

O.D.O.T. DISTRICT 2 SURVEY OFFICE (USE ONLY)

PERSONNEL

REFERENCE NO. 1

SHEET 1 OF 15

NOTES RHOADES DATE 8/4/16
 H.C. O'DONNELL WEATHER FAIR
 R.C. RHOADES TEMP. 80°

ROUTE SR 576
 COUNTY WILLIAMS
 TOWNSHIP CENTER
 SECTION 35

DWG BY RHOADES PID 85269

T 6 N R 2 E

TYPE MONUMENT MONBOX W/1" IPIN

ON SURFACE - ~~BELOW~~ ON

OFFSET C PAVEMENT 11.8' ~~RT~~ : RT

0.9' TO RT EDGE PAVEMENT


STATION: 0+00

HORZ. DATUM: NAD83 2011


GEOID: NAVD88 2012A

GRID: NORTHING: 648281.816

EASTING: 1389322.822

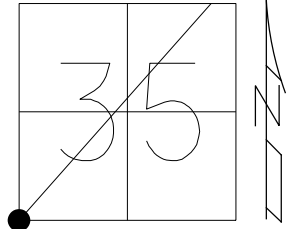

NOTE: REF1 SR 2

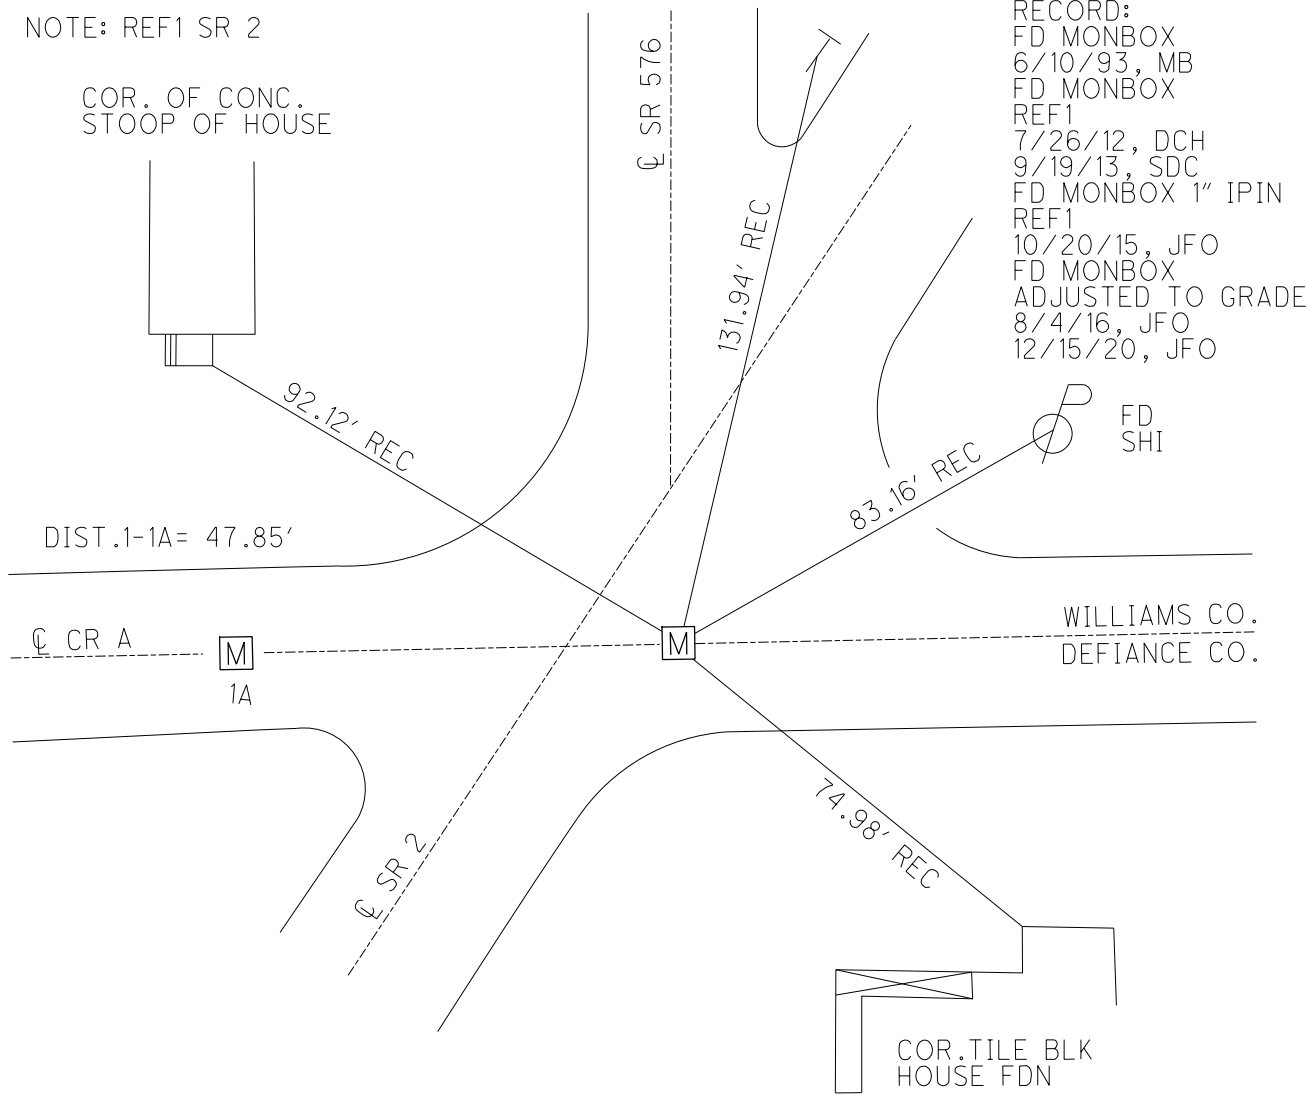

RECORD:
 FD MONBOX
 6/10/93, MB
 FD MONBOX
 REF1
 7/26/12, DCH
 9/19/13, SDC
 FD MONBOX 1" IPIN
 REF1
 10/20/15, JFO
 FD MONBOX
 ADJUSTED TO GRADE
 8/4/16, JFO
 12/15/20, JFO

FD
 SHI

WILLIAMS CO.
 DEFIANCE CO.

COR. TILE BLK
 HOUSE FDN

O.D.O.T. DISTRICT 2 SURVEY OFFICE



PERSONNEL

NOTES VAN DUSEN
 H.C. CORDS
 R.C. BARNHISEL
OTTO

REFERENCE NO. 1
 DATE 6-11-93
 WEATHER CLEAR
 TEMP. +65°

SHEET 1 OF 16
 ROUTE S.R. 576
 COUNTY Williams
 TOWNSHIP Center
 SECTION 34
T. 6 N. R. 2 E

TYPE MONUMENT P.K.
 ON SURFACE - ~~BELON~~ yes
~~LEFT - & PAV'T.~~ - RIGHT 3.5
G.S. TO RT EDGE PAVEMENT
 S.L.M. 12 + 36

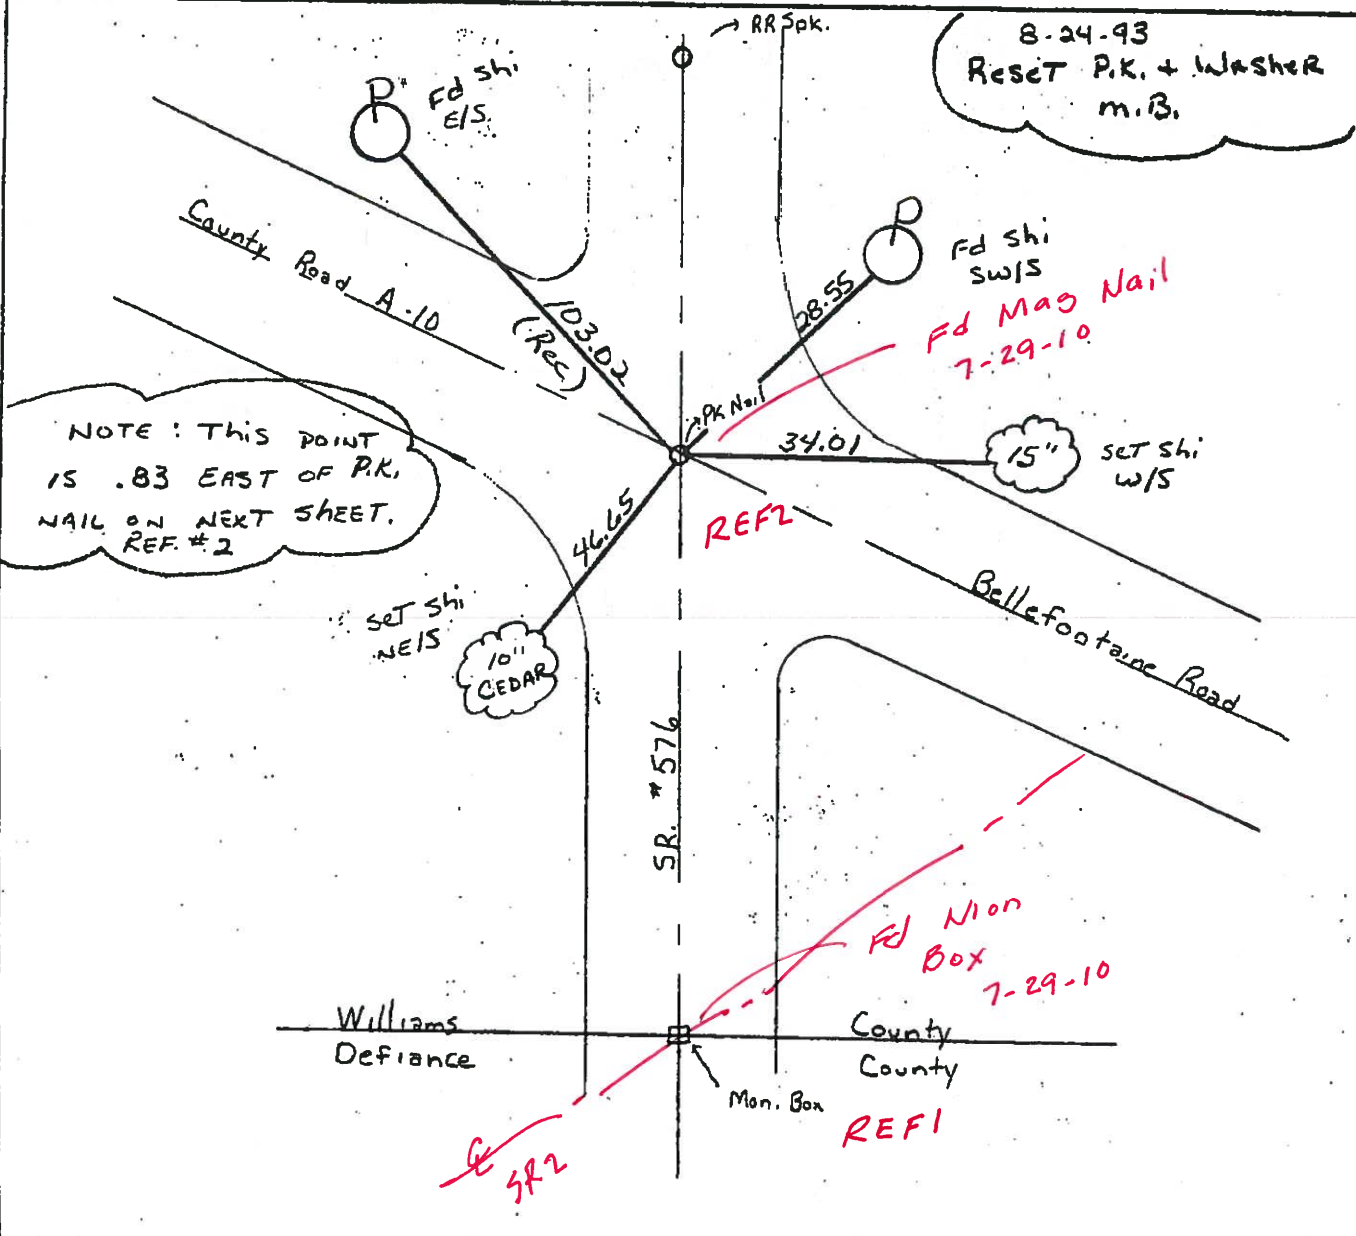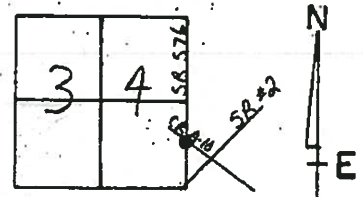

County WILLIAMS S.R. 576

Date 7-31-79

Township CENTER



Weather RAIN SHOWERS

Section 34

Temp. +75°

T6N, R2E

Personnel BURNSIDE
SMITH
BOWERS
KNAPE
MEAD

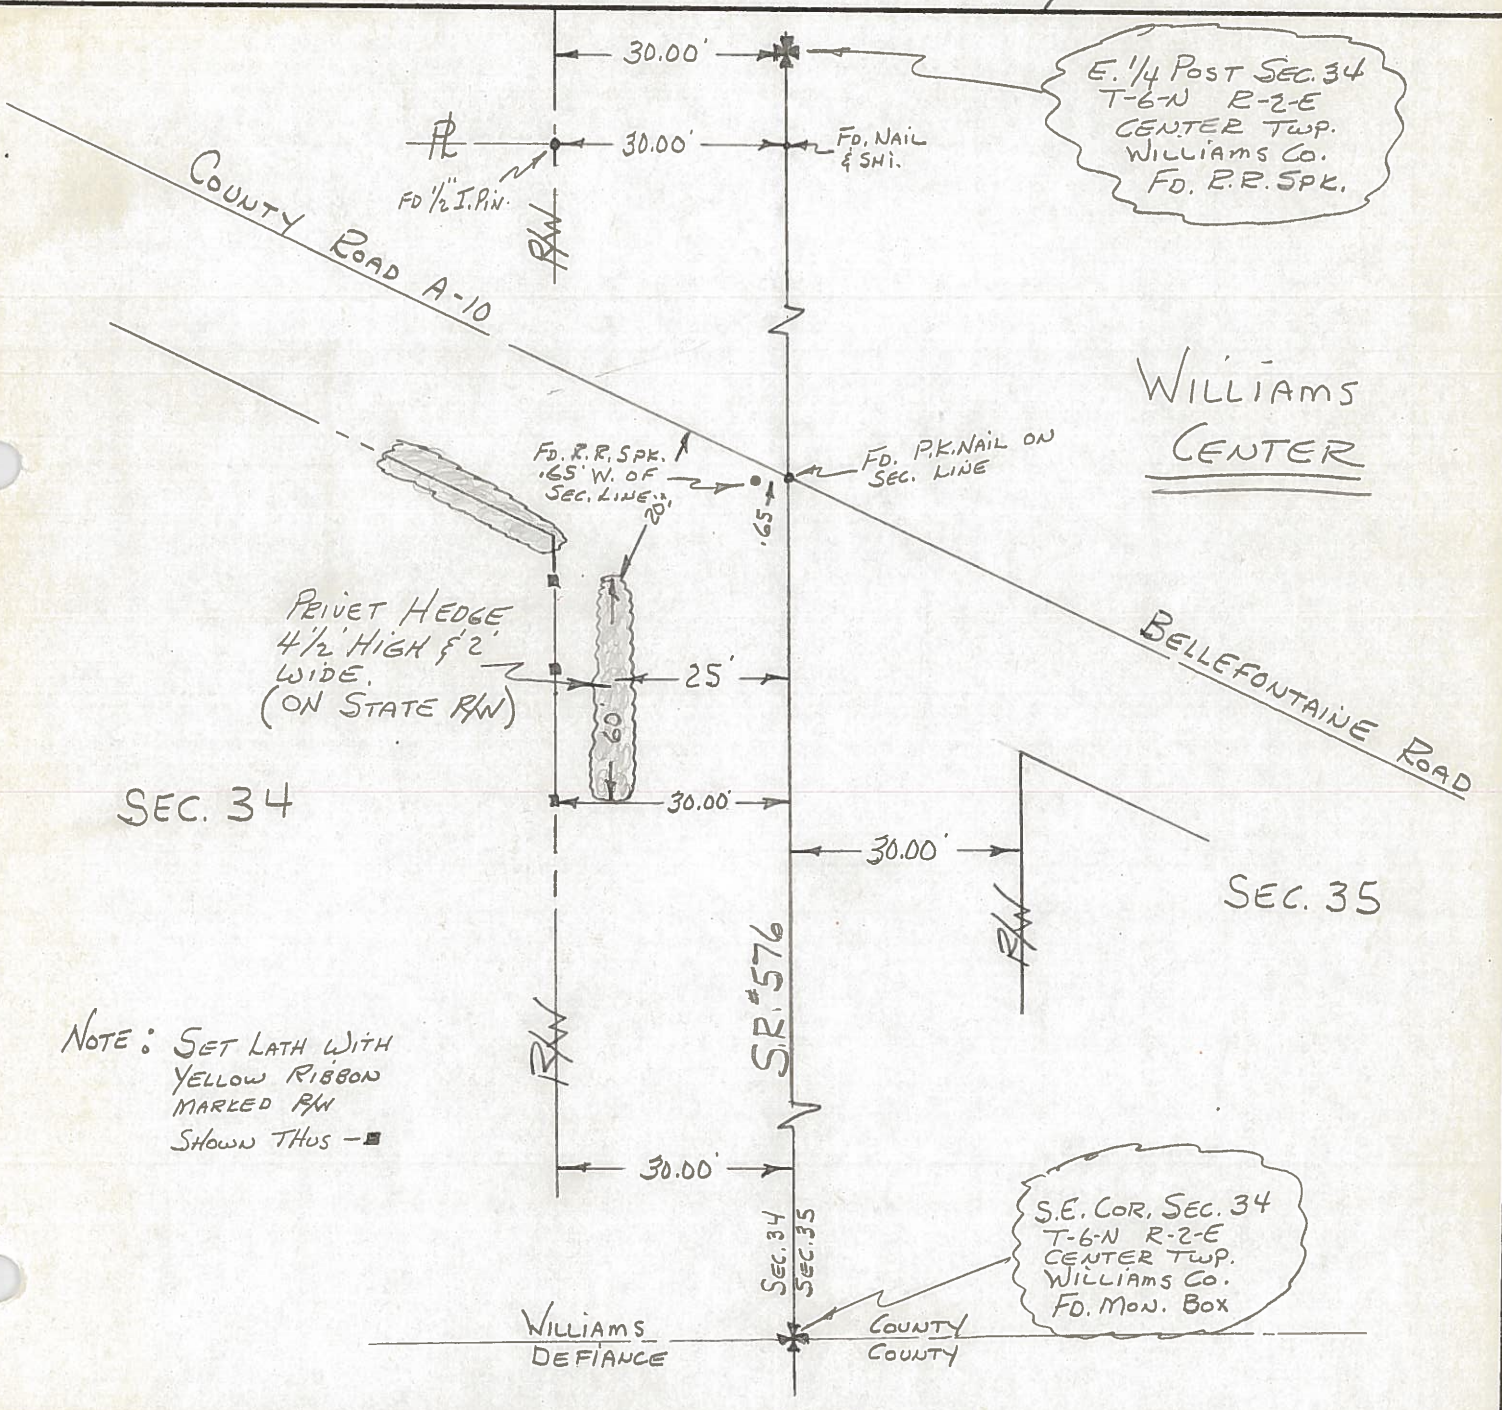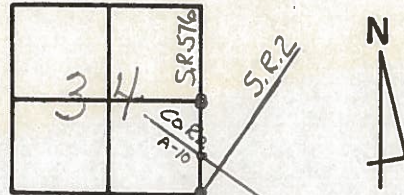

SEC. 34

WILLIAMS
CENTER

SEC. 35

NOTE: SET LATH WITH
YELLOW RIBBON
MARKED RW
SHOWN THUS -■

S.E. COR. SEC. 34
T-6-N R-2-E
CENTER TWP.
WILLIAMS Co.
FD. MON. BOX

WILLIAMS
DEFIANCE

COUNTY
COUNTY

| | | | | | |
|-------------|-----------------------------|-------------|-------|---------|-----------------------------|
| PERSONNEL | TITLE | PERSONNEL | TITLE | COUNTY | DATE |
| Louys | | | | Wi. | 4-7-50 |
| Hoover | | | | S. R. | 576 |
| Beach | | | | WEATHER | Fair. |
| | | | | SEC. | Defiance Co. Line to Pt. 34 |
| | | | | TEMP. | 50° |
| DESCRIPTION | Witnesses to control Points | | | JOB NO. | |
| | LEFT | CENTER LINE | RIGHT | | |

