


O.D.O.T. DISTRICT 2 SURVEY OFFICE (USE ONLY)

PERSONNEL _____ REFERENCE NO. 2 C SHEET 7 OF 15
 NOTES ASTON DATE 3/29/24 ROUTE SR 576
 H.C. RHOADES WEATHER SUNNY COUNTY WILLIAMS
 R.C. ASTON TEMP. 44° TOWNSHIP CENTER
 DWG BY RHOADES PID CHIP SEAL SECTION 35
 T 6 N R 2 E

TYPE MONUMENT P.K.SHANK
 ON SURFACE - ~~BELOW~~ ON
 OFFSET \varnothing PAVEMENT 3.2' ~~RT~~ : RT
6.9' TO RT EDGE PAVEMENT
 STATION: 16+90

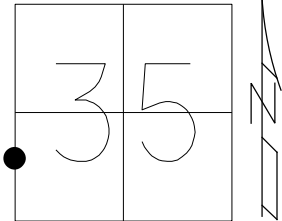


HORZ.DATUM: NAD83 2011 GEOID: NAVD88 2018
 GRID: NORTHING: 649969.471 EASTING: 1389356.661

RECORD:
 FD P.K.WASHER
 REF6
 7-6-12, DCH
 SET P.K./WASHER
 NEWREF6
 7-26-12, DCH
 FD P.K.SHANK
 REF2C
 6/28/23,
 3/29/24, JMR

FD SHI
 30" ASH

DIST .2B-2C= 34.31'

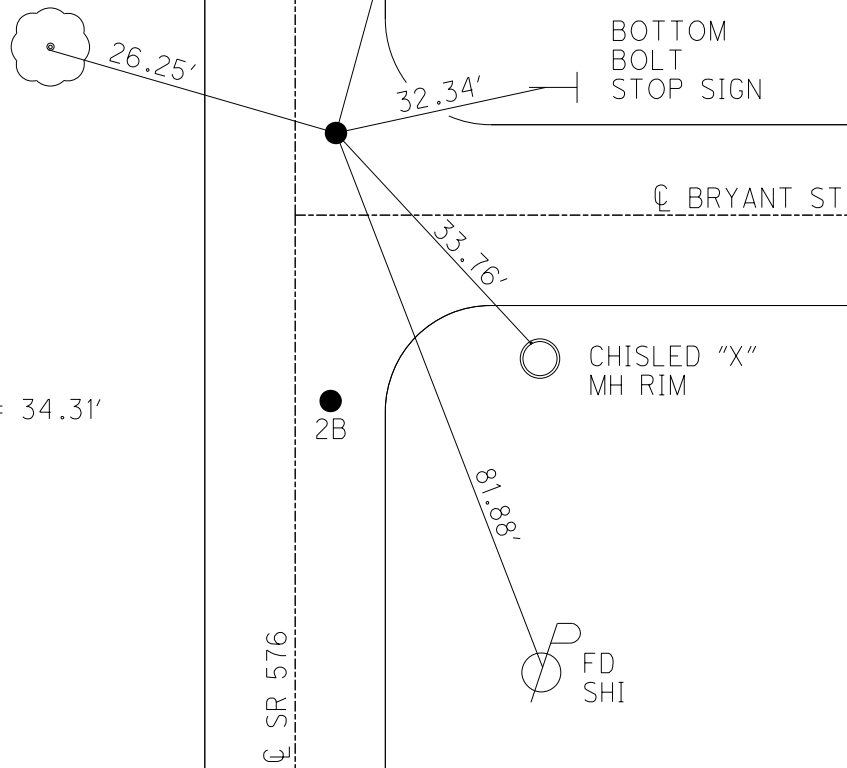

\varnothing SR 576

O.D.O.T. DISTRICT 2 SURVEY OFFICE (USE ONLY)

PERSONNEL _____ REFERENCE NO. 2 C SHEET 6 OF 14
 NOTES HOMAN DATE 7-06-12 ROUTE SR 576
 H.C. HOMAN WEATHER SUNNY COUNTY WILLIAMS
 R.C. HARBAUGH TEMP. 90° TOWNSHIP CENTER
 _____ SECTION 35
 _____ T 6 N R 2 E

TYPE MONUMENT PK/WASHER


ON SURFACE - ~~BELOW~~ ON _____

~~LEFT~~ - ☉ PAV'T - RIGHT 3.2', 11' N ☉ OF BRYANT ST.


6.9 TO RT EDGE PAVEMENT

S.L.M. 16+90

Grid: Northing: 649969.471 Easting: 1389356.661

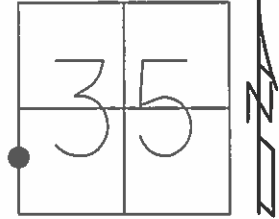

FD PK
 REF6
 7-6-12, DCH
 GPS, NEWREF6
 SET PK/WASHER
 7-26-12, DCH

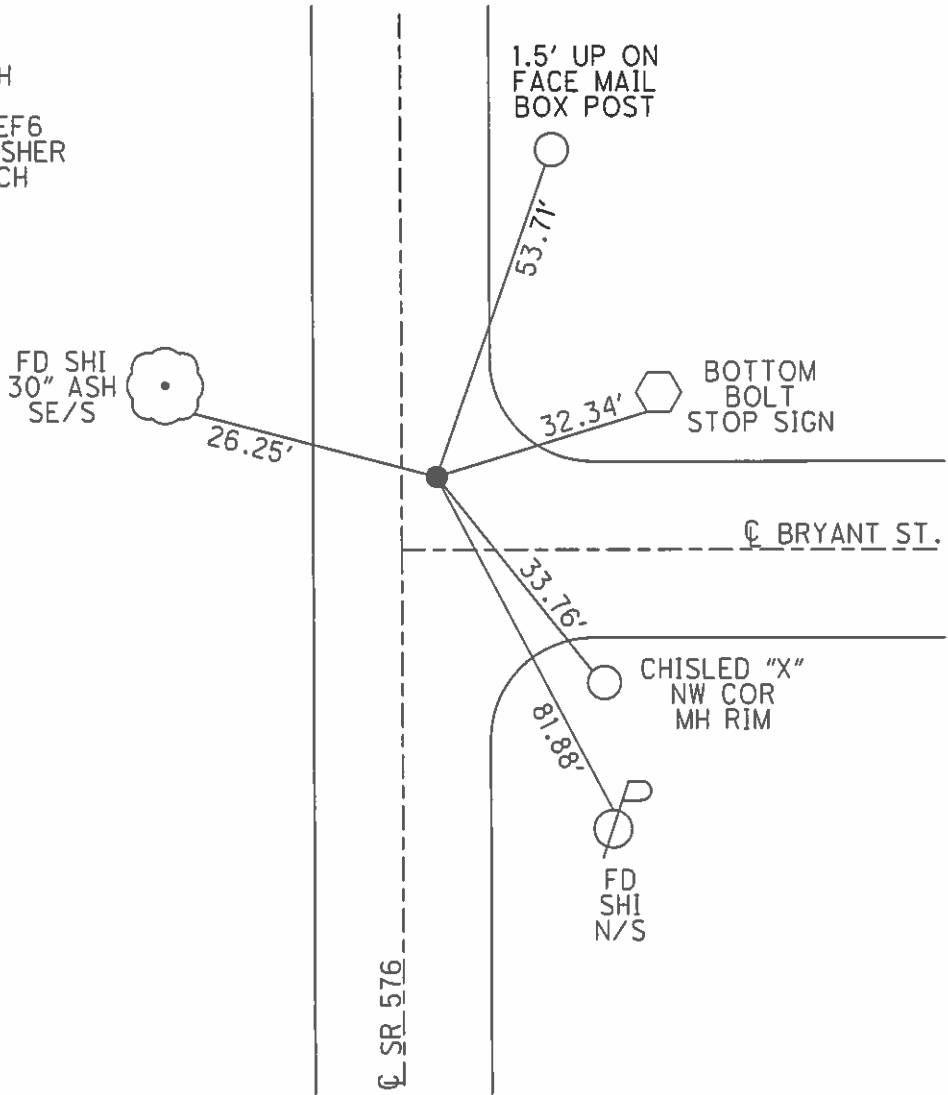

O.D.O.T. DISTRICT 2 SURVEY OFFICE

PERSONNEL _____

REFERENCE NO. 2-A

SHEET 3 OF 16

NOTES BARNHISEL

H.C. CORDS

DATE 6-11-93

ROUTE 576

R.C. JAN DUSEN

WEATHER CLEAR

COUNTY WILLIAMS

OTTO

TEMP. +65°

TOWNSHIP CENTER

SECTION 35

T6 N R 2 E

TYPE MONUMENT PK NAIL


ON SURFACE - ~~NO~~ YES

~~1.5~~ - PAV'T. - RIGHT 3.2


6.9 TO RT EDGE PAVEMENT

S.L.M. 16+90

11' NORTH OF E BRYANT ST.

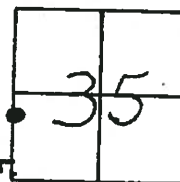

Reset PK & WASHER
8-24-93
MB

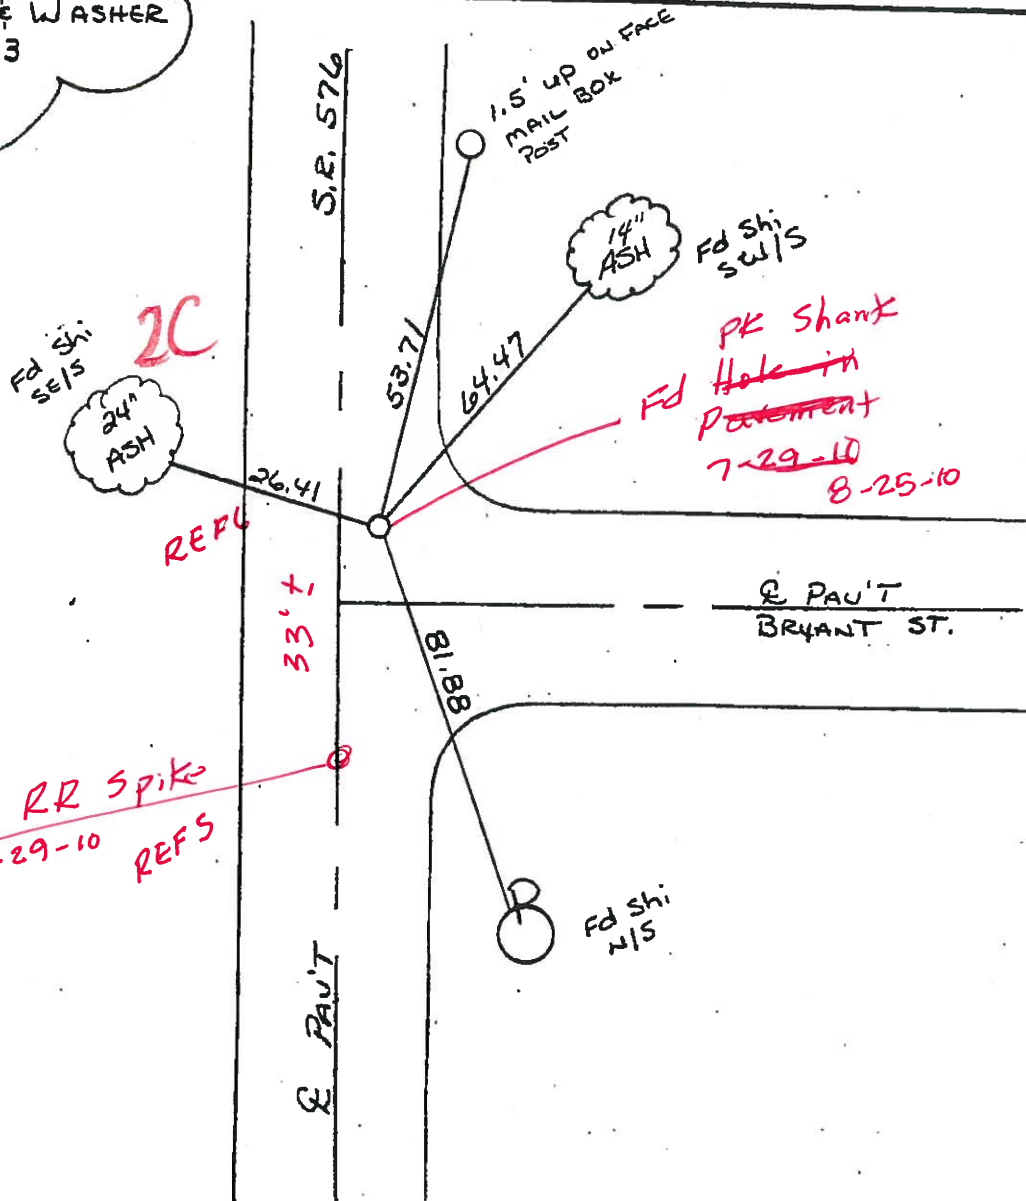

O.D.O.T. DISTRICT 2 SURVEY OFFICE

SHEET 3 OF

County Williams S.R. 576

Date 16 April 85

Township Center

Weather Sunny

Section 35

Temp. 59°


T N, R E

Personnel I. Stone

R. Michalak


D. Coats

J. Housholder

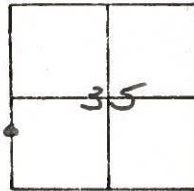

REF. NO. 2-A

20

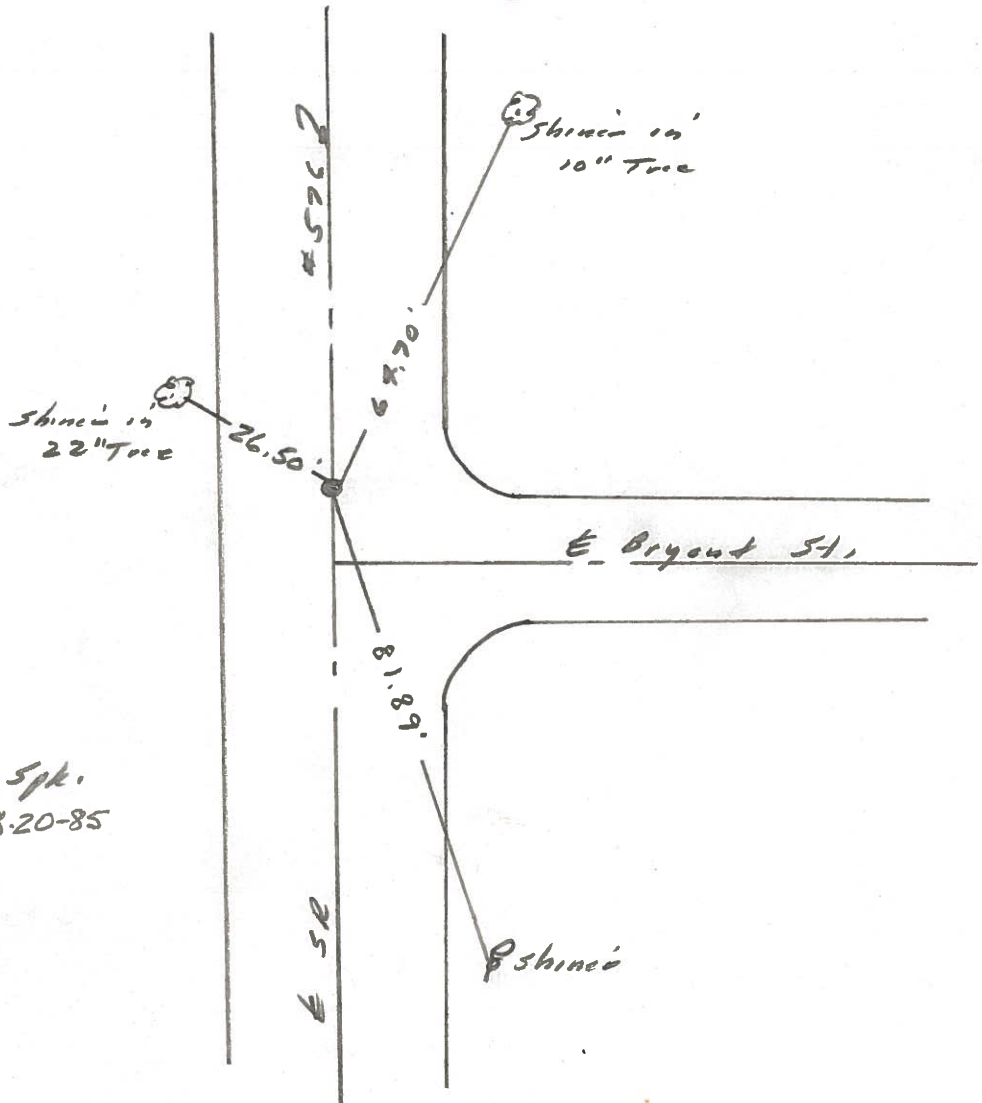

Rd. Small RR Spk.
Set P.K. 8-20-85

County Williams S.R. 576

Date 18 Aug. 80

Township Center


Weather Cloudy

Section 35

Temp. 67°

T N, R E

Personnel I. Stone

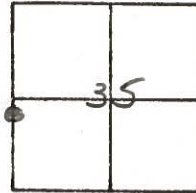


R. Michalak

P. Neusev

D. Curtis

REF. NO. 2-A

2C

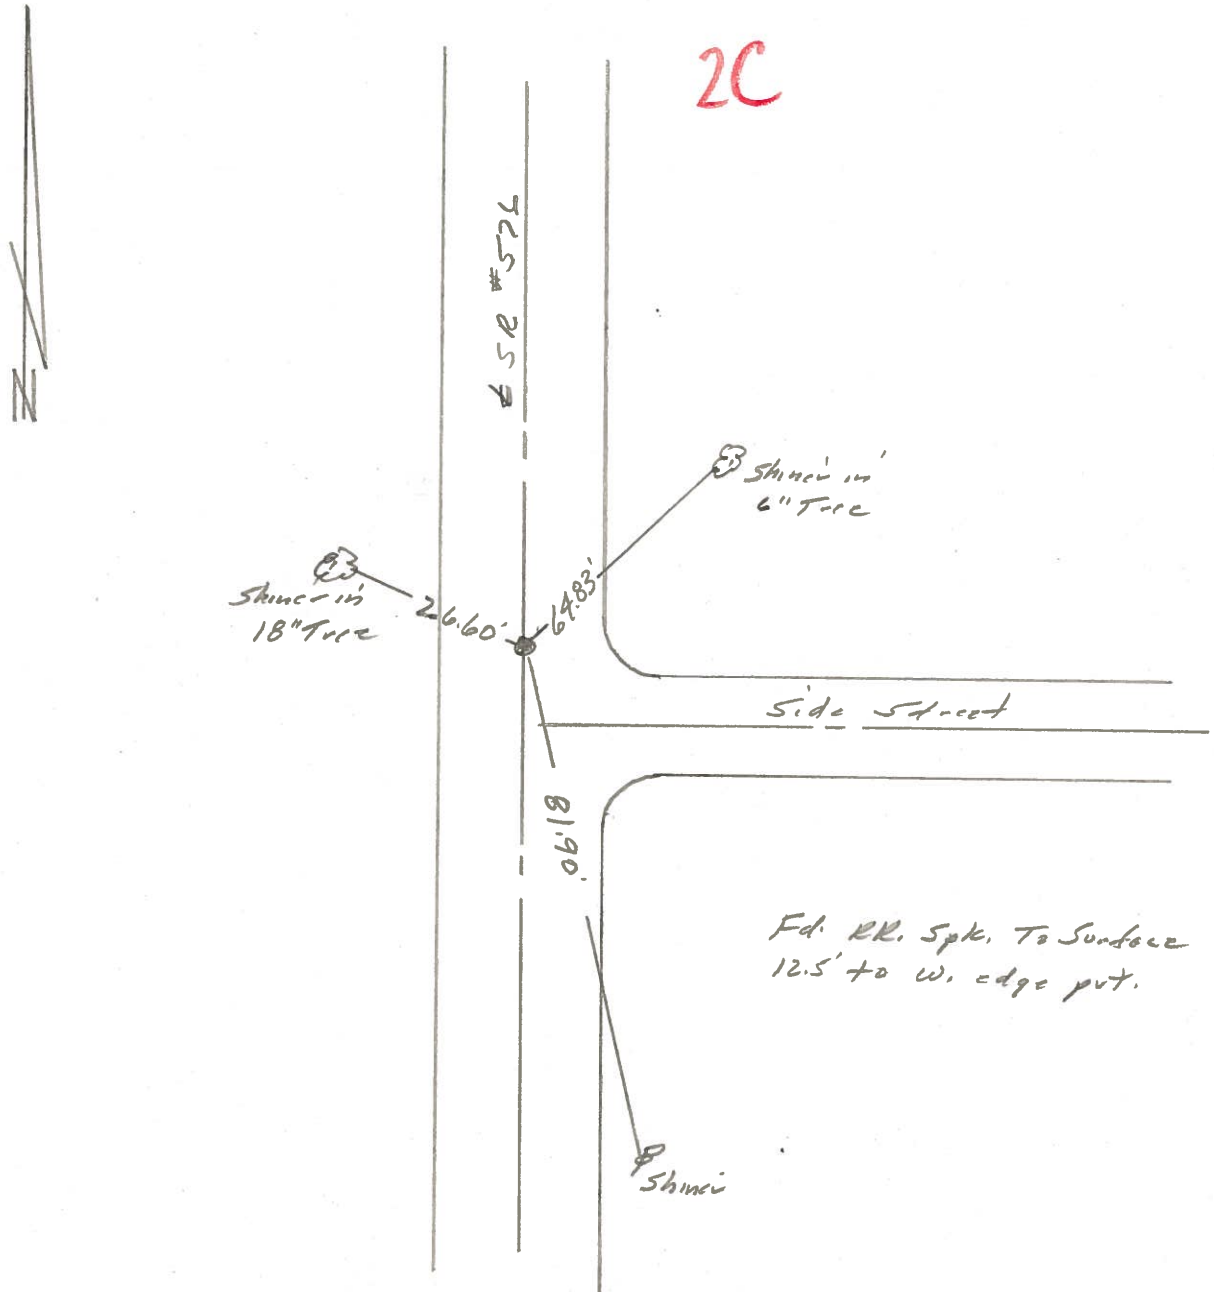

County Williams S.R. 576

Date 18 Aug. 80

Township Center

Weather Cloudy

Section 35

Temp. 67°


T.N., R.E

Personnel I. Stone


R. Michalak

P. Neuser

D. Curtis

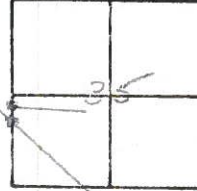

REF. NO. **2AA**

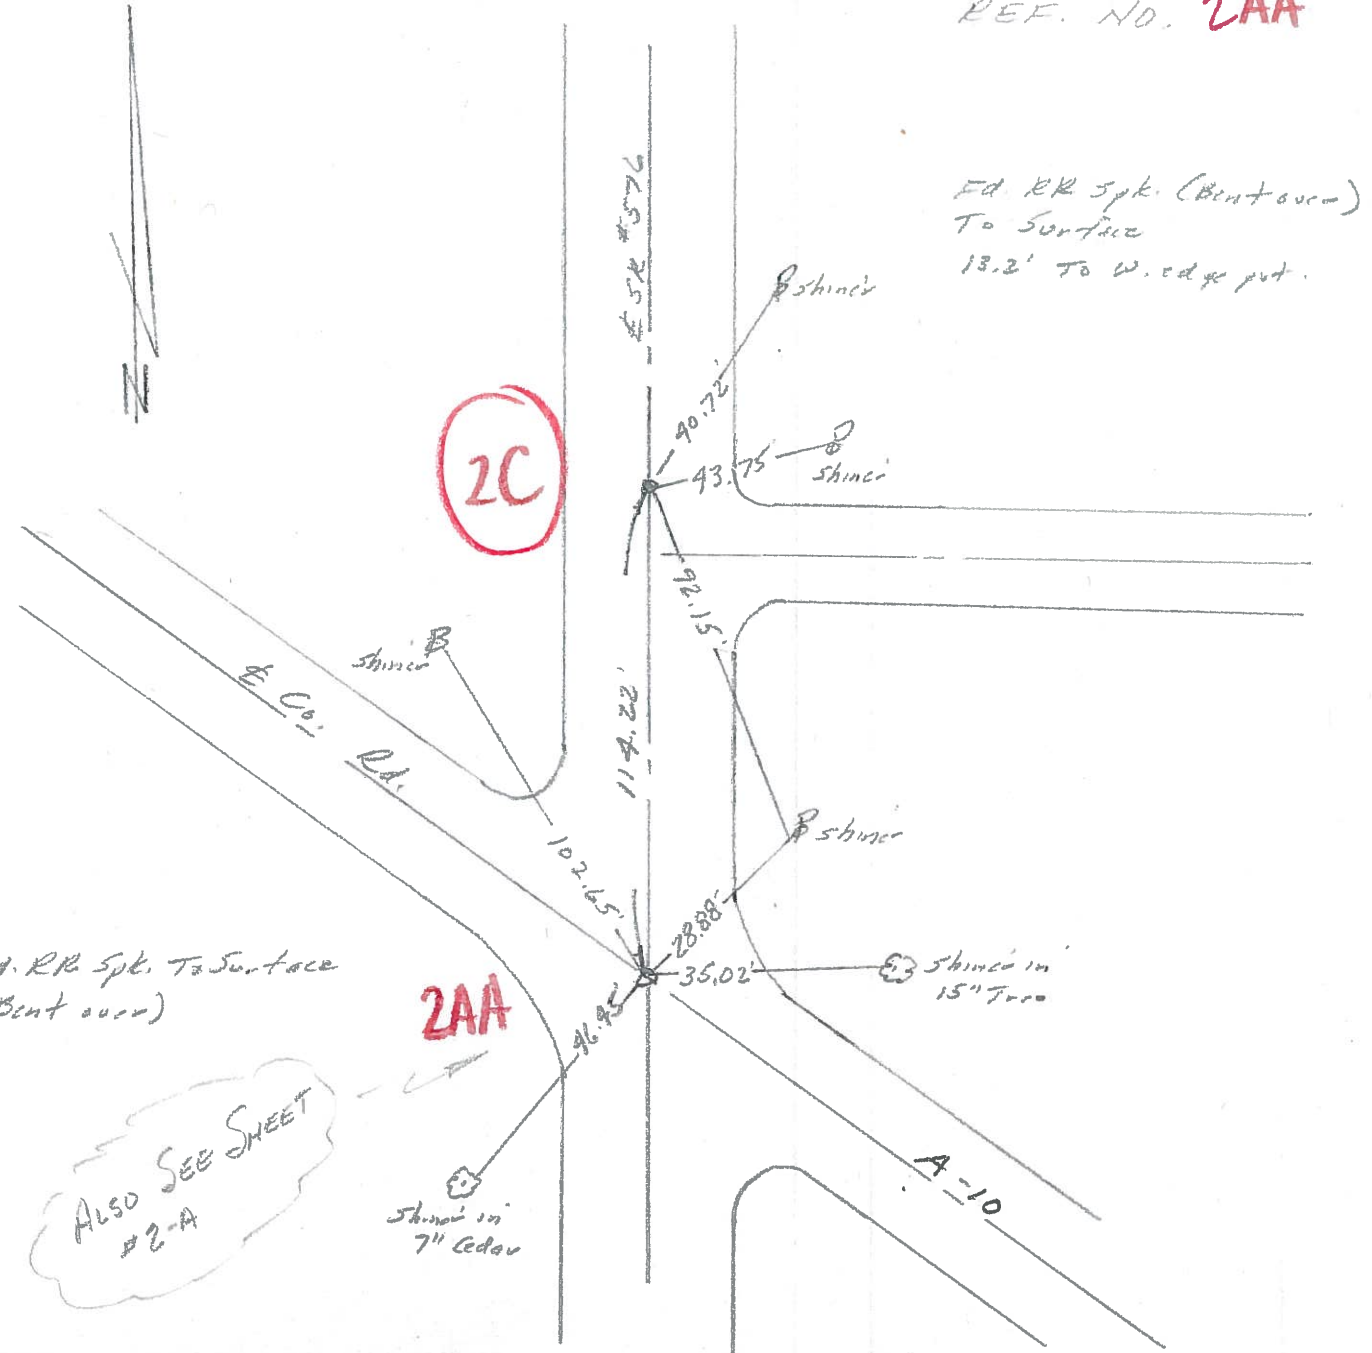

Ed. RR Spk. To Surface (Bent over)

Ed. RR Spk. (Bent over) To Surface 13.2' To W. edge pt.

ALSO SEE SHEET #2-A

Shiner in 7" Cedar