


O.D.O.T. DISTRICT 2 SURVEY OFFICE (USE ONLY)


PERSONNEL \_\_\_\_\_ REFERENCE NO. 3 SHEET 7 OF 14  
 NOTES HOMAN DATE 7-6-12 ROUTE SR 576  
 H.C. HOMAN WEATHER SUNNY COUNTY WILLIAMS  
 R.C. HARBAUGH TEMP. 90° TOWNSHIP CENTER  
 SECTION 35  
 T 6 N R 2 E

TYPE MONUMENT PK NAIL  
~~ON SURFACE~~ - BELOW 3"  
~~LEFT~~ - ☉ PAV'T - RIGHT 1.2'  
8.9 TO RT EDGE PAVEMENT  
 S.L.M. 26+43

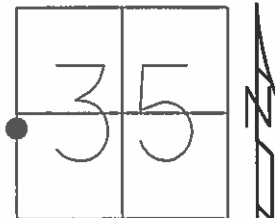

Grid: Northing: 650922.135 Easting: 1389356.661

RESET PK/WASHERS  
 8-24-93, MB  
 FD PK  
 REF7  
 7-6-12, DCH  
 DISTANCE TO REF 3 A = 16.15'  
 GPS, NEWREF7  
 SET PK/WASHER  
 7-26-12, DCH

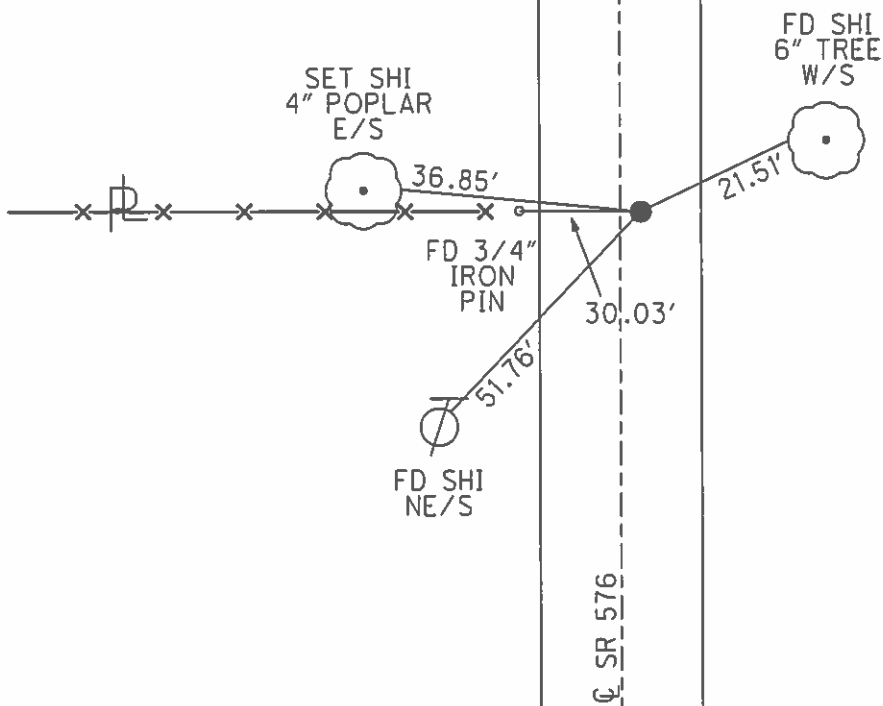

# O.D.O.T. DISTRICT 2 SURVEY OFFICE


PERSONNEL \_\_\_\_\_ REFERENCE NO. 3 SHEET 4 OF 16

NOTES BARNHISEL  
 H.C. COEDS  
 R.C. JAN DUSEN  
OTTO


DATE 6-11-93  
 WEATHER CLEAR  
 TEMP. +65°

ROUTE 576  
 COUNTY WILLIAMS  
 TOWNSHIP CENTER  
 SECTION 35  
T 6 N R 2 E

TYPE MONUMENT <sup>①</sup> PK NAIL <sup>②</sup> PK NAIL ~ W. 1/4 CORNER Sec. 35  
 ON SURFACE - ~~NO~~ yes yes  
~~1.2~~ - & PAV'T. - RIGHT 1.2 1.2  
S.9 TO RT EDGE PAVEMENT BOTH  
 S.L.M. <sup>①</sup> 26+43 <sup>②</sup> 26+59

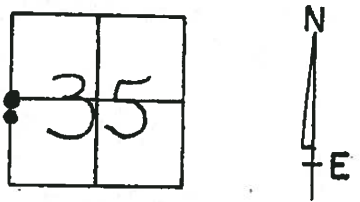

Reset PK's & WASHERS  
 8-24-93  
 MB

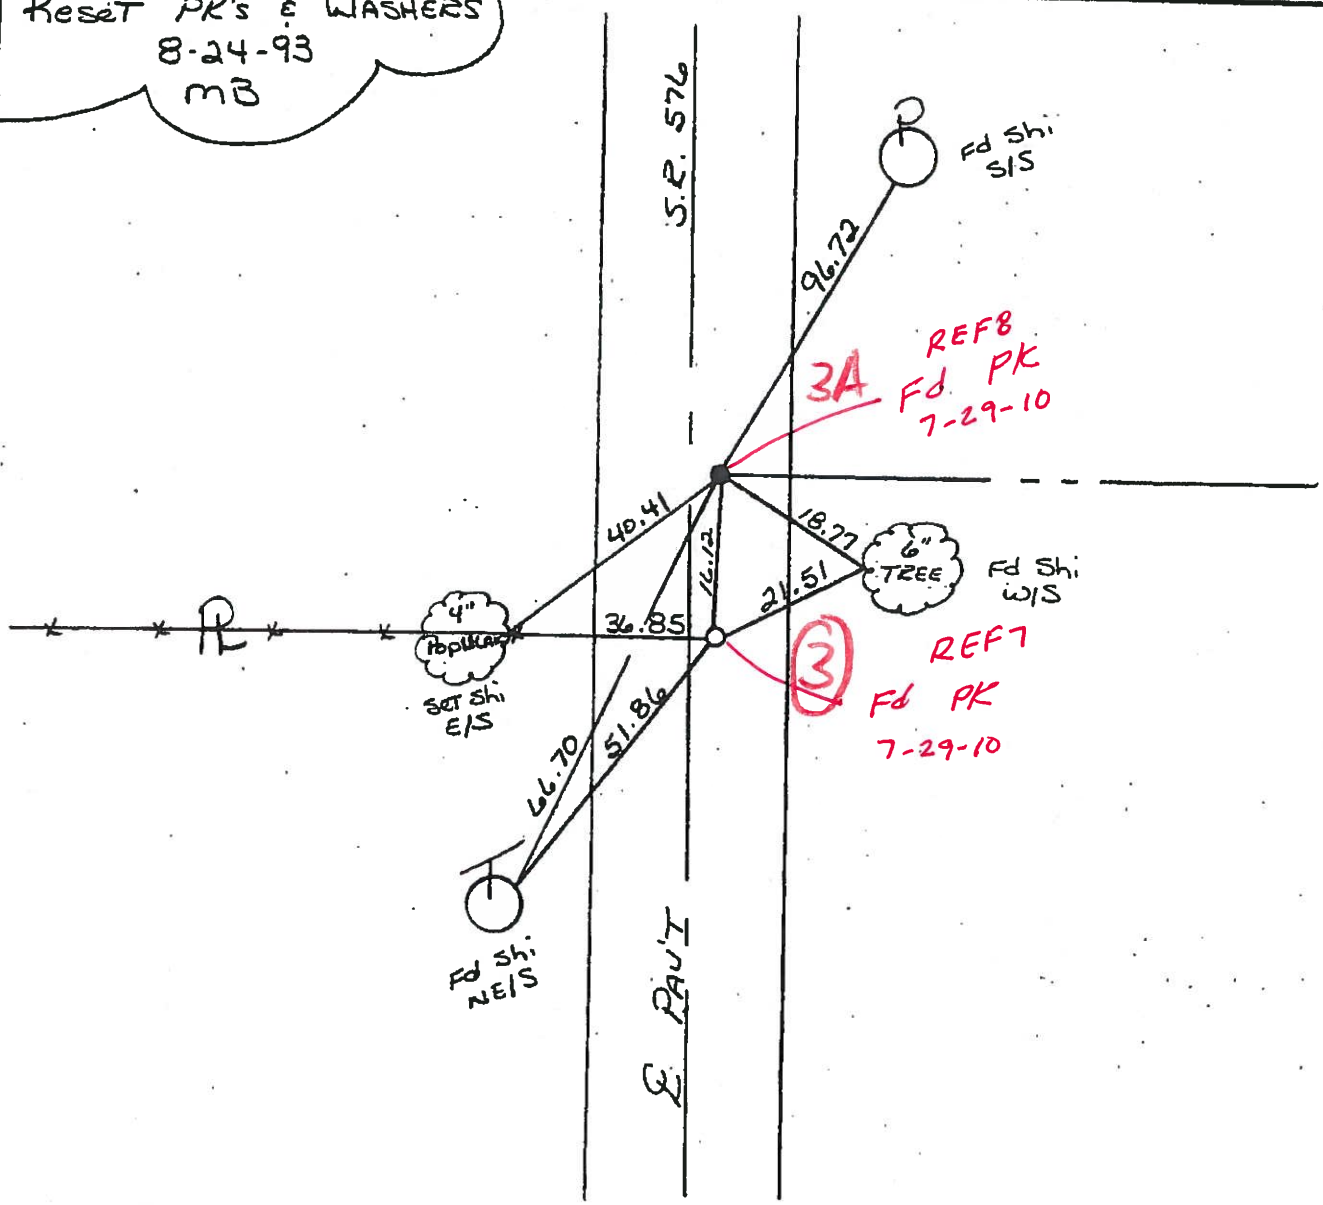

# O.D.O.T. DISTRICT 2 SURVEY OFFICE

PERSONNEL

REFERENCE NO. 3

SHEET 4 OF       

NOTES I. Stone

H.C. D. Curtis

R.C. R. Michalak

J. Householder

DATE 6 Sept. 85

WEATHER Rain

TEMP. 75°

ROUTE SR# 576

COUNTY Williams

TOWNSHIP Center

SECTION 35

T        R       



TYPE MONUMENT Set PK Nails

ON SURFACE - BELOW       

LEFT - & PAV'T. - RIGHT       

       TO        EDGE PAVEMENT

S.L.M. 26+50 ±

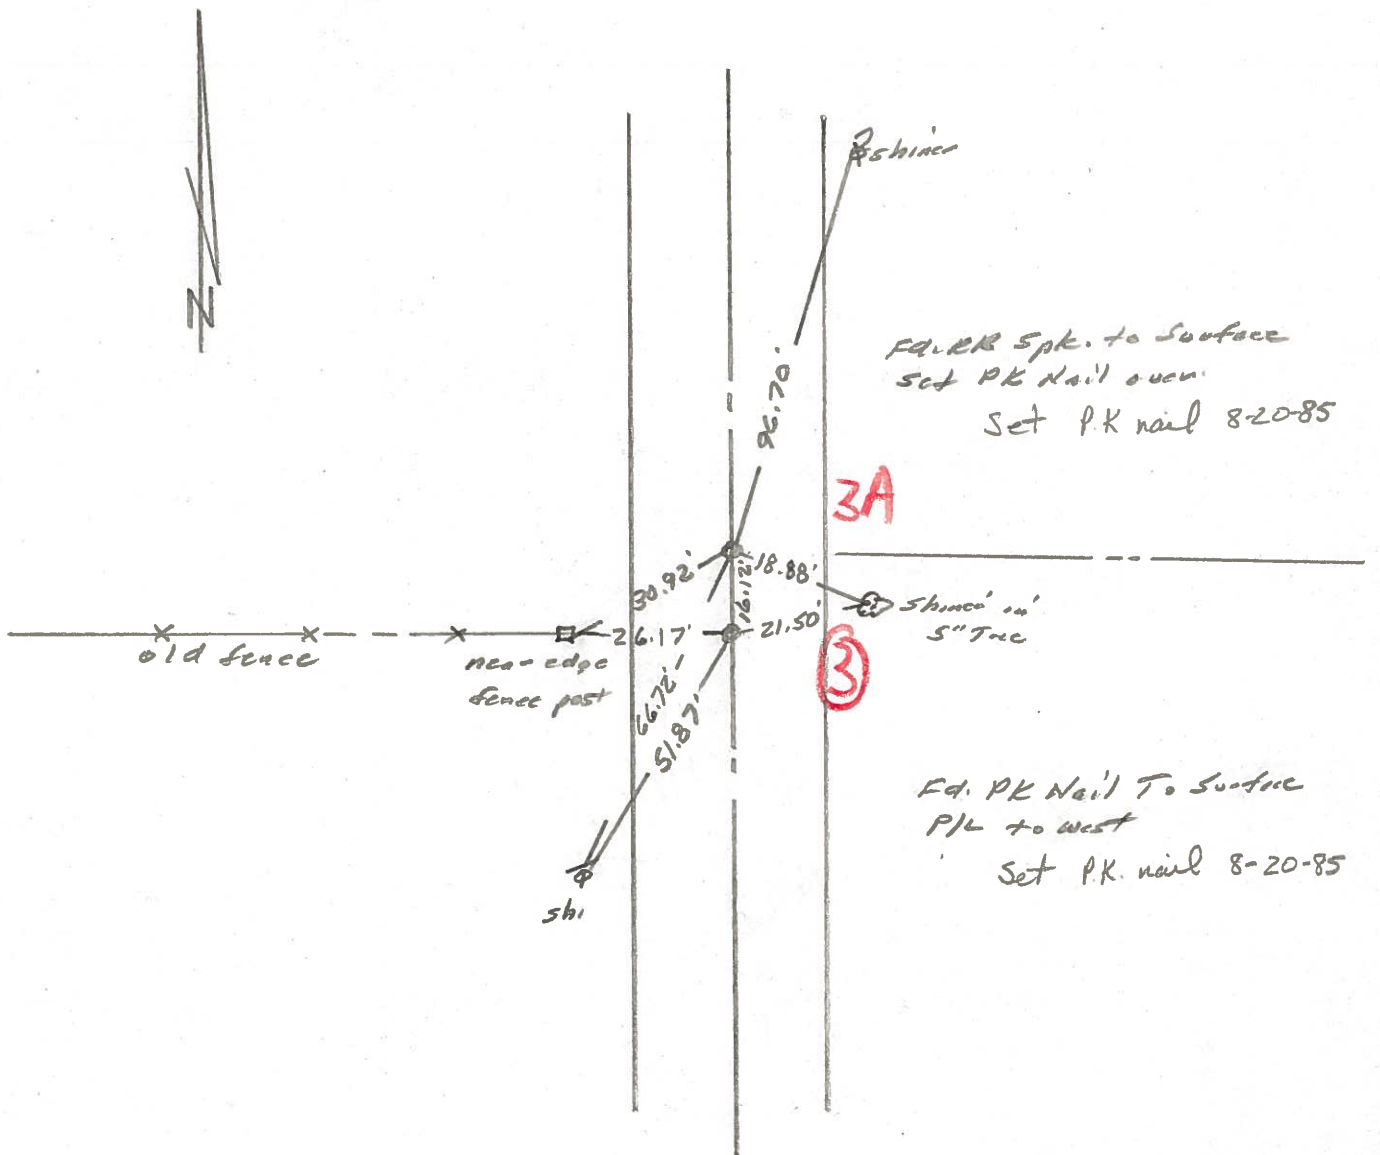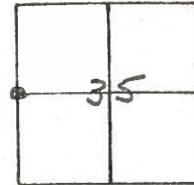

County Williams S.R. 576

Date 18 Aug. 80

Township Greater

Weather Cloudy

Section 35

Temp. 67°


T N, R E

Personnel I. Stone


R. Michalak

P. Neuser

D. Curtis

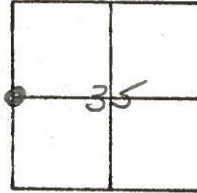

REF. NO. 3

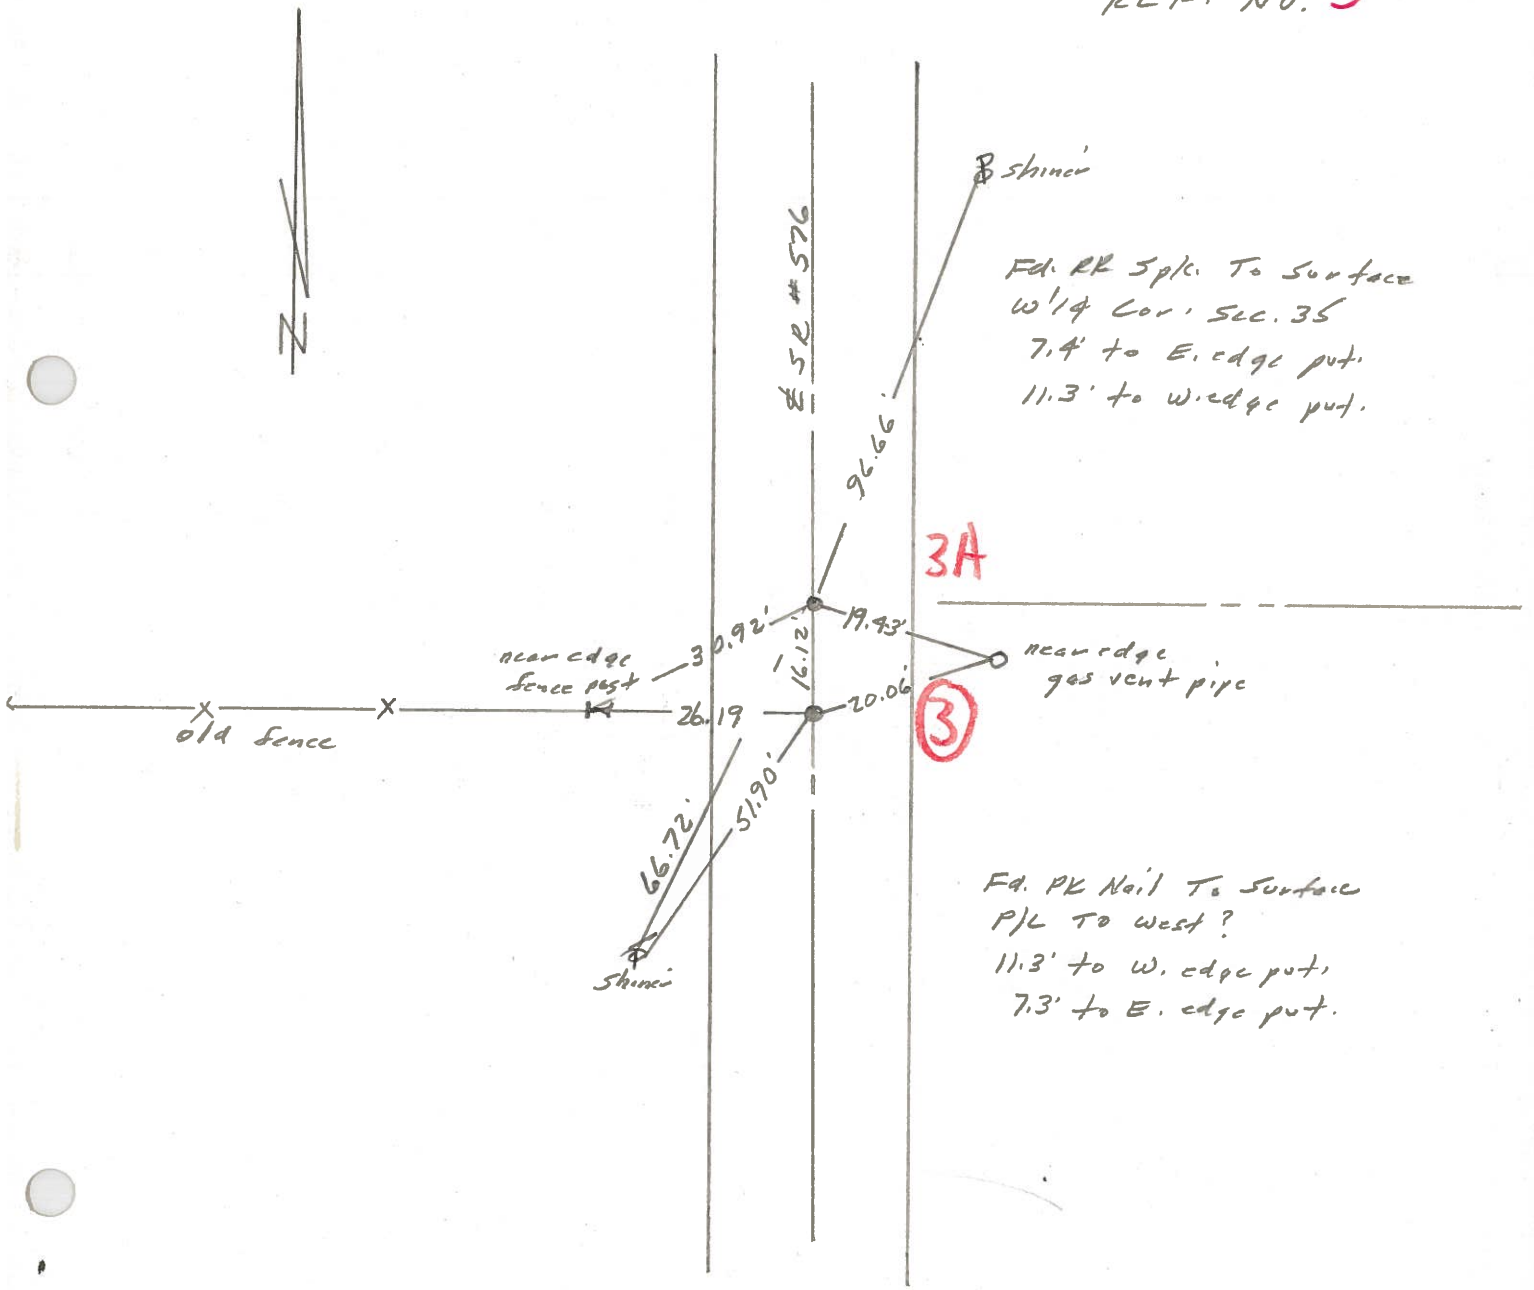



PERSONNEL	TITLE	PERSONNEL	TITLE	COUNTY	DATE
Louys Hoover Beach				Wi.	4-7-50
				S. R. 576	WEATHER Fair.
				SEC Defiance Co. Line to Pt. 34	TEMP. 50°
DESCRIPTION	Witnesses to control Points			JOB NO.	
	LEFT	CENTER LINE	RIGHT		

