

O.D.O.T. DISTRICT 2 SURVEY OFFICE (USE ONLY)

PERSONNEL

REFERENCE NO. 4

SHEET 9 OF 14

NOTES RHOADES DATE 12/15/20
 H.C. O'DONNELL WEATHER FAIR
 R.C. AUBLE TEMP. 25°

ROUTE SR 576
 COUNTY WILLIAMS
 TOWNSHIP CENTER
 SECTION 27

DWG BY NIESE PID NO PID

T 6 N R 2 E

TYPE MONUMENT MAG/WASHER

ON SURFACE - ~~BELOW~~ ON

OFFSET ☉ PAVEMENT ON LT : RT

- TO - EDGE PAVEMENT


STATION: 52+80

HORZ.DATUM: NAD83 2011

GEOID: NAVD88 2018


GRID: NORTHING: 653594.574

EASTING: 1389417.919

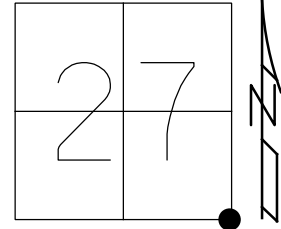

RECORD: P.I.
 $\Delta = 0^\circ 12' 00''$ RT
 STA. 362+67.5
 FD SM.R.R.SPIKE
 10/12/88, SWH
 SET SM.R.R.SPIKE
 11/23/88
 SET P.K./WASHER
 12/6/90, SWH
 FD P.K./WASHER
 11/17/95, MRC
 SET P.K./WASHER
 12/15/98, TR
 7/6/12, DCH
 D.N.F.
 5/1/17, JLL
 SET MAG/WASHER
 11/6/19, JLL
 FD MAG/WASHER
 REF11
 12/15/20, JFO

NOTE: REF 11 US 6

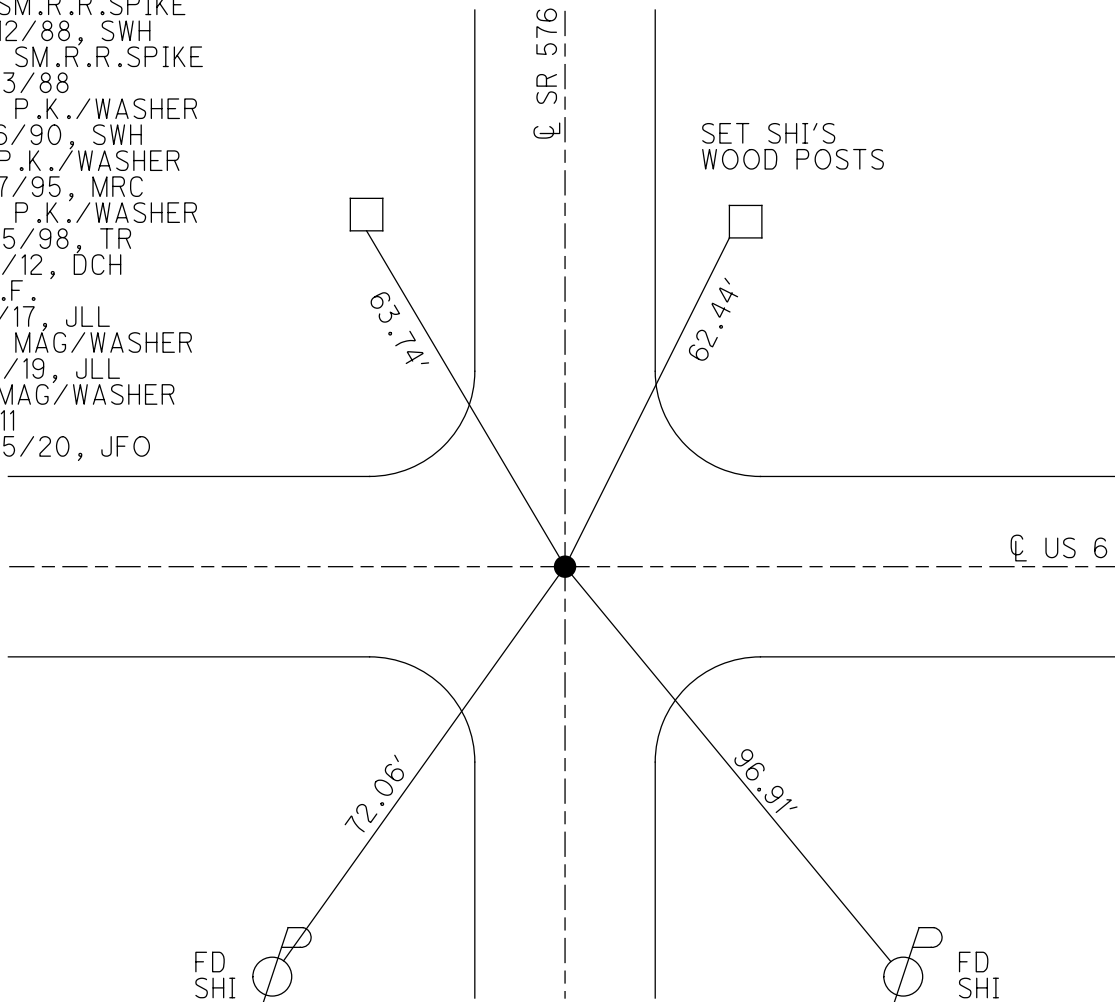

O.D.O.T. DISTRICT 2 SURVEY OFFICE

PERSONNEL

4-SR. 576

REFERENCE NO. 11 U.S. 6 SHEET 5 OF 16

NOTES HOFFMAN

H.C. BARNHISEL

R.C. LOSHRKE

DATE 10-12-88

WEATHER P. CLEAR

TEMP. 48°

S.R. 567

ROUTE US 6

COUNTY Williams

TOWNSHIP Center

SECTION 26

T. 6 N. R. 2 E

TYPE MONUMENT SMALL RR SPIRE


ON SURFACE - BELOW YES

LEFT- & PAV'T. - RIGHT YES

TO EDGE PAVEMENT

S.L.M. 539+14 BACK = 538+56 AHEAD

27	26
34	35

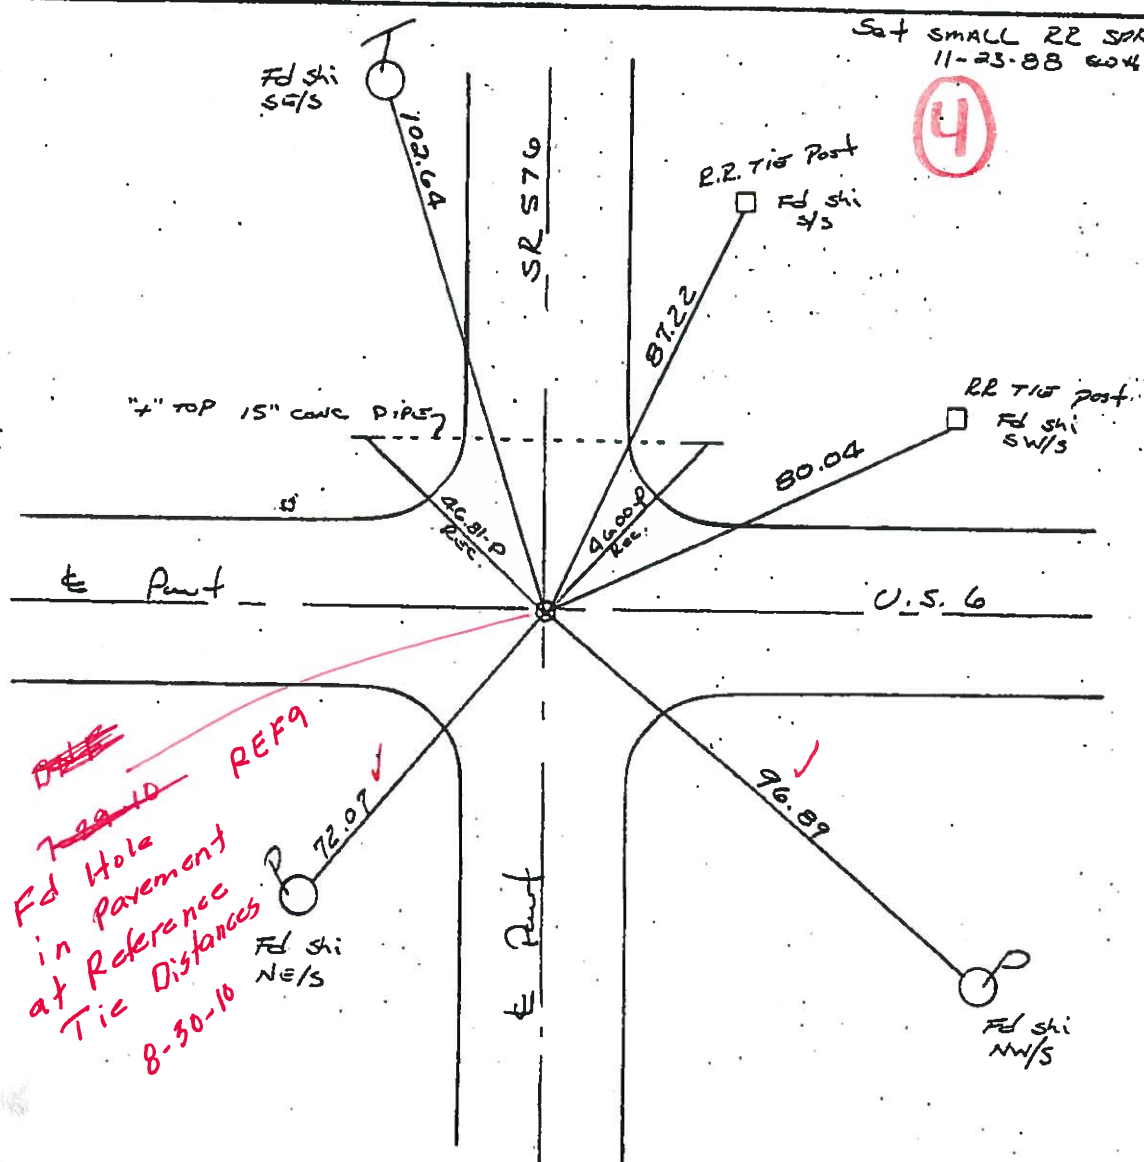

O.D.O.T. DISTRICT 2 SURVEY OFFICE

PERSONNEL

REFERENCE NO. 11

SHEET OF

NOTES HOFFMAN

H.C. BARNHISEL

DATE 10-12-88

ROUTE US 6

R.C. LOSHRKE

WEATHER P. CLEAR

COUNTY Williams

TEMP. 48°

TOWNSHIP Center

SECTION 26

T. 6 N. 2 E.

TYPE MONUMENT SMALL RR SPIRE

ON SURFACE - BELOW YES

LEFT- & PAV'T. - RIGHT YES


TO EDGE PAVEMENT

S.L.M. 539+14 BACK = 538+56 AHEAD

27	26
34	35



Set SMALL RR SPIRE
11-23-88 EOH

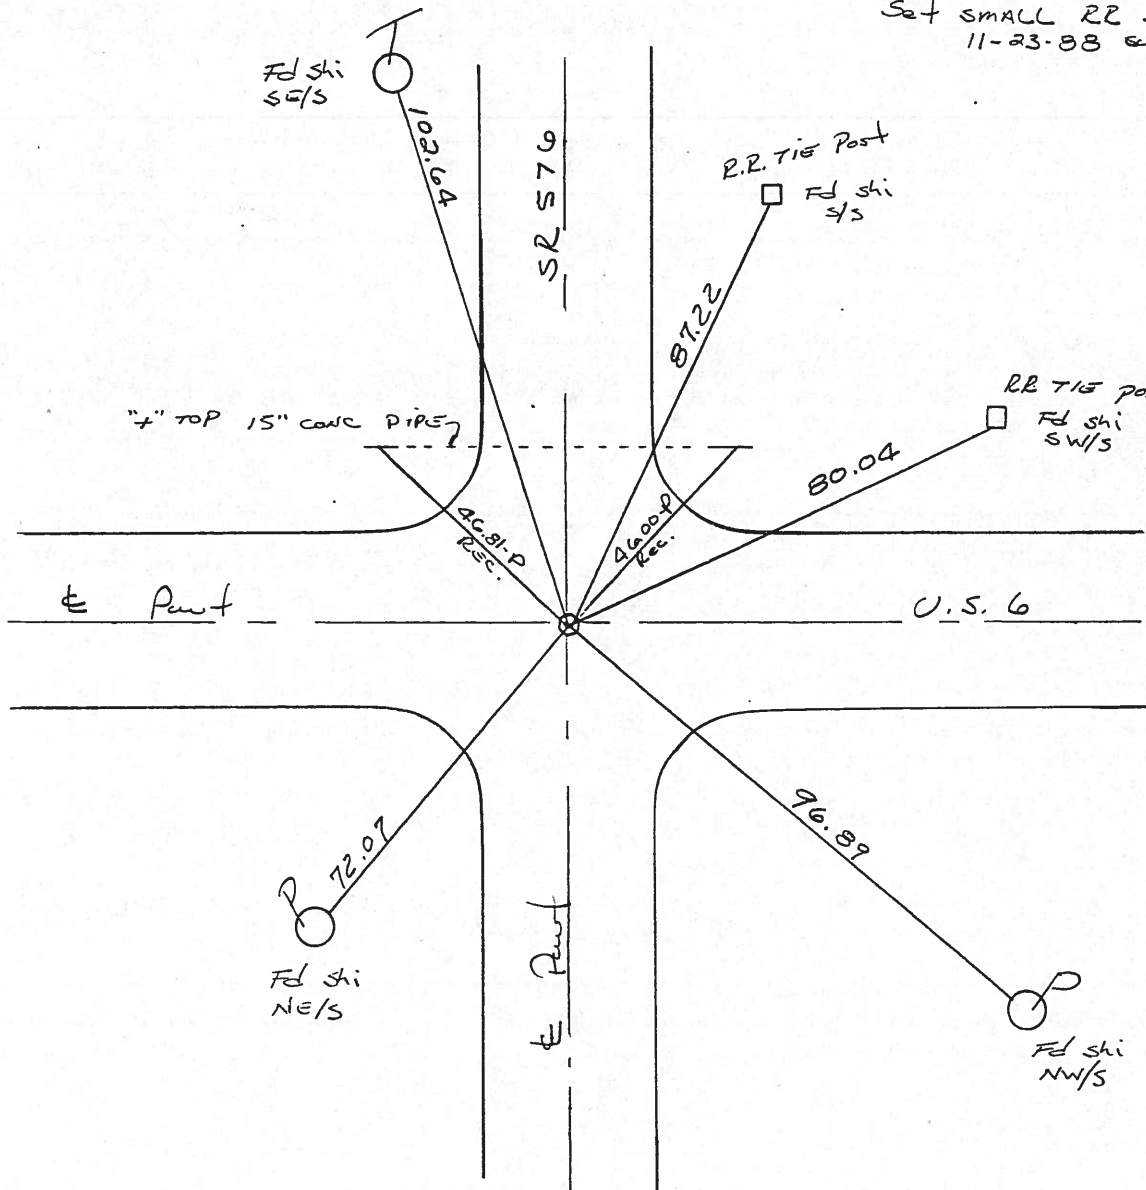

O.D.O.T. DISTRICT 2 SURVEY OFFICE

PERSONNEL _____

REFERENCE NO. 4

SHEET 5 OF _____

NOTES 1. Stone

H.C. D. Curtis

R.C. K. Michalake

J. Householder

DATE 6 Sept. 85

WEATHER Rain

TEMP. 75°

ROUTE SR #576

COUNTY Williams

TOWNSHIP Center

SECTION 35

T. _____ R. _____

TYPE MONUMENT RR site


ON SURFACE - BELOW _____

LEFT - \odot PAV'T. - RIGHT _____

TO _____ EDGE PAVEMENT

S.L.M. _____

27	26
34	35

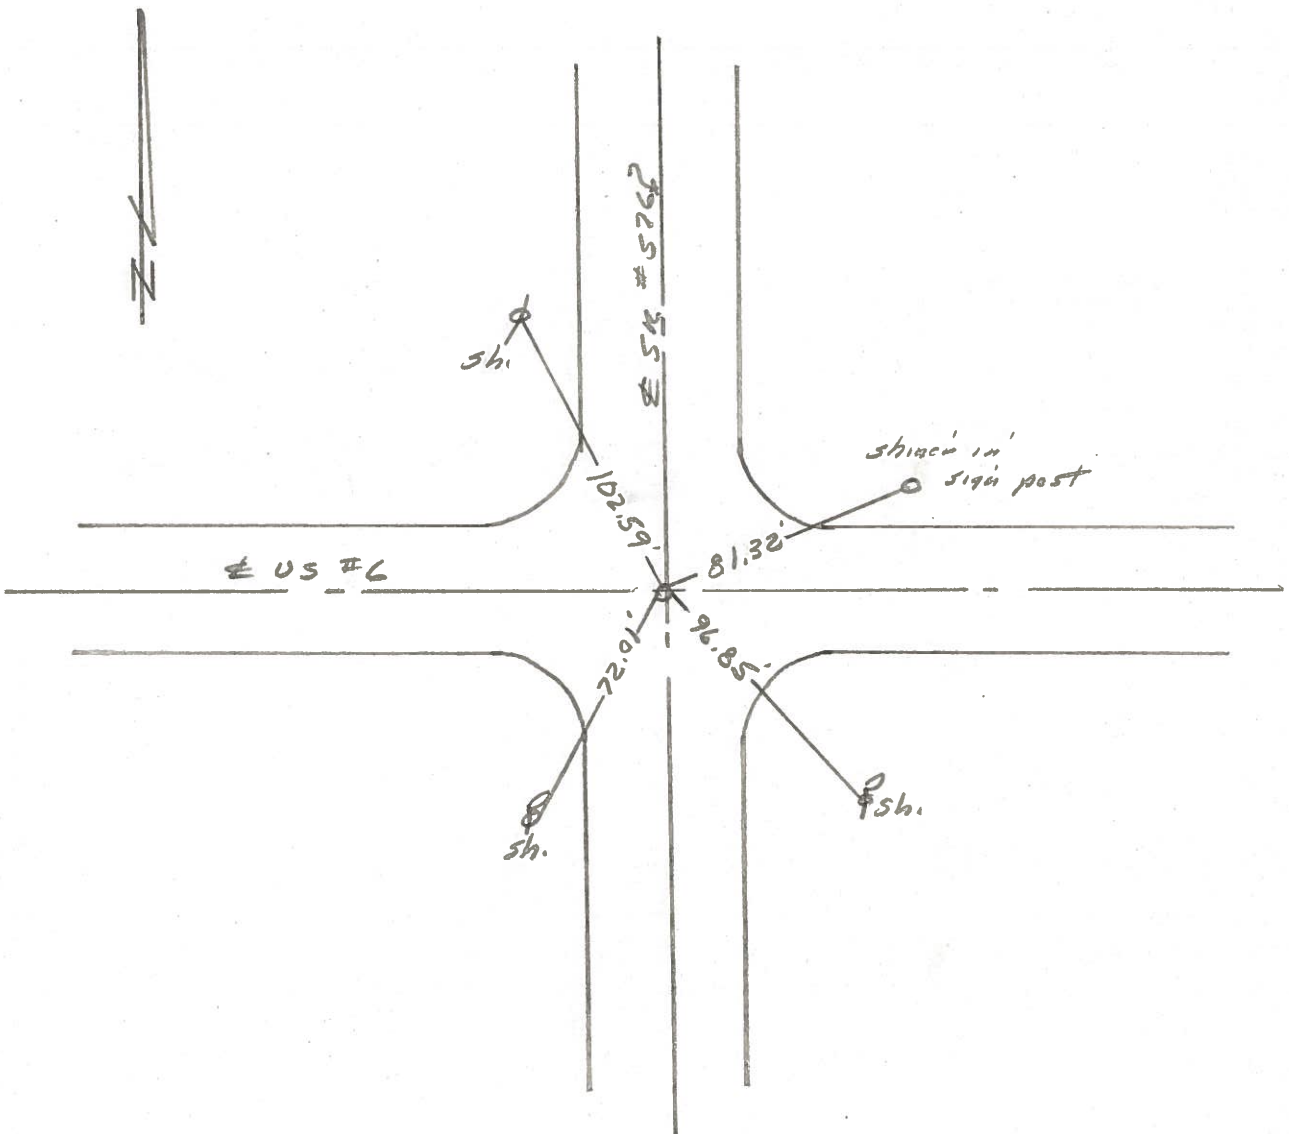

County Williams S.R. 576

Date 18 Aug, 80

Township Center

Weather Fair

Section 26-27-34-35

Temp. 72°

T N, R E

Personnel J. Stone

27	26
34	35




R. Michalek

P. Neuse

D. Curtis

REF. No. 4

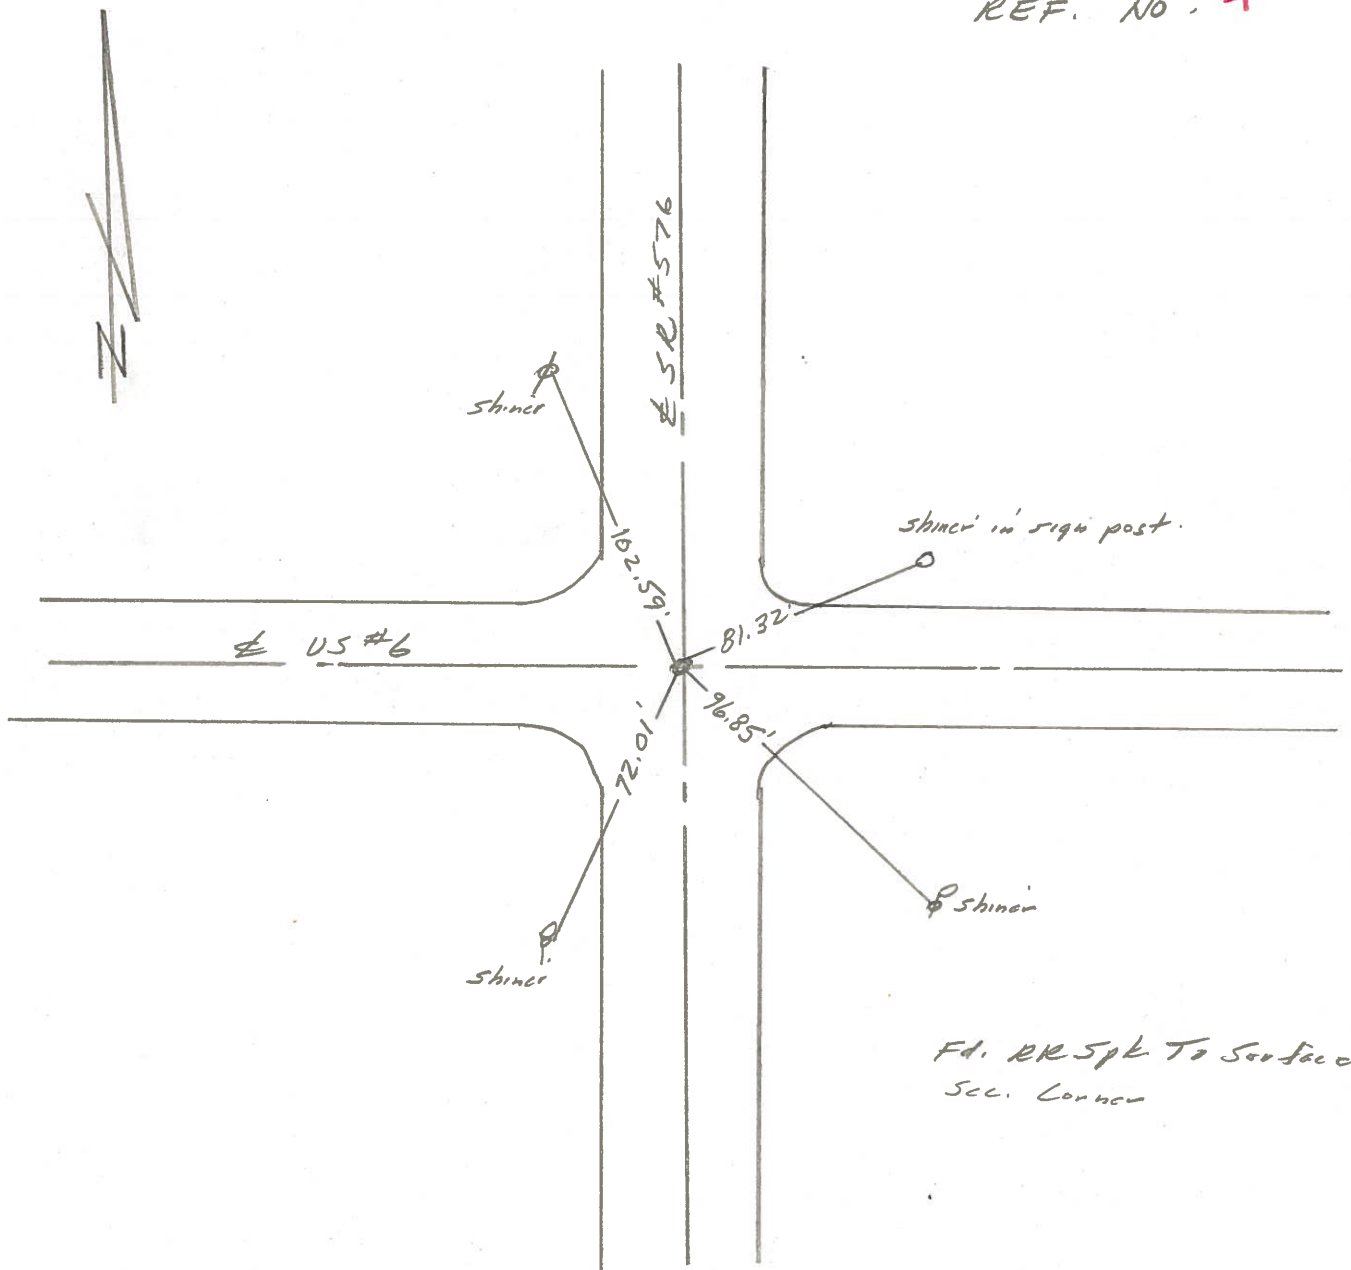

PERSONNEL	TITLE	PERSONNEL	TITLE	COUNTY	DATE
Louys				Wi.	4-7-50
Hoover				S. R. 576	WEATHER Fair.
Beach				SEC. Defiance Co. Line to Pt. 34	TEMP. 50°
DESCRIPTION				WITNESSES TO CONTROL POINTS	JOB NO.

