

O.D.O.T. DISTRICT 2 SURVEY OFFICE (USE ONLY)

PERSONNEL

REFERENCE NO. 6 A

SHEET 12 OF 14

NOTES RHOADES

DATE 8/5/22

ROUTE SR 576

H.C. RHOADES

WEATHER CLOUDY

COUNTY WILLIAMS

R.C. WHITAKER

TEMP. 73°

TOWNSHIP CENTER

SECTION 23

DWG BY RHOADES PID PAVETRAIN

T 6 N R 2 E

TYPE MONUMENT P.K./WASHER

ON SURFACE - ~~BELOW~~ ON

OFFSET ☉ PAVEMENT 5.2' LT : ~~RT~~

6.1' TO LT EDGE PAVEMENT


STATION: 114+30

HORIZ.DATUM: NAD83 2011

GEOID: NAVD88 2018

GRID: NORTHING: 659707.466

EASTING: 1389455.589

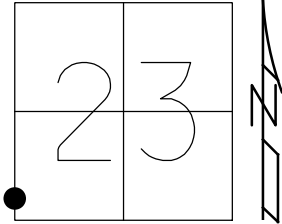

RECORD:
 SET P.K./WASHER
 8-24-93, MB
 (REC) 834.15' SOUTH
 TO SEC. CORNER
 FD SM.R.R.SPIKE
 REF12
 7-6-12, DCH
 SET P.K./WASHER
 NEWREF12
 7/26/12, DCH
 FD P.K./WASHER
 REFA6
 8/5/22,
 2/2/23, JMR

SET
SHI

34.28'



60.60'

FD
SHI

67.79'


FD
SHI

☉ SR 576

O.D.O.T. DISTRICT 2 SURVEY OFFICE (USE ONLY)

PERSONNEL _____ REFERENCE NO. 6 A SHEET 12 OF 14
 NOTES HOMAN DATE 7-6-12 ROUTE SR 576
 H.C. HOMAN WEATHER SUNNY COUNTY WILLIAMS
 R.C. HARBAUGH TEMP. 90° TOWNSHIP CENTER
 _____ SECTION 23
 _____ T 6 N R 2 E

TYPE MONUMENT SM RR SPIKE
~~ON SURFACE~~ - BELOW 1 1/2"
 LEFT - CL PAV'T - ~~RIGHT~~ 5.2'
6.1 TO LT EDGE PAVEMENT
 S.L.M. 114+30
 Grid: Northing: 659707.489 Easting: 1389455.561

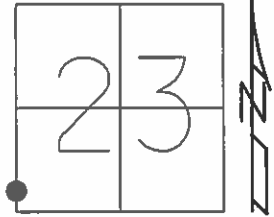


RESET PK/WASHER
8-24-93, MB

(REC) 834.15' SOUTH
TO SEC. CORNER

REF12
FD PK
7-6-12, DCH

GPS, NEWREF12
SET PK/WASHER
7-26-12, DCH

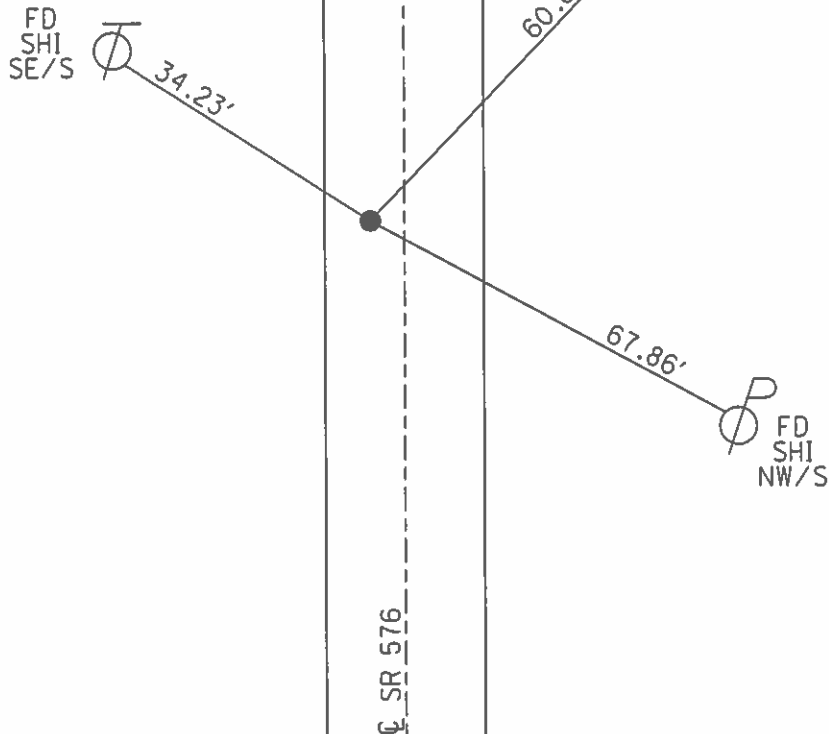

O.D.O.T. DISTRICT 2 SURVEY OFFICE

PERSONNEL

REFERENCE NO. 6-A

SHEET 8 OF 16

NOTES VAN DUSEN

H.C. CORDES

DATE 6-10-93

ROUTE 576

R.C. BARNHISEL III

WEATHER Cloudy

COUNTY WILLIAMS

OTTO

TEMP. +60°

TOWNSHIP CENTER

SECTION 23

T. 6 NR. 2 E


TYPE MONUMENT Sm RR Spk

~~OUT SURFACE~~ - BELOW 1 1/2"


LEFT - E PAV'T. - ~~RESET~~ 5.2

6.1 TO LT EDGE PAVEMENT

S.L.M. 114+30

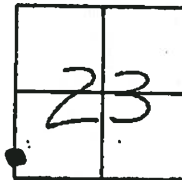

Reset P.K. & WASHER
8-24-93
MB

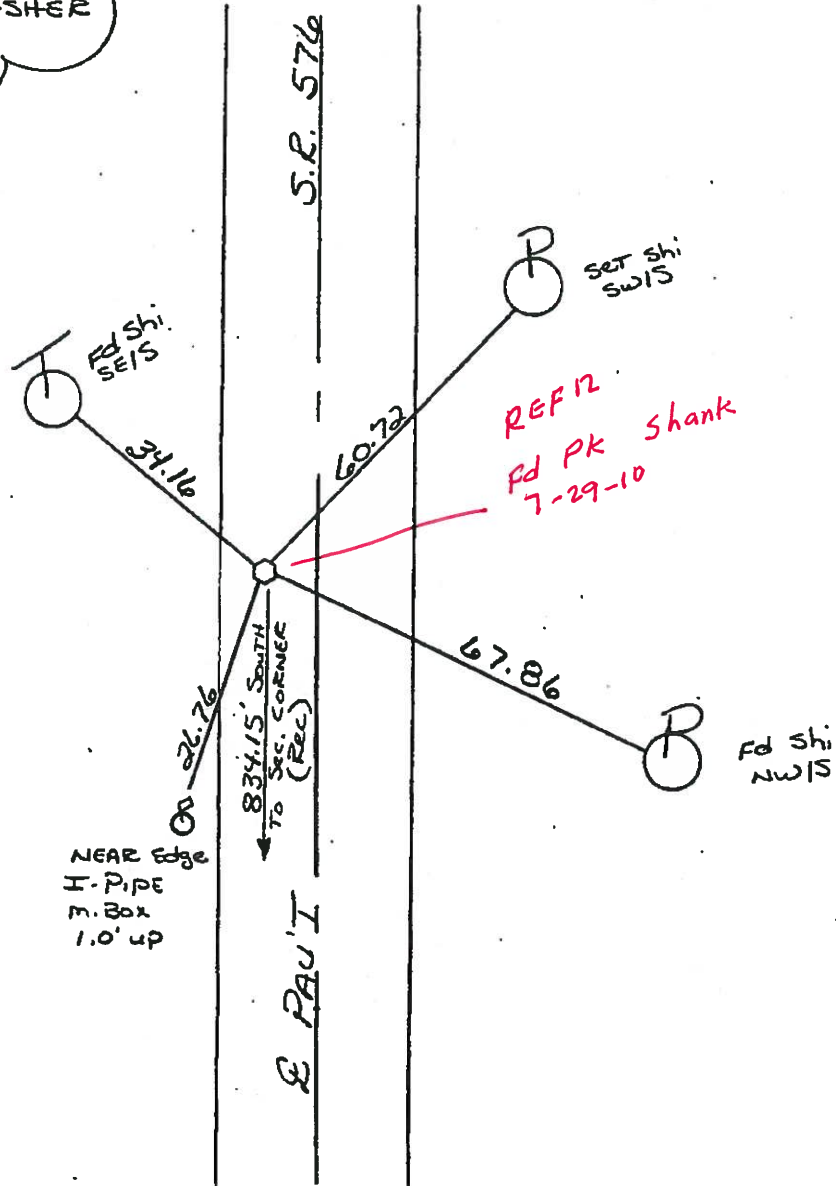

O.D.O.T. DISTRICT 2 SURVEY OFFICE

PERSONNEL

REFERENCE NO. 6-A



SHEET 7 OF

NOTES J. Stone
 H.C. D. Curtis
 R.C. R. Michalak
J. Hauscholder

DATE 6 Sept. 85
 WEATHER Rain
 TEMP. 75°

ROUTE SR #576
 COUNTY Williams
 TOWNSHIP Center
 SECTION 23
 T R

TYPE MONUMENT PK Nail 8-20-85
 ON SURFACE - BELOW on surf.
 LEFT - ☉ PAV'T. - RIGHT
 TO EDGE PAVEMENT
 S.L.M. 114+30±

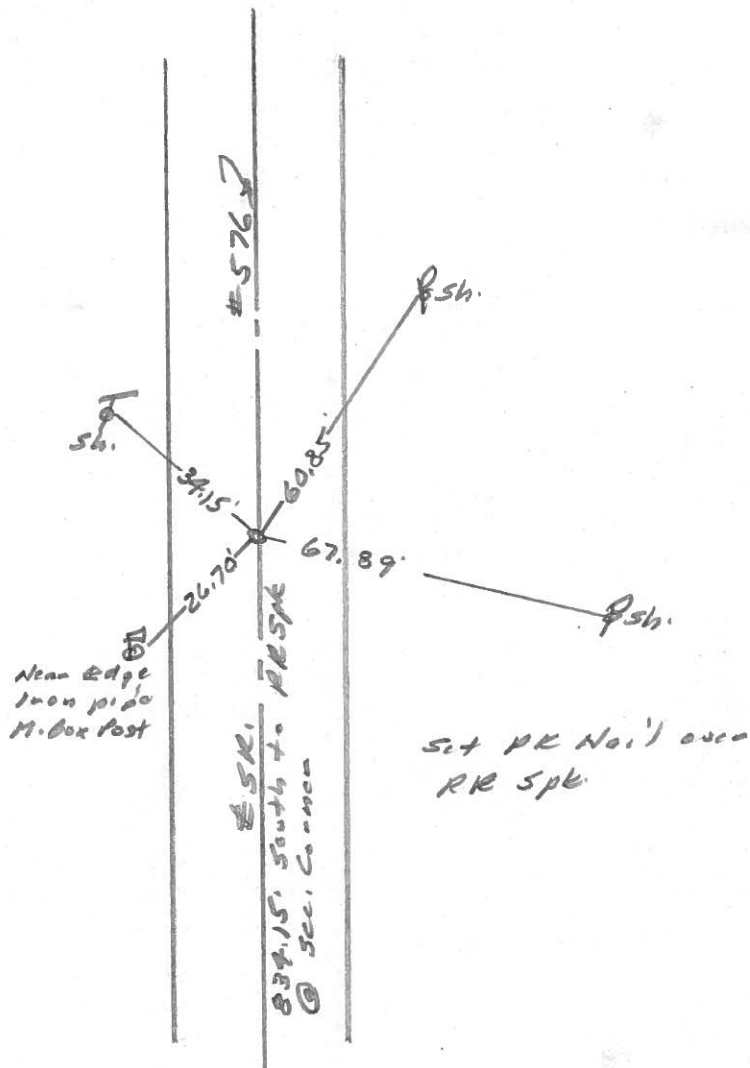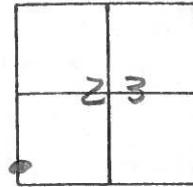

County Williams S.R. 576

Date 19 Jan. 82

Township Center

Weather Cold

Section 23

Temp. 15°


T N, R E

Personnel 1. Stone

P. Newson

R. Nicholas

D. Curtis

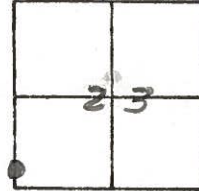

REF. NO. **6-A**

