

O.D.O.T. DISTRICT 2 SURVEY OFFICE (USE ONLY)

PERSONNEL

REFERENCE NO. 7

SHEET 13 OF 14

NOTES RHOADES

DATE 8/5/22

ROUTE SR 576

H.C. RHOADES

WEATHER CLOUDY

COUNTY WILLIAMS

R.C. WHITAKER

TEMP. 73°

TOWNSHIP CENTER

DWG BY RHOADES PID PAVETRAIN

SECTION 23

T 6 N R 2 E

TYPE MONUMENT P.K./WASHER

ON SURFACE - ~~BELOW~~ ON

OFFSET \varnothing PAVEMENT ON LT : RT

10.1' TO LT EDGE PAVEMENT


STATION: 132+36

HORZ.DATUM: NAD83 2011


GEOID: NAVD88 2018

GRID: NORTHING: 661514.104

EASTING: 1389461.791

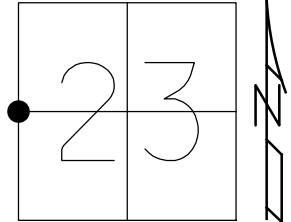


RECORD:
 SET P.K.NAIL
 OVER R.R.SPIKE
 9-6-85
 SET P.K./WASHER
 8-24-93, MB
 FD R.R.SPIKE
 REF13
 7-6-12, DCH
 SET PK/WASHER
 NEWREF13
 7-26-12, DCH
 FD P.K./WASHER
 REF7
 8/5/22,
 2/2/23, JMR

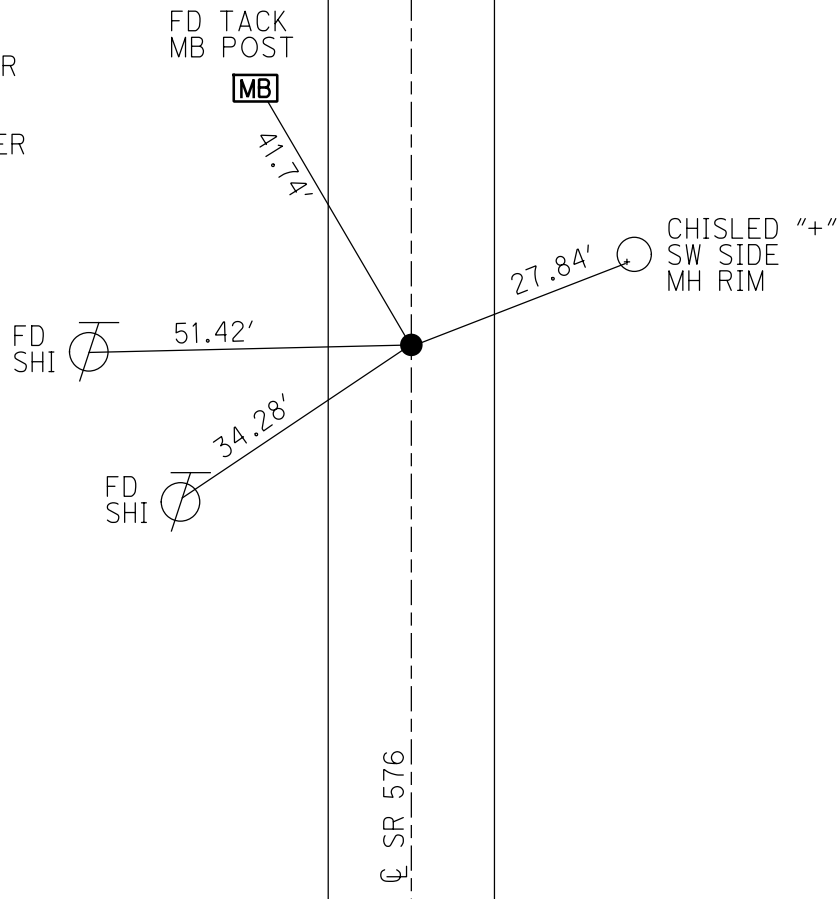

O.D.O.T. DISTRICT 2 SURVEY OFFICE (USE ONLY)

PERSONNEL _____ REFERENCE NO. 7 SHEET 13 OF 14
 NOTES HOMAN DATE 7-6-12 ROUTE SR 576
 H.C. HOMAN WEATHER SUNNY COUNTY WILLIAMS
 R.C. HARBAUGH TEMP. 85° TOWNSHIP CENTER
 SECTION 23
 T 6 N R 2 E

TYPE MONUMENT RR SPIKE
~~ON SURFACE~~ - BELOW 2"
~~LEFT~~ - ℄ PAV'T - ~~RIGHT~~ ON _____
10.1 TO LT EDGE PAVEMENT
 S.L.M. 132+36
 Grid: Northing: 661514.138 Easting: 1389461.771

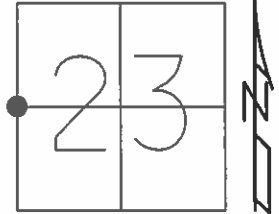


SET PK NAIL OVER
 FD RR SPIKE
 9-06-85

RESET PK/WASHER
 8-24-93, MB

FD PK
 REF13
 7-06-12, DCH

GPS, NEWREF13
 SET PK/WASHER
 7-26-12, DCH

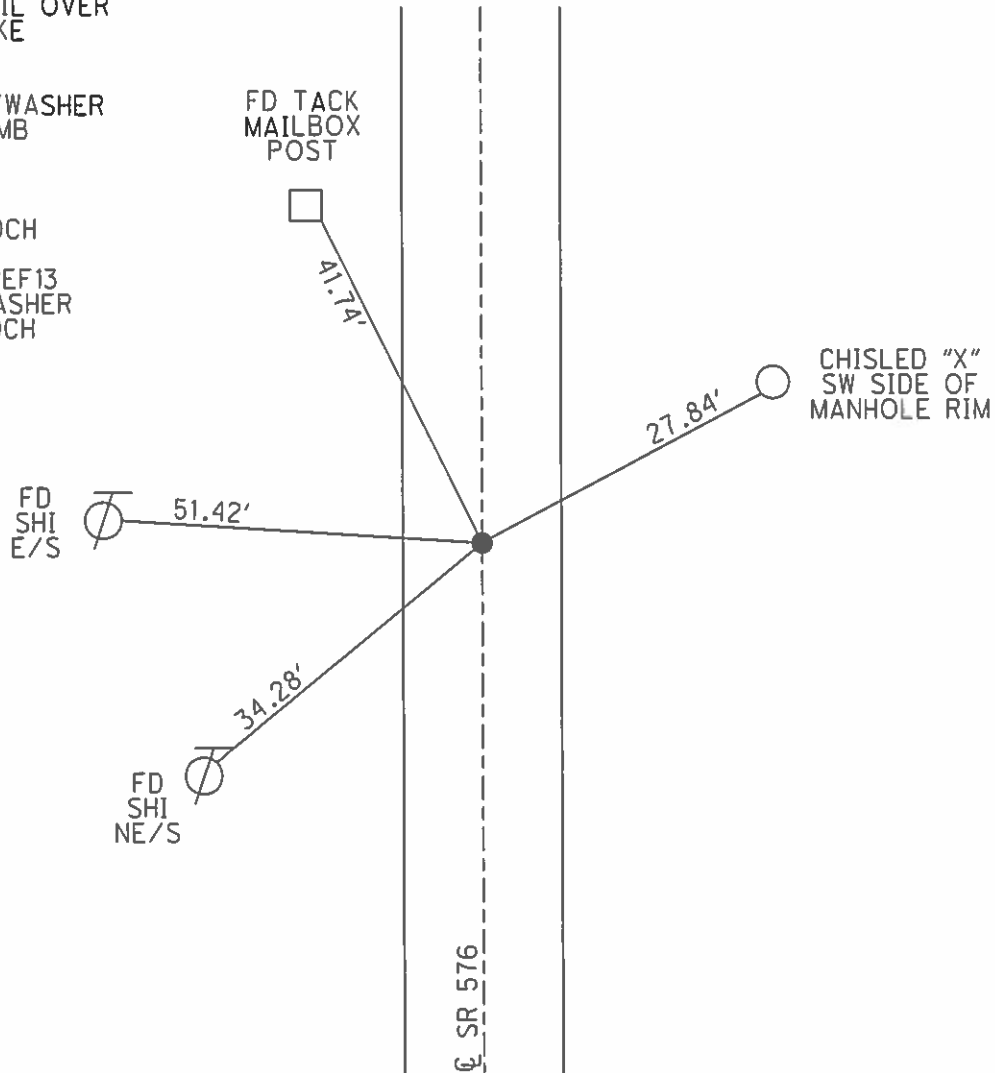

O.D.O.T. DISTRICT 2 SURVEY OFFICE

PERSONNEL

REFERENCE NO. 7

SHEET 9 OF 16

NOTES VAN DUSEN

H.C. CORDS

R.C. BARNHISEL

OTTO

DATE 6-10-93

WEATHER Cloudy

TEMP. +60°

ROUTE S.R. # 576

COUNTY Williams

TOWNSHIP Center

SECTION 23

T6 NR 2 E


TYPE MONUMENT P.K. nail

ON SURFACE - ~~stone~~ yes


~~stone~~ - & PAV'T. - ~~stone~~ yes

10.1 TO LT EDGE PAVEMENT

S.L.M. 132 + 36

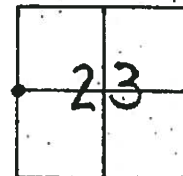

Reset PK & WASHER
8-24-93
MB

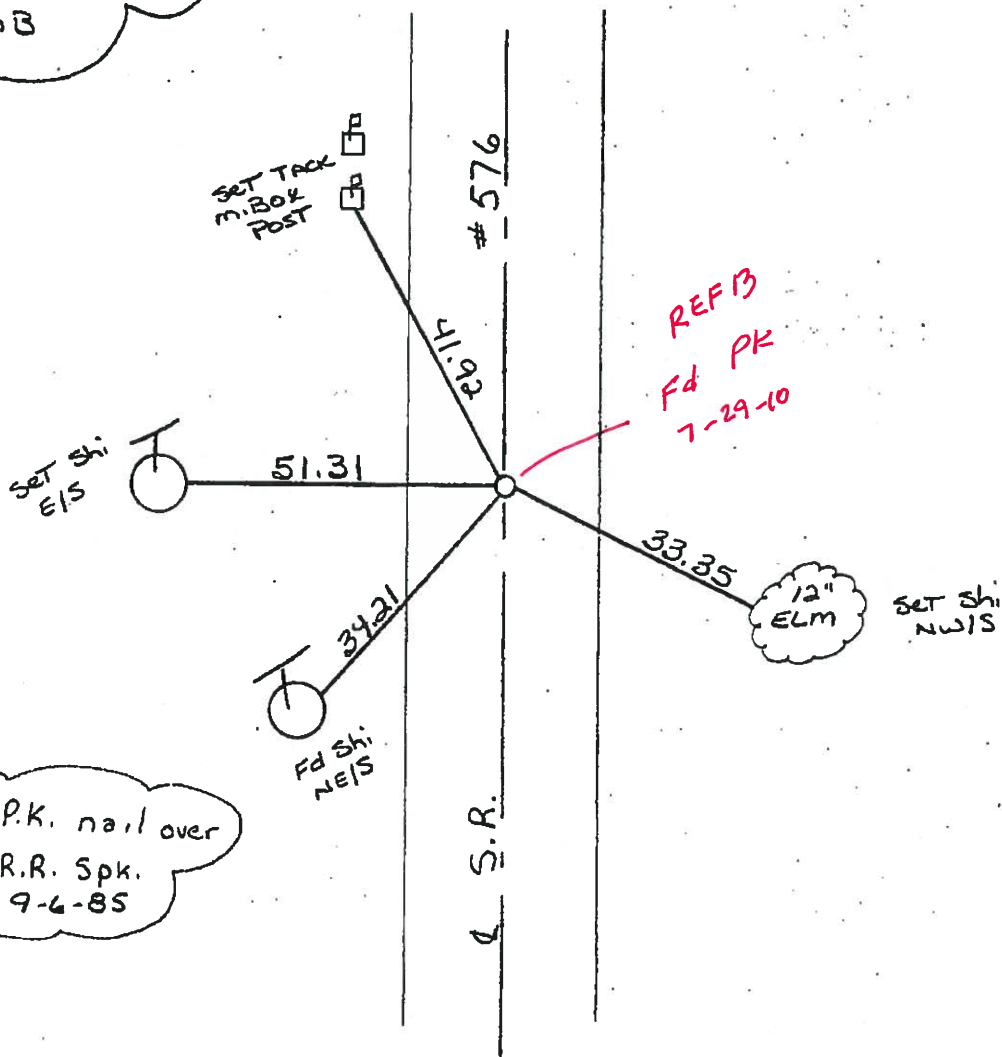

Set. P.K. nail over
Fd. R.R. Spk.
9-6-85

O.D.O.T. DISTRICT 2 SURVEY OFFICE

PERSONNEL _____

REFERENCE NO. 7

SHEET 8 OF _____

NOTES 1. Stone

H.C. D. Curtis

R.C. R. Michalak

J. Householder

DATE 6 Sept. 85

WEATHER Rain

TEMP. 75°

ROUTE SR #576

COUNTY Williams

TOWNSHIP Center

SECTION _____

T. _____ R. _____



TYPE MONUMENT PK Nail 8-20-85

ON SURFACE - BELOW on surf.

LEFT - & PAW'T. - RIGHT _____

TO _____ EDGE PAVEMENT

S.L.M. _____

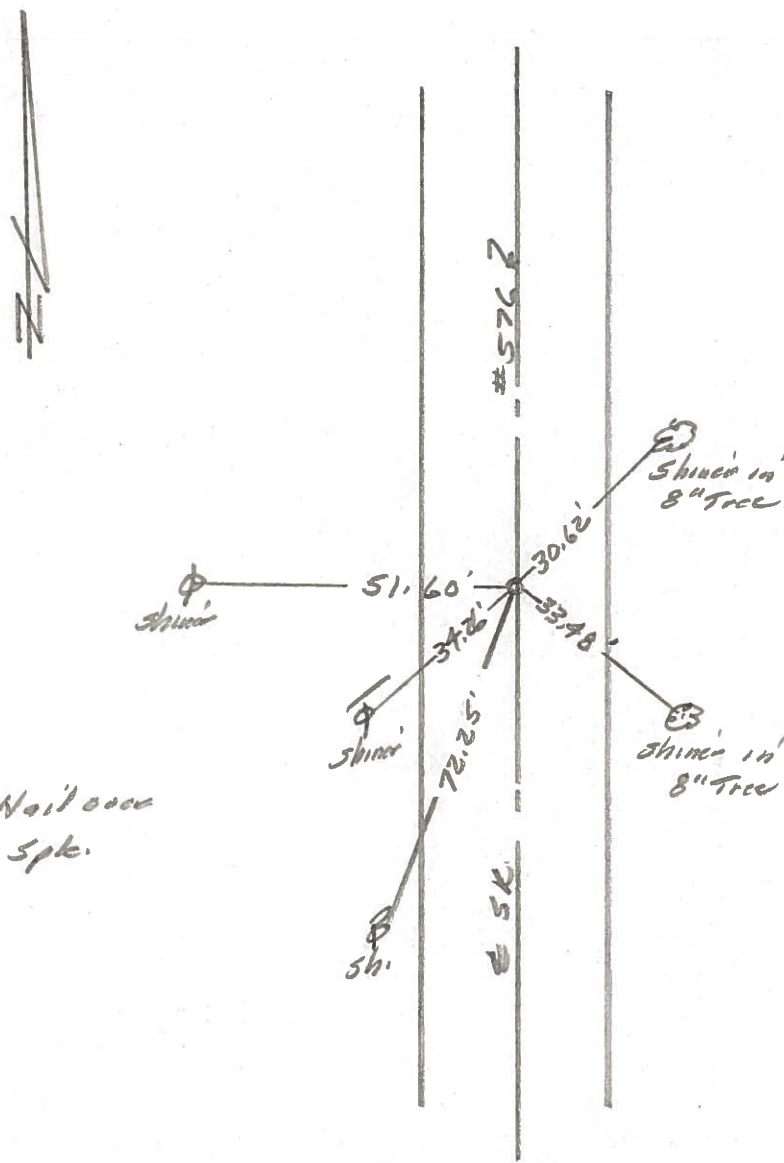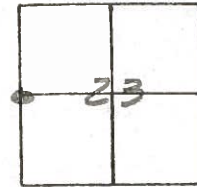

Set PK Nail 0000
Ed. RR Spk.

County Williams S.R. 576

Date 19 Jan. 82

Township Leato

Weather Cold

Section 23

Temp. 20°


T N, R E

Personnel I. Stone


P. Neuser

R. Michalek

D. Curtis

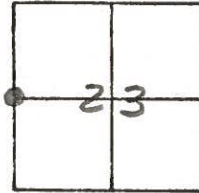

REF. NO. 7

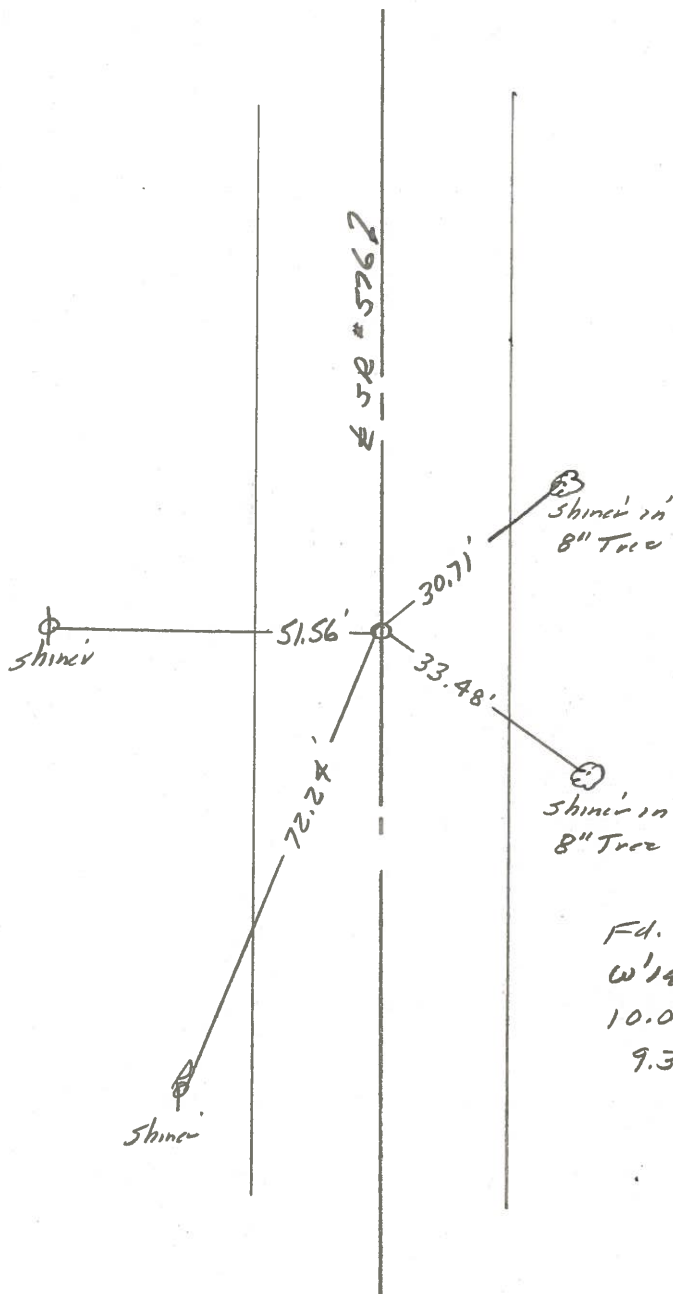

Fd. RR Spk. To surface
 w/14 Cov. Sec. 23
 10.0' to E. edge put.
 9.3' to W. edge put.

O.D.O.T. DISTRICT 2 SURVEY OFFICE

SHEET 8 OF

County Williams S.R. 576

Date 18 Aug, 80

Township Zenon

Weather Cloudy

Section 23

Temp. 76°


T N, R E

Personnel L. Stone


R. Michalak

P. Neuser

D. Curtis

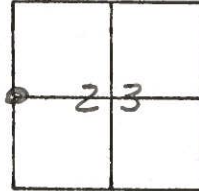

REF. NO. 7

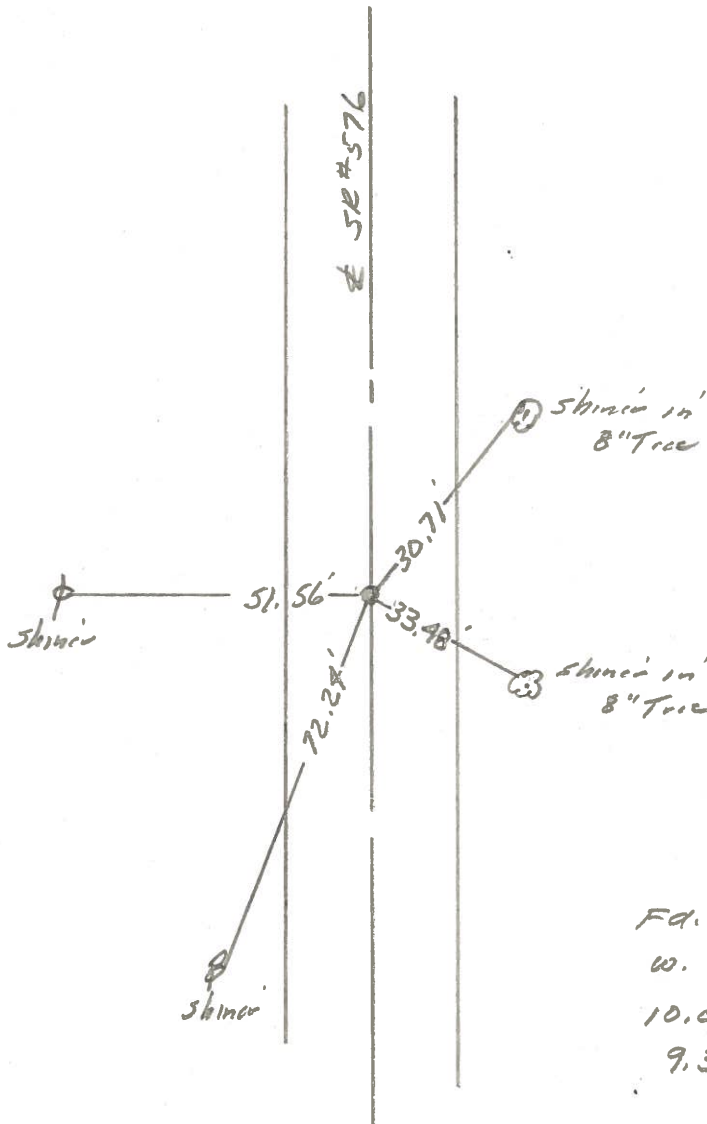

FD. RR Spk. To Surface.
W. 1/4 Cor. Sec. 23
10.0' to E. edge pt.
9.3' to W. edge pt.

PERSONNEL TITLE PERSONNEL TITLE

Louys
Hoover
Beach

COUNTY Wi: DATE 4-7-50

S. R. 576 WEATHER Fair


SEC Defiance Co. Line to Rt. 34 TEMP. 50°

DESCRIPTION Witnesses to Control Points JOB NO. _____


LEFT CENTER LINE RIGHT

⑧


162. Sta. 157+47.81
R.R. Spk

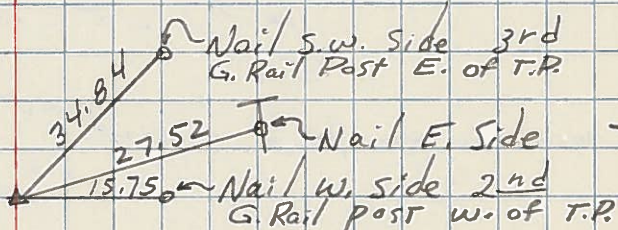


161 Sta. 156+71.60
ADD

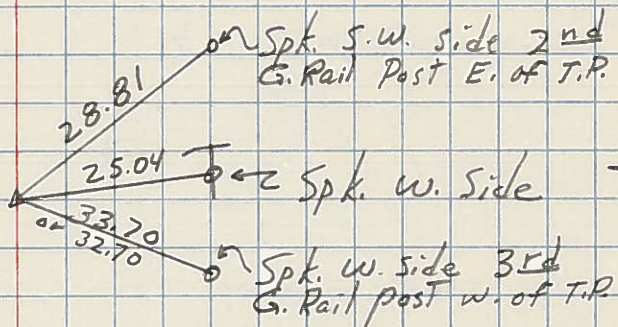

160 Sta. 155+00.00
ADD

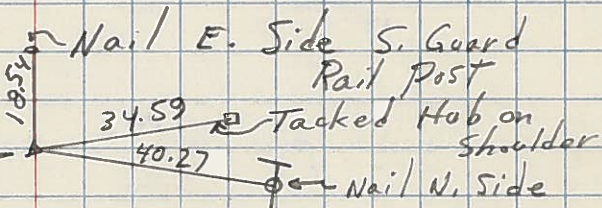

159 Sta. 145+73.65
ADD

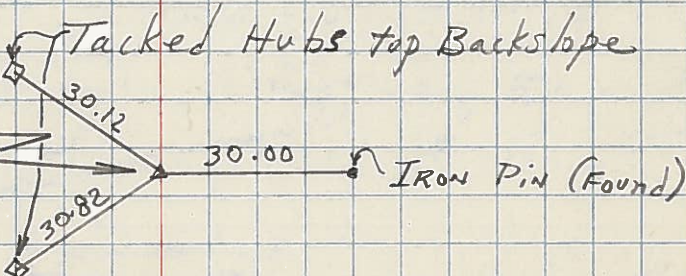

158 ⑦
Sta. 132+36.60

