

O.D.O.T. DISTRICT 2 SURVEY OFFICE (USE ONLY)

PERSONNEL

REFERENCE NO. 10 A

SHEET 10 OF 29

NOTES RHOADES

DATE 7-1-20

ROUTE SR 576

H.C. AUBLE

WEATHER SUNNY

COUNTY WILLIAMS

R.C. MAHLER

TEMP. 81°F

TOWNSHIP CENTER

LEU

DWG BY MAHLER

PID PAVETRAIN

SECTION 11

T 6 N R 2 E

TYPE MONUMENT MAG/WASHER

ON SURFACE - ~~BELOW~~ ON

OFFSET ☉ PAVEMENT ON LT : RT

- TO - EDGE PAVEMENT


STATION: 228+88.42

HORZ.DATUM: NAD83 2011


GEOID: NAVD88 2018

GRID: NORTHING: 671167.414

EASTING: 1389631.048

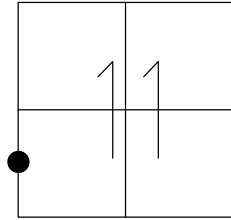

NOTE: REF28D SR 34

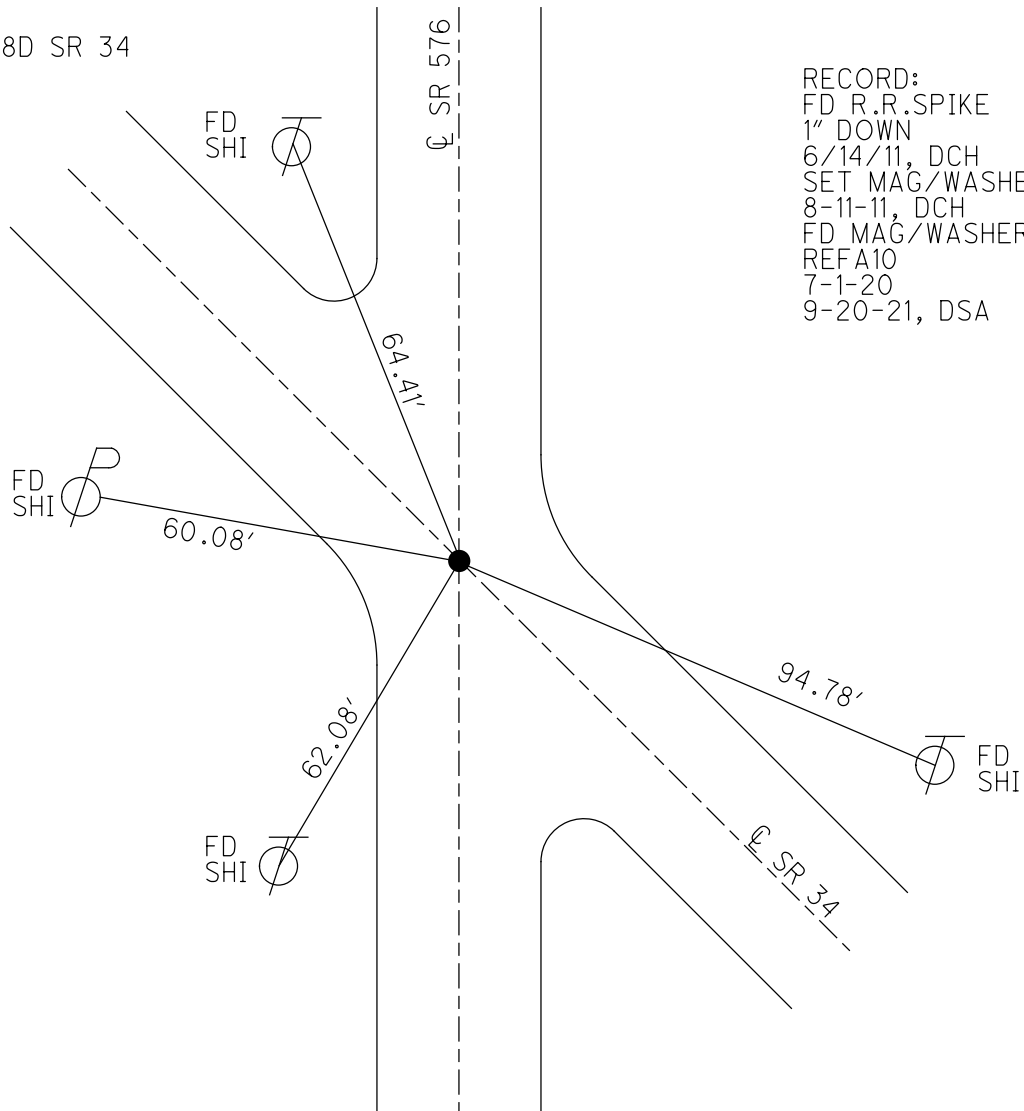

RECORD:
 FD R.R.SPIKE
 1" DOWN
 6/14/11, DCH
 SET MAG/WASHER
 8-11-11, DCH
 FD MAG/WASHER
 REFA10
 7-1-20
 9-20-21, DSA

O.D.O.T. DISTRICT 2 SURVEY OFFICE USE ONLY

PERSONNEL

REFERENCE NO. 10 A

SHEET 8 OF 27

NOTES HOMAN

DATE 6-14-11

ROUTE SR 576

H.C. HOMAN

WEATHER SUNNY

COUNTY WILLIAMS

R.C. ROUSOS

TEMP. 75°

TOWNSHIP CENTER

SECTION 11

(REF 29 ON SR34)

T 6 N R 2 E

TYPE MONUMENT RR SPIKE


~~ON SURFACE~~ - BELOW 1"

~~LEFT - C PAV'T - RIGHT~~ ON


TO EDGE PAVEMENT

S.L.M. 228+88

Grid: Northing: 671167.496 Easting: 1389630.955

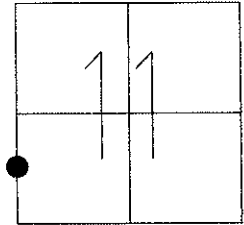

SET MAG NAIL
& WASHER
9-2-11
DCH

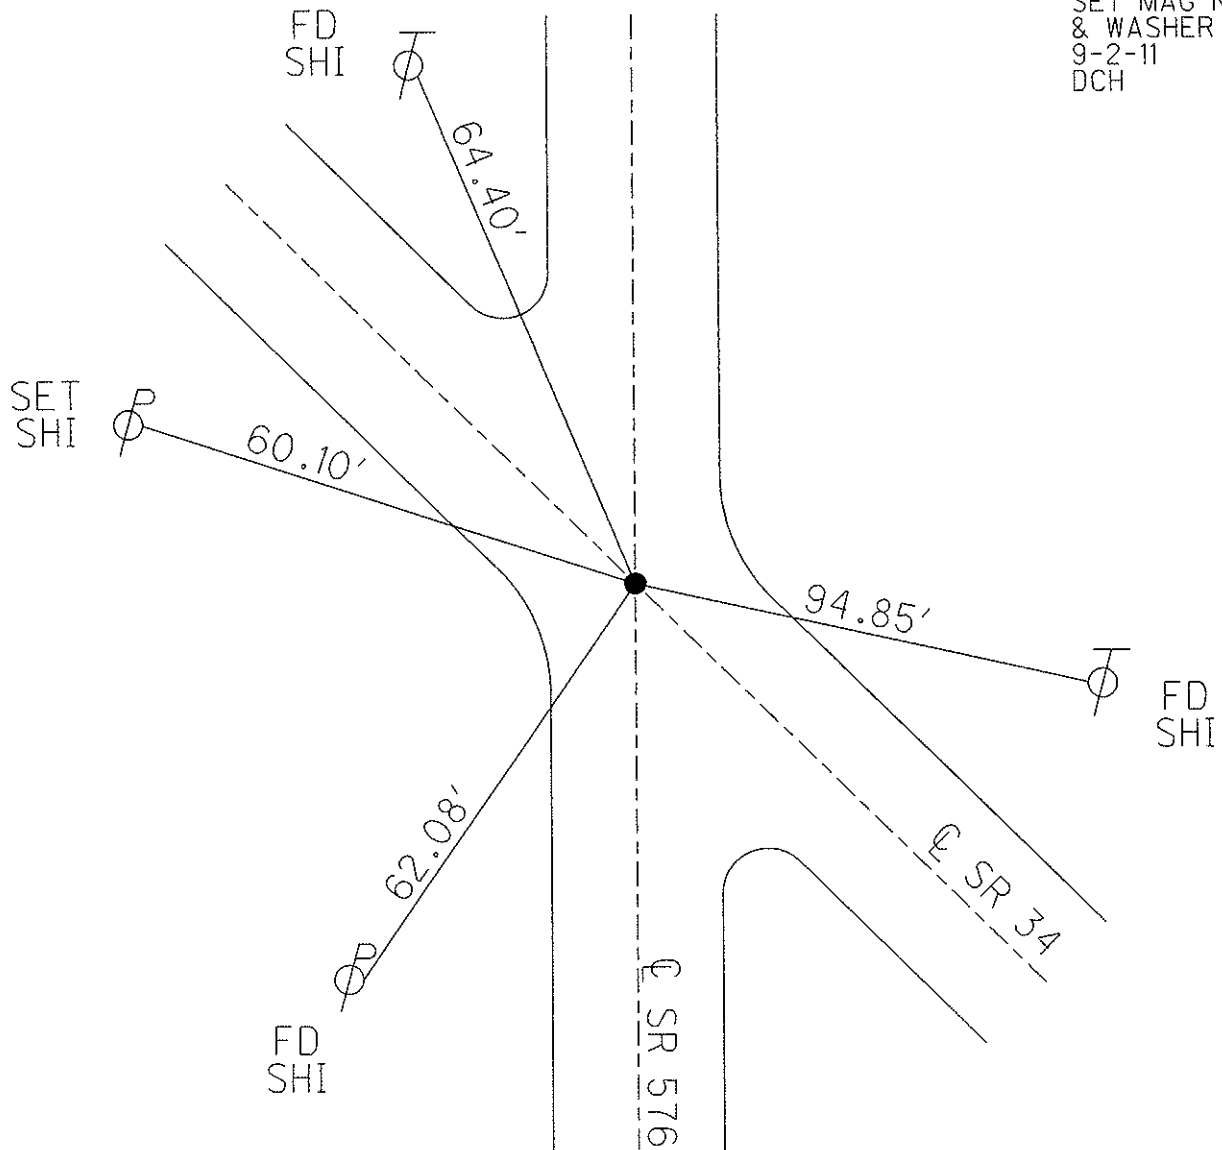

O.D.O.T. DISTRICT 2 SURVEY OFFICE



PERSONNEL

NOTES NUHFER
 H.C. MIKLOVIC
 R.C. HUSS

REFERENCE NO. 29
 DATE 7-10-06
 WEATHER SUNNY
 TEMP. +75°

SHEET 3 OF 5
 ROUTE SR34&SR576
 COUNTY WILLIAMS
 TOWNSHIP CENTER
 SECTION 11
 T 6 N R 2 E

TYPE MONUMENT SM. RR SPIKE
~~ON SURFACE~~ - BELOW 2" DOWN
~~LEFT - C PAV'T - RIGHT~~ C
TO EDGE PAVEMENT
 S.L.M. SR34=708+35, SR576=229+54.93

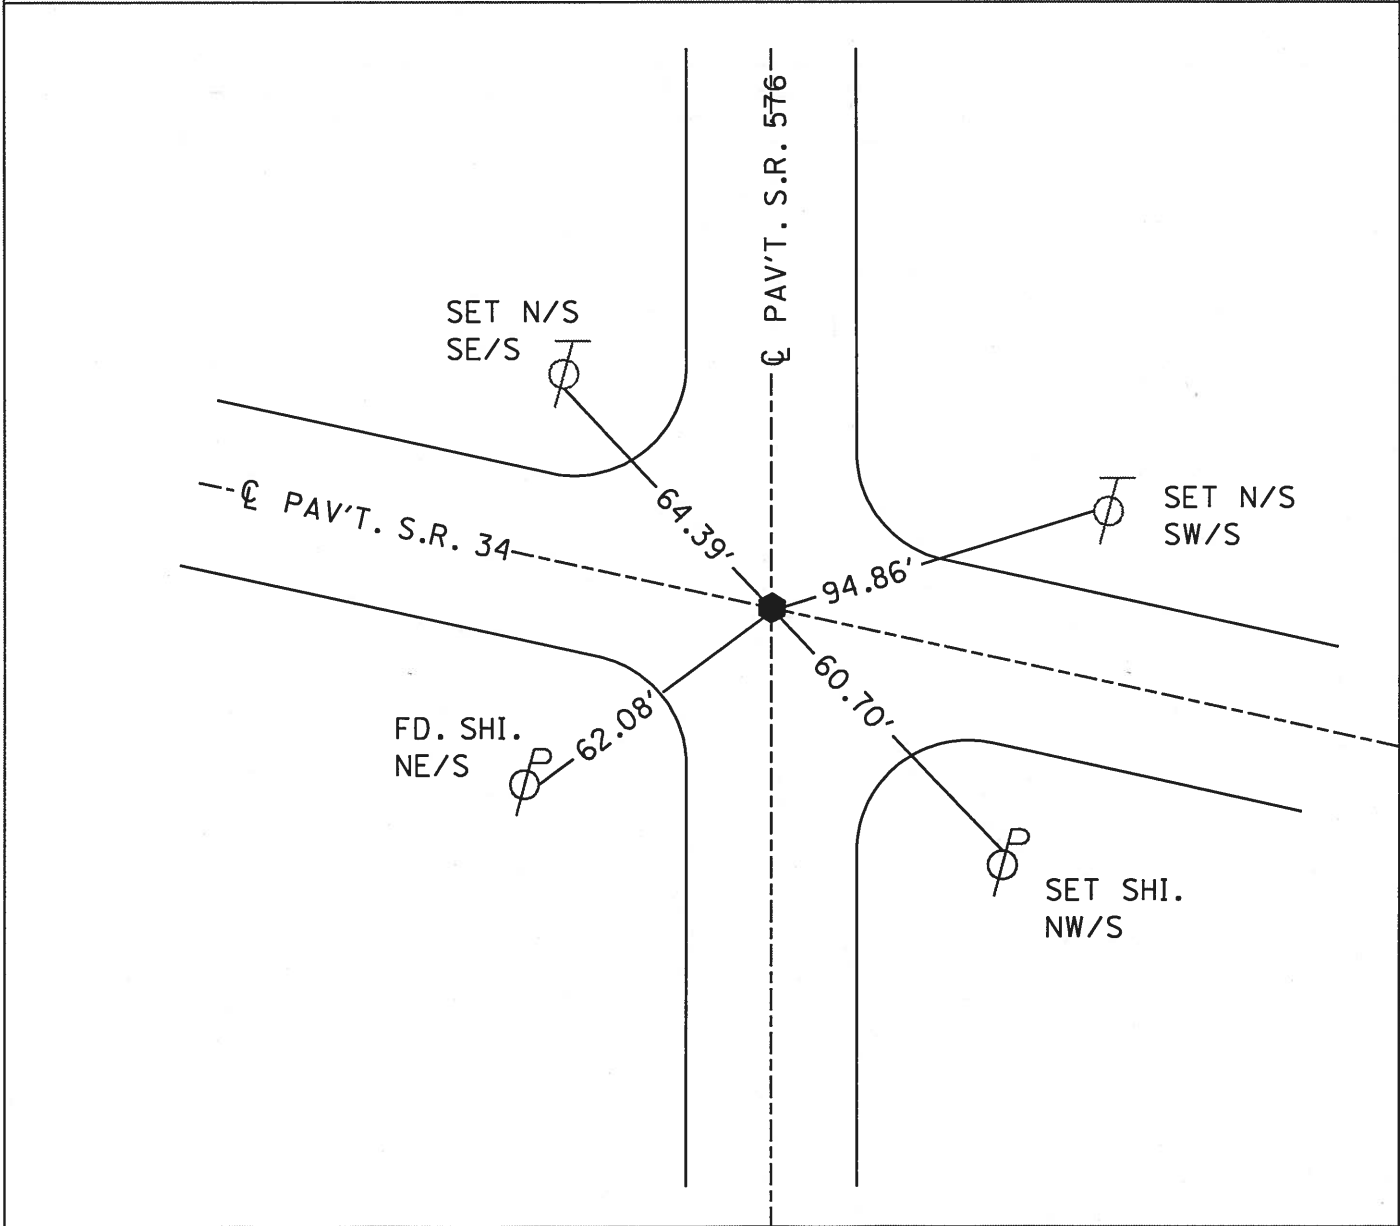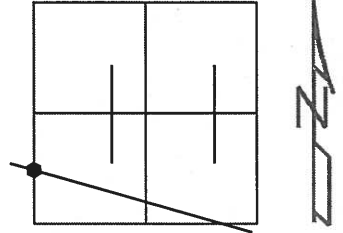

O.D.O.T. DISTRICT 2 SURVEY OFFICE

PERSONNEL

REFERENCE NO. 29 ON 5234 SHEET OF
10-A ON 52370

NOTES VAN DUWEN

H.C. MOJER

DATE 2-21-95

ROUTE SR. 34 & 576

R.C. BARNHISEL

WEATHER CLOUDY

COUNTY WILLIAMS

CORDES

TEMP. +25° F

TOWNSHIP CENTER

SECTION 11

T. 6 N. R. 2 E



TYPE MONUMENT 5m. R.R. SPK.

ON SURFACE - BELOW YES

LEFT - ☉ PAV'T. - RIGHT

 TO EDGE PAVEMENT

S.L.M. SR. 34 = 708+35, SR. 576 = 229+54.93

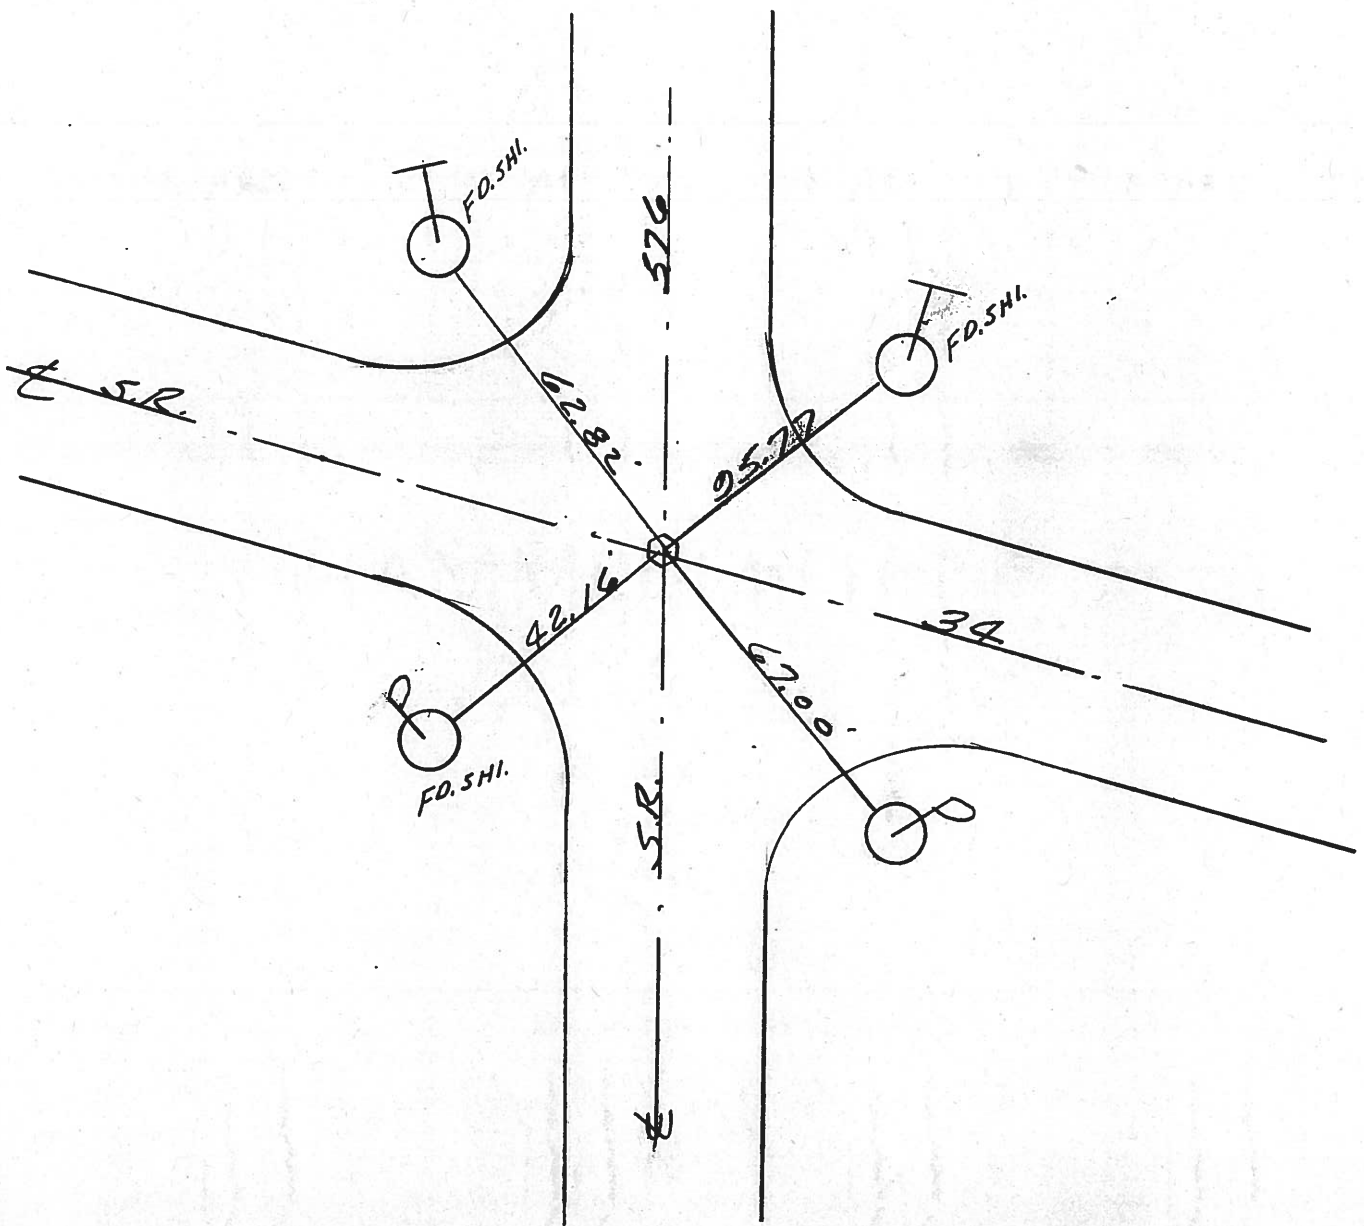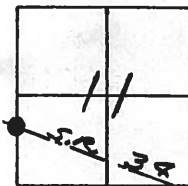

O.D.O.T. DISTRICT 2 SURVEY OFFICE

PERSONNEL _____

REFERENCE NO. 10-A

SHEET 1 OF 19

NOTES D. CURTIS

H.C. J. HOUSEHOLDER

DATE 9-29-86

ROUTE 576

R.C. _____

WEATHER WARM

COUNTY WILLIAMS

TEMP. 75°

TOWNSHIP CENTER

SECTION 11

T _____ R _____


TYPE MONUMENT R.R. SPK.

ON SURFACE - BELOW 1 1/2" BELOW


LEFT- & PAV'T. - RIGHT 1.5' N. OF S.R. 34 PAVT.

TO _____ EDGE PAVEMENT

S.L.M. _____

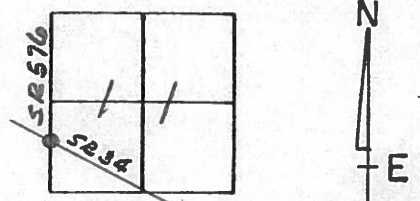

OK 7/20/88 IRS

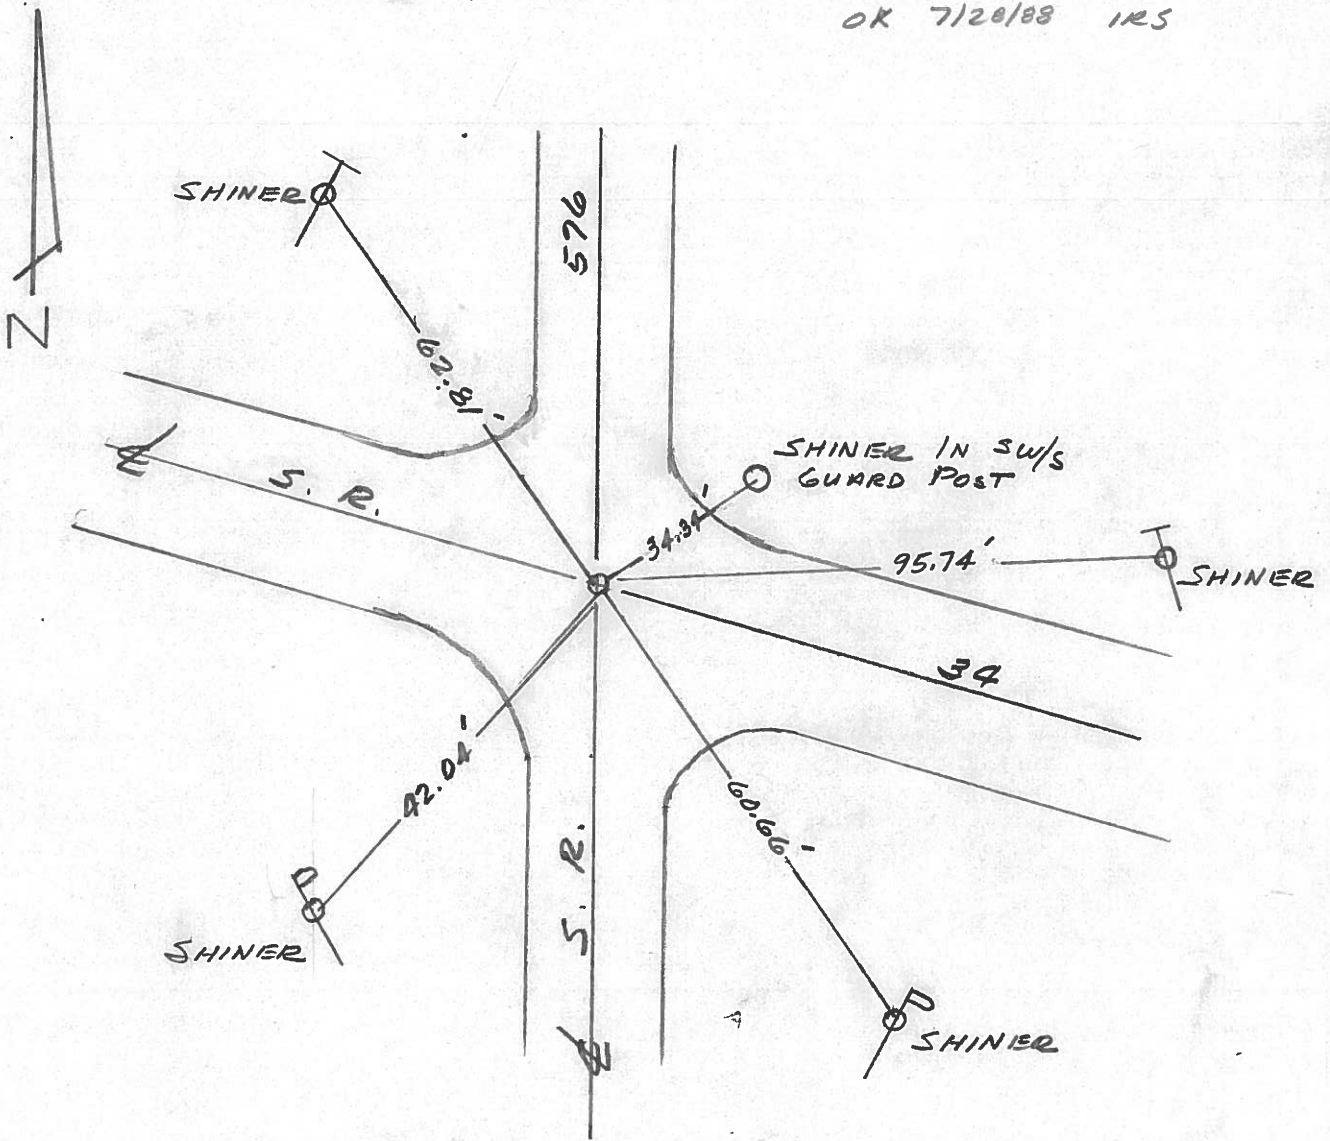

Q.D.O.T. DISTRICT 2 SURVEY OFFICE

SHEET _____ OF _____

County Williams S.R. 576

Township CENTER

Section 11

T, N, R, E

Personnel HOFFMAN

Householder

Loehrke


Barnhisel

#10-A

Date Nov 29, 82

Weather OVERCAST

Temp. +38°

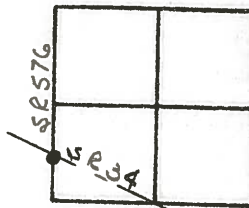

Fd R.R. spk 1 1/2" Below surface
1.5' N. of & PAUT S.R. 34

