

O.D.O.T. DISTRICT 2 SURVEY OFFICE (USE ONLY)

PERSONNEL

REFERENCE NO. 14

SHEET 16 OF 29

NOTES MAHLER

DATE 7-1-20

ROUTE SR 576

H.C. LEU

WEATHER SUNNY

COUNTY WILLIAMS

R.C. MAHLER

TEMP. 75°F

TOWNSHIP CENTER

SECTION 2

DWG BY MAHLER PID PAVETRAIN

T 6 N R 2 E

TYPE MONUMENT MAG/WASHER

ON SURFACE - ~~BELOW~~ ON

OFFSET \odot PAVEMENT 19.7' ~~ET~~ : RT

- TO - EDGE PAVEMENT


STATION: 317+21.40

HORZ. DATUM: NAD83 2011


GEOID: NAVD88 2018

GRID: NORTHING: 679996.356

EASTING: 1389918.692

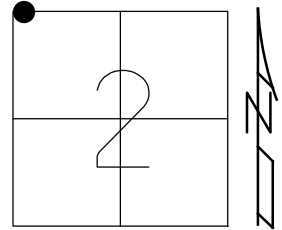


RECORD:
 FD P.K.NAIL
 6/14/11, DCH
 SET MAG/WASHER
 8-11-11, DCH
 FD MAG/WASHER
 REF14
 7-1-20, JLL
 9-20-21, DSA

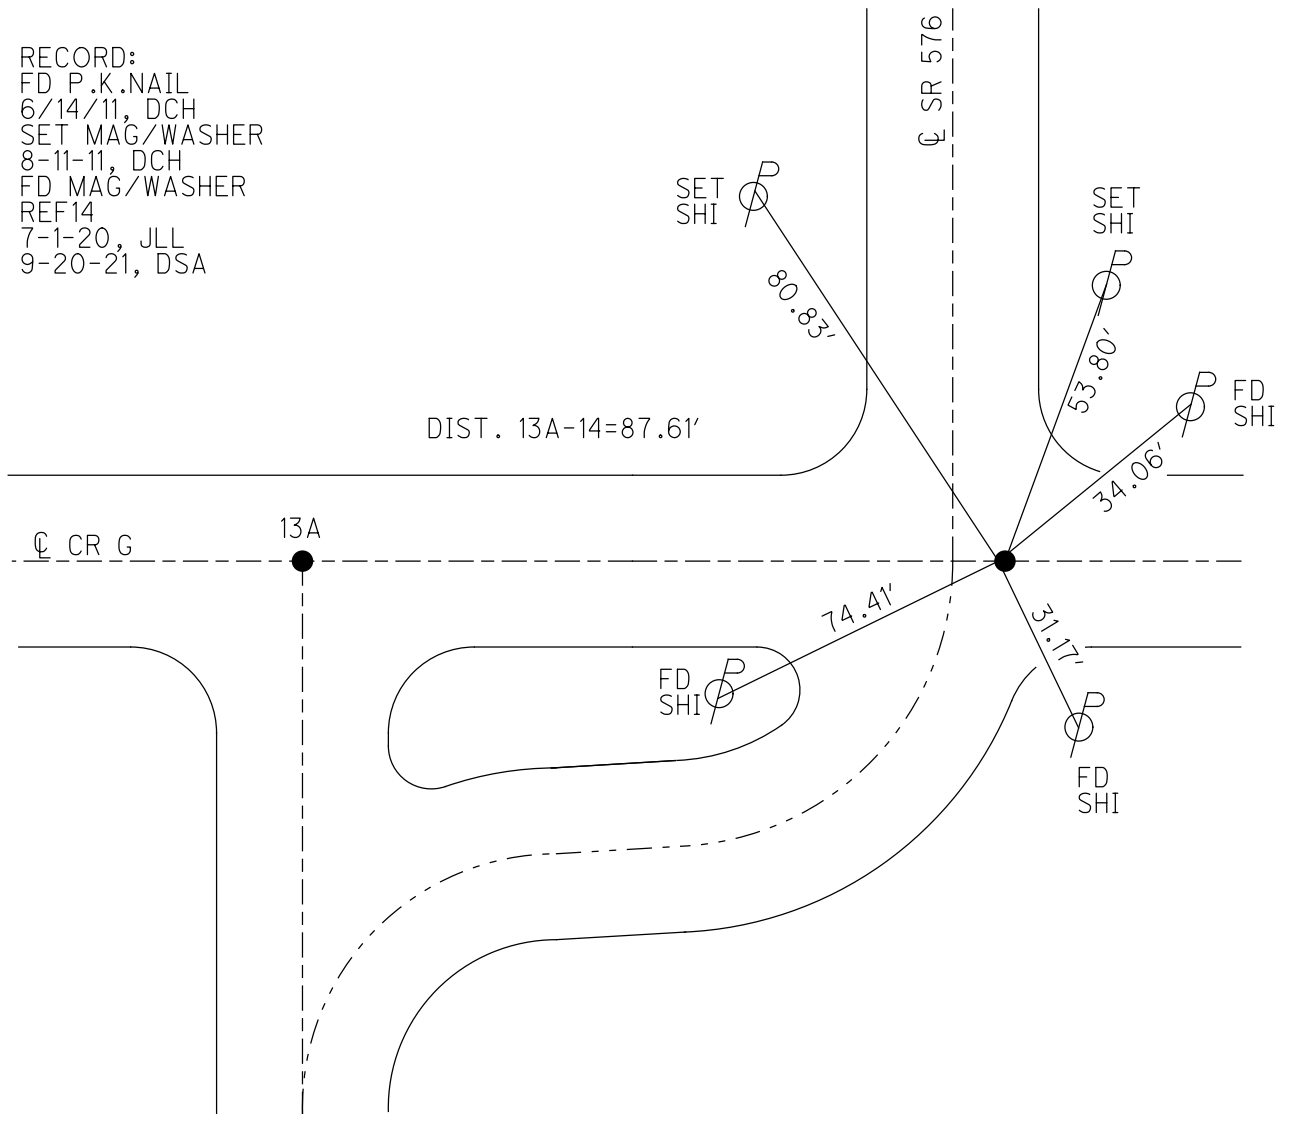

O.D.O.T. DISTRICT 2 SURVEY OFFICE USE ONLY


PERSONNEL	REFERENCE NO. <u>14</u>	SHEET <u>14</u> OF <u>27</u>
NOTES <u>HOMAN</u>	DATE <u>6-14-11</u>	ROUTE <u>S.R. 576</u>
H.C. <u>ROUSOS</u>	WEATHER <u>SUNNY</u>	COUNTY <u>WILLIAMS</u>
R.C. <u>HOMAN</u>	TEMP. <u>80°</u>	TOWNSHIP <u>CENTER</u>
		SECTION <u>2</u>
		T <u>6</u> N R <u>2</u> E

TYPE MONUMENT _____ PK _____
 ON SURFACE - ~~BELOW~~ _____ ON _____
~~LEFT~~ - Q PAV'T - RIGHT 19.7' _____
 - TO - EDGE PAVEMENT _____
 S.L.M. 317+21 _____

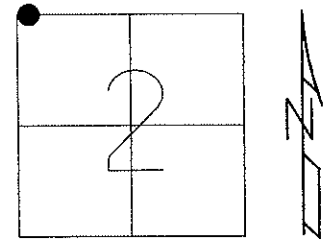

Grid: Northing: 679998.134 Easting: 1389831.082

SET MAG NAIL
 & WASHER
 8-11-11
 DCH

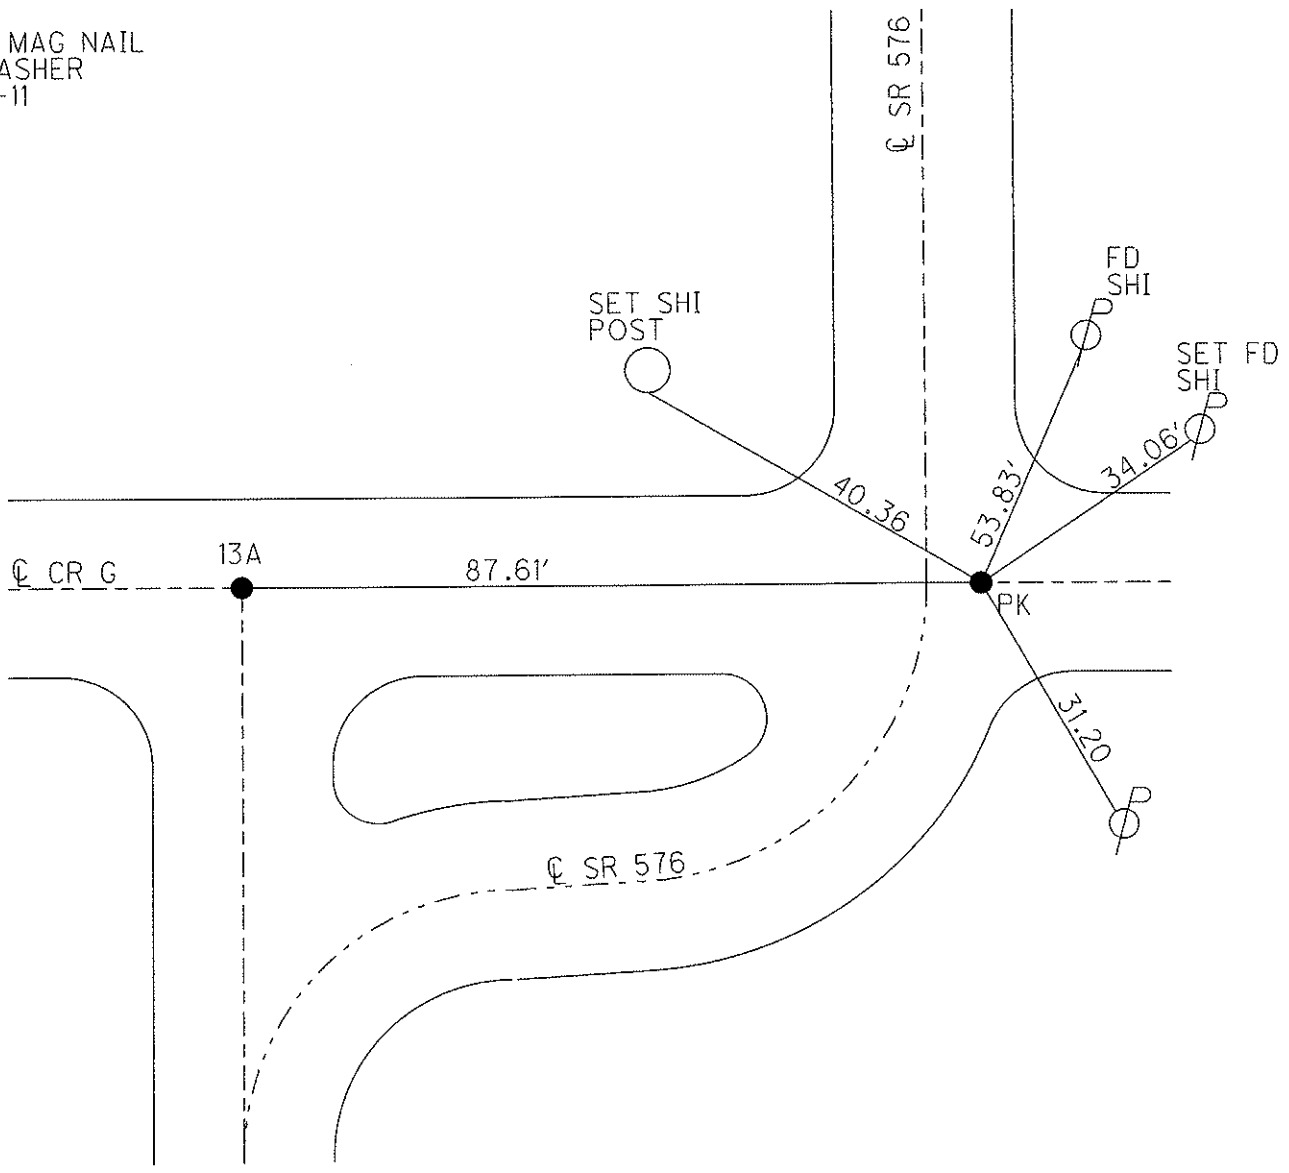

County Williams S.R. 576

Date 18 Aug. 80

Township SUPERIOR CENTER


Weather cloudy

Section 3-2 (CENTER)
34-35 (SUPERIOR)

Temp. 79°

T. N, R. E

Personnel J. Stone

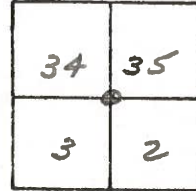


R. Michalak

P. Neuser

D. Curtis

REF. NO. 14

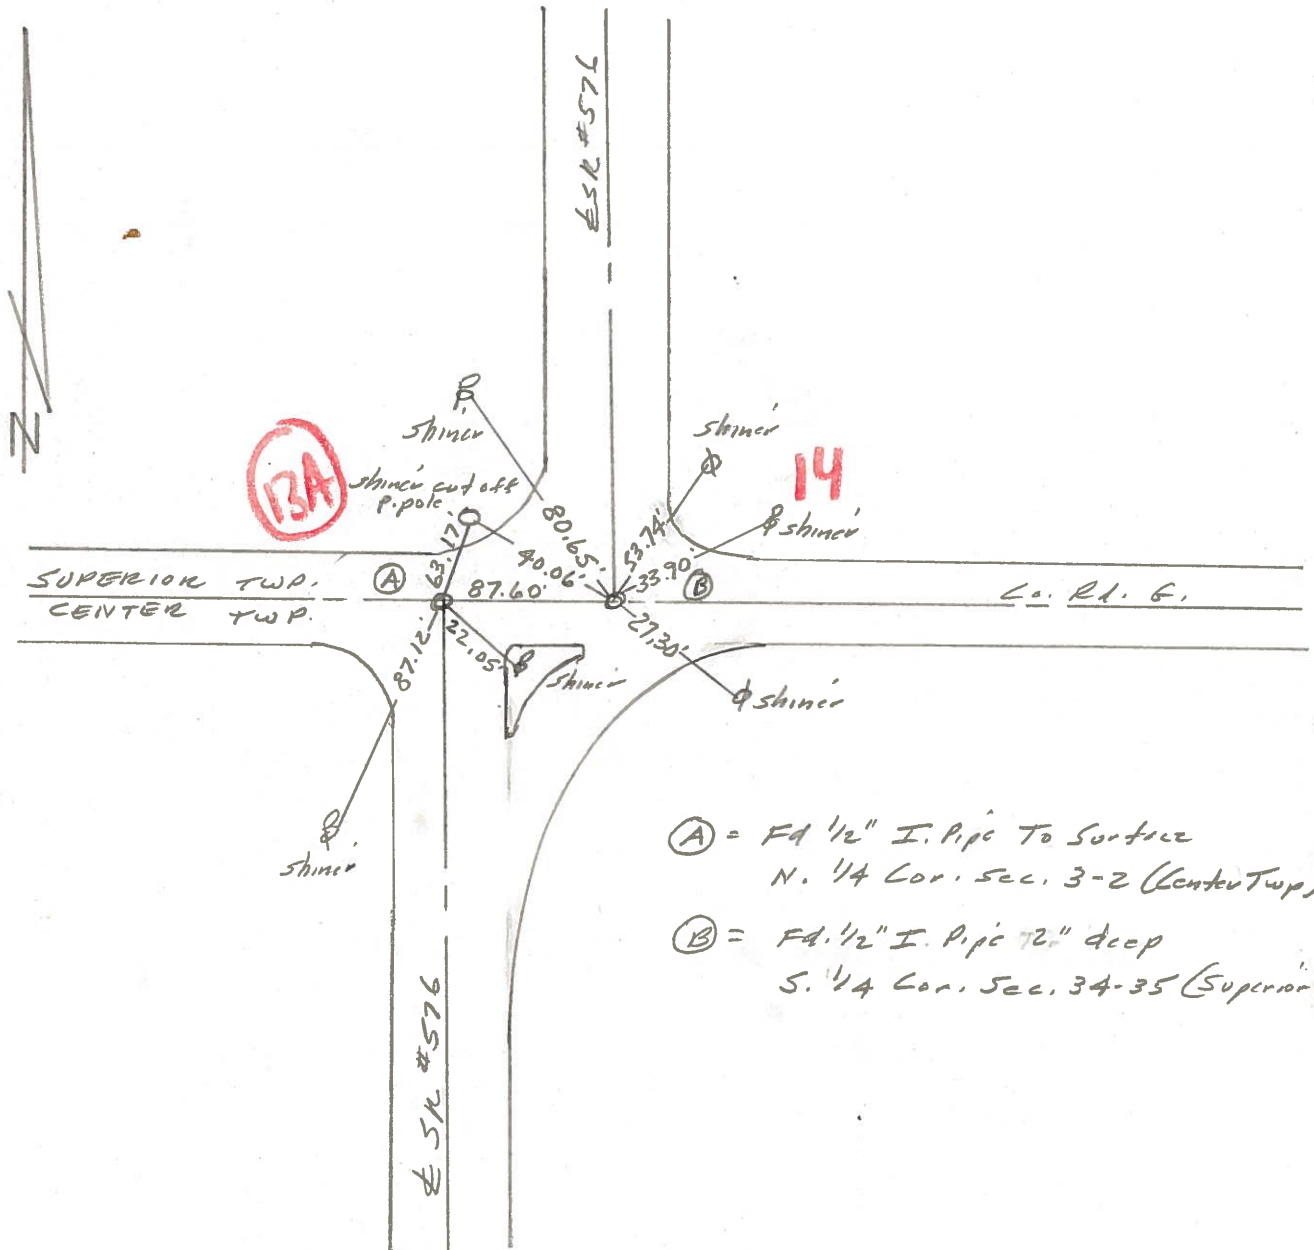

Ⓐ = Fd. 1/2" I. Pipe To Surface
N. 1/4 Cor. Sec. 3-2 (Center Twp)

Ⓑ = Fd. 1/2" I. Pipe 72" deep
S. 1/4 Cor. Sec. 34-35 (Superior Twp)

O.D.O.T. DISTRICT 2 SURVEY OFFICE

PERSONNEL _____

REFERENCE NO. 14

SHEET 4 OF 17

NOTES CANTERBURY

H.C. Rousos

DATE 5-23-97

ROUTE 576

R.C. BARNHISEL III

WEATHER SUNNY

COUNTY WILLIAMS

TEMP. +70°

TOWNSHIP CENTER

SECTION 2

T6 N R 2 E


TYPE MONUMENT P.K.'S

ON SURFACE - ~~BELOW~~ yes


LEFT- & PAW'T. - RIGHT "A" 67.7' LT & / "B" 19.7' RT &

- TO - EDGE PAVEMENT

S.L.M. 319+61

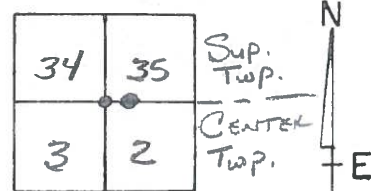

RESET PK/WASHER
 POINT "B"; "A" NOT
 COVERED
 8-20-97
 MRC

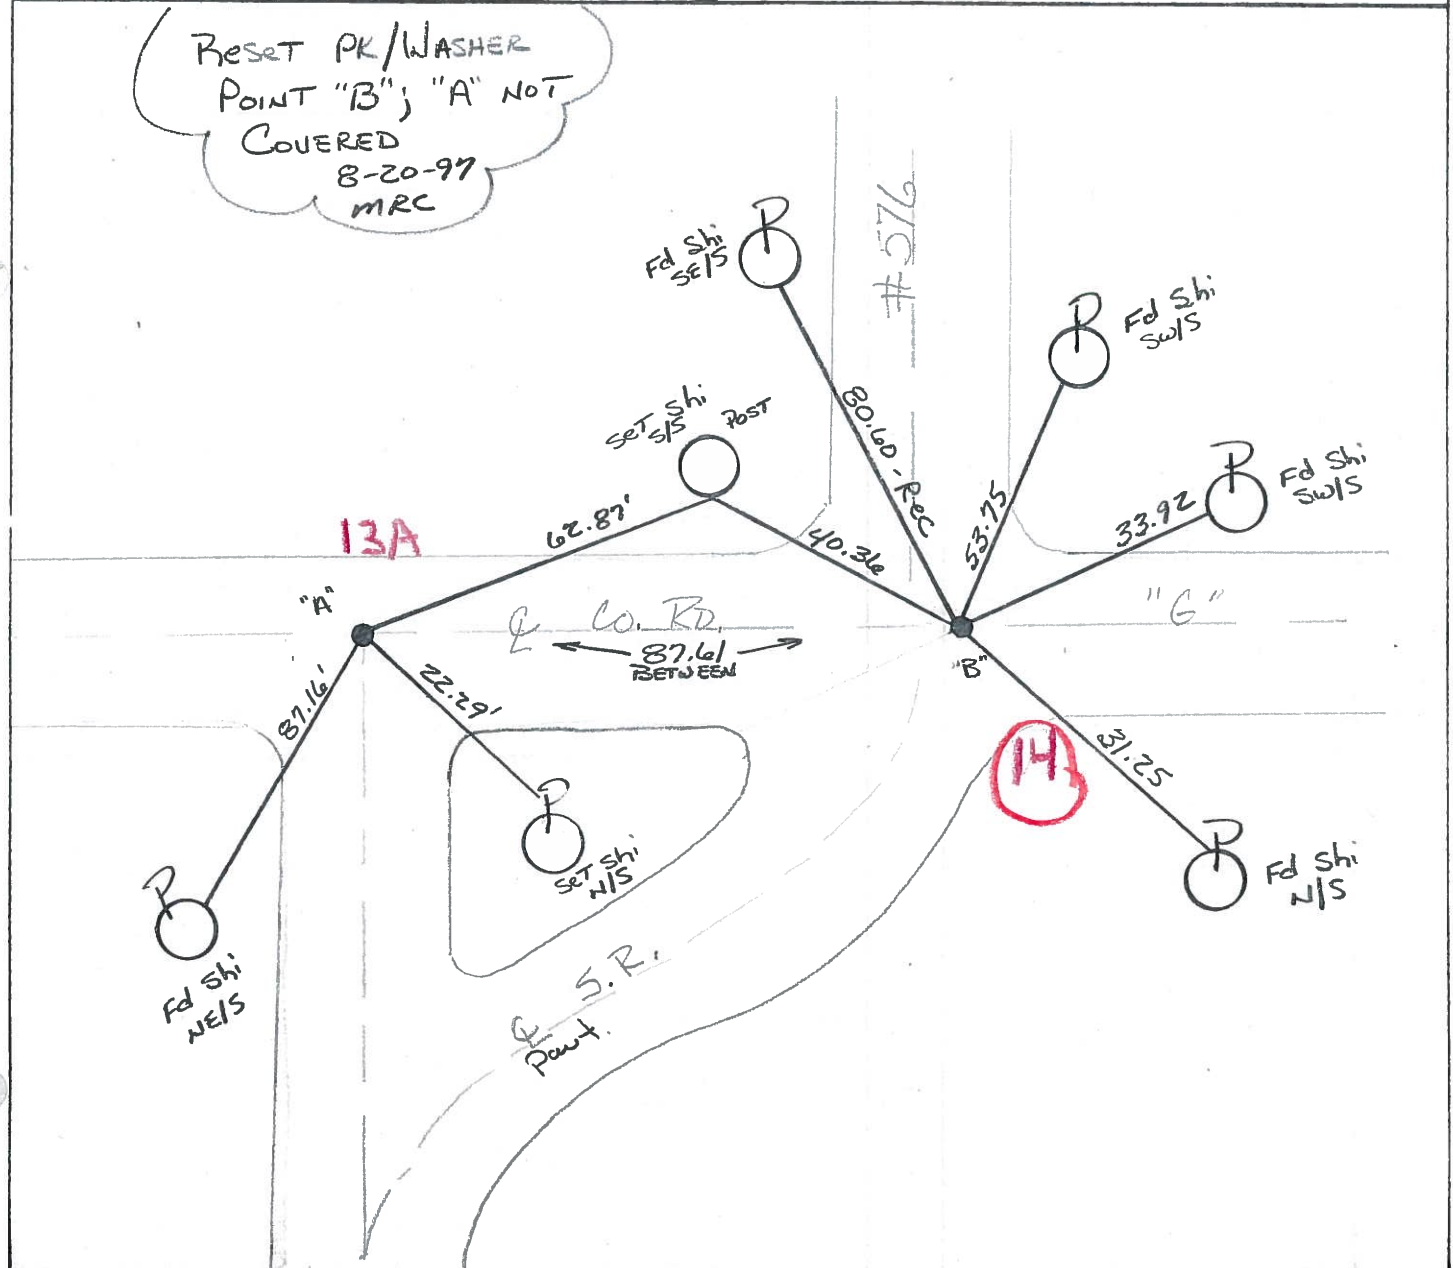

O.D.O.T. DISTRICT 2 SURVEY OFFICE

PERSONNEL _____

REFERENCE NO. 14

SHEET 5 OF 19

NOTES D. CURTIS

H.C. J. HOUSEHOLDER

DATE 9-29-86

ROUTE 576

R.C. _____

WEATHER WARM

COUNTY WILLIAMS

TEMP. 75°

TOWNSHIP CENTER

SECTION 2

T 6 N R 2 E


TYPE MONUMENT SEE BELOW

ON SURFACE - BELOW _____

LEFT - \odot PAV'T. - RIGHT _____

_____ TO _____ EDGE PAVEMENT


S.L.M. 319+25 - PT "B"

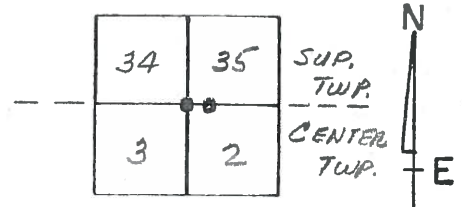

PT. "A"
NAIL IN SHINER AT SURFACE

PT. "B"
NAIL IN BOTTLE CAP
AT SURFACE

COR. SEC'S. 2, 3, 34, 35 $\frac{1}{4}$
SUPERIOR-CENTER TWP LINE
OK 7/28/88 IRS

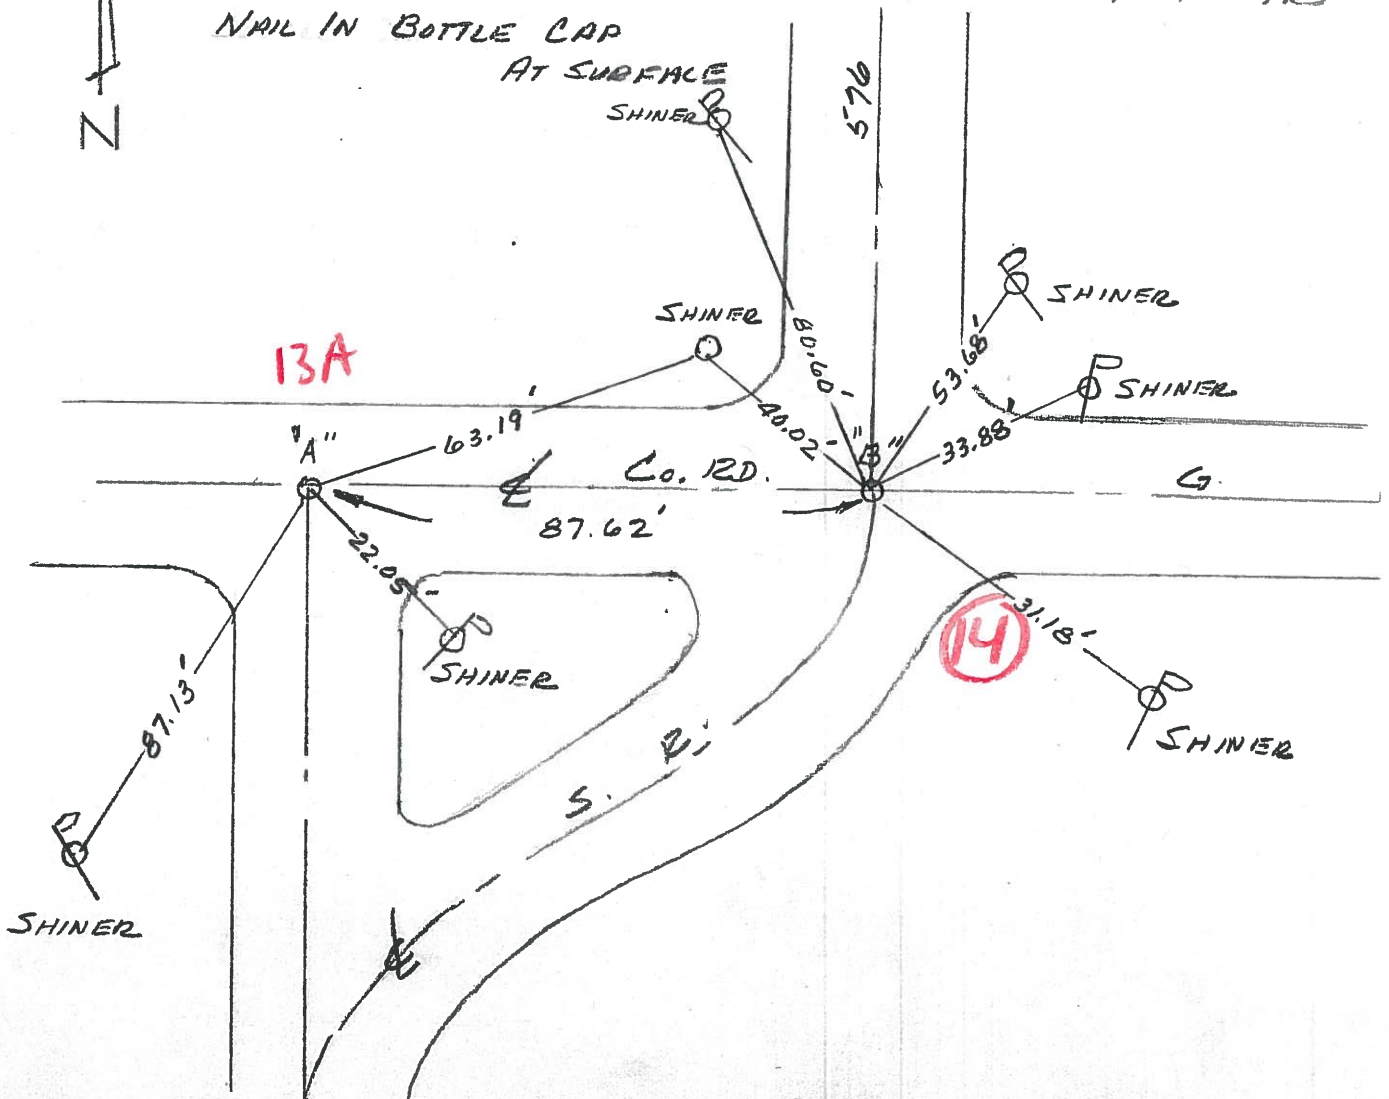

Q.D.O.T. DISTRICT 2 SURVEY OFFICE

SHEET _____ OF _____

County Williams S.R. 576

Date 1-20-83

Township CENTER


Weather CLEAR

Section 2

Temp. +18°

T6N, R2E

Personnel HOFFMAN

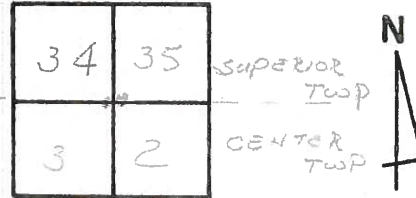

14


+
CREW

PT. "A" Fd 1/2" I. PIPE @ surface
ON & PAUT
10.2' TO N.E.P.

PT "B" Fd 1/2" I. PIPE 2" BELOW SURFACE
S.L.M. 319+25
ON & PAUT Rd "B"
8.1' EAST of E.E.P. SR576
18.9' EAST of & PAUT SR576 NORTH

OK
6/16/83
J.H.

SET P.K./WASHER
6/16/83
J.H.

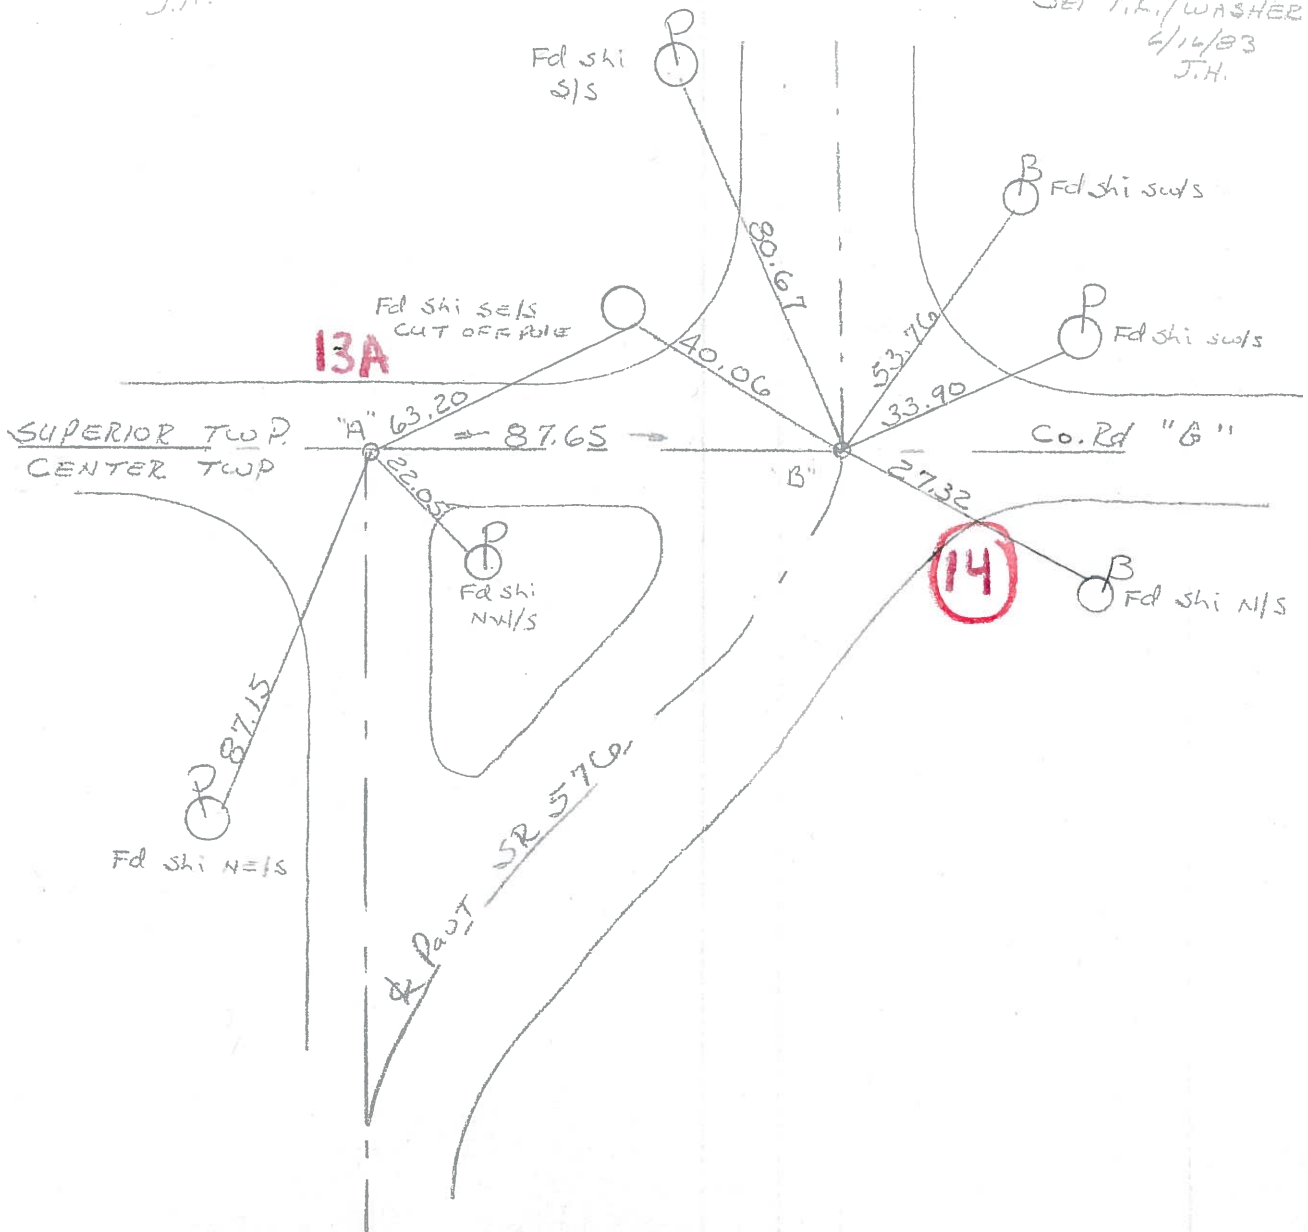

County Williams S.R. 576

Date 18 Aug. 80

Township SUPERIOR CENTER


Weather cloudy

Section 3-2 (CENTER)
34-35 (SUPERIOR)

Temp. 79°

T. N, R. E

Personnel I. Stone

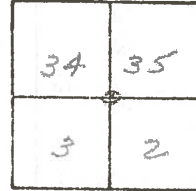


R. Michalak

P. Newser

D. Curtis

REF. NO. 14

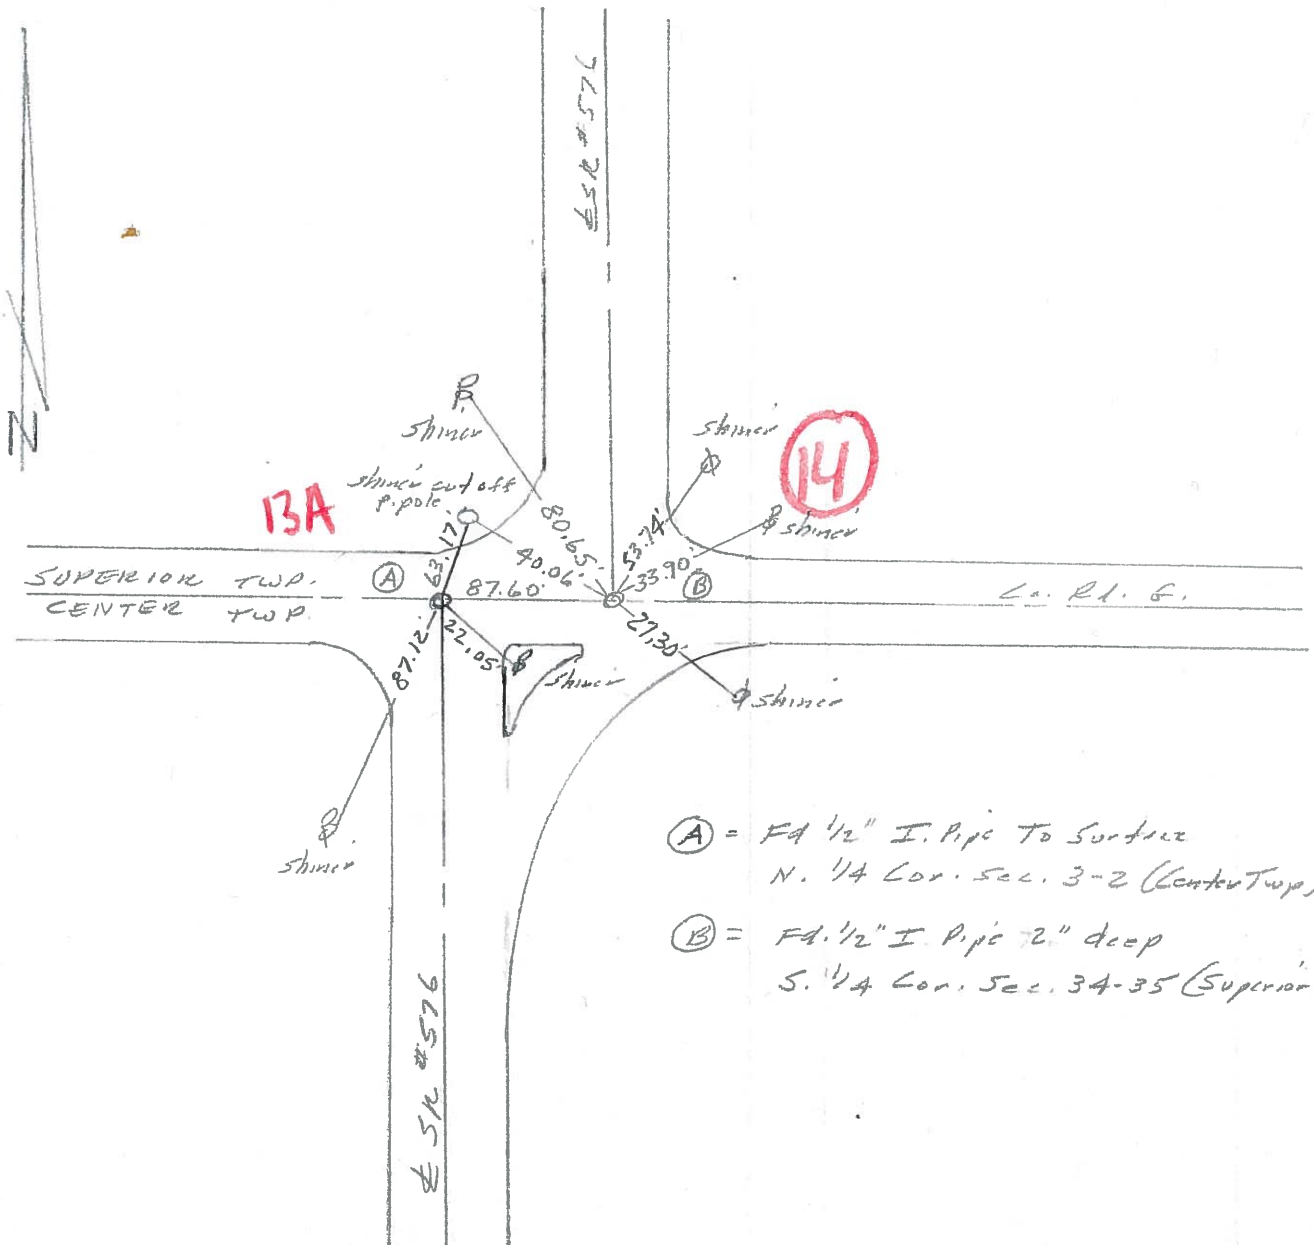

Ⓐ = F4 1/2" I. Pipe To Surface
N. 1/4 Cor. Sec. 3-2 (Center Twp)

Ⓑ = F4 1/2" I. Pipe 2" deep
S. 1/4 Cor. Sec. 34-35 (Superior Twp)