

O.D.O.T. DISTRICT 2 SURVEY OFFICE

PERSONNEL _____

REFERENCE NO. _____

SHEET 10 OF 19

NOTES J. Householder

H.C. D. Curtis

DATE Sept. 29, 1986

ROUTE S.R. 576

R.C. _____

WEATHER Warm

COUNTY Williams

TEMP. ± 82

TOWNSHIP Superior

SECTION 23

T _____ R _____


TYPE MONUMENT P.K. Nail

ON SURFACE - BELOW Surface

LEFT- & PAV'T. - RIGHT _____

____ TO _____ EDGE PAVEMENT

S.L.M. 428 + 64

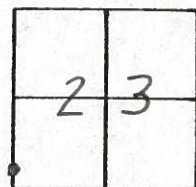


P.O.T. Sta. 428+68.08



ADD

This point was used as P.O.T. for const. No other use. Refs. lost in Const. 7/28/88 IRS

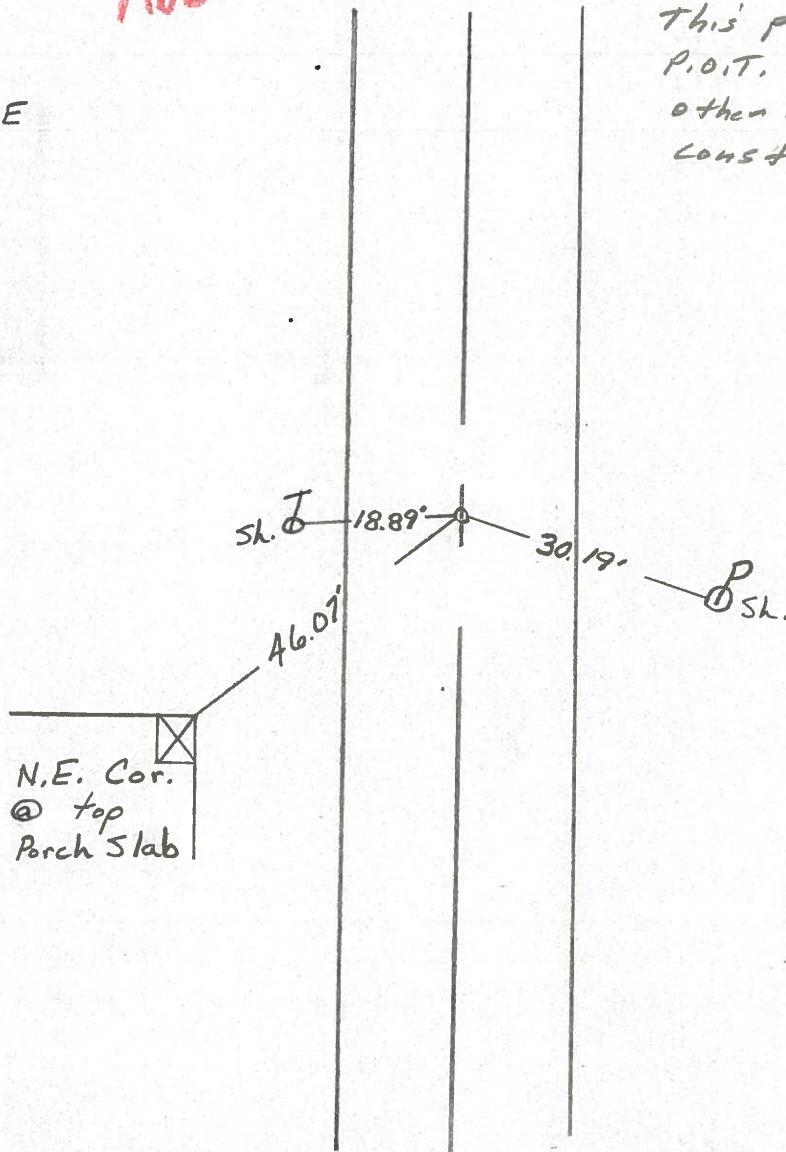

County Williams S.R. 576

Date 7-27-84

Township SPRINGFIELD

Weather Cloudy

Section 23

Temp. 70°

T7N, R2E


Personnel Hoffman

Loehrer

Householder R.C.

Barnhisel H.C.

F. S. G. W.

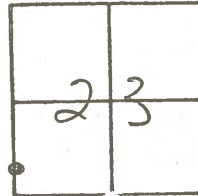

Set P.K. P.O.T. STA 428+68.08
@ TOP OF HILL

ADD

9.9 TO LT. EP.

9.2 TO RT. EP.

