


O.D.O.T. DISTRICT 2 SURVEY OFFICE (USE ONLY)


PERSONNEL _____ REFERENCE NO. 17 SHEET 22 OF 29
 NOTES NIESE DATE 3-31-21 ROUTE SR 576
 H.C. AUBLE WEATHER WINDY COUNTY WILLIAMS
 R.C. NIESE TEMP. 70° F TOWNSHIP SUPERIOR
 SECTION 23
 DWG BY AUBLE PID PAVETRAIN T 7 N R 2 E

TYPE MONUMENT MAG/WASHER
 ON SURFACE - ~~BELOW~~ ON
 OFFSET ϕ PAVEMENT 1.3' RT : RT
8.6' TO RT EDGE PAVEMENT
 STATION: 476+88.64

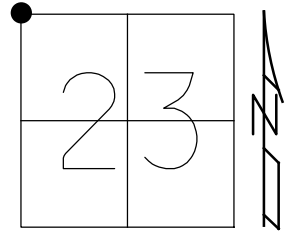

HORZ.DATUM: NAD83 2011 GEOID: NAVD88 2018
 GRID: NORTHING: 695873.063 EASTING: 1390226.116

RECORD:
 SET MAG/WASHER
 8-19-11, DCH
 FD MAG/WASHER
 REF17
 3-31-21
 9-20-21, DSA

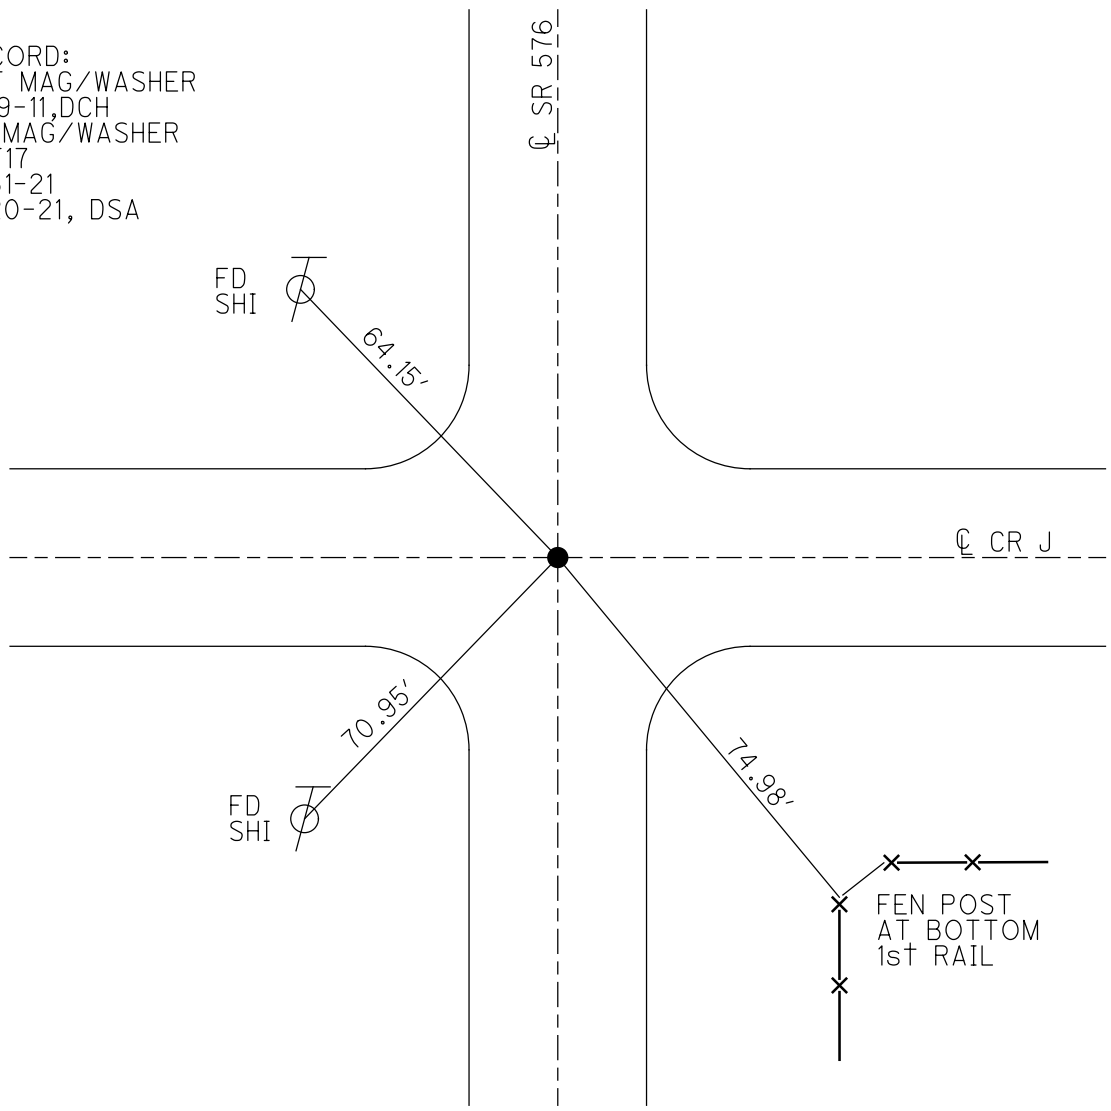

O.D.O.T. DISTRICT 2 SURVEY OFFICE USE ONLY

PERSONNEL

REFERENCE NO. 17

SHEET 20 OF 27

NOTES HOMAN

DATE 6-16-11

ROUTE S.R. 576

H.C. ROUSOS

WEATHER CLOUDY

COUNTY WILLIAMS

R.C. HOMAN

TEMP. 75°

TOWNSHIP SUPERIOR

SECTION 23

T 7 N R 2 E

TYPE MONUMENT PK NAIL


~~ON SURFACE~~ - BELOW 3"

~~LEFT~~ ~~OF PAV'T~~ - RIGHT 1.3' RT


8.6' TO RT EDGE PAVEMENT

S.L.M. 476+89

Grid: Northing: 695873.124 Easting: 1390226.133

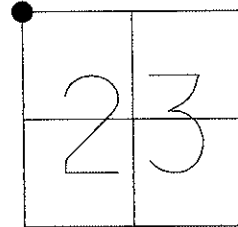

SET MAG NAIL
& WASHER
8-19-11
DCH

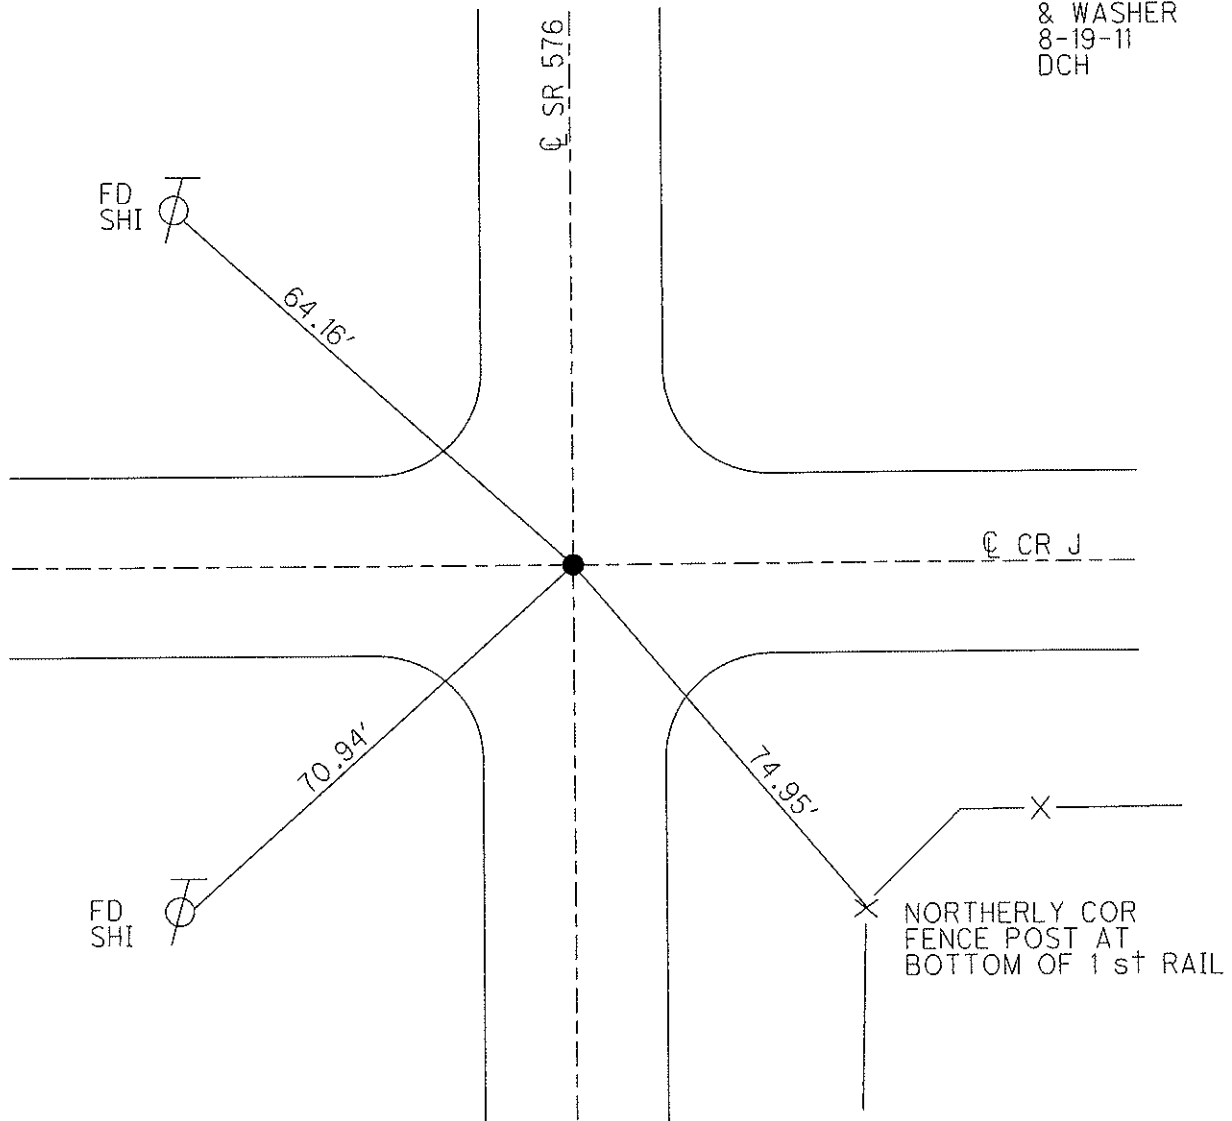

O.D.O.T. DISTRICT 2 SURVEY OFFICE

PERSONNEL _____

REFERENCE NO. 17

SHEET 10 OF 17

NOTES CANTERBURY

H.C. ROUSOS

DATE 5-27-97

ROUTE S.D. #576

R.C. BARNAISEL

WEATHER SUNNY

COUNTY WILLIAMS

TEMP. +65°

TOWNSHIP SUPERIOR

SECTION 14-15-22-23

T 7 N R 2 E

TYPE MONUMENT PK NAIL


ON SURFACE - ~~BELOW~~ yes

~~EST~~ - Q PAV'T. - RIGHT 1.3'

8.6 TO RT EDGE PAVEMENT

S.L.M. 478+44

15	14
22	23

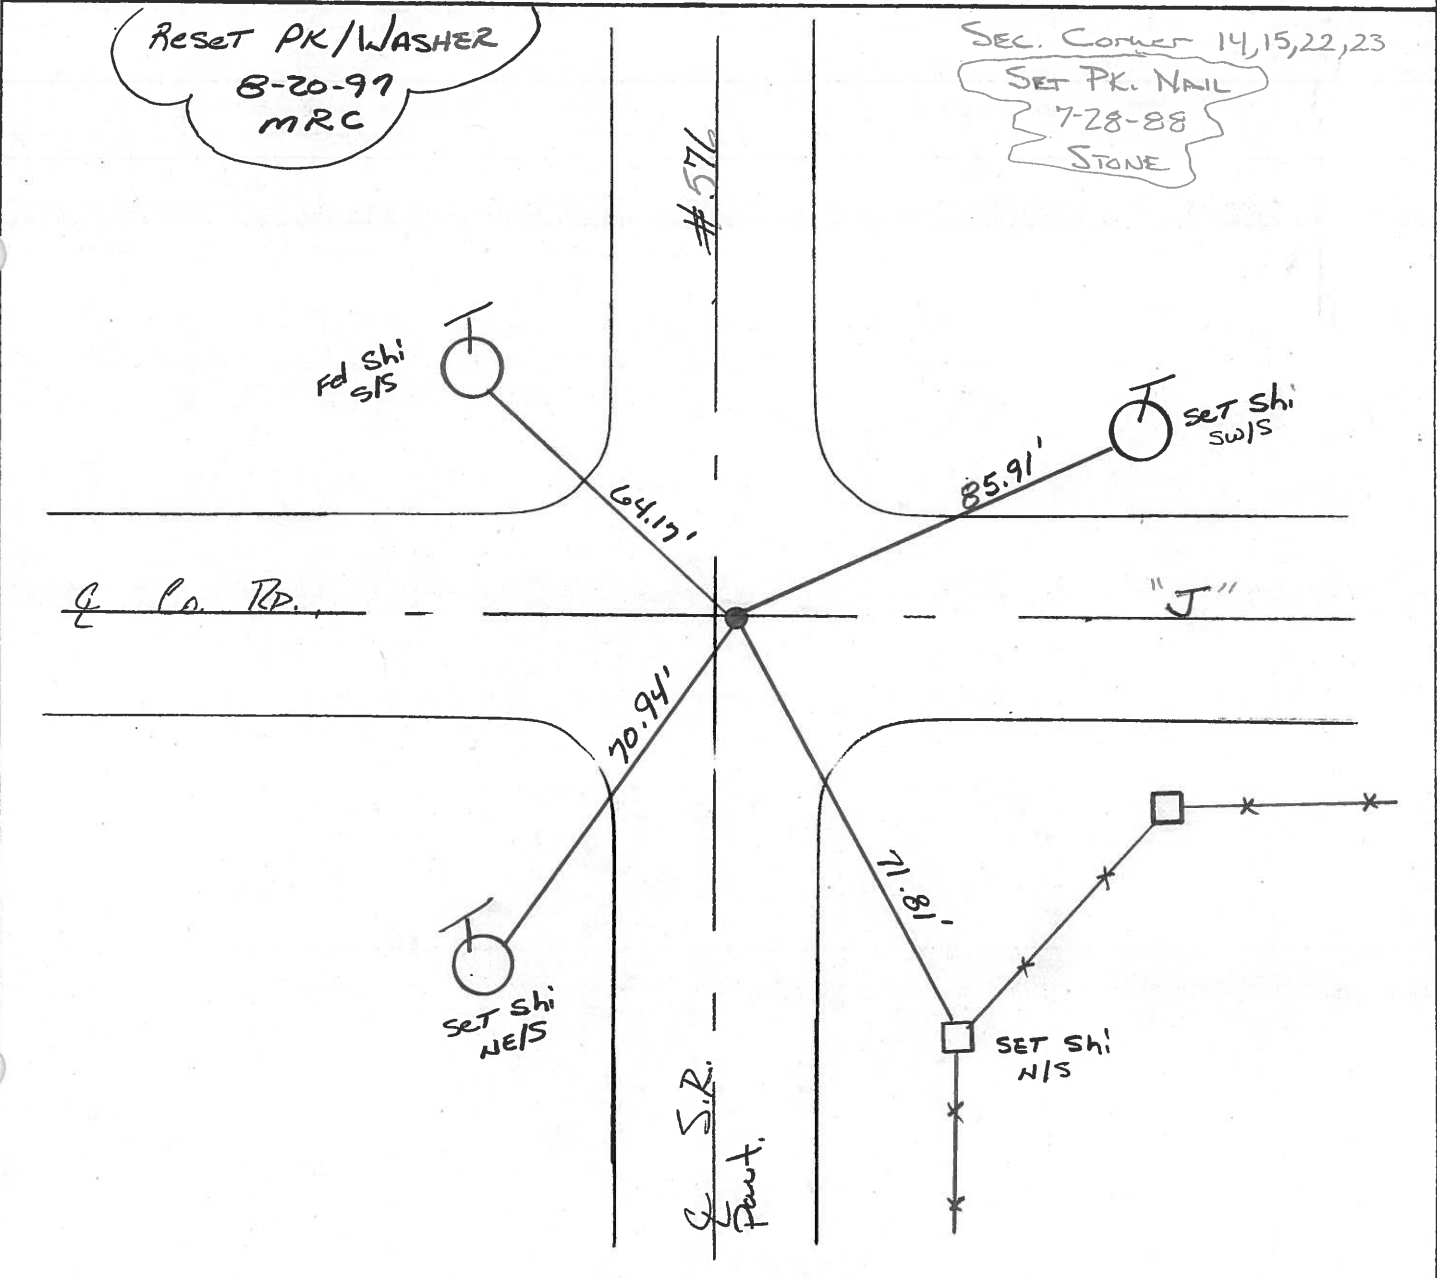

O.D.O.T. DISTRICT 2 SURVEY OFFICE

PERSONNEL _____

REFERENCE NO. 17

SHEET 13 OF 19

NOTES D. CURTIS

H.C. J. HOUSEHOLDER

DATE 9-30-86

ROUTE 576

R.C. _____

WEATHER CLOUDY

COUNTY Williams

TEMP. 70°

TOWNSHIP SUPERIOR

SECTION 14-15-22-23

T _____ R _____

TYPE MONUMENT CONC. NAIL


ON SURFACE - BELOW ON SURFACE

LEFT - ☉ PAV'T. - RIGHT 1' 12T. & PAVM.T

_____ TO _____ EDGE PAVEMENT

S.L.M. 478 + 02

15	14
22	23

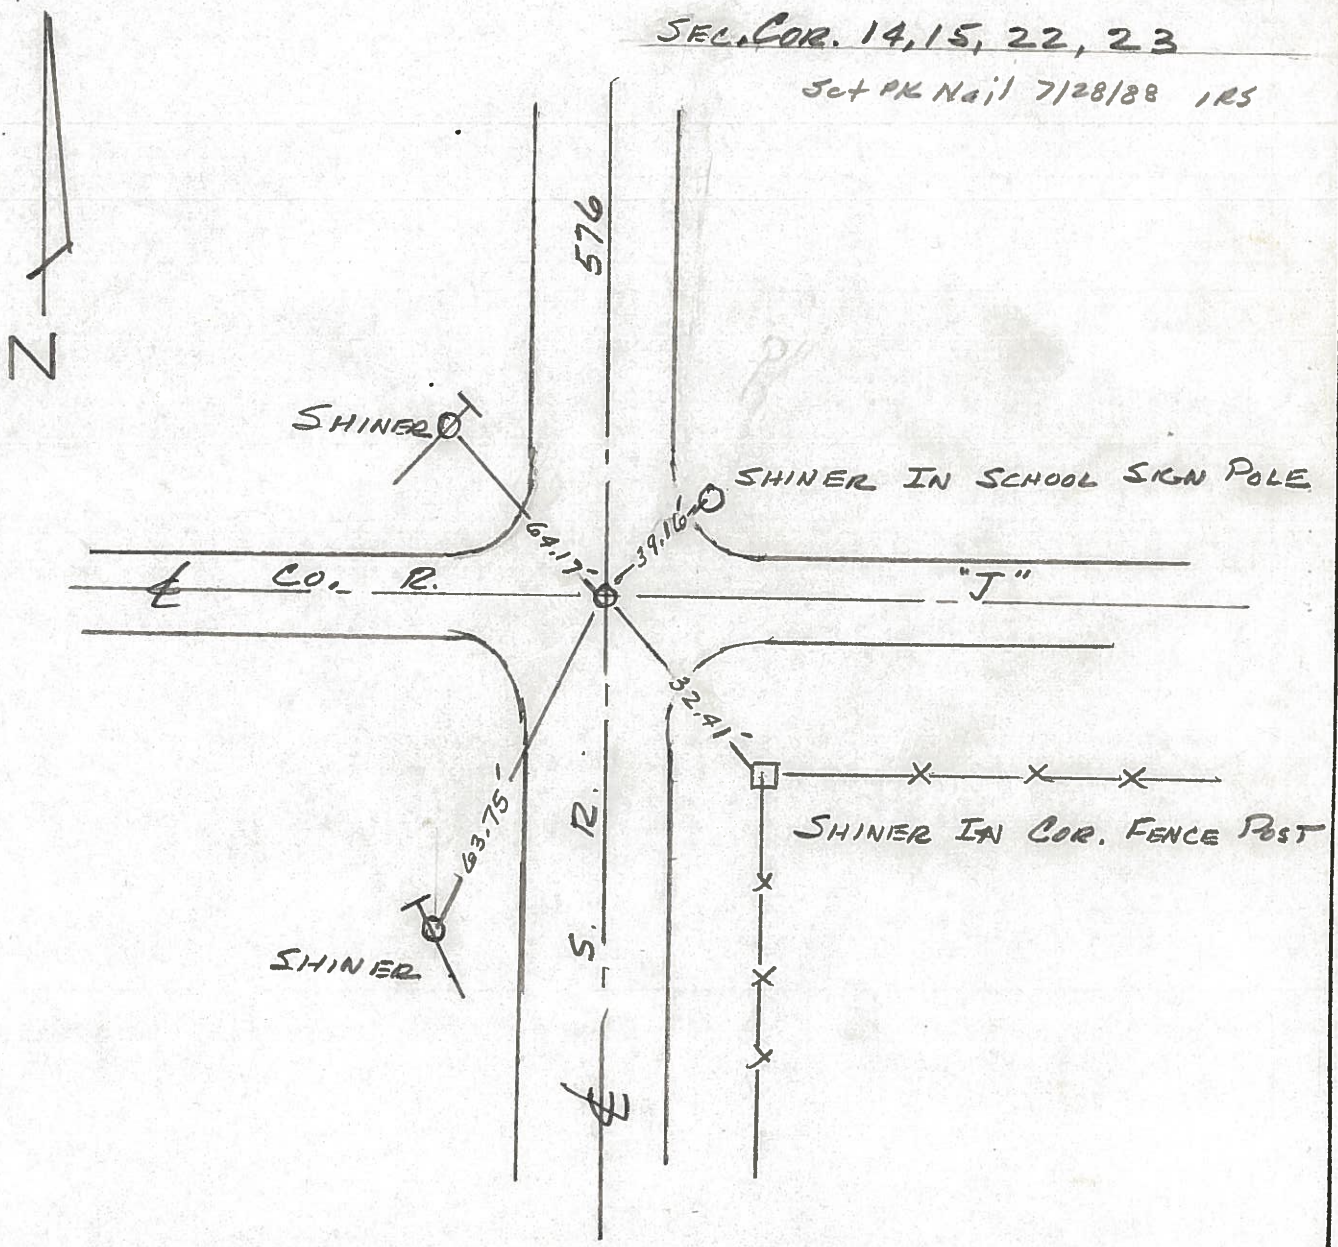

County Williams S.R. 576

Date 19 Aug. 80

Township Superior

Weather Cloudy

Section 14-15-22-23

Temp. 70°

T N, R E

Personnel J. Stone

R. Michalak


P. Neuser

D. Curtis

15	14
22	23



REF. NO. 17

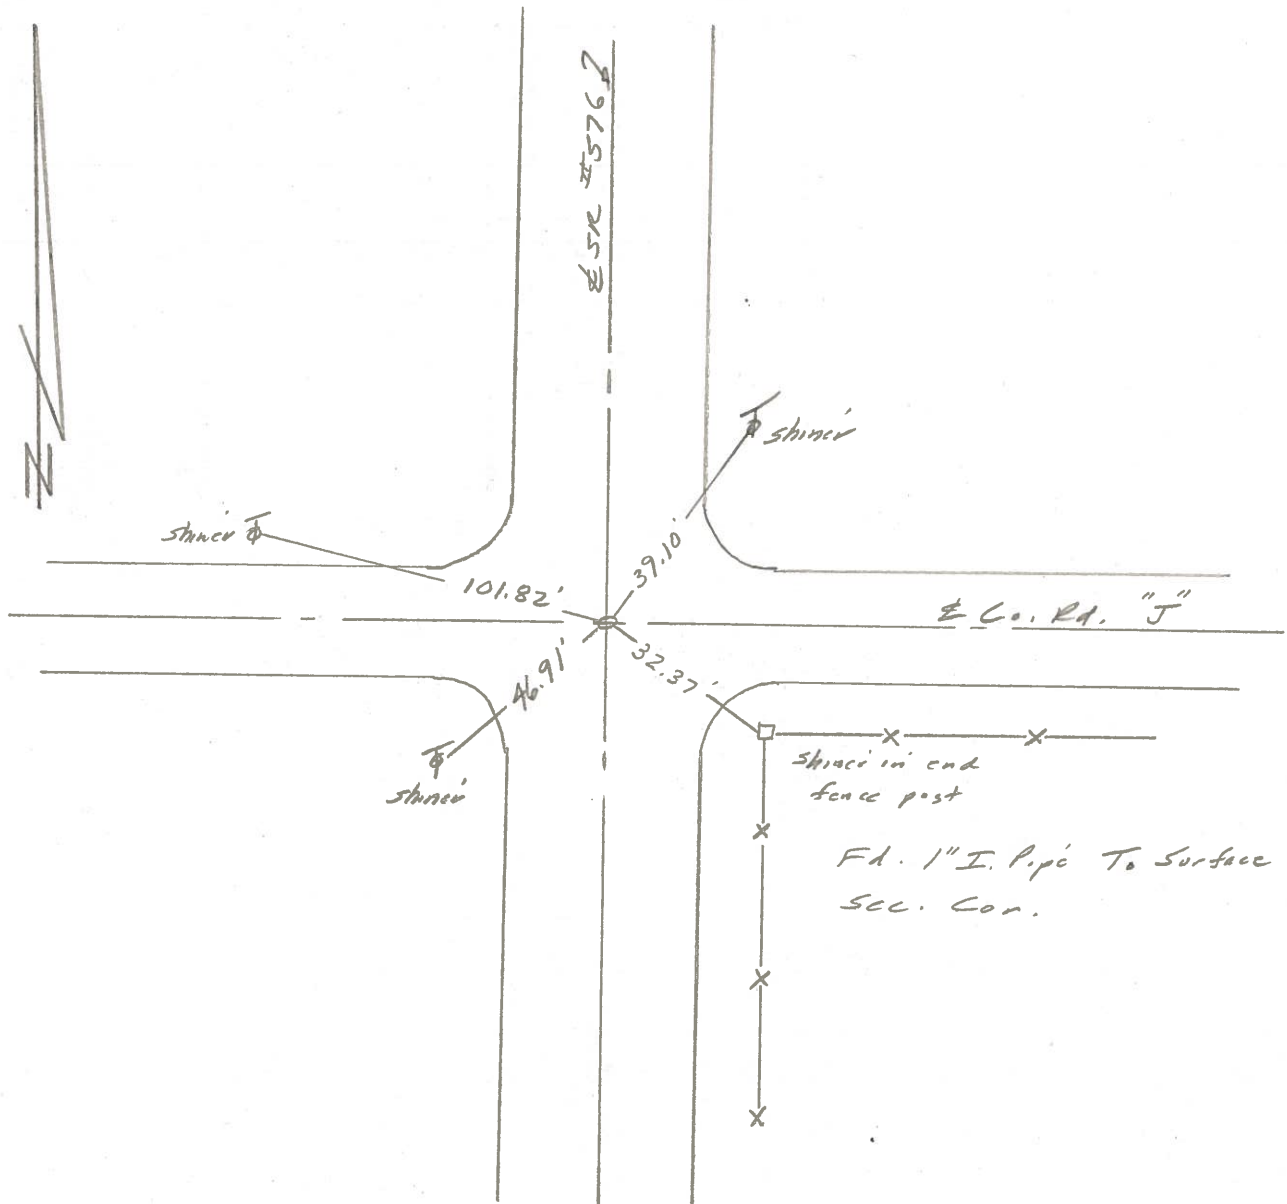

County WILLIAMS S.R. 576

Date 6-19-79

Township SUPERIOR

Weather CLEAR

Section N.E. COR. SEC. 22

Temp. +80


T N, R E

Personnel BURNSIDE

SMITH

KNAPE

MEAD

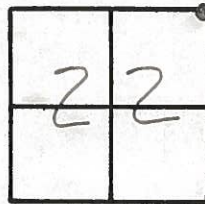

(17)

FD. 3/4" IRON PIPE @ SURFACE & IN CTR. PAVE., N.E.S., E.E.W.

