

O.D.O.T. DISTRICT 2 SURVEY OFFICE USE ONLY

PERSONNEL

REFERENCE NO. 18-C

SHEET 25 OF 27

NOTES ROUSOS

DATE 6-16-11

ROUTE 576

H.C. ROUSOS

WEATHER CLOUDY

COUNTY WILLIAMS

R.C. HOMAN

TEMP. 70°

TOWNSHIP SUPERIOR

SECTION 14

T 7 N R 2 E

TYPE MONUMENT PK NAIL



ON SURFACE - ~~BELOW~~ ON

~~LEFT - C PAV'T - RIGHT~~ ON

10.1 TO LT EDGE PAVEMENT

S.L.M. 521+36

Grid: Northing: 700319.059 Easting: 1390325.704

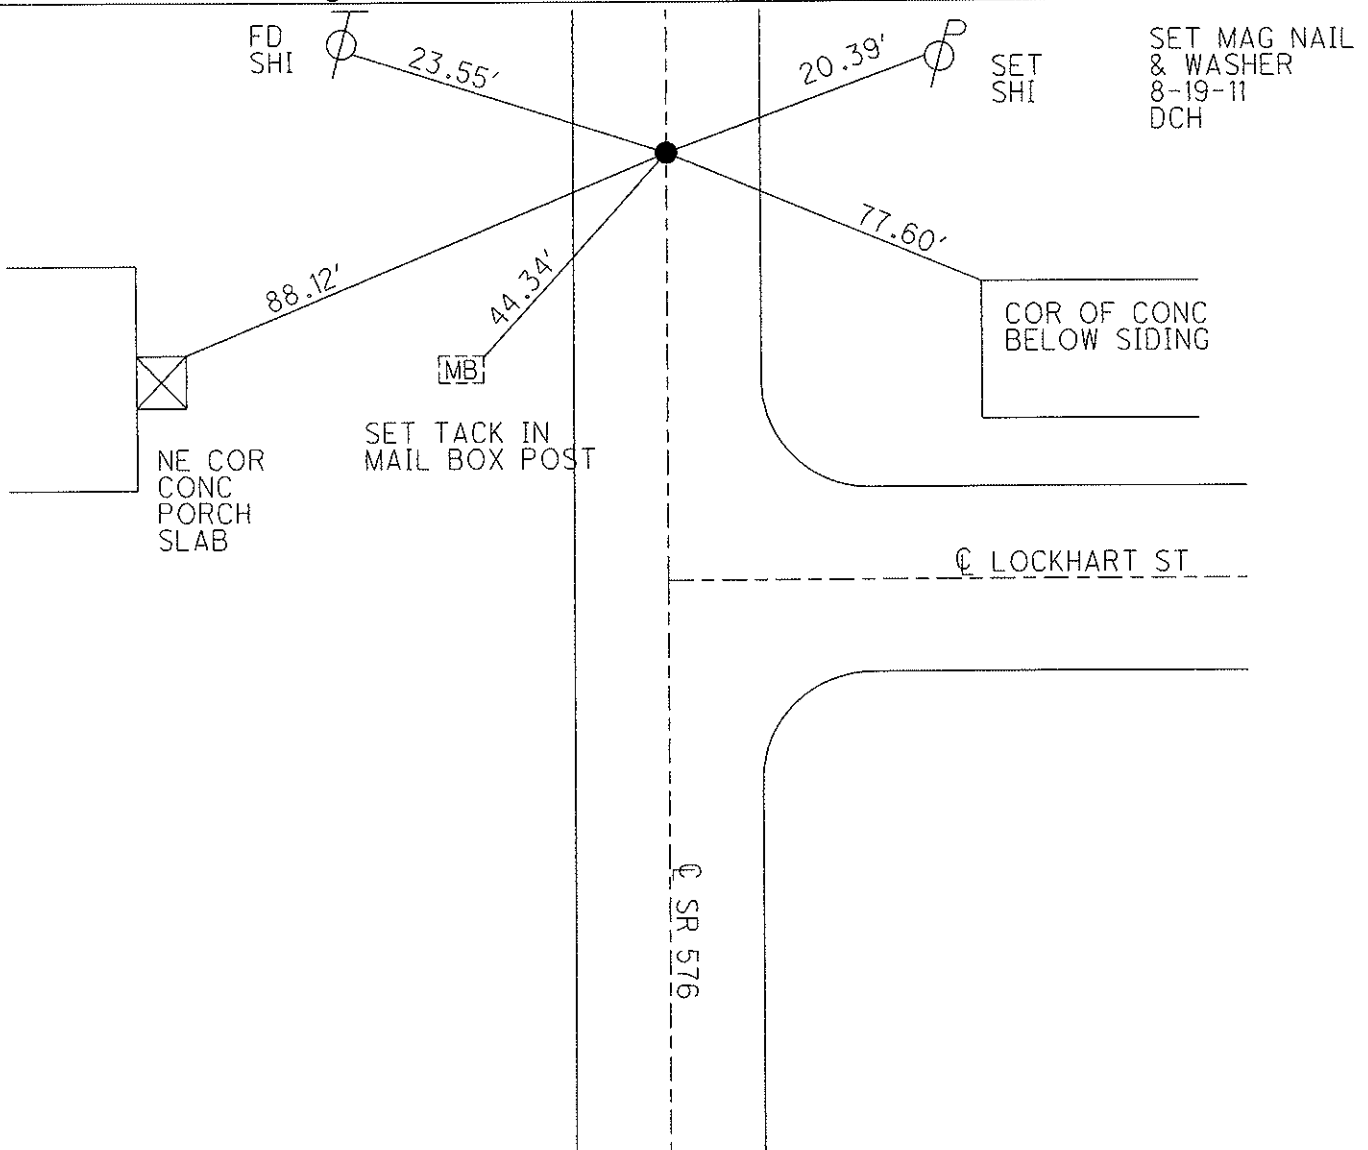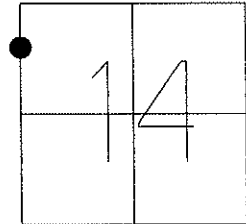

O.D.O.T. DISTRICT 2 SURVEY OFFICE

PERSONNEL

REFERENCE NO. 18-C

SHEET 14 OF 17

NOTES CANTERBURY

H.C. ROUSOS

DATE 5-28-97

ROUTE S.R. # 576

R.C. BARNHISEL III

WEATHER Cloudy

COUNTY WILLIAMS

TEMP. +62°

TOWNSHIP SUPERIOR

SECTION 14

T 7 N R 2 E


TYPE MONUMENT P.K. NAIL

ON SURFACE - ~~BELOW~~ yes


~~LEFT - C PAV'T.~~ ~~RIGHT~~ yes

10.1 TO LT EDGE PAVEMENT




S.L.M. 522+96

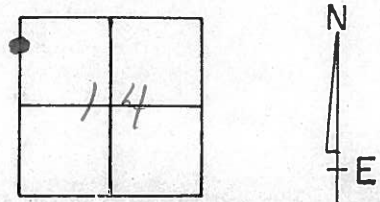

RESET PK/WASHER
9-22-97
MRC

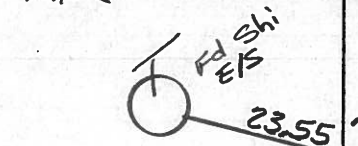

FD PK. NAIL 2" DEEP
7-28-88
STONE

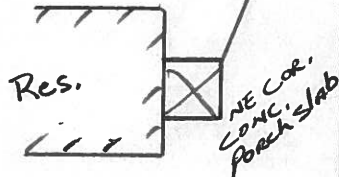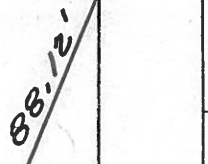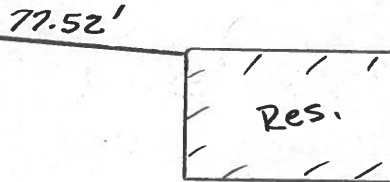

LOCKHART ST.

± Point SR 576

O.D.O.T. DISTRICT 2 SURVEY OFFICE

PERSONNEL

REFERENCE NO. 18-C

SHEET 17 OF 19

NOTES 1. Stone

H.C. D. Curtis

R.C. J. Householder

DATE 16 Oct. 86

WEATHER Cloudy

TEMP. 42°

ROUTE SR#576

COUNTY Williams

TOWNSHIP Superior

SECTION _____

T _____ R _____


TYPE MONUMENT PK Nail

ON SURFACE - BELOW Surface


LEFT - \odot PAV'T. - RIGHT _____

TO _____ EDGE PAVEMENT

S.L.M. 522+50

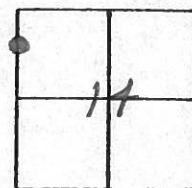

*Fd PK Nail 2" deep
7/28/88 IRS*

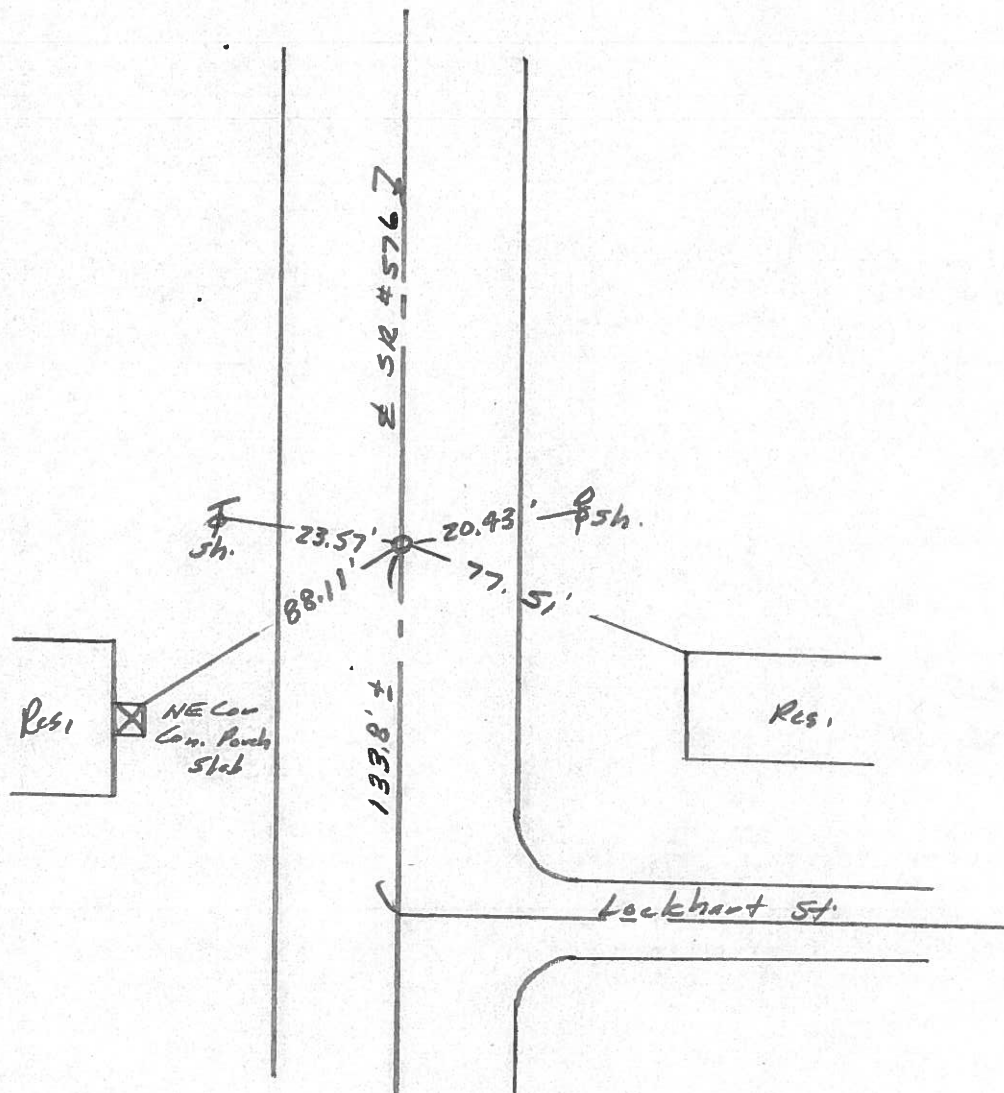

County Williams S.R. _____

Date 19 Aug. 80

Township Superior


Weather Cloudy

Section 14

Temp. 72°

T N, R E

Personnel I. Stone

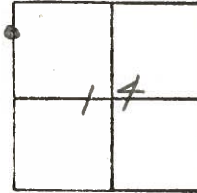

R. Michalek
P. Neuser
D. Curtis

REF. NO. 18-C



Fd. RR Sple. To Surface
9.2' to E. edge put,
9.3' to W. edge put.

