


O.D.O.T. DISTRICT 2 SURVEY OFFICE (USE ONLY)


PERSONNEL _____ REFERENCE NO. 26 A SHEET 17 OF 32
 NOTES LOEHRKE DATE 6-16-93 ROUTE SR 576
 H.C. ROMETO WEATHER CLEAR COUNTY WILLIAMS
 R.C. CANTERBURY TEMP. 65° TOWNSHIP SUPERIOR
 _____ SECTION 11
 _____ T 7 N R 2 E

TYPE MONUMENT PK NAIL
 ON SURFACE - ~~BELOW~~ ON _____
~~LEFT~~ - CL PAV'T - ~~RIGHT~~ ON _____
22.0 TO LT EDGE PAVEMENT
 S.L.M. 597+70.57

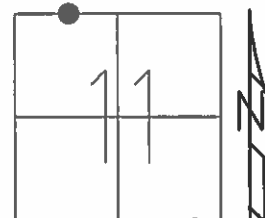

Grid: Northing: _____ Easting: _____

RECORD:
 47.73' TO REF26AB

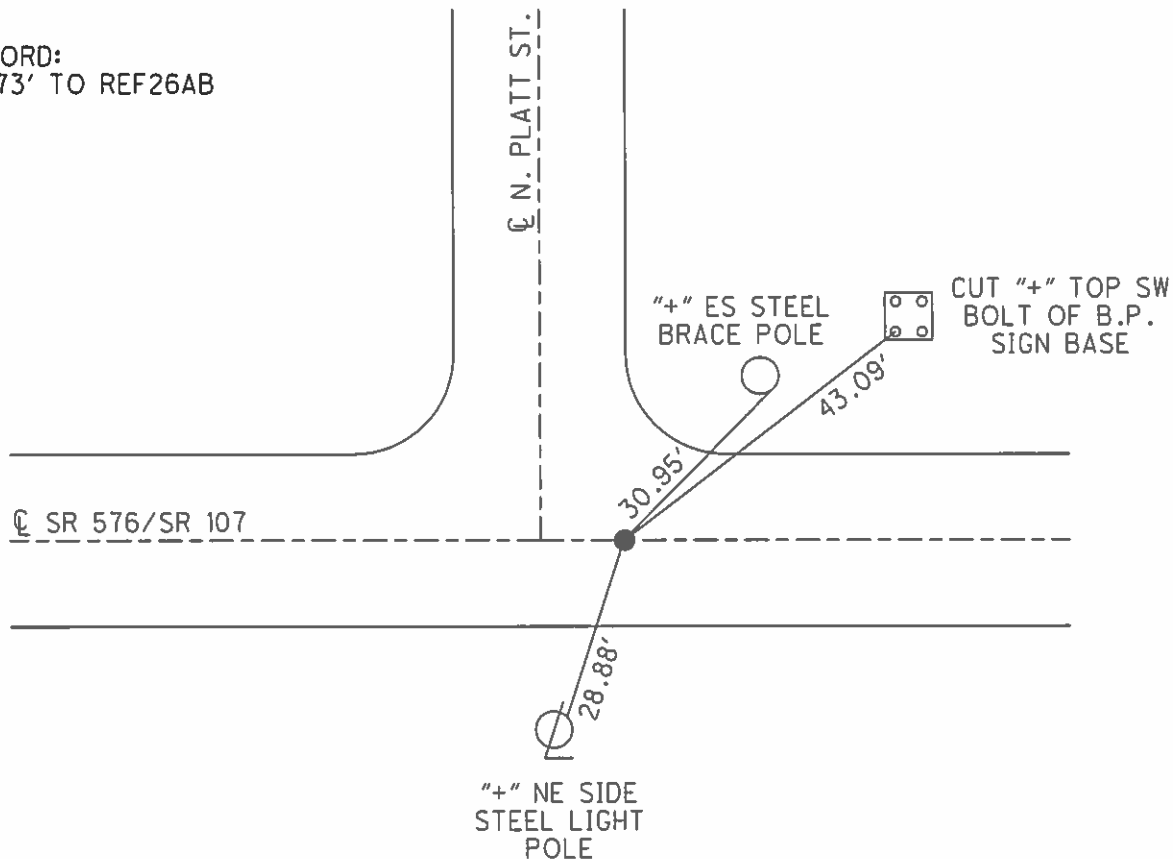

O.D.O.T. DISTRICT 2 SURVEY OFFICE

PERSONNEL _____

REFERENCE NO. _____

SHEET 15 OF 15

NOTES LOEHRKE

H.C. ROMETO

R.C. CANTERBURY

CORDES

DATE 6-16-93

WEATHER CLEAR

TEMP. +65

ROUTE S.R. 576

COUNTY William

TOWNSHIP Superior

SECTION 11

T 7 N R 2 W



TYPE MONUMENT P.K. NAIL / MON BOX

ON SURFACE - BELOW YES 2" DOWN

LEFT - Q PAV'T. - RIGHT _____

22.0 TO L+ EDGE PAVEMENT

S.L.M. Box - 599+02

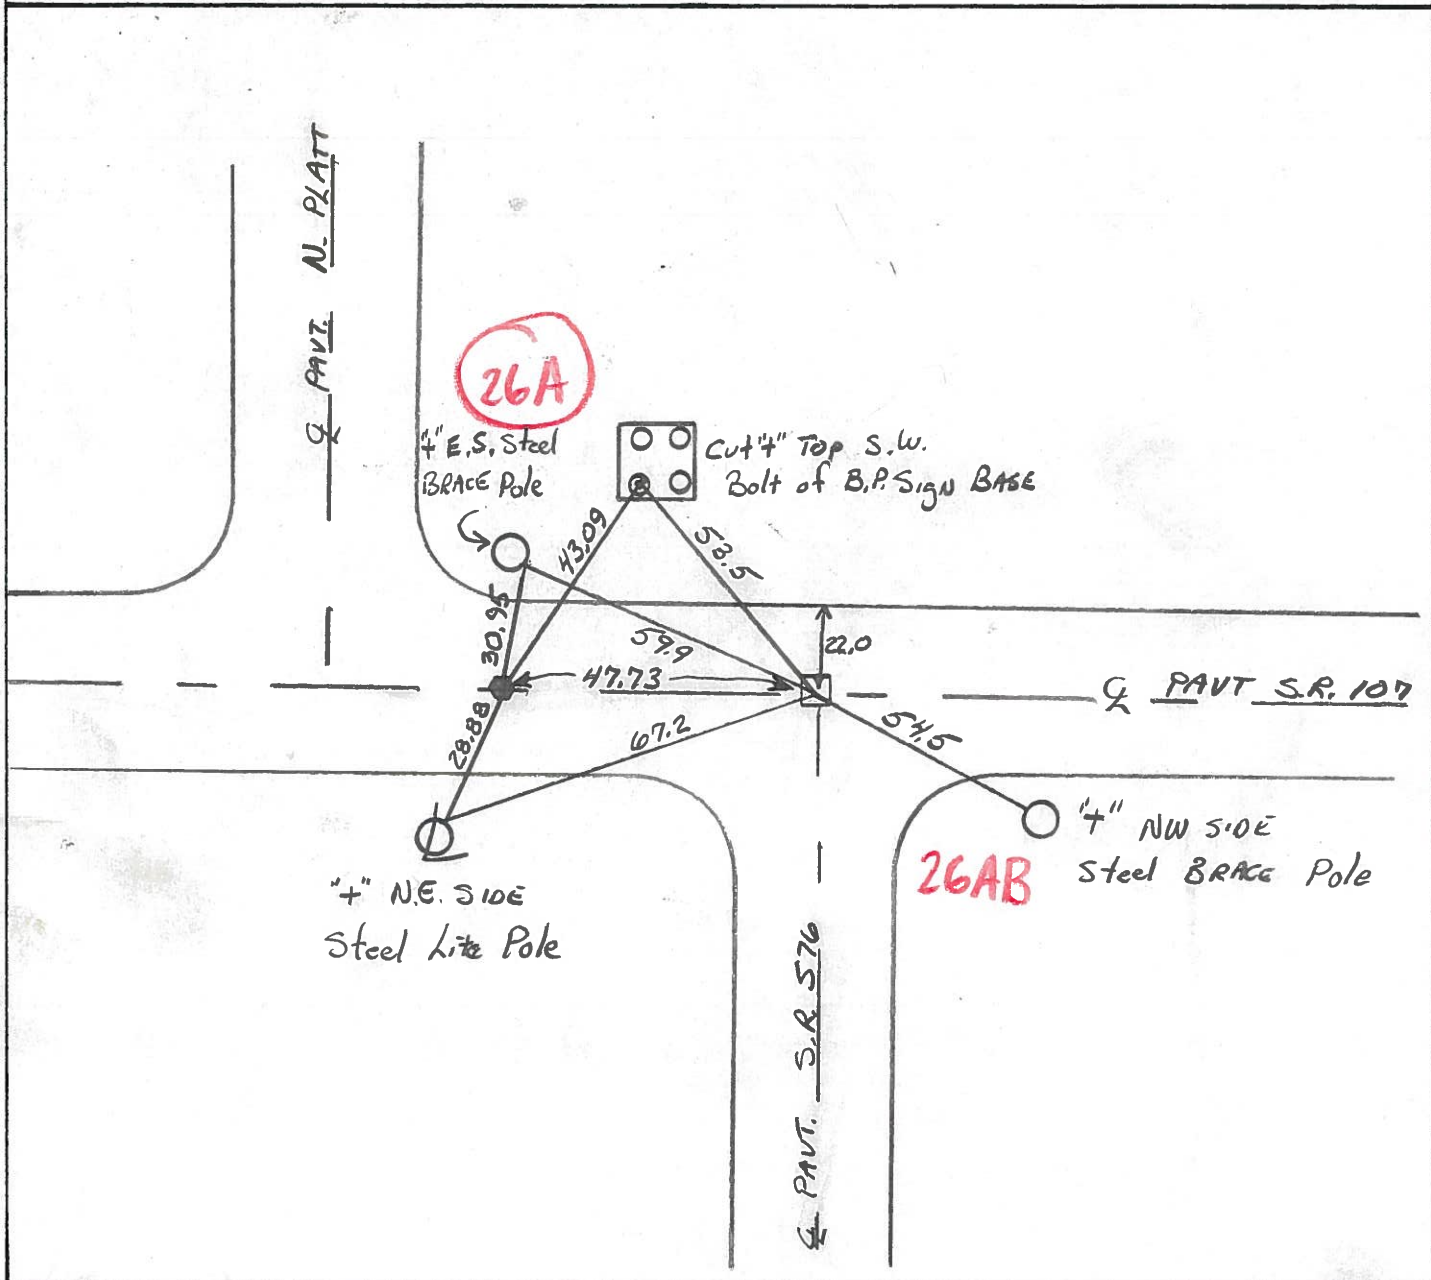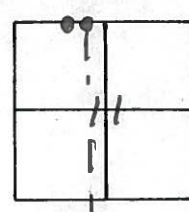

County Williams S.R. 576

Date 17 Oct. 80

Township Superior

Weather Cloudy

Section 11

Temp. 57°


T_N, R_E

Personnel I. Stone


R. Michalak

P. Neuser

D. Curtis

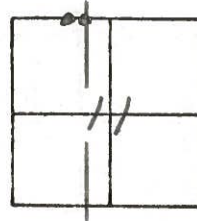

REF. NO.

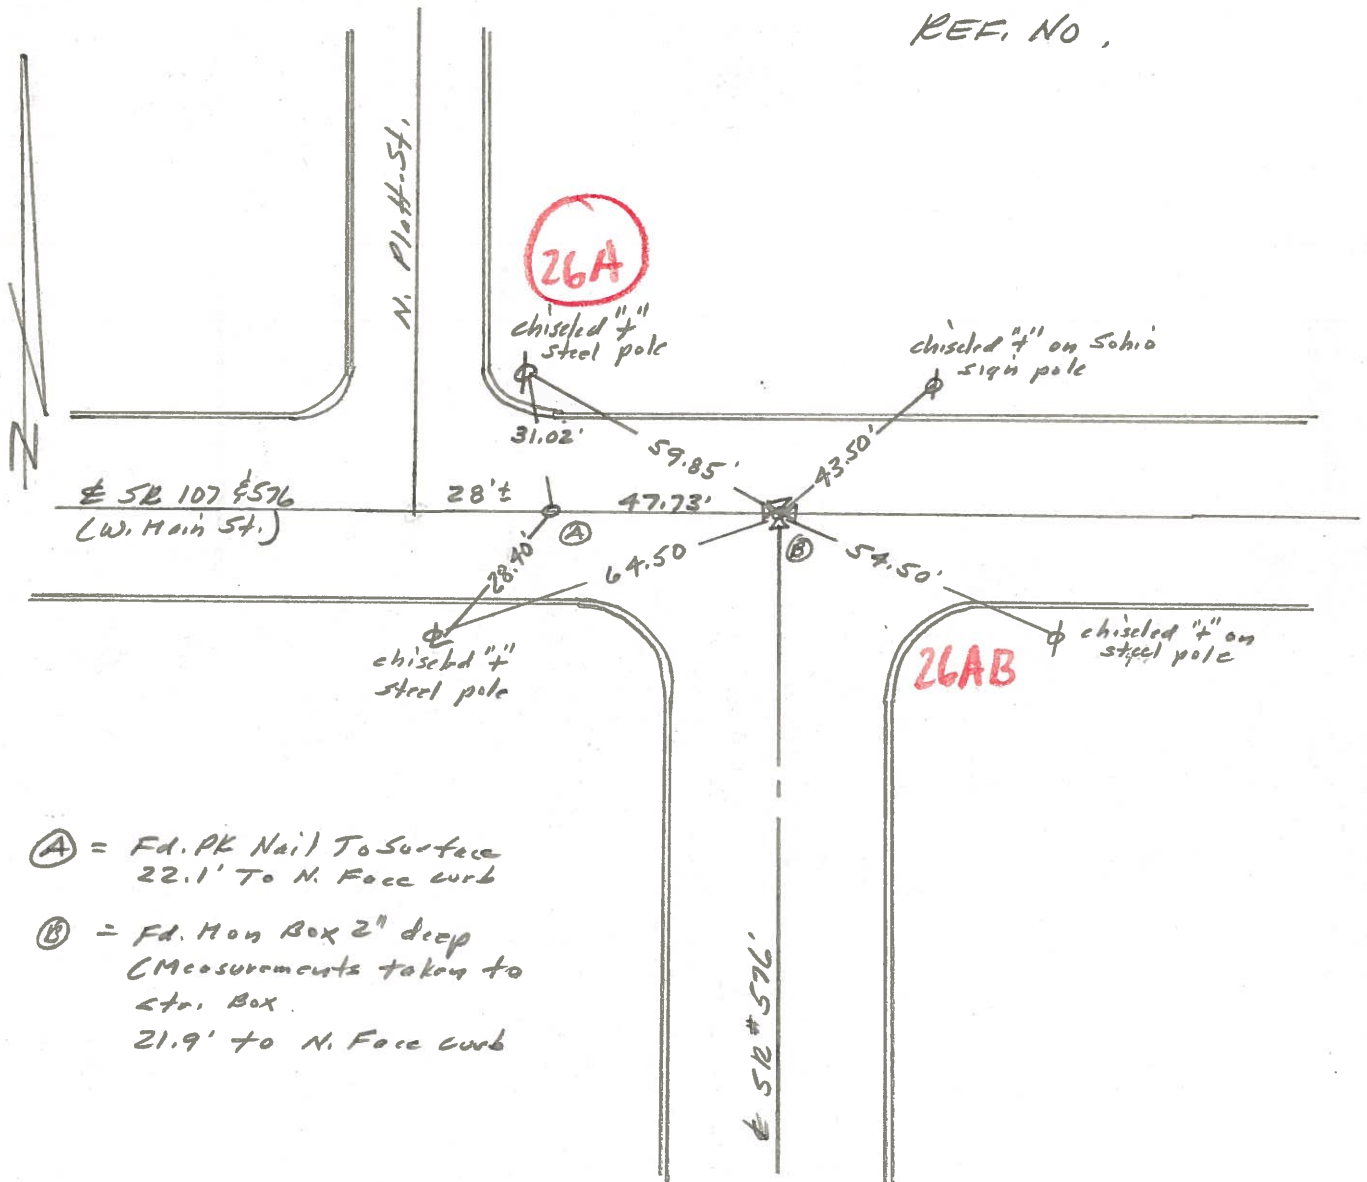

Ⓐ = Fd. PK Nail To Surface
22.1' To N. Face curb

Ⓑ = Fd. Man Box 2" deep
CMeasurements taken to
Str. Box
21.9' to N. Face curb