


O.D.O.T. DISTRICT 2 SURVEY OFFICE (USE ONLY)


PERSONNEL \_\_\_\_\_ REFERENCE NO. 26 AB SHEET 18 OF 32

NOTES	<u>LOEHRKE</u>	DATE	<u>6-16-93</u>	ROUTE	<u>SR 576</u>
H.C.	<u>ROMETO</u>	WEATHER	<u>CLEAR</u>	COUNTY	<u>WILLIAMS</u>
R.C.	<u>CANTERBURY</u>	TEMP.	<u>65°</u>	TOWNSHIP	<u>SUPERIOR</u>
	<u>CORDES</u>			SECTION	<u>11</u>
				T	<u>7</u> N
				R	<u>2</u> E

TYPE MONUMENT MON BOX  
~~ON SURFACE~~ - BELOW 2"  
~~LEFT~~ - CL PAV'T - ~~RIGHT~~ ON \_\_\_\_\_  
22.0' TO LT EDGE PAVEMENT  
 S.L.M. 598+18.30  
 Grid: Northing: 706404.2072 Easting: 1392124.8510

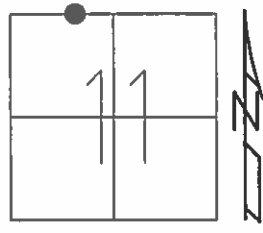

FD MON BOX  
 GPS, REF57  
 2/5/13, DCH  
 47.73' TO REF26A

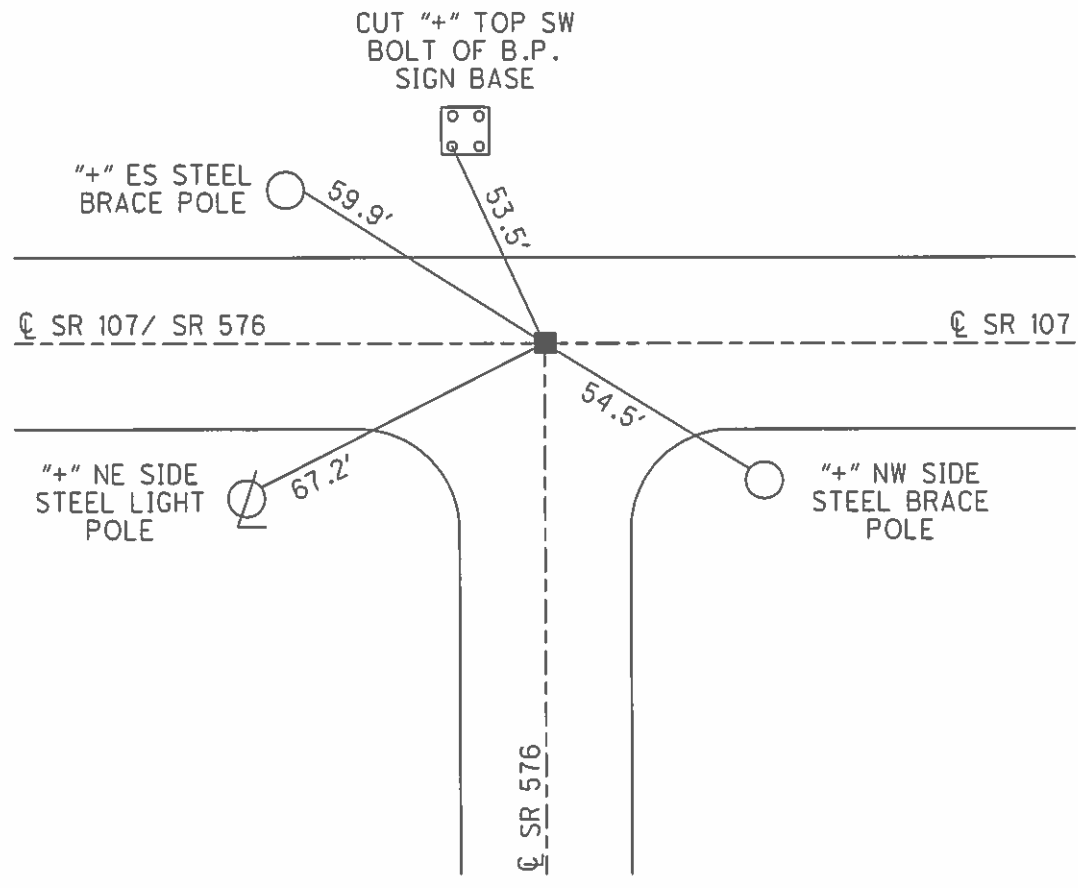

# O.D.O.T. DISTRICT 2 SURVEY OFFICE

PERSONNEL \_\_\_\_\_

REFERENCE NO. \_\_\_\_\_

SHEET 15 OF 15

NOTES LOEHRKE

H.C. ROMETO

DATE 6-16-93

ROUTE S.R. 576

R.C. CANTERBURY

WEATHER CLEAR

COUNTY William

CORDES

TEMP. +65

TOWNSHIP Superior

SECTION 11

T 7 N R 2 W



TYPE MONUMENT P.K. NAIL / MON BOX

ON SURFACE - BELOW Yes 2" DOWN

LEFT - Q PAV'T. - RIGHT \_\_\_\_\_

22.0 TO Lt EDGE PAVEMENT

S.L.M. Box 599+02

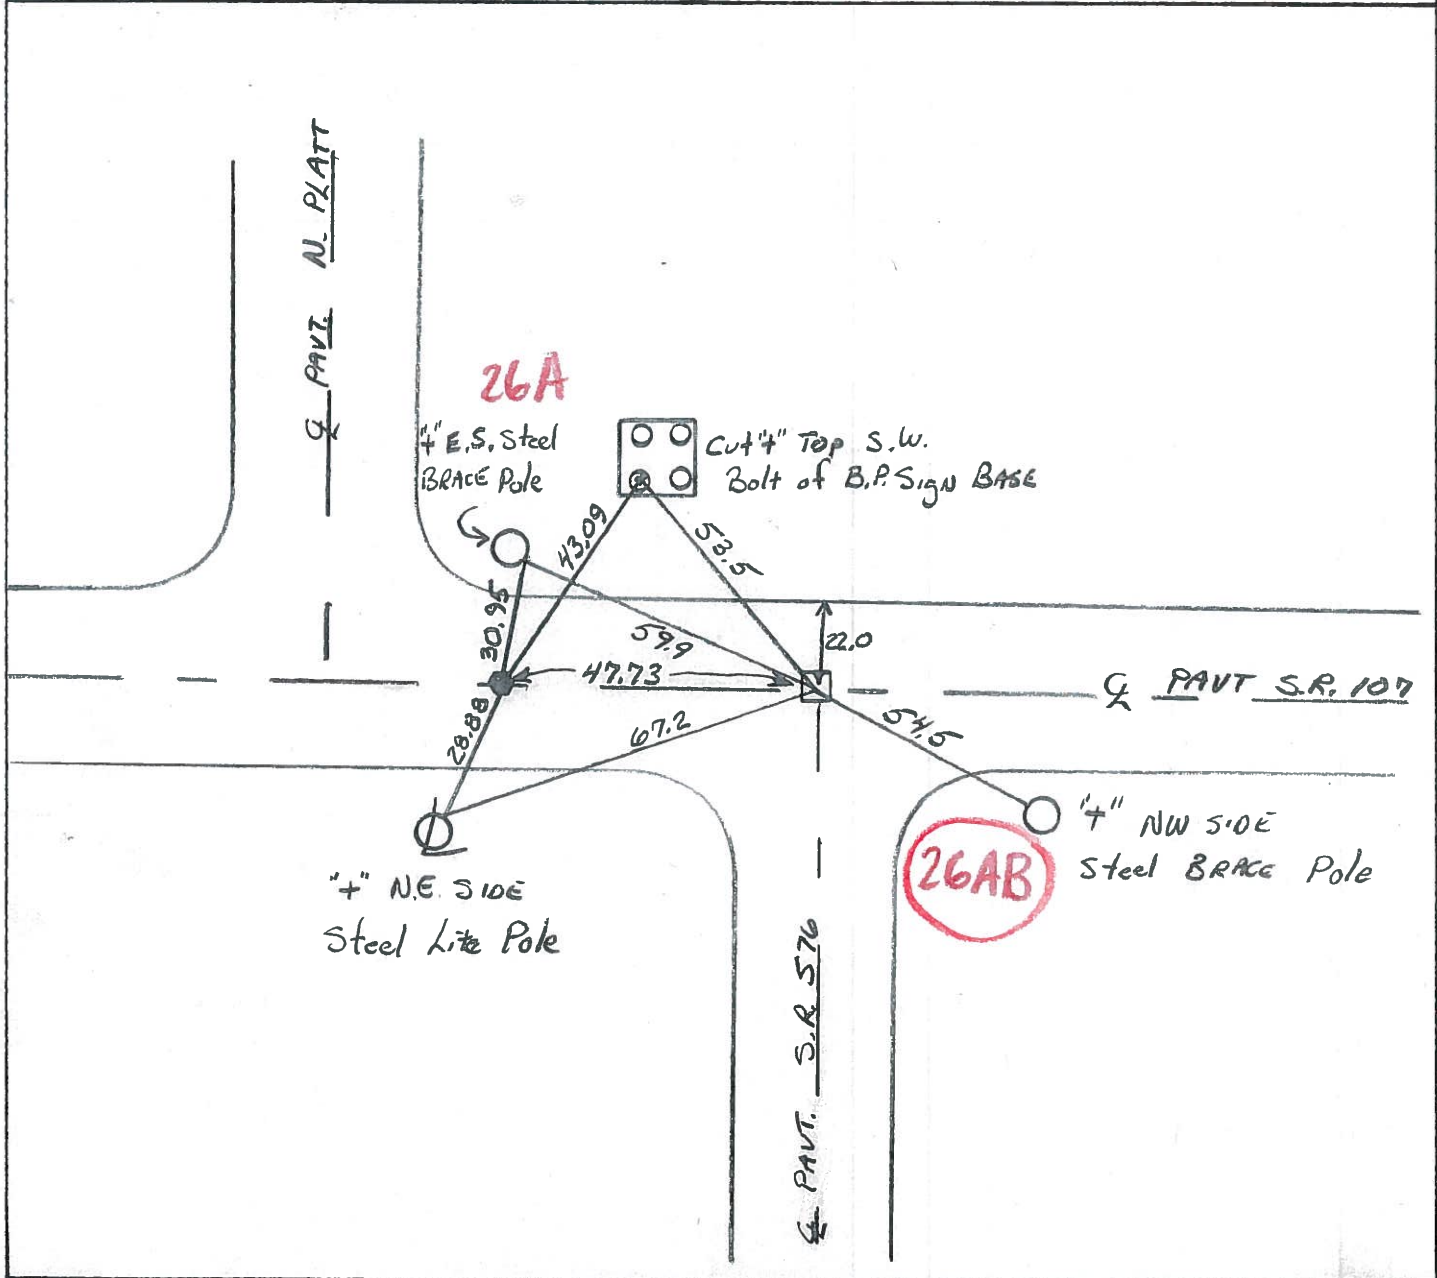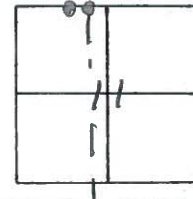

County Williams S.R. 576

Date 17 Oct. 80

Township Superior

Weather cloudy

Section 11

Temp. 57°


T\_N, R\_E

Personnel I. Stone


R. Michalak

P. Krusca

D. Curtis

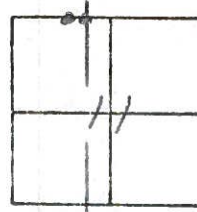

REF. NO.

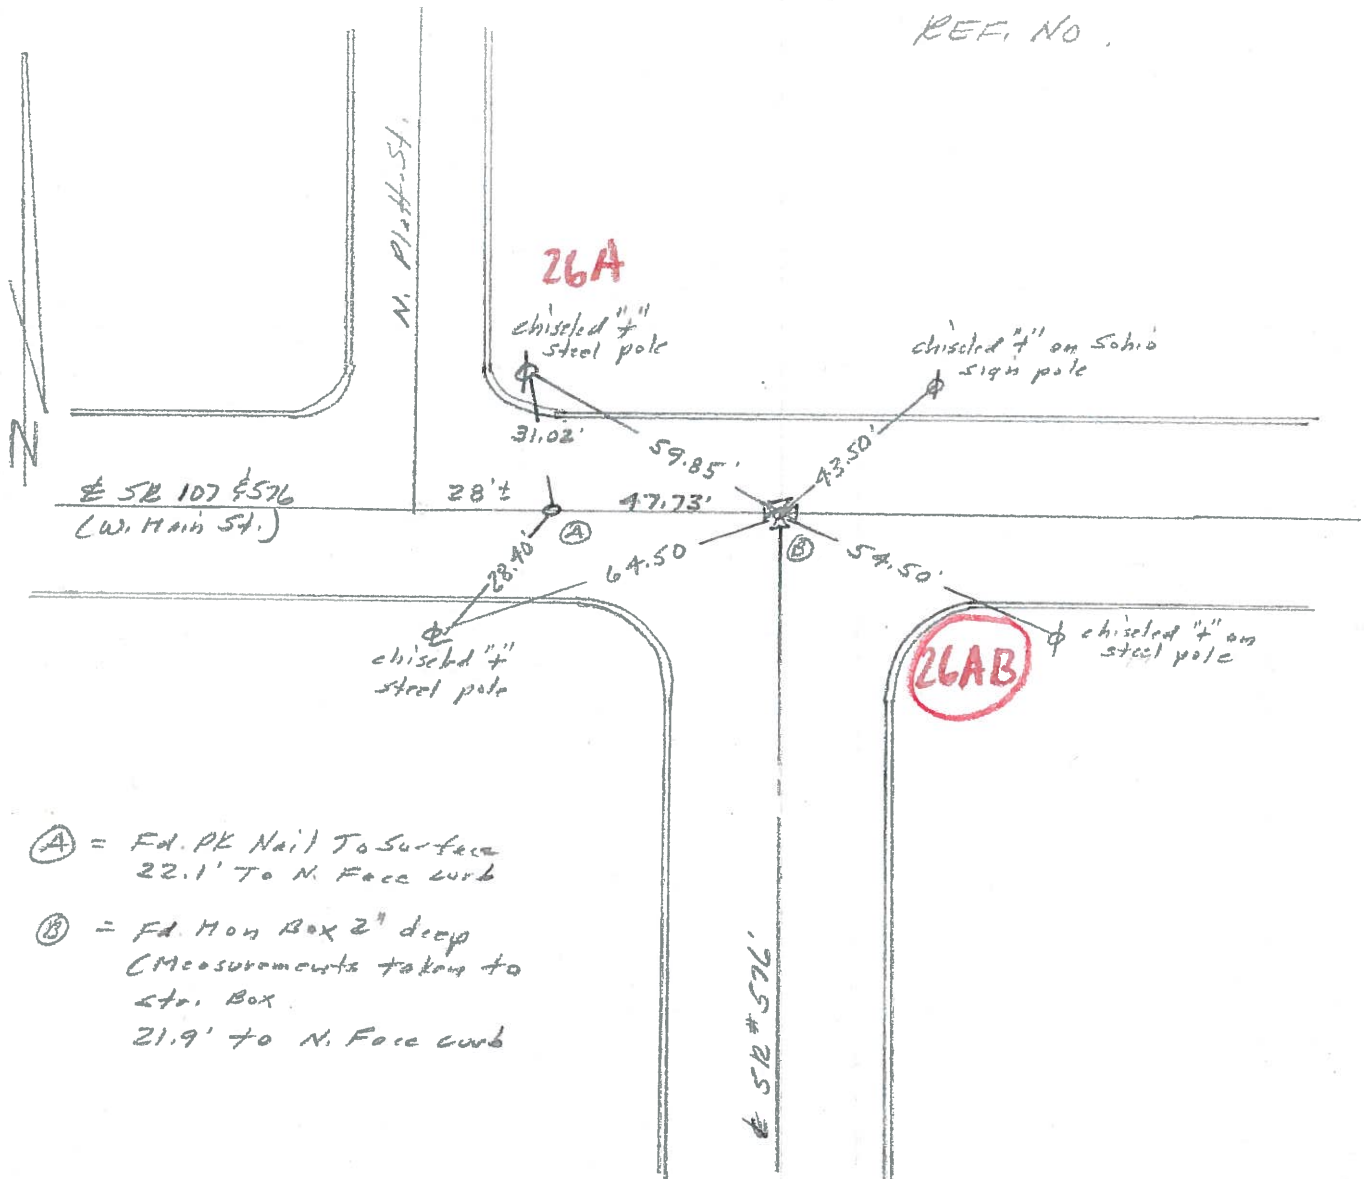

Ⓐ = Fd. PK Nail To Surface  
22.1' To N. Face curb

Ⓑ = Fd. Man Box 2' deep  
(Measurements taken to  
ctr. Box  
21.9' to N. Face curb