


O.D.O.T. DISTRICT 2 SURVEY OFFICE (USE ONLY)


PERSONNEL _____ REFERENCE NO. 26 D SHEET 21 OF 33
 NOTES HOMAN DATE 6/19/12 ROUTE SR 576
 H.C. ROUSOS WEATHER SUNNY COUNTY WILLIAMS
 R.C. HOMAN TEMP. 80° TOWNSHIP SUPERIOR
 DWG BY RHOADES PID CHIP SEAL SECTION 2
 T 7 N R 2 E

TYPE MONUMENT P.K.NAIL
 ON SURFACE - ~~BELOW~~ ON
 OFFSET Q PAVEMENT ON LT : RT
15.9' TO RT EDGE PAVEMENT
 STATION: 619+78.64

HORIZ.DATUM: NAD83 2011 GEOID: NAVD88 2018
 GRID: NORTHING: 707218.681 EASTING: 1390737.518

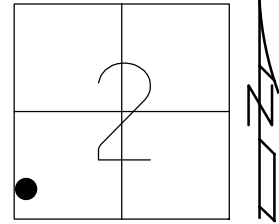

RECORD:
 SET P.K.NAIL
 9-4-86, IRS
 FD P.K.NAIL
 REF61
 6-19-12, DCH
 SET P.K./WASHER
 NEWREF61
 2/5/13, DCH
 FD P.K./WASHER
 REFD26
 7/5/22, TDN
 3/8/23, JMR

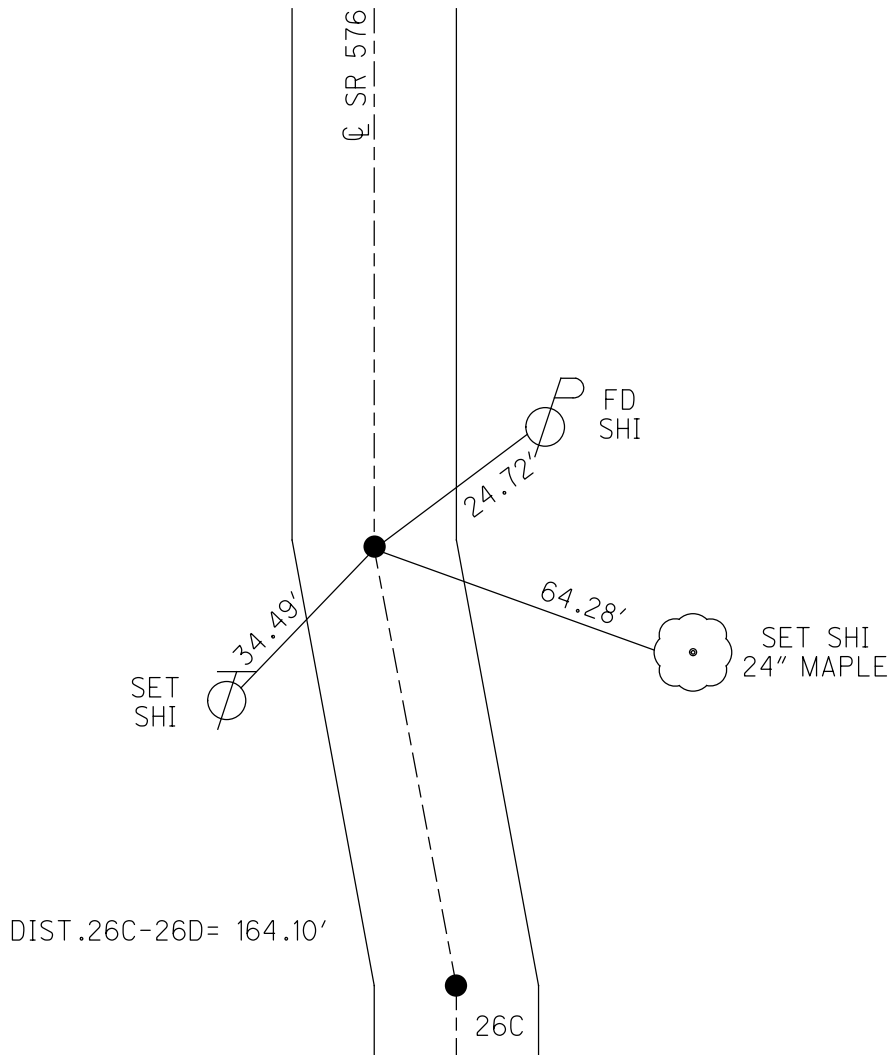


O.D.O.T. DISTRICT 2 SURVEY OFFICE (USE ONLY)

PERSONNEL _____ REFERENCE NO. 26 D SHEET 21 OF 32

NOTES HOMAN DATE 6-19-12 ROUTE SR 576
H.C. ROUSOS WEATHER SUNNY COUNTY WILLIAMS
R.C. HOMAN TEMP. 80° TOWNSHIP SUPERIOR
SECTION 2
T 7 N R 2 E

TYPE MONUMENT PK NAIL
ON SURFACE - ~~BELOW~~ ON
LEFT - ☉ PAV'T - RIGHT _____
_____ TO _____ EDGE PAVEMENT
S.L.M. 619+78.64

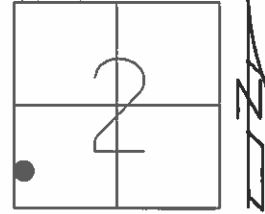


Grid: Northing: 707218.680 Easting: 1390737.473

SET PK NAIL
9-4-86, IRS

FD PK
REF61
6-19-12, DCH

SET PK/WASHER
GPS, NEWREF61
2/5/13, DCH

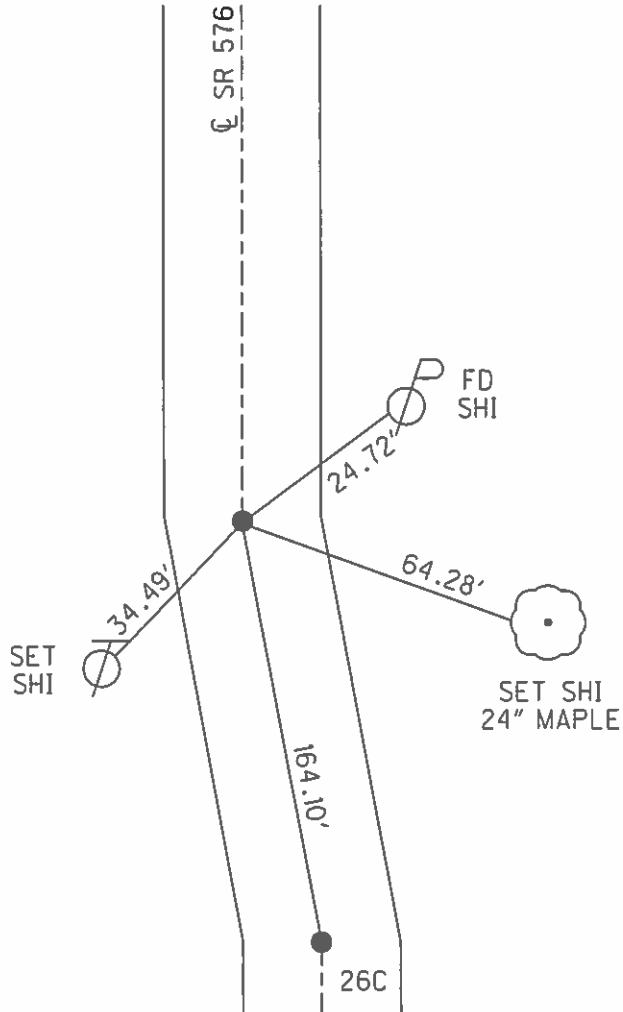

O.D.O.T. DISTRICT 2 SURVEY OFFICE

PERSONNEL _____

REFERENCE NO. _____

SHEET 2 OF _____

NOTES 1. Stone

H.C. D. Curtis

R.C. R. Michalak

J. Householder

DATE 8 April 86

WEATHER Cool

TEMP. 50°

ROUTE SR #576

COUNTY Williams

TOWNSHIP Superior

SECTION 2

T _____ R _____


TYPE MONUMENT PK Nail

ON SURFACE - BELOW Surface

LEFT - \odot PAV'T. - RIGHT _____

TO _____ EDGE PAVEMENT

S.L.M. 620 + 42

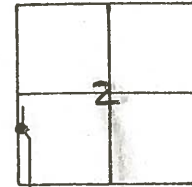

26D

Set PK Nail 9/4/86 IRS

