

O.D.O.T. DISTRICT 2 SURVEY OFFICE (USE ONLY)

PERSONNEL

REFERENCE NO. 26 DE

SHEET 22 OF 33

NOTES HOMAN

DATE 6/21/12

ROUTE SR 576

H.C. ROUSOS

WEATHER SUNNY

COUNTY WILLIAMS

R.C. HOMAN

TEMP. 80°

TOWNSHIP SUPERIOR

SECTION 2

DWG BY RHOADES

PID CHIP SEAL

T 7 N R 2 E

TYPE MONUMENT IPIN

ON SURFACE - ~~BELOW~~ ON

OFFSET ☉ PAVEMENT 3' ~~±~~ : RT

- TO - EDGE PAVEMENT


STATION: 664+77.52

HORIZ.DATUM: NAD83 2011


GEOID: NAVD88 2018

GRID: NORTHING: 711710.044

EASTING: 1390585.544

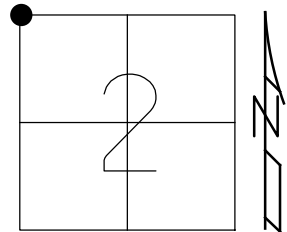


RECORD:
 FD IPIN
 REFA63
 6-21-12, DCH
 SET P.K./WASHER
 NEWREFA63
 7-10-12, DCH
 FD P.K.SHANK
 REFDE26
 7/5/22, TDN
 3/8/23, JMR

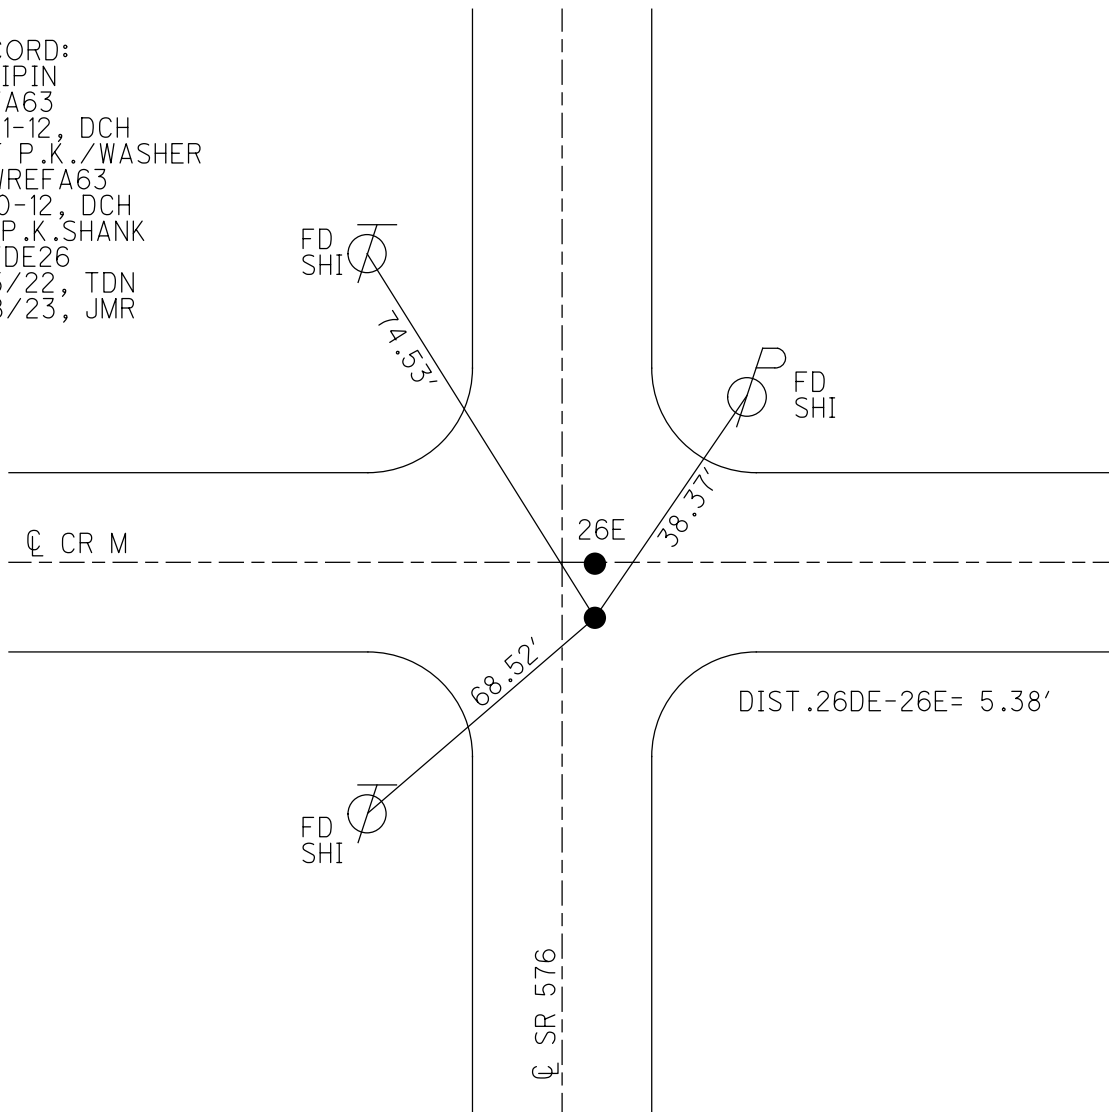

O.D.O.T. DISTRICT 2 SURVEY OFFICE (USE ONLY)

PERSONNEL _____ REFERENCE NO. 26 DE SHEET 22 OF 32
 NOTES HOMAN DATE 6-21-12 ROUTE SR 576
 H.C. ROUSOS WEATHER SUNNY COUNTY WILLIAMS
 R.C. HOMAN TEMP. 80° TOWNSHIP SUPERIOR
 SECTION 2,3,34,35
 T 7 N R 2 E

TYPE MONUMENT IPIN
 ON SURFACE - ~~BELOW~~ ON _____
~~LEFT~~ - CL PAV'T - RIGHT 3'
 _____ TO _____ EDGE PAVEMENT
 S.L.M. 665+36
 Grid: Northing: 711710.058 Easting: 1390585.457

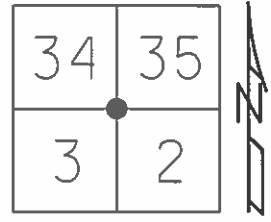

FD I PIN
 REF A63
 6-21-12
 SET PK/WASHER
 NEWREFA63
 7-10-12, DCH

