

O.D.O.T. DISTRICT 2 SURVEY OFFICE (USE ONLY)

PERSONNEL

REFERENCE NO. 26 E

SHEET 23 OF 33

NOTES HOMAN

DATE 6/21/12

ROUTE SR 576

H.C. ROUSOS

WEATHER SUNNY

COUNTY WILLIAMS

R.C. HOMAN

TEMP. 80°

TOWNSHIP SUPERIOR

SECTION 2

DWG BY RHOADES

PID CHIP SEAL

T 7 N R 2 E

TYPE MONUMENT P.K.NAIL

ON SURFACE - ~~BELOW~~ ON

OFFSET  $\varnothing$  PAVEMENT 5' ~~LF~~ : RT

- TO - EDGE PAVEMENT


STATION: 664+82.90

HORIZ.DATUM: NAD83 2011


GEOID: NAVD88 2018

GRID: NORTHING: 711714.979

EASTING: 1390587.686

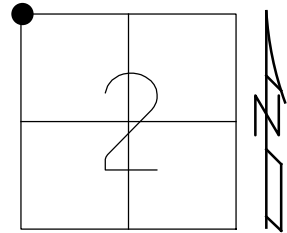


RECORD:  
P.K.NAIL  
9/4/86, IRS  
FD MAG NAIL  
REF63  
6-21-12, DCH  
SET MAG/WASHER  
NEWREF63  
7-10-12, DCH  
FD MAG/WASHER  
REFE26  
7/5/22, TDN  
3/8/23, JMR

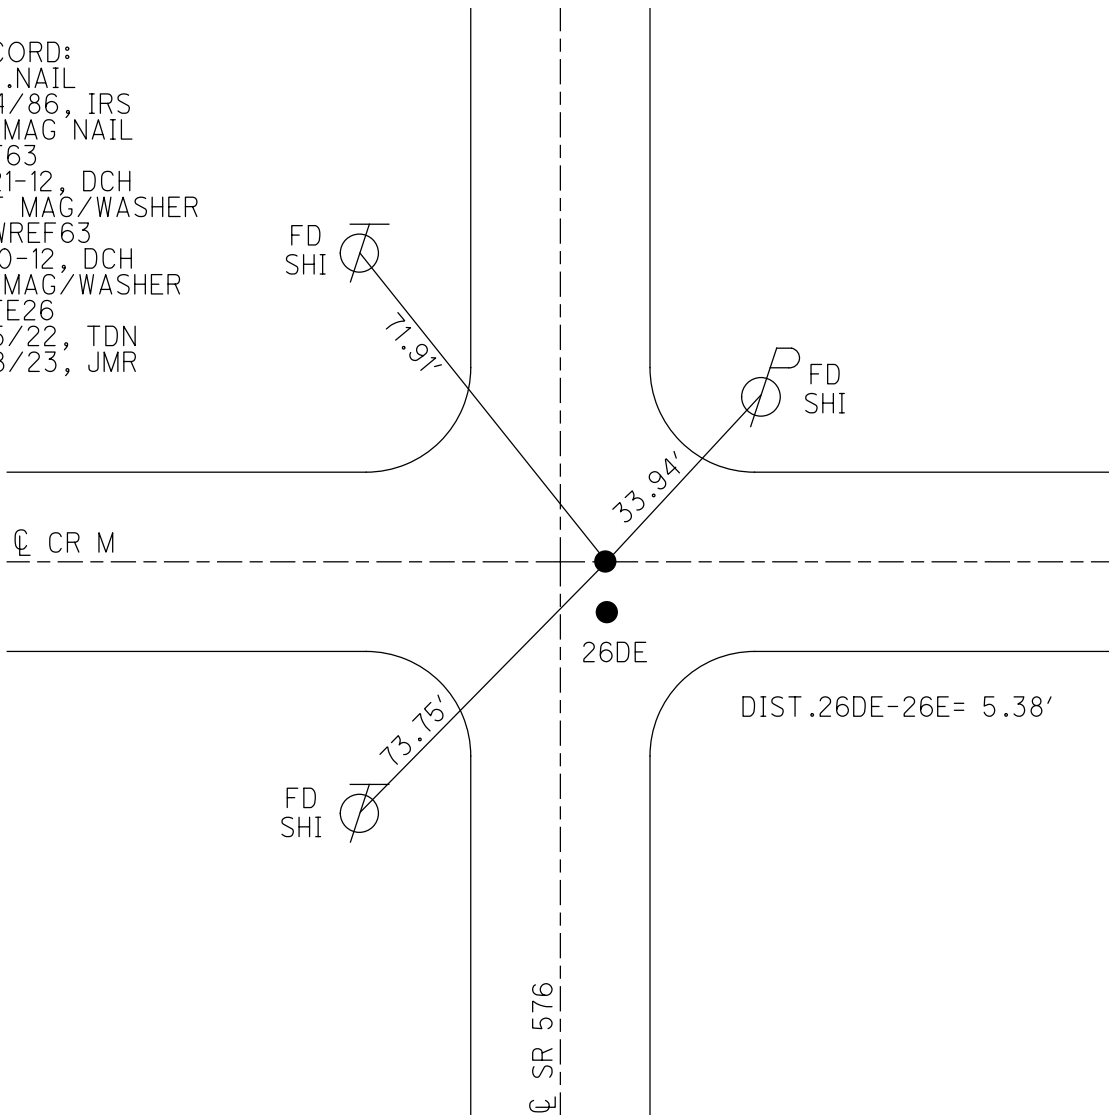

O.D.O.T. DISTRICT 2 SURVEY OFFICE (USE ONLY)

PERSONNEL \_\_\_\_\_ REFERENCE NO. 26 E SHEET 23 OF 32  
 NOTES HOMAN DATE 6-21-12 ROUTE SR 576  
 H.C. ROUSOS WEATHER SUNNY COUNTY WILLIAMS  
 R.C. HOMAN TEMP. 80° TOWNSHIP SUPERIOR  
 \_\_\_\_\_ SECTION 2,3,34,35  
 \_\_\_\_\_ T 7 N R 2 E

TYPE MONUMENT PK NAIL  
 ON SURFACE - ~~BELOW~~ ON \_\_\_\_\_  
~~LEFT~~ - ☉ PAV'T - RIGHT 5'  
 \_\_\_\_\_ TO \_\_\_\_\_ EDGE PAVEMENT  
 S.L.M. 665+41

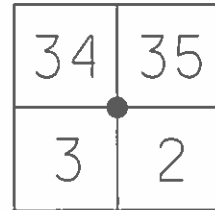


Grid: Northing: 711715.097 Easting: 1390587.581

SET PK NAIL  
 9-4-86, IRS

REF 63  
 FD MAG  
 6-21-12

NEW REF 63  
 SET MAG/WASHER  
 7-10-12, DCH

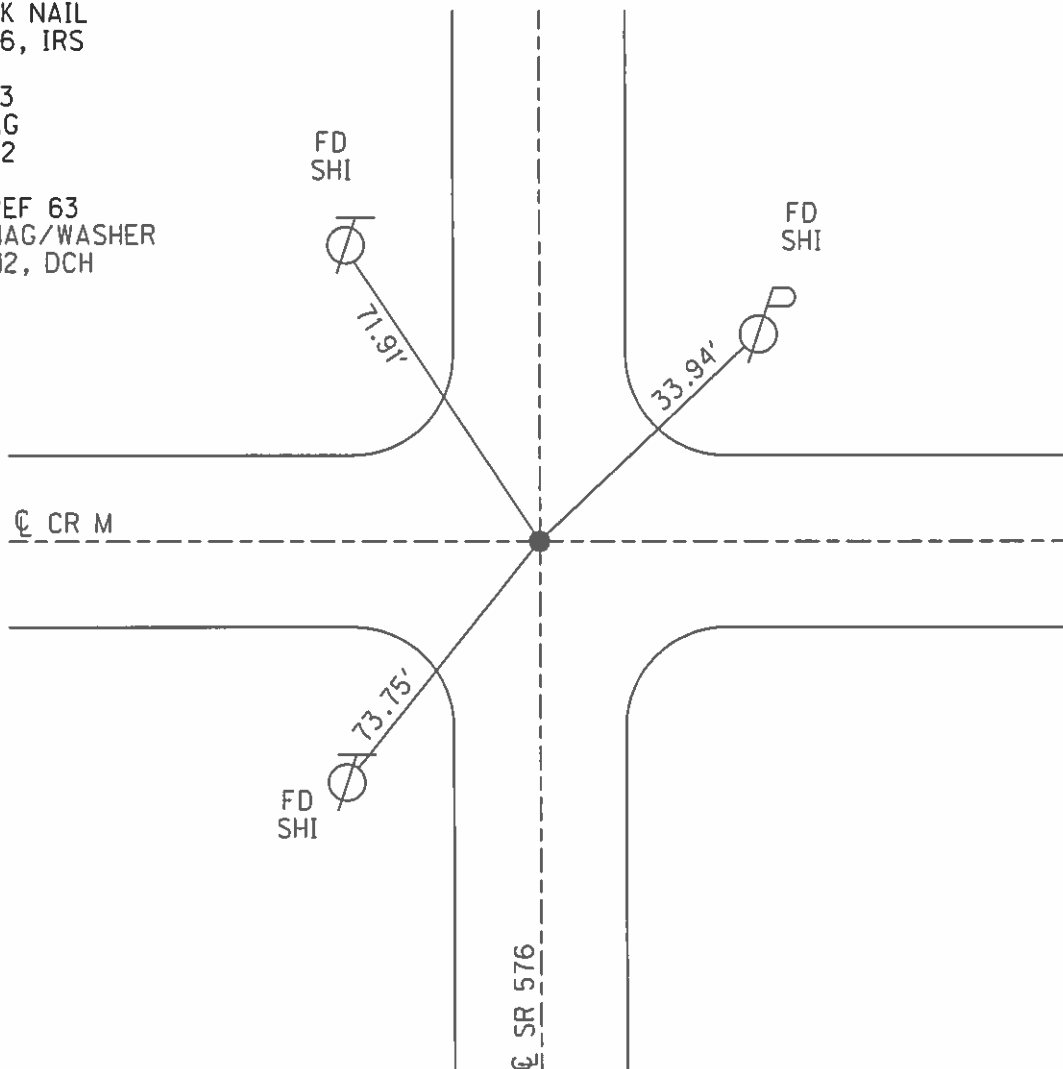

# O.D.O.T. DISTRICT 2 SURVEY OFFICE

PERSONNEL \_\_\_\_\_

REFERENCE NO. \_\_\_\_\_

SHEET 9 OF \_\_\_\_\_

NOTES 1. Stone

H.C. D. Curtis

R.C. R. Michalak

J. Household

DATE 8 April 86

WEATHER Cool

TEMP. 50°

ROUTE SR#576

COUNTY Williams

TOWNSHIP Superior

SECTION 2-3-34-35

T. \_\_\_\_\_ R. \_\_\_\_\_

TYPE MONUMENT PK Nail

ON SURFACE - BELOW Surface

LEFT - ☉ PAV'T. - RIGHT \_\_\_\_\_

TO \_\_\_\_\_ EDGE PAVEMENT

S.L.M. 665+41

34	35
3	2



26 E

Set PK Nail 9/4/86 1RS

