


O.D.O.T. DISTRICT 2 SURVEY OFFICE (USE ONLY)


PERSONNEL \_\_\_\_\_ REFERENCE NO. 27 SHEET 24 OF 33  
 NOTES HOMAN DATE 6/21/12 ROUTE SR 576  
 H.C. ROUSOS WEATHER SUNNY COUNTY WILLIAMS  
 R.C. HOMAN TEMP. 80° TOWNSHIP SUPERIOR  
 DWG BY RHOADES PID CHIP SEAL SECTION 34  
 T 8 N R 2 E

TYPE MONUMENT R.R.SPIKE  
 ON SURFACE - ~~BELOW~~ ON  
 OFFSET  $\varnothing$  PAVEMENT 0.5' LT : ~~RT~~  
10.6' TO LT EDGE PAVEMENT  
 STATION: 675+39.52

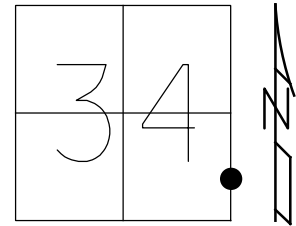

HORIZ.DATUM: NAD83 2011 GEOID: NAVD88 2018  
 GRID: NORTHING: 712771.648 EASTING: 1390594.756


RECORD: P.I.  
 STA.675+97.71  
 $\Delta = 0^\circ 41' 04''$  RT  
 SET SM.SPIKE  
 9-4-86, IRS  
 FD R.R.SPIKE  
 REF64  
 6-21-12, DCH  
 SET MAG/WASHER  
 NEWREF64  
 7-10-12, DCH  
 FD P.K./WASHER  
 REF27  
 4-22-16, JFO  
 FD MAG/WASHER  
 REF27  
 7/5/22, TDN  
 3/8/23, JMR

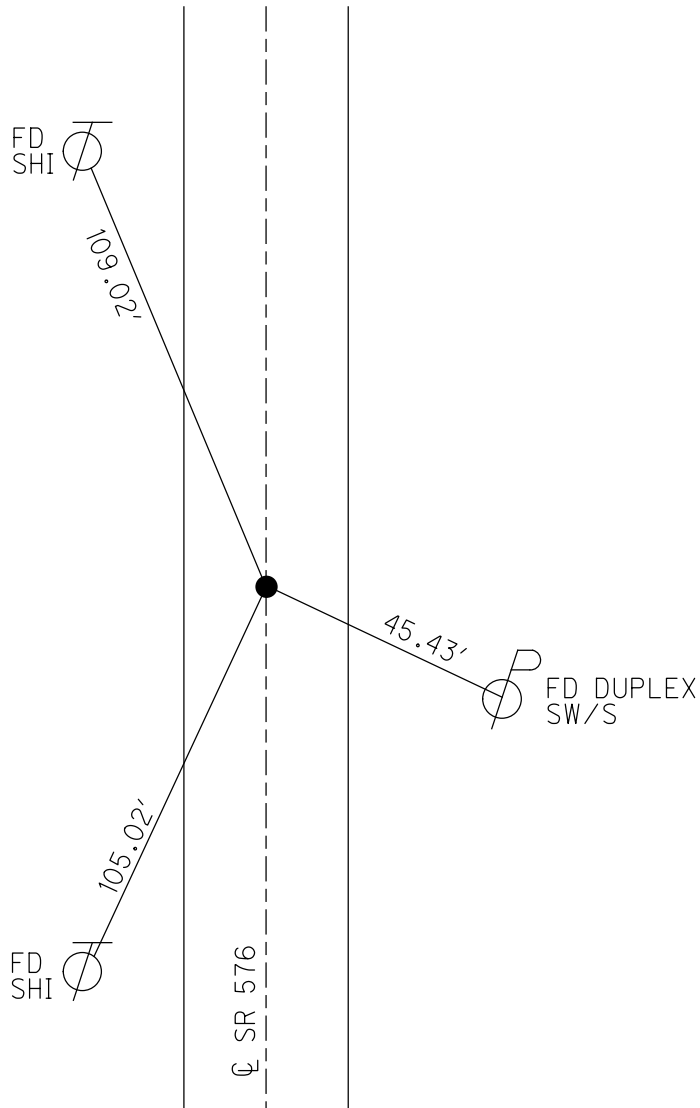


O.D.O.T. DISTRICT 2 SURVEY OFFICE (USE ONLY)

PERSONNEL \_\_\_\_\_ REFERENCE NO. 27 SHEET 24 OF 32  
 NOTES HOMAN DATE 6-21-12 ROUTE SR 576  
 H.C. ROUSOS WEATHER SUNNY COUNTY WILLIAMS  
 R.C. HOMAN TEMP. 80° TOWNSHIP SUPERIOR  
 \_\_\_\_\_ SECTION 11  
 \_\_\_\_\_ T 8 N R 2 E

TYPE MONUMENT RR SPIKE  
 ON SURFACE - ~~BELOW~~ ON  
 LEFT - ☉ PAV'T - ~~RIGHT~~ 1'  
 - TO - EDGE PAVEMENT  
 S.L.M. 675+39.52  
 Grid: Northing: 712771.742 Easting: 1390594.6890

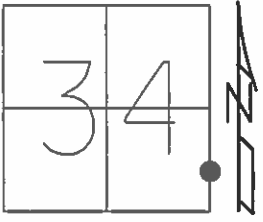

SET SMALL SPK  
 9-4-86, IRS  
 FD RR SPK  
 REF64  
 6-21-12, DCH  
 SET MAG/WASHER  
 GPS, NEWREF64  
 7-10-12, DCH  
 FD PK/WASHER  
 GPS, REF27  
 4-22-16, JFO

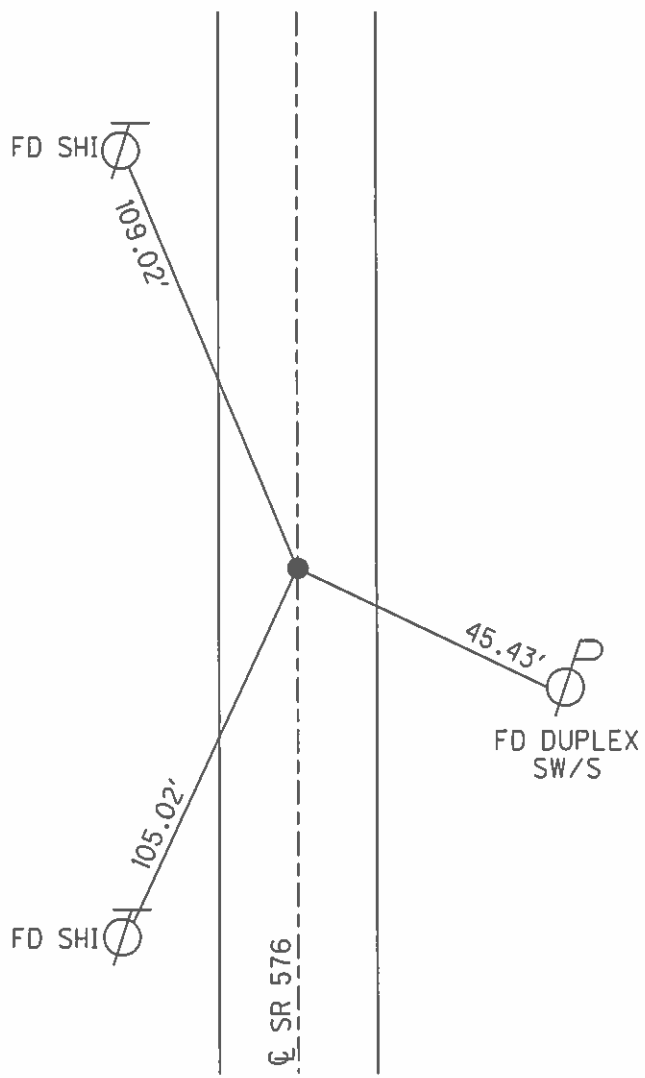


O.D.O.T. DISTRICT 2 SURVEY OFFICE (USE ONLY)

PERSONNEL \_\_\_\_\_ REFERENCE NO. 27 SHEET 30 OF 38  
 NOTES HOMAN DATE 6-21-12 ROUTE SR 576  
 H.C. ROUSOS WEATHER SUNNY COUNTY WILLIAMS  
 R.C. HOMAN TEMP. 80° TOWNSHIP SUPERIOR  
 \_\_\_\_\_ SECTION 11  
 \_\_\_\_\_ T 8 N R 2 E

TYPE MONUMENT RR SPIKE  
 ON SURFACE - ~~BELOW~~ ON \_\_\_\_\_  
 LEFT - ☉ PAV'T - ~~RIGHT~~ 1' \_\_\_\_\_  
 \_\_\_\_\_ TO \_\_\_\_\_ EDGE PAVEMENT  
 S.L.M. 675+39.52

Grid: Northing: 712771.690 Easting: 1390594.593

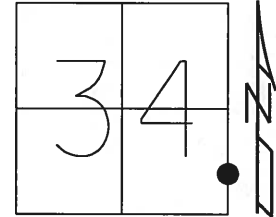


SET SMALL SPK  
7-4-86, IRS

FD RR SPK  
REF64  
6-21-12, DCH

SET MAG/WASHER  
GPS, NEWREF64  
7-10-12, DCH

SET  
SHI

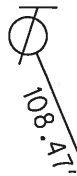

108.47'


SET  
SHI



104.95'

45.38'

FD  
DUPLEX

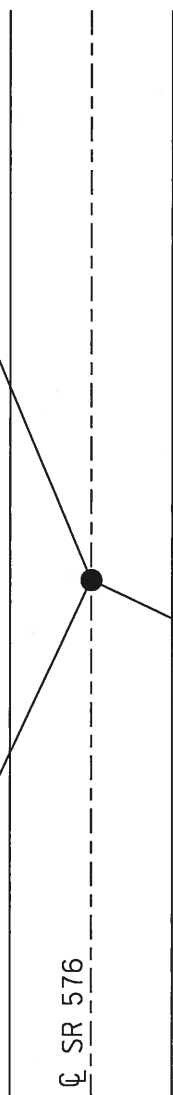

☉ SR 576

# O.D.O.T. DISTRICT 2 SURVEY OFFICE

PERSONNEL

REFERENCE NO. 27


SHEET 4 OF     

NOTES 1/ Stone  
 H.C. D. Curtis  
 R.C. R. Michalak  
J. Housholder


DATE 8 April 86  
 WEATHER Cool  
 TEMP. 50°

ROUTE SR# 576  
 COUNTY Williams  
 TOWNSHIP Superior  
 SECTION 34  
 T      R     

TYPE MONUMENT 3/4" I. pipe  
 ON SURFACE - BELOW 4" deep  
 LEFT -      PAV'T. - RIGHT       
     TO      EDGE PAVEMENT  
 S.L.M. 676+03

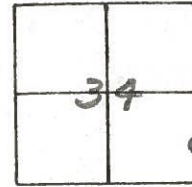

*Set Small Spk. 7/4/86 JRS*

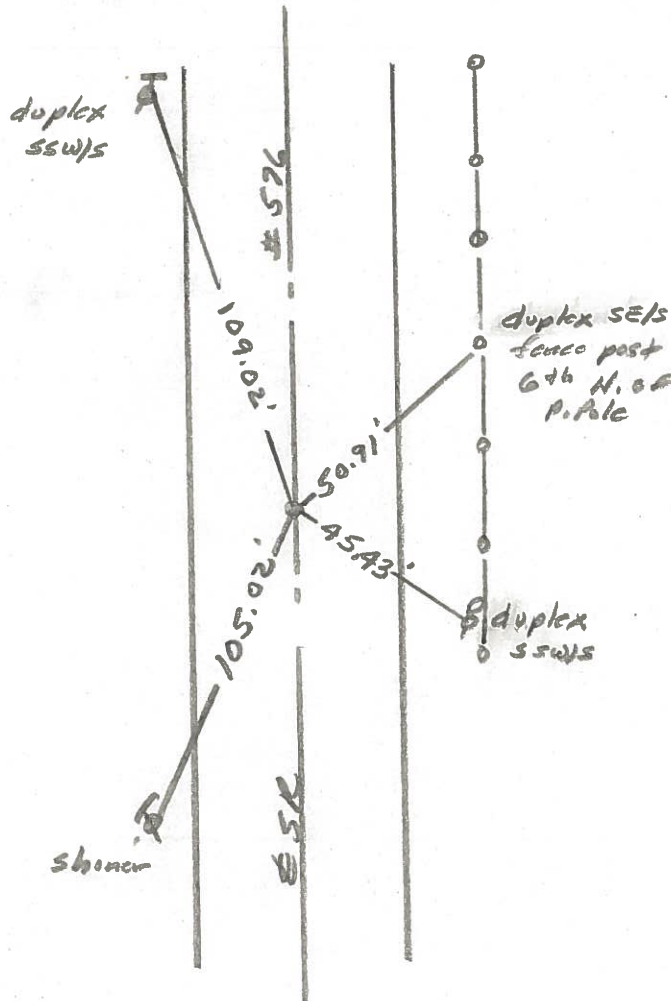

PERSONNEL TITLE PERSONNEL TITLE

COUNTY Williams DATE 11 Aug 76

Red Beach  
W. Krape

S. R. 576 WEATHER \_\_\_\_\_

SEC 34/35 Superior Twp T-8-N TEMP \_\_\_\_\_

DESCRIPTION CONTROL POINTS JOB NO. \_\_\_\_\_

**27**

