

O.D.O.T. DISTRICT 2 SURVEY OFFICE (USE ONLY)

PERSONNEL

REFERENCE NO. 27 B

SHEET 27 OF 33

NOTES NIESE

DATE 7/5/22

ROUTE SR 576

H.C. NIESE

WEATHER BREEZY

COUNTY WILLIAMS

R.C. WHITAKER

TEMP. 80°

TOWNSHIP SUPERIOR

SECTION 34

DWG BY RHOADES

PID CHIP SEAL

T 8 N R 2 E

TYPE MONUMENT P.K./WASHER

ON SURFACE - ~~BELOW~~ ON

OFFSET \odot PAVEMENT 1' LT : ~~RT~~

11.2' TO LT EDGE PAVEMENT



STATION: 701+70.13

HORIZ.DATUM: NAD83 2011


GEOID: NAVD88 2018

GRID: NORTHING: 715401.707

EASTING: 1390651.224

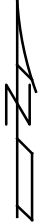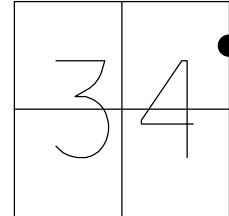


RECORD:
 SET SM.R.R.SPIKE
 9-4-86, IRS
 FD 3/4" IPIPE
 REF66
 6-19-12, DCH
 SET P.K./WASHER
 NEWREF66
 7-11-12, DCH
 FD P.K./WASHER
 REFB27
 4-22-16, JFO
 FD MAG NAIL
 REFB27
 7/5/22, TDN
 3/8/23, JMR

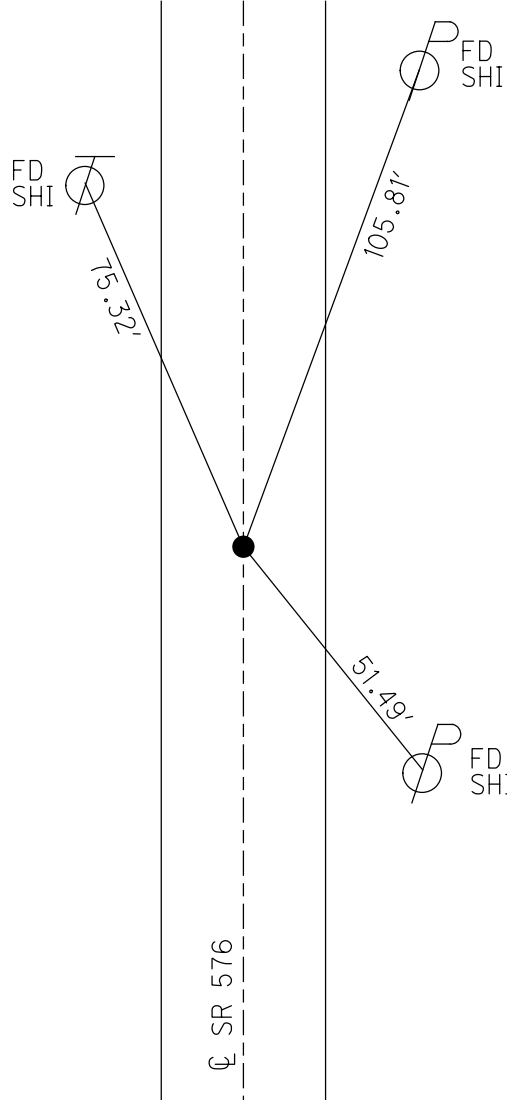

O.D.O.T. DISTRICT 2 SURVEY OFFICE (USE ONLY)

PERSONNEL _____ REFERENCE NO. 27 B SHEET 26 OF 32
 NOTES HOMAN DATE 6-19-12 ROUTE SR 576
 H.C. ROUSOS WEATHER SUNNY COUNTY WILLIAMS
 R.C. HOMAN TEMP. 90° TOWNSHIP SUPERIOR
 _____ SECTION 34
 _____ T 8 N R 2 E

TYPE MONUMENT 3/4" IPIPE
~~ON SURFACE~~ - BELOW 4"
 LEFT - ☉ PAV'T - RIGHT ON
- TO - EDGE PAVEMENT
 S.L.M. 701+70.13

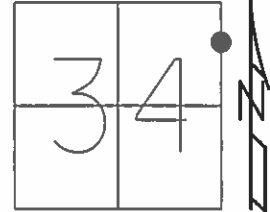


Grid: Northing: 713773.8311 Easting: 1390614.8340

SET SMALL SPK
9-4-86, IRS

FD RR SPK
REF66
6-19-12, DCH

SET PK/WASHER
GPS, NEWREF66
7-11-12, DCH

FD PK/WASHER
GPS, REFB27
4-22-16, JFO

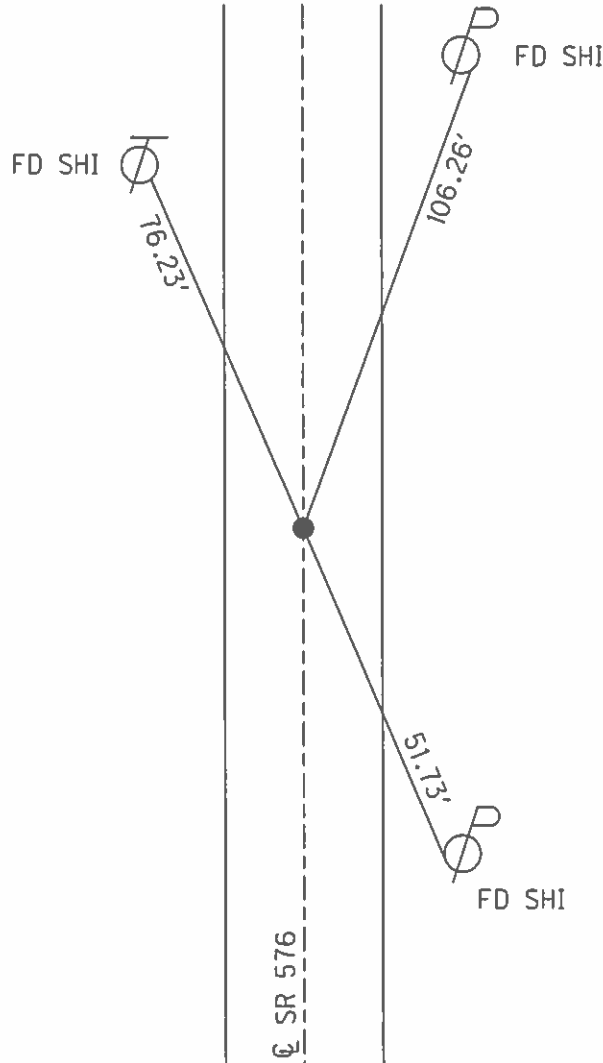


O.D.O.T. DISTRICT 2 SURVEY OFFICE (USE ONLY)

PERSONNEL _____ REFERENCE NO. 27 B SHEET 32 OF 38
 NOTES HOMAN DATE 6-19-12 ROUTE SR 576
 H.C. ROUSOS WEATHER SUNNY COUNTY WILLIAMS
 R.C. HOMAN TEMP. 90° TOWNSHIP SUPERIOR
 _____ SECTION 34
 _____ T 8 N R 2 E

TYPE MONUMENT 3/4" IPIPE
~~ON SURFACE~~ - BELOW 4"
 LEFT - ☉ PAV'T - RIGHT _____
 _____ TO _____ EDGE PAVEMENT
 S.L.M. 701+70.13


Grid: Northing: 715401.688 Easting: 1390651.125

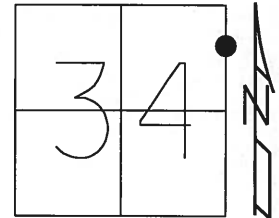

SET SMALL SPK
9-4-86, IRS

FD RR SPK
REF66
6-19-12, DCH

SET PK/WASHER
GPS, NEWREF66
7-11-12, DCH

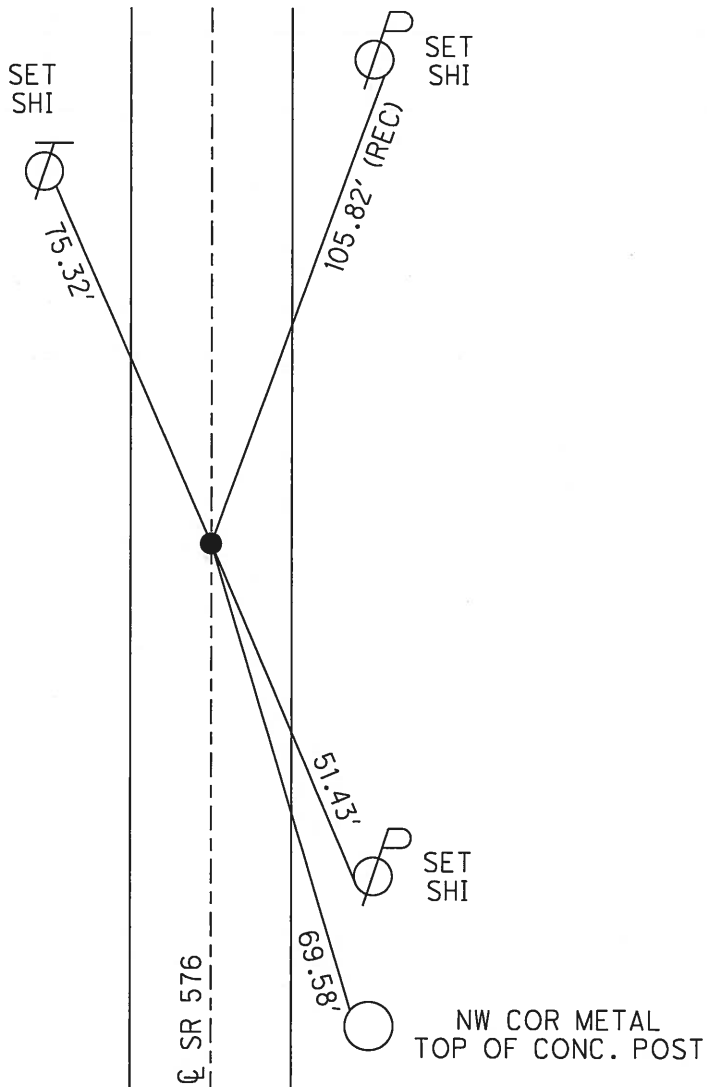

O.D.O.T. DISTRICT 2 SURVEY OFFICE

PERSONNEL


REFERENCE NO. 27-8 SHEET 6 OF

NOTES h. Stone
 H.C. D. Curtis
 R.C. R. Michalak
J. Hauschalter

DATE 8 April 86
 WEATHER Cool
 TEMP. 50°

ROUTE SR#576
 COUNTY Williams
 TOWNSHIP
 SECTION
 T R

TYPE MONUMENT 3/4" I. pipe
 ON SURFACE - BELOW 4" deep
 LEFT - ☉ PAV'T. - RIGHT
 TO EDGE PAVEMENT
 S.L.M. 702+34

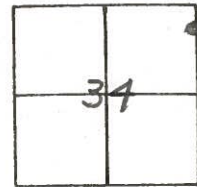

Set Small Spk. 9/4/86 1es

