



PERSONNEL TITLE PERSONNEL TITLE COUNTY WOOD DATE 4-8-93
 VAN DUSEN III
 BARNHISEL TAPE
 CORDS TAPE
 GREEN
 S.R. U.S. 6 WEATHER cloudy
 SEC. 11.76 (By-Pass) TEMP. +50°

DESCRIPTION PAU'T MARKINGS CENTER LINE RIGHT JOB NO.

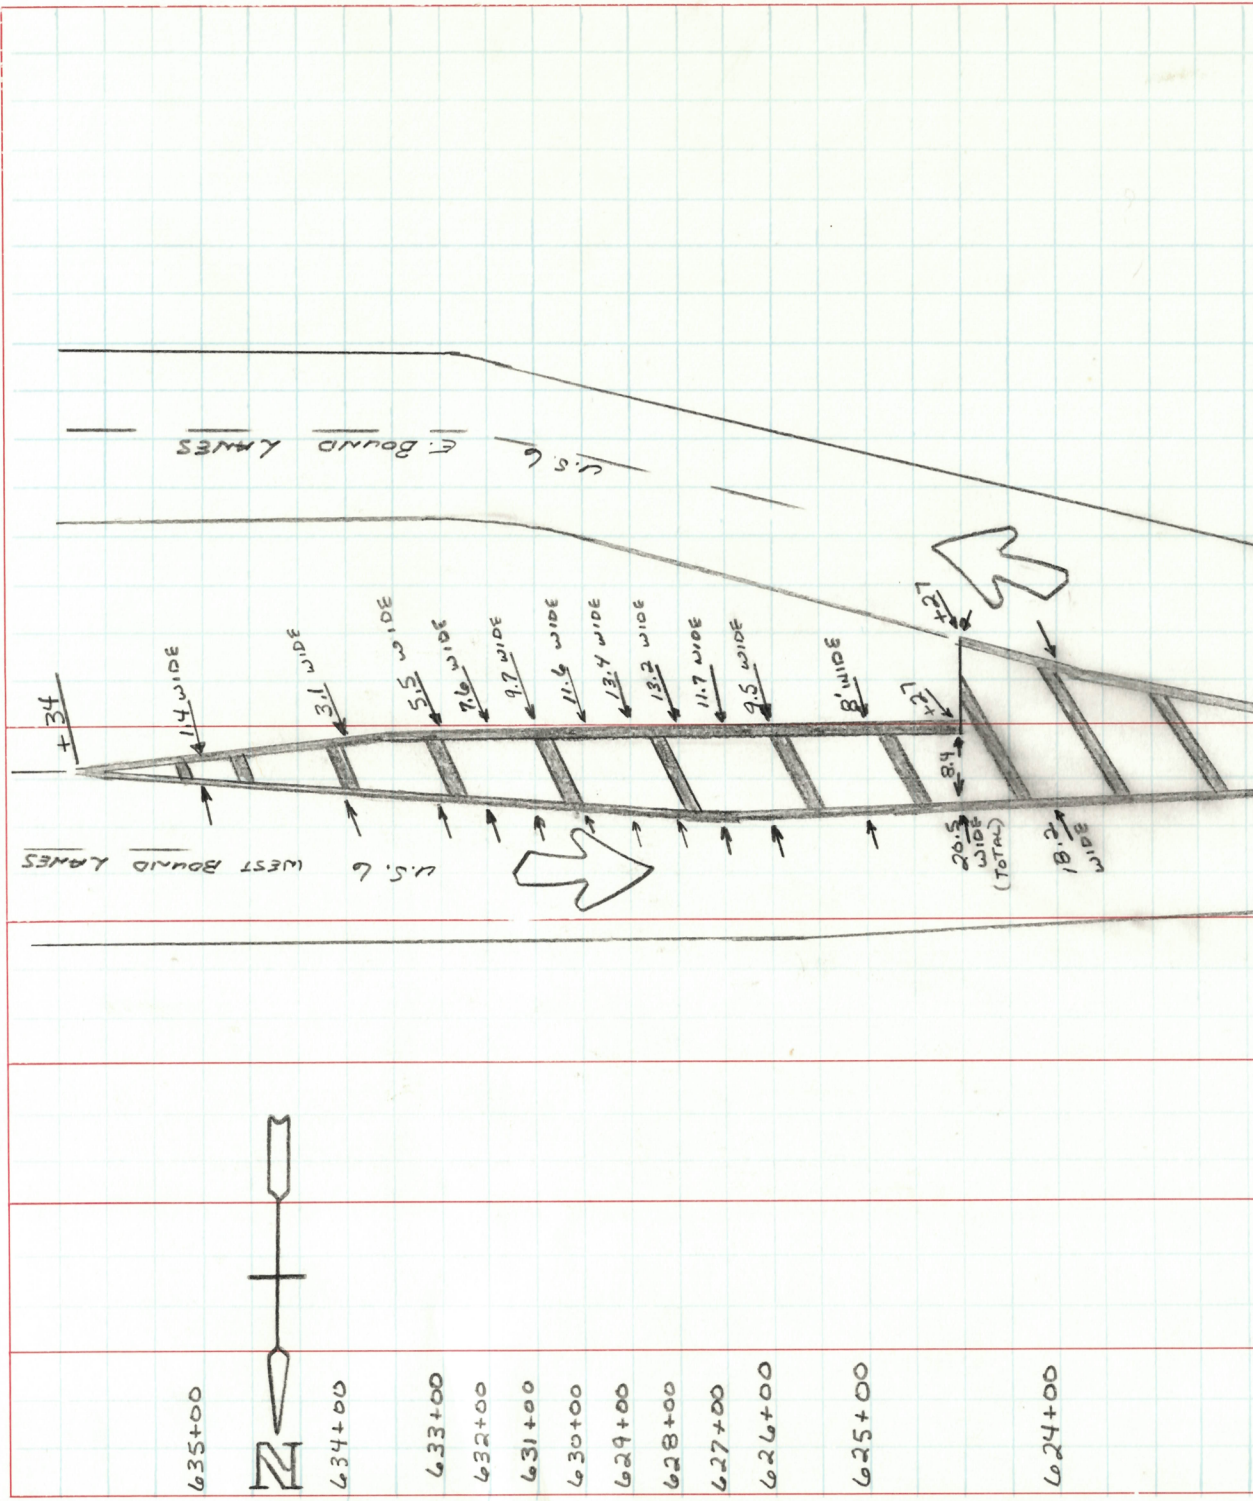

DESCRIPTION	PAV'T MARKINGS	CENTER LINE	RIGHT	JOB NO.
		LEFT		

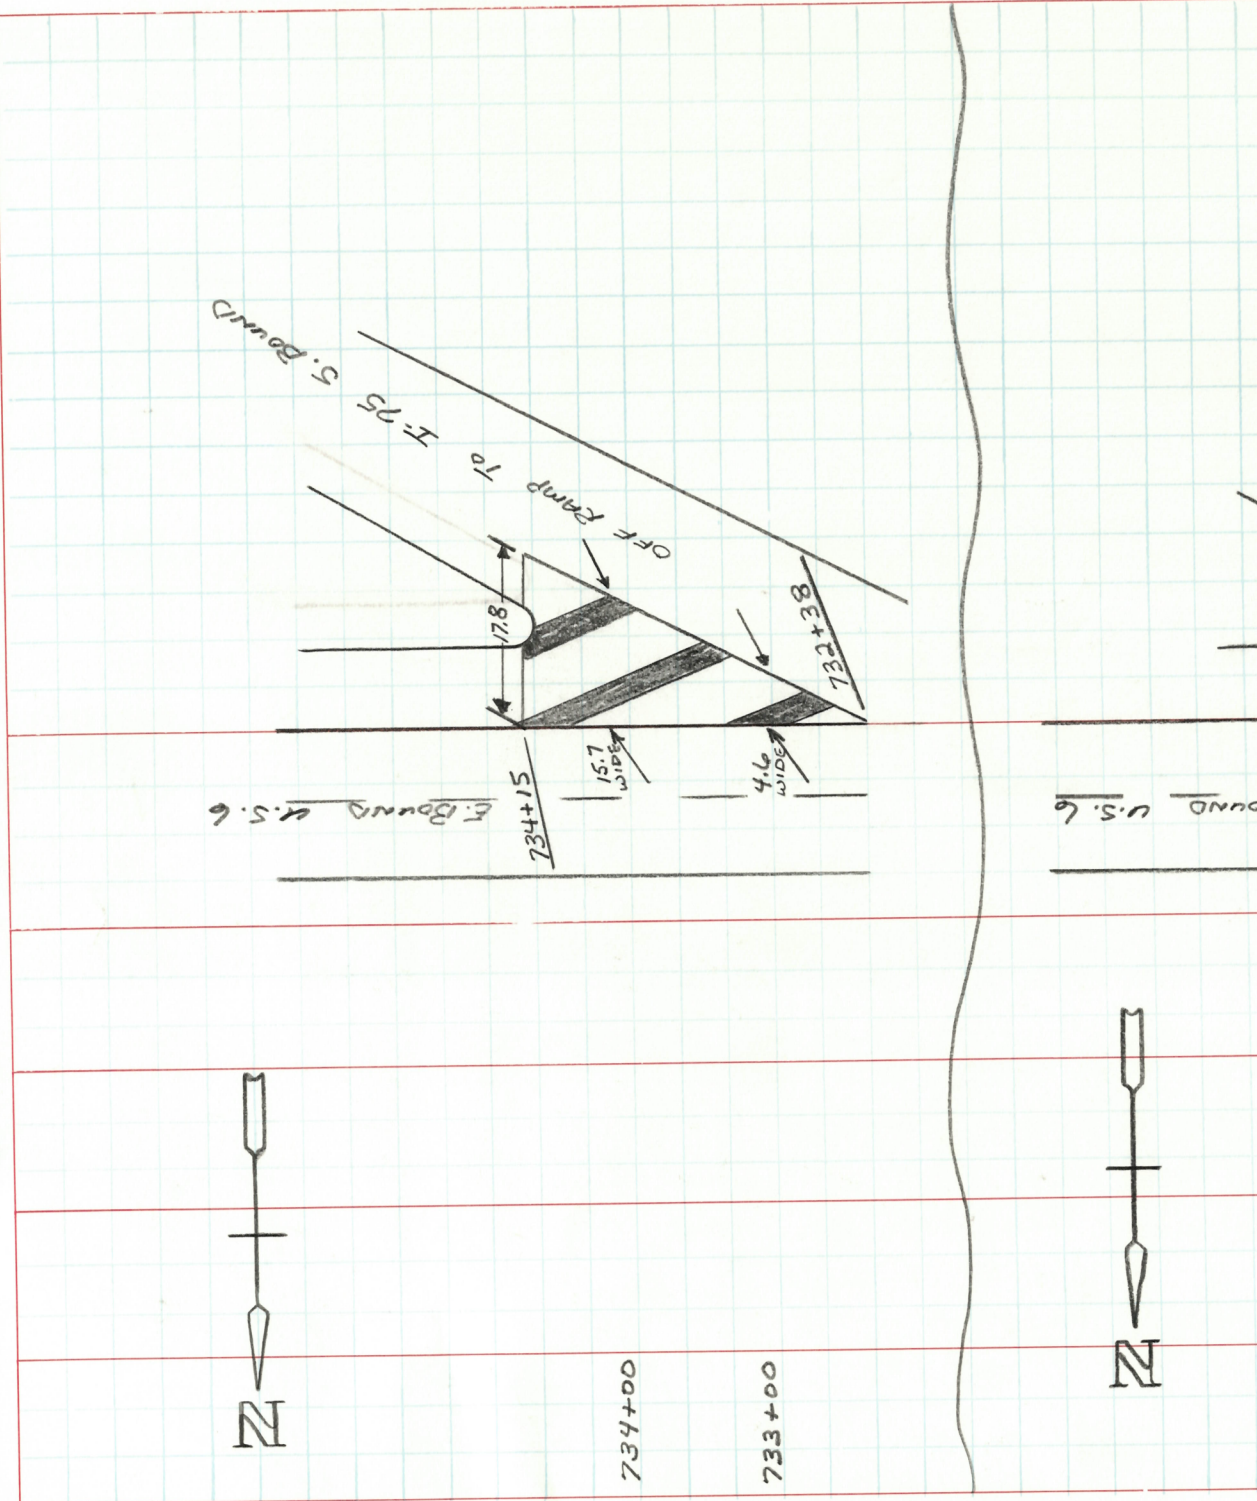


LD-5 Rev. 2-83

OHIO DEPARTMENT OF TRANSPORTATION

SHEET NO. 3 of 5

PERSONNEL	TITLE	PERSONNEL	TITLE	COUNTY	DATE	WEATHER	TEMP	JOB NO.
VAN DUSEN		WOOD		U.S. 6	4-8-93	Cloudy	+55°	
BARNHISEL	III							
CORDES	TAPE							
GREEN	TAPE							

DESCRIPTION PAV'T MARKINGS

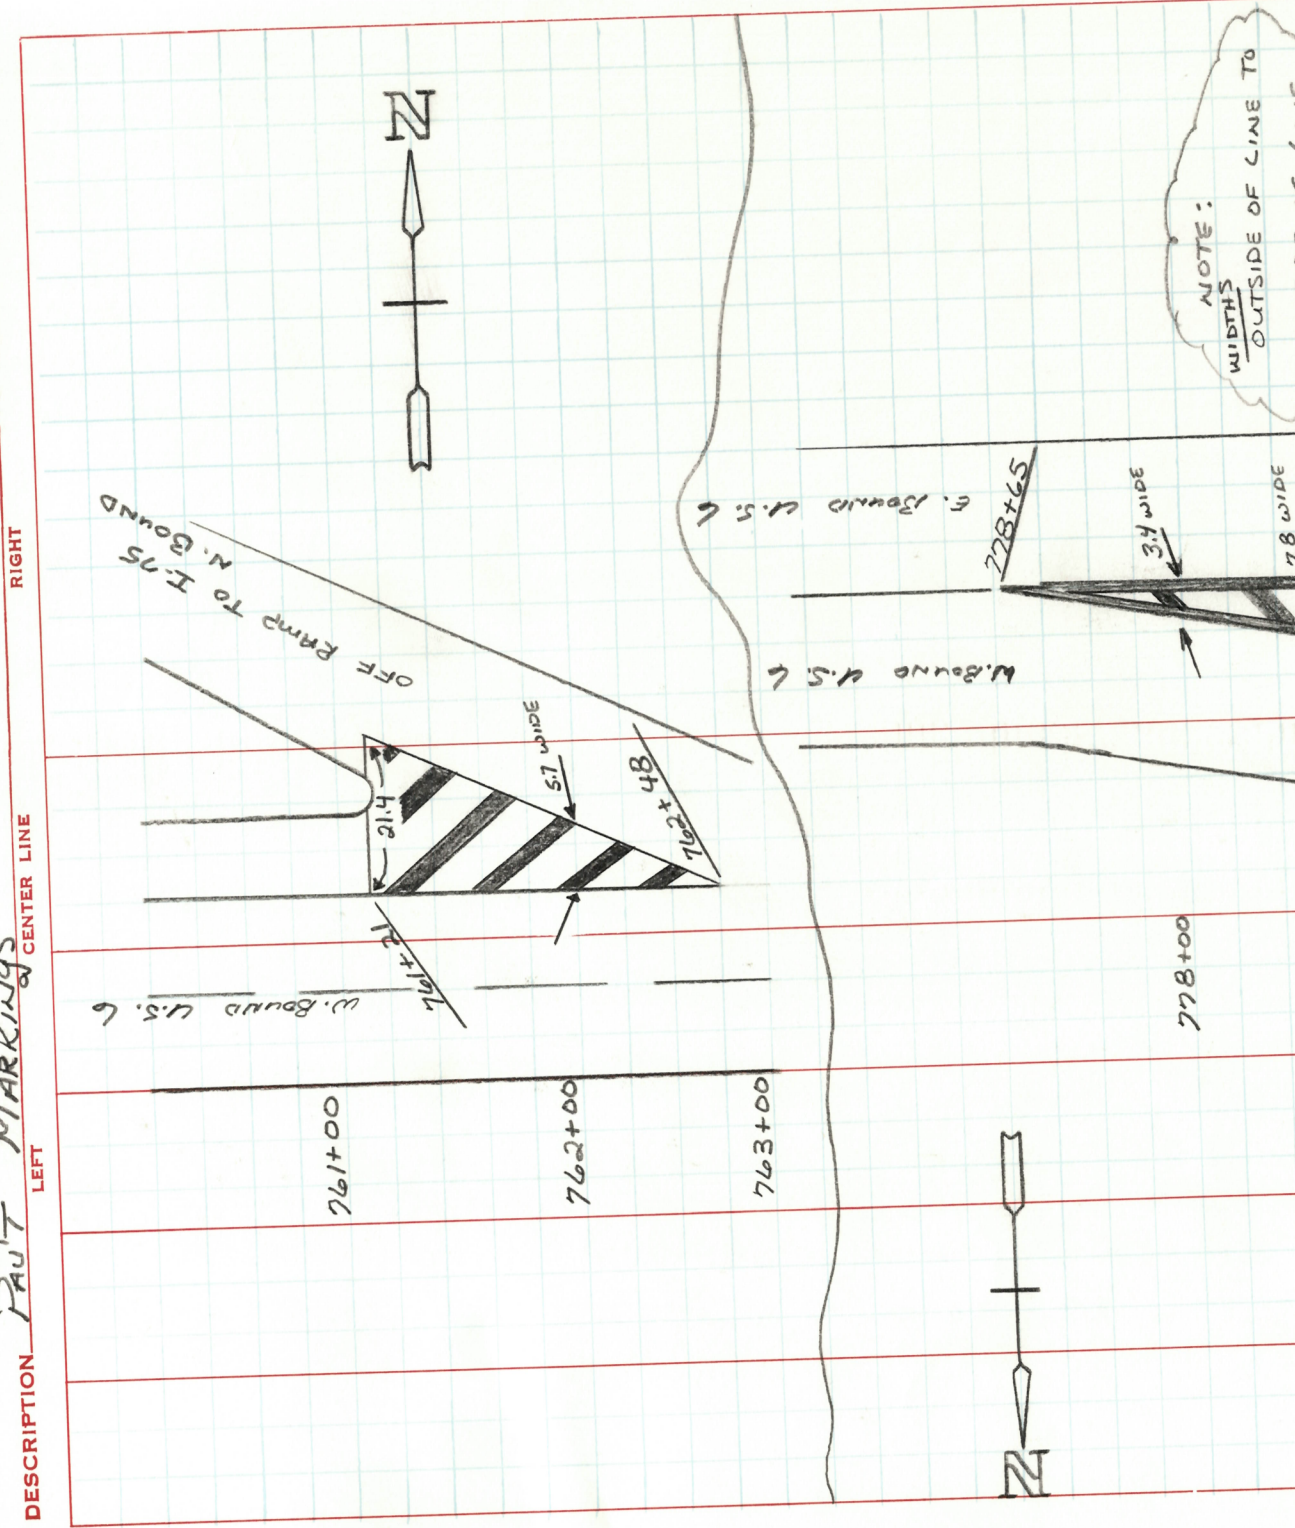

OHIO DEPARTMENT OF TRANSPORTATION


SHEET NO. 4 of 5

LD-5 Rev. 2-83

PERSONNEL	TITLE	PERSONNEL	TITLE	COUNTY	DATE	WEATHER	TEMP.
VAN DUSEN				WOOD	4-8-93	cloudy	+55°
BARNHISEL	III			S.R.			
CORDES	TAPE			SEC.	11.76 (34-PASS)		
GREEN	TAPE						

JOB NO. _____

DESCRIPTION PAV'T MARKINGS

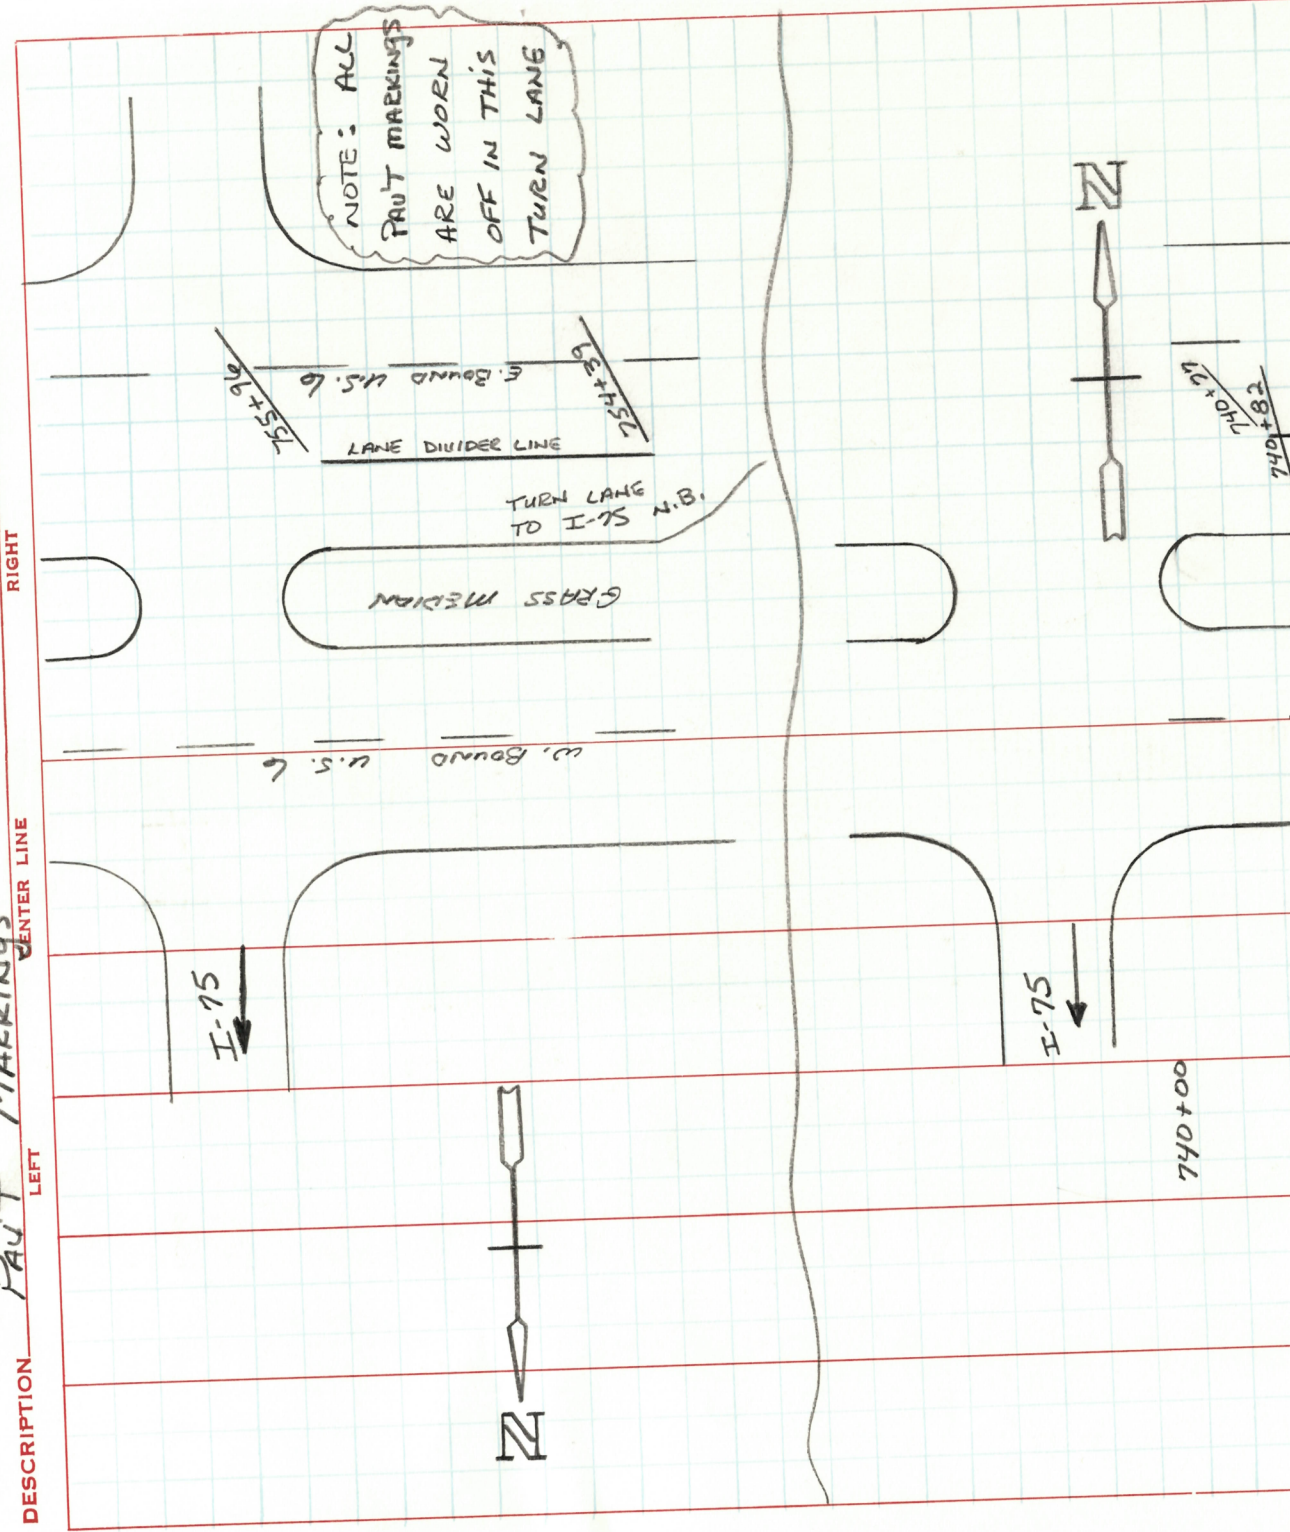

OHIO DEPARTMENT OF TRANSPORTATION

SHEET NO. 5 of 5

PERSONNEL	TITLE	PERSONNEL	TITLE	COUNTY	DATE	WEATHER	TEMP.
VAN DUSEN				WOOD	4-8-93	cloudy	
BARNHISEL	III			S.R.			
CORDES	TAPE						
GREEN	TAPE						

DESCRIPTION PAU'T MARKINGS

LEFT

CENTER LINE

RIGHT

JOB NO.

TO
OFF RAMP
25

680+49

680+00