

ODOT (D-2)

1990 TWO-LANE RESURFACING PROGRAM

SHEET 2 OF 14

APPROACHES (INTERSECTIONS & DRIVES)

COUNTY Wood

ROUTE U.S. 6

SECTION

00
—
—

L = Prop Pav't Depth (in.) x 10; W = Width @ Mouth; W-1 = Width @ Throat

[illegible]

UTILITIES (Catch Basin, Manhole, Inlet, Watervale Box and Monument Box)

COUNTY Wood ROUTE US6 SECTION 11.8 -- 14.7

R = Raise F = Feather


[illegible]

OHIO DEPARTMENT OF TRANSPORTATION

SHEET NO. 5 of 14

PERSONNEL TITLE PERSONNEL TITLE COUNTY Wood DATE 6-27-91
 Van Dusen
 Loehke
 Barnhisel
 Kuse
 S. R. US 6 WEATHER Clear
 SEC. 11.8 TEMP. 90° F.

DESCRIPTION Wood US 6 Four Lane RESURFACE JOB NO.
 LEFT CENTER LINE RIGHT

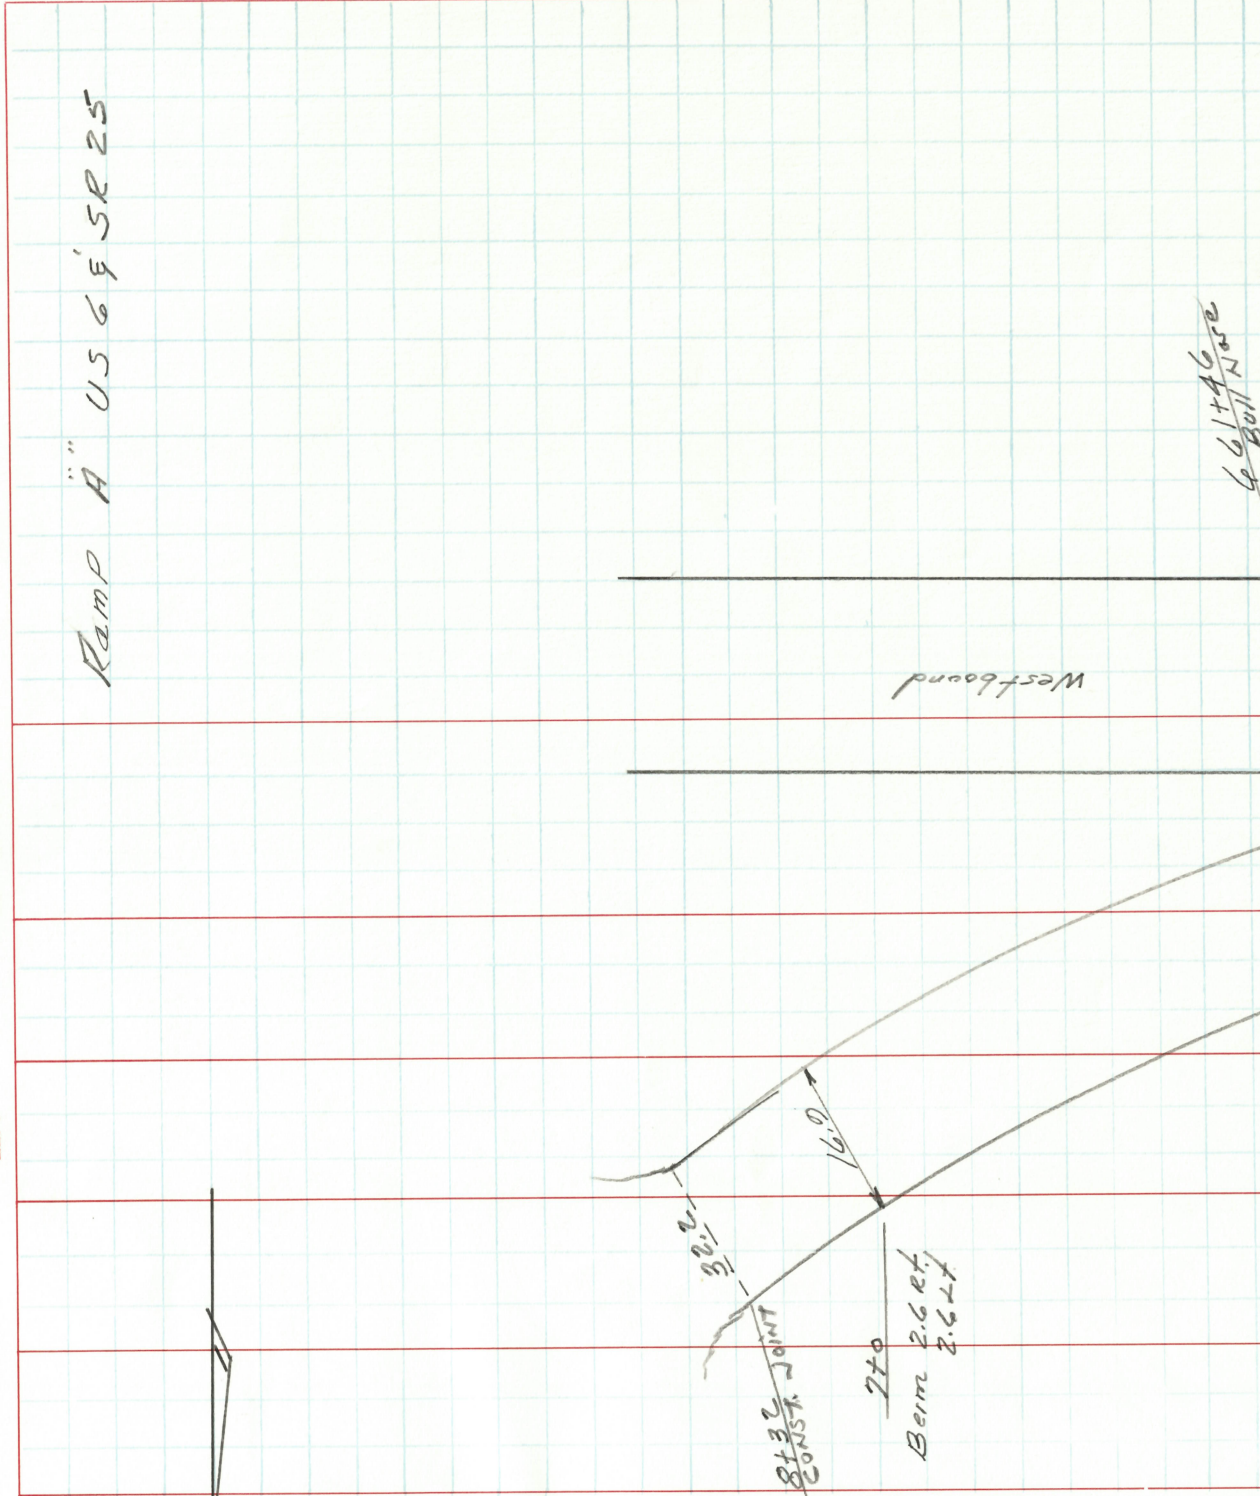

OHIO DEPARTMENT OF TRANSPORTATION

SHEET NO. 6 of 14


PERSONNEL	TITLE	PERSONNEL	TITLE	COUNTY	DATE	WEATHER
Van Dusen		Wood		Wood	6-27-91	Clear
Loehrke		S. R.		US 6		
Barnhisel		SEC.		11.8		
Kusz		TEMP.		90° F.		

DESCRIPTION Wood US 6 Four Lane Resurface Job No.

RIGHT

CENTER LINE

LEFT

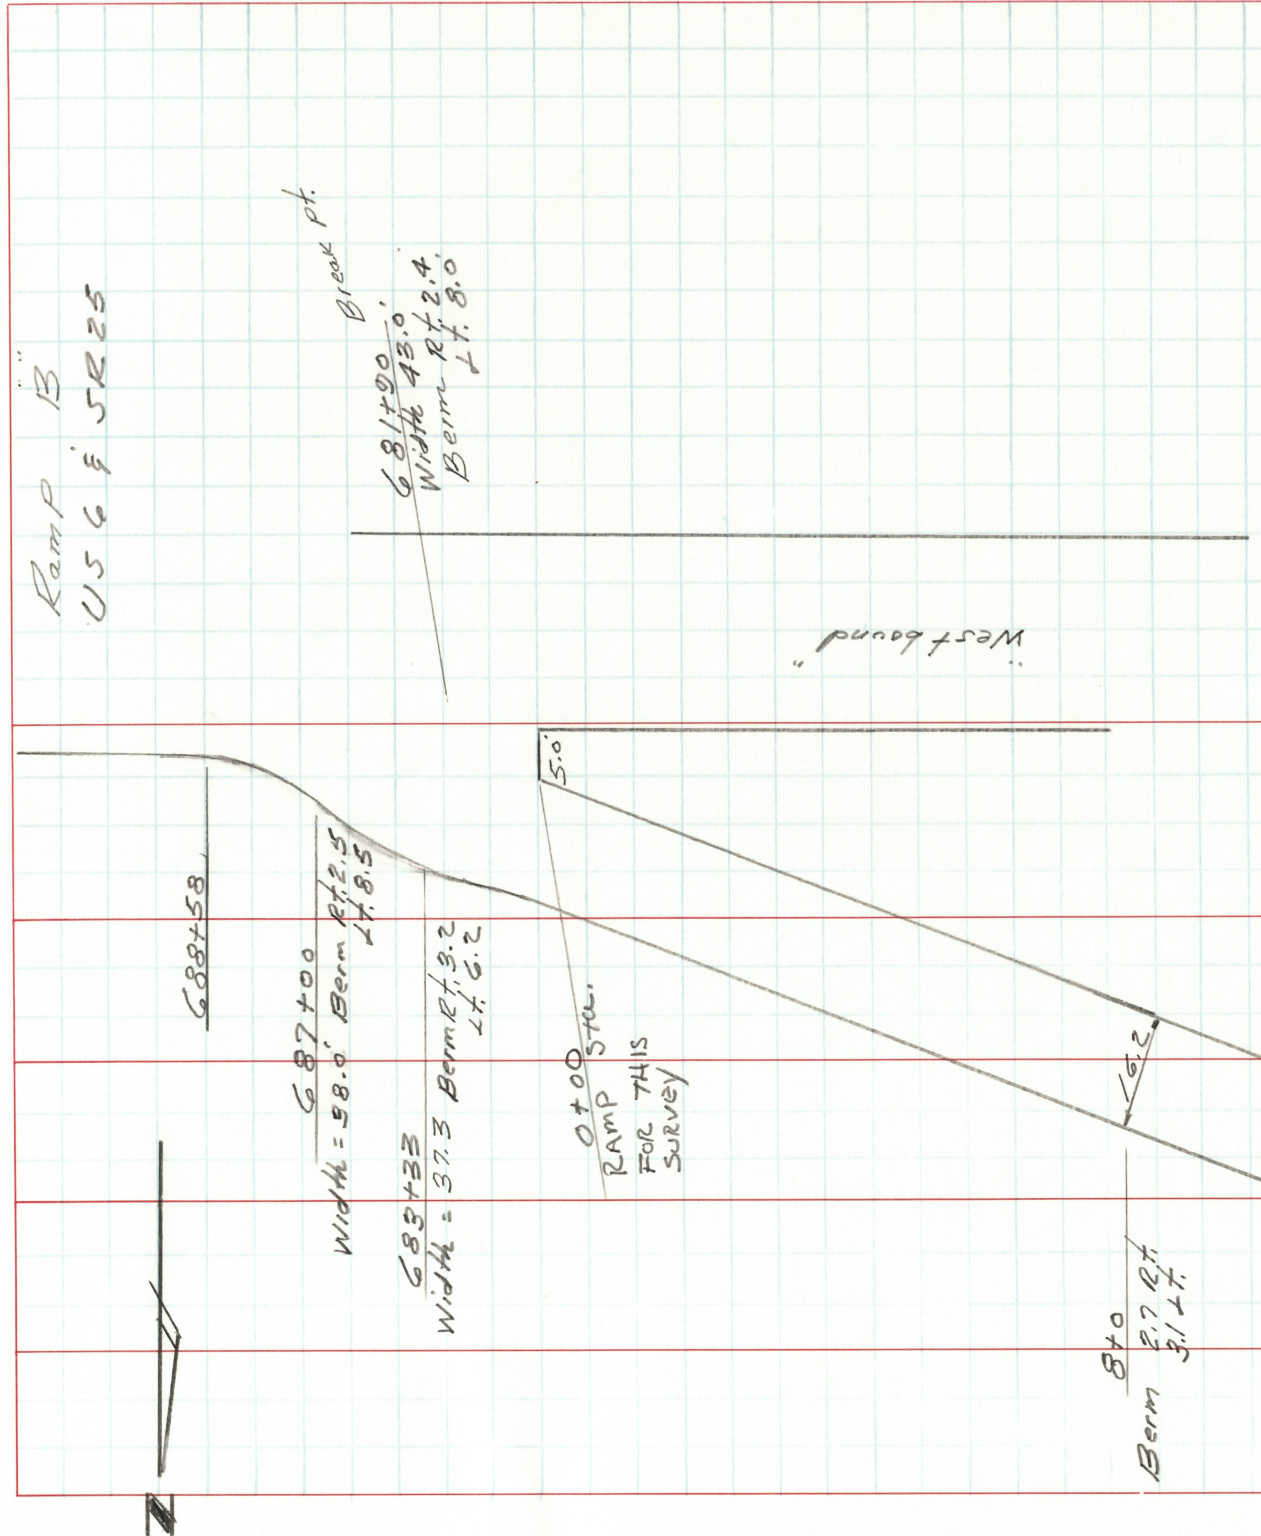


OHIO DEPARTMENT OF TRANSPORTATION

SHEET NO. 7 of 14

PERSONNEL	TITLE	PERSONNEL	TITLE	COUNTY	DATE	WEATHER
Van Duren				Wood	6-27-91	Clear
Loehrke				S. R.	US 6	
Barahisel				SEC.	11.8	
Kurz				TEMP.	90° F.	

DESCRIPTION Wood US-6 Four Lane Resurfaced JOB NO. _____
LEFT CENTER LINE RIGHT

RAMP C " US-6 & SR 25

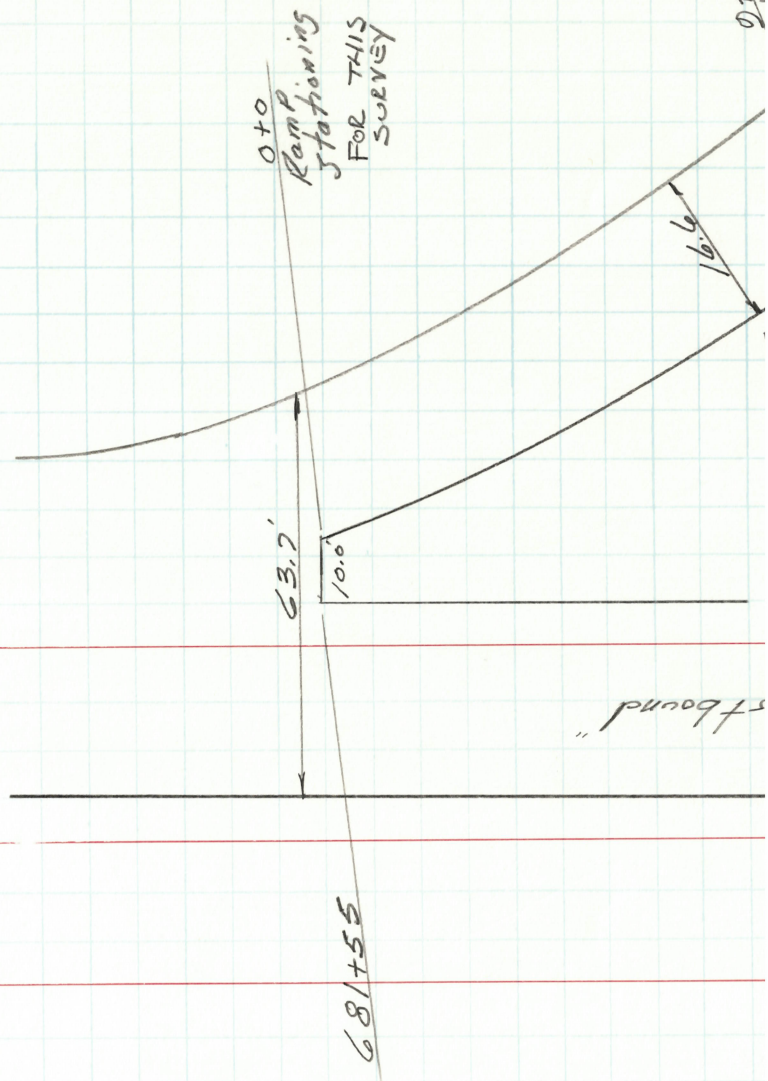623+20 Width 24.6
Berm = 9.0' R/L
End Taper 2.7 L/L

PERSONNEL	TITLE	PERSONNEL	TITLE	COUNTY	WOOD	DATE	6-26-91
Van Duren				S. R.	U.S. #6	WEATHER	C/ear
Loehcke				SEC.	11.8	TEMP.	85°F.
Barahivel							
Kusz							

DESCRIPTION WOOD US-6 FOUR LANE RESURFACE RIGHT JOB NO.

CENTER LINE

LEFT

Ramp D US 6 & SR 25

SR 25

29.5'

17.0'

9+20
Const. Joint

8+0

2.3 Rt.
2.6 Lt. Berm0+0 Sta
RAMP
FOR THIS SURVEYRt. Berm = 10.2
Lt. Berm = 2.6

25.5' 4.0' 19.2'


661+91

Rt. Berm = 5.3 Ramp
Lt. Berm = 2.2

655+33

Width = 37.6'
Rt. Berm = 8.5'


DESCRIPTION	LEFT	CENTER LINE	RIGHT	JOB NO.
WOOD US-C		FOUR LANE	RESURFACE	

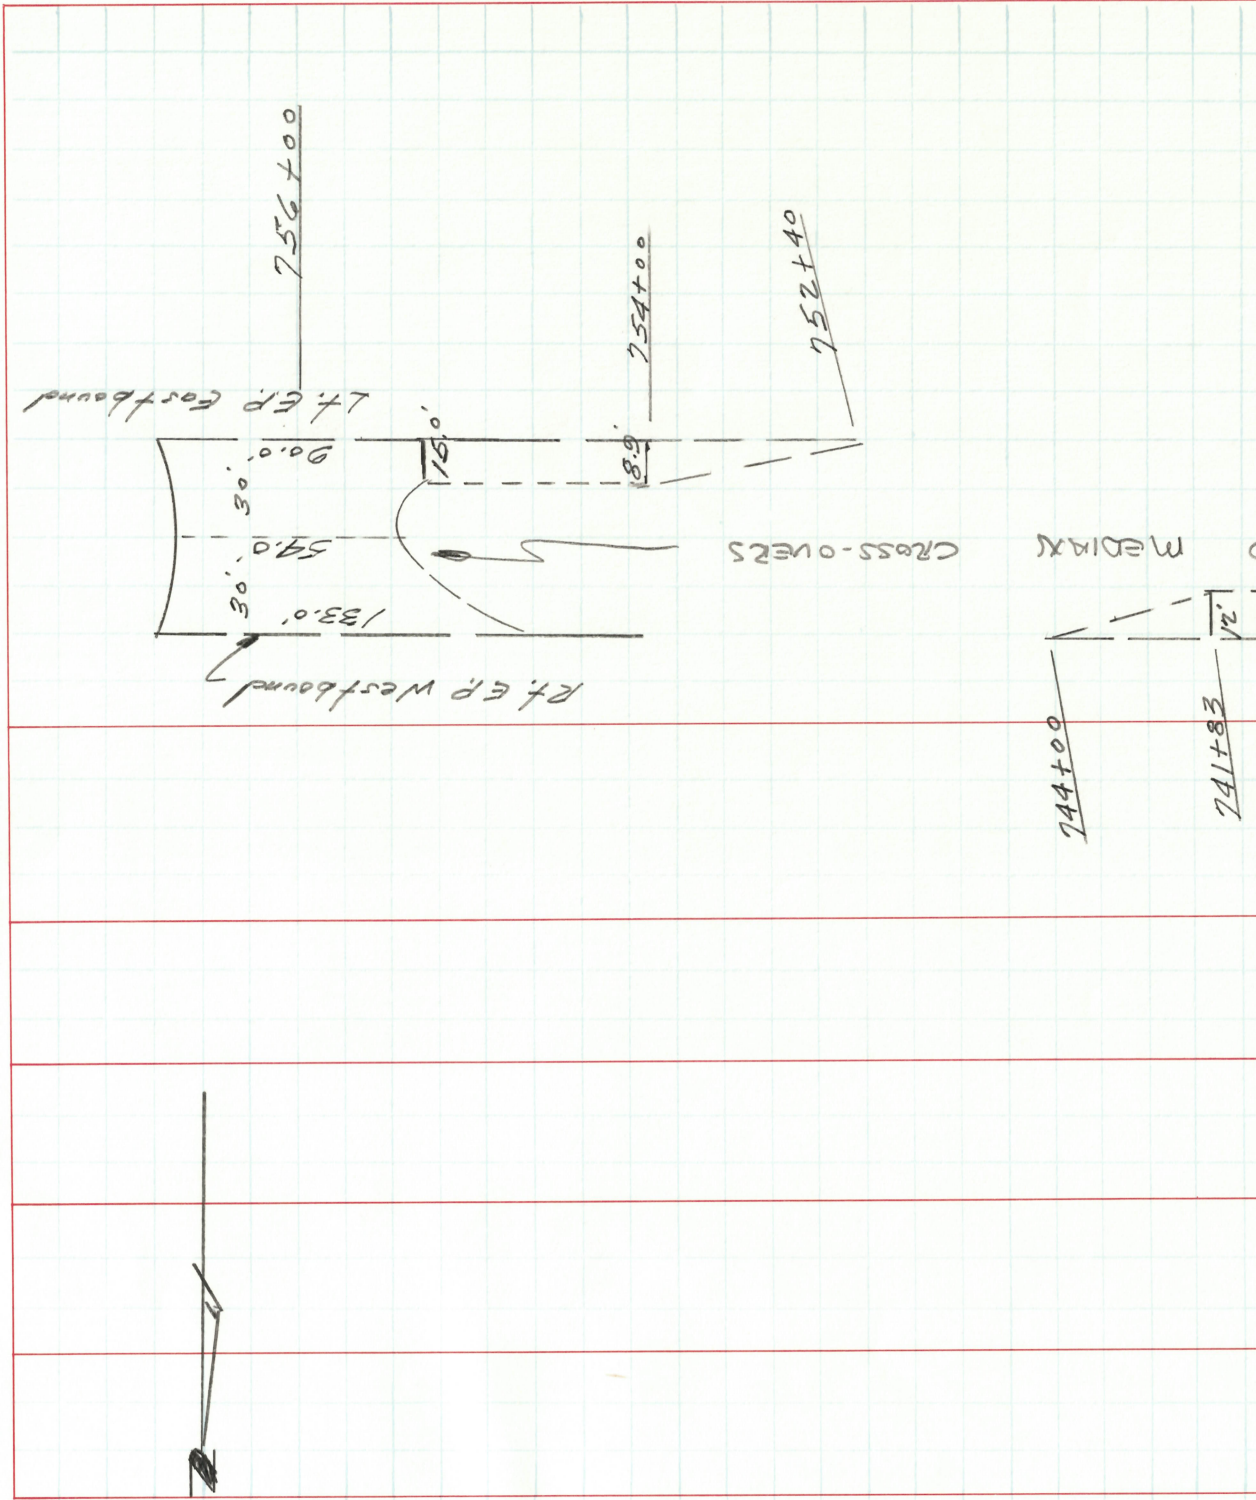


PERSONNEL	TITLE	PERSONNEL	TITLE	COUNTY	DATE	WEATHER	TEMP.
Van Dusen		Wood		Wood	6-26-91	Clear	85° F.
Loehrke				S. R.	U.S. #6		
Barnhisel				SEC.	11.8		
Kosz							

DESCRIPTION WOOD U.S. #6 FOUR LANE RESURFACE RIGHT

LEFT CENTER LINE

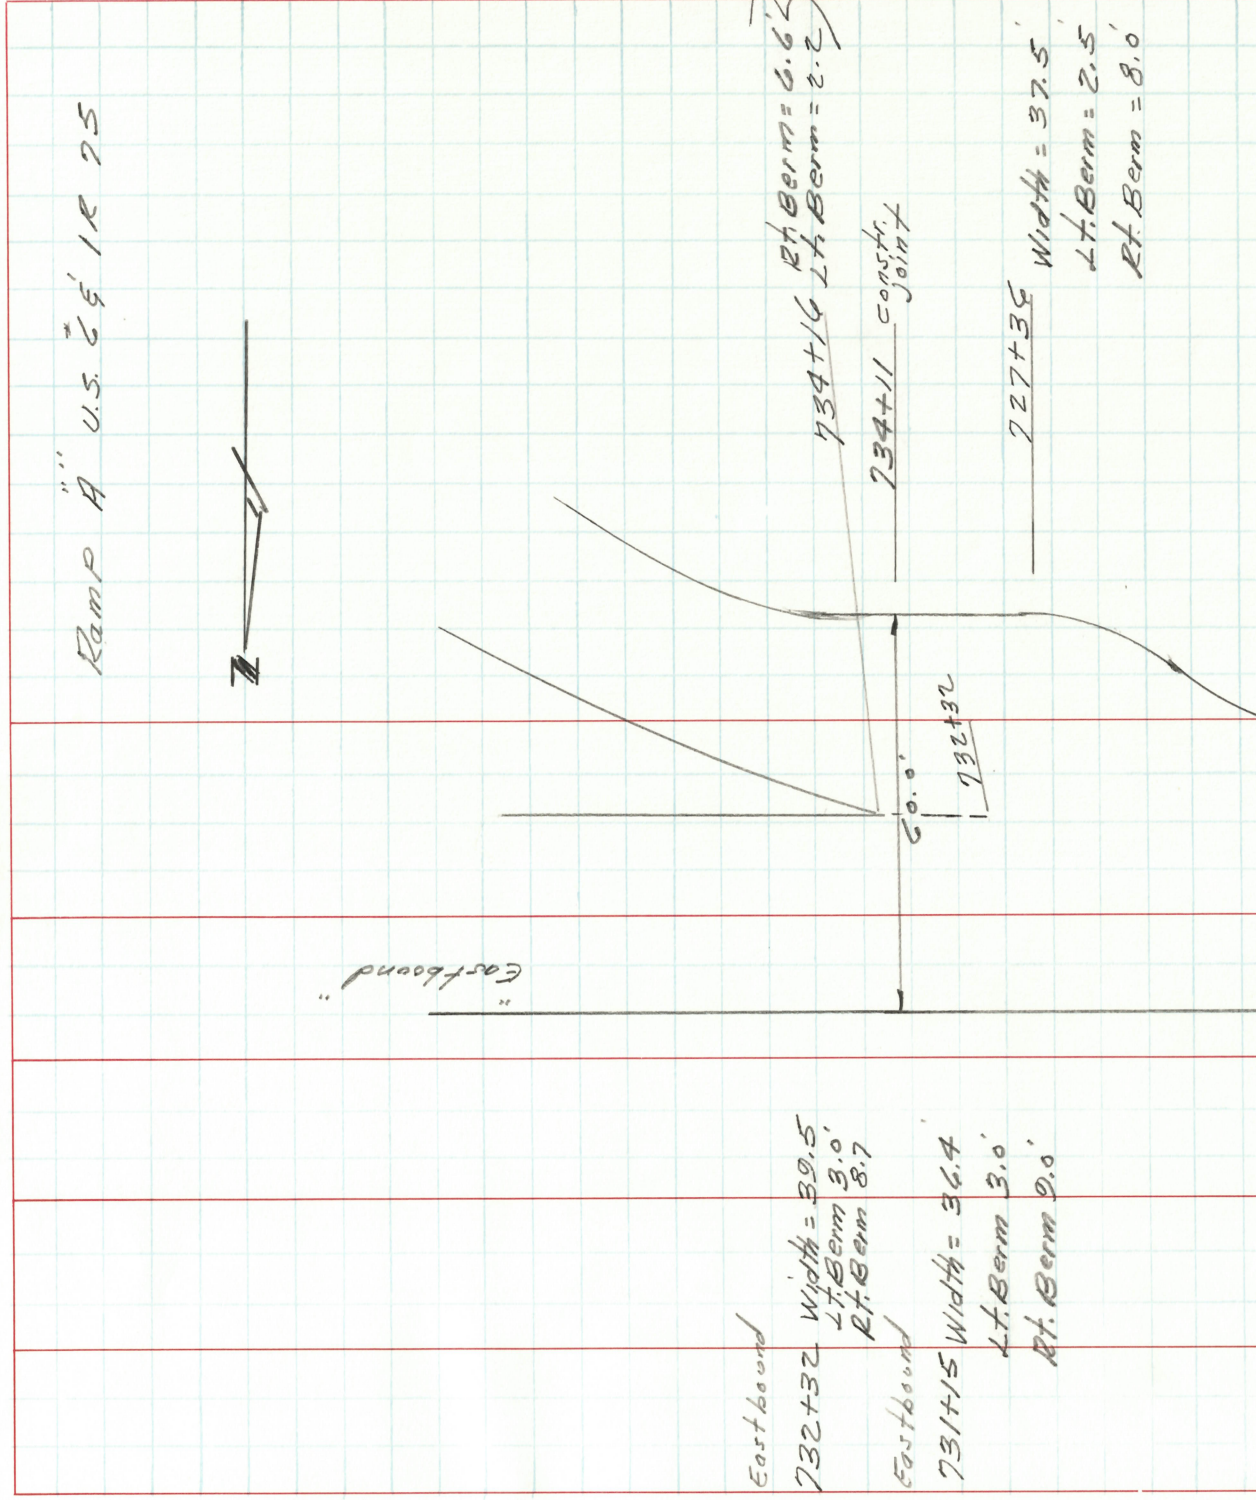


DESCRIPTION	U.S. G	FOUR LANE	RESURFACE	JOB NO.
	LEFT	CENTER LINE	RIGHT	

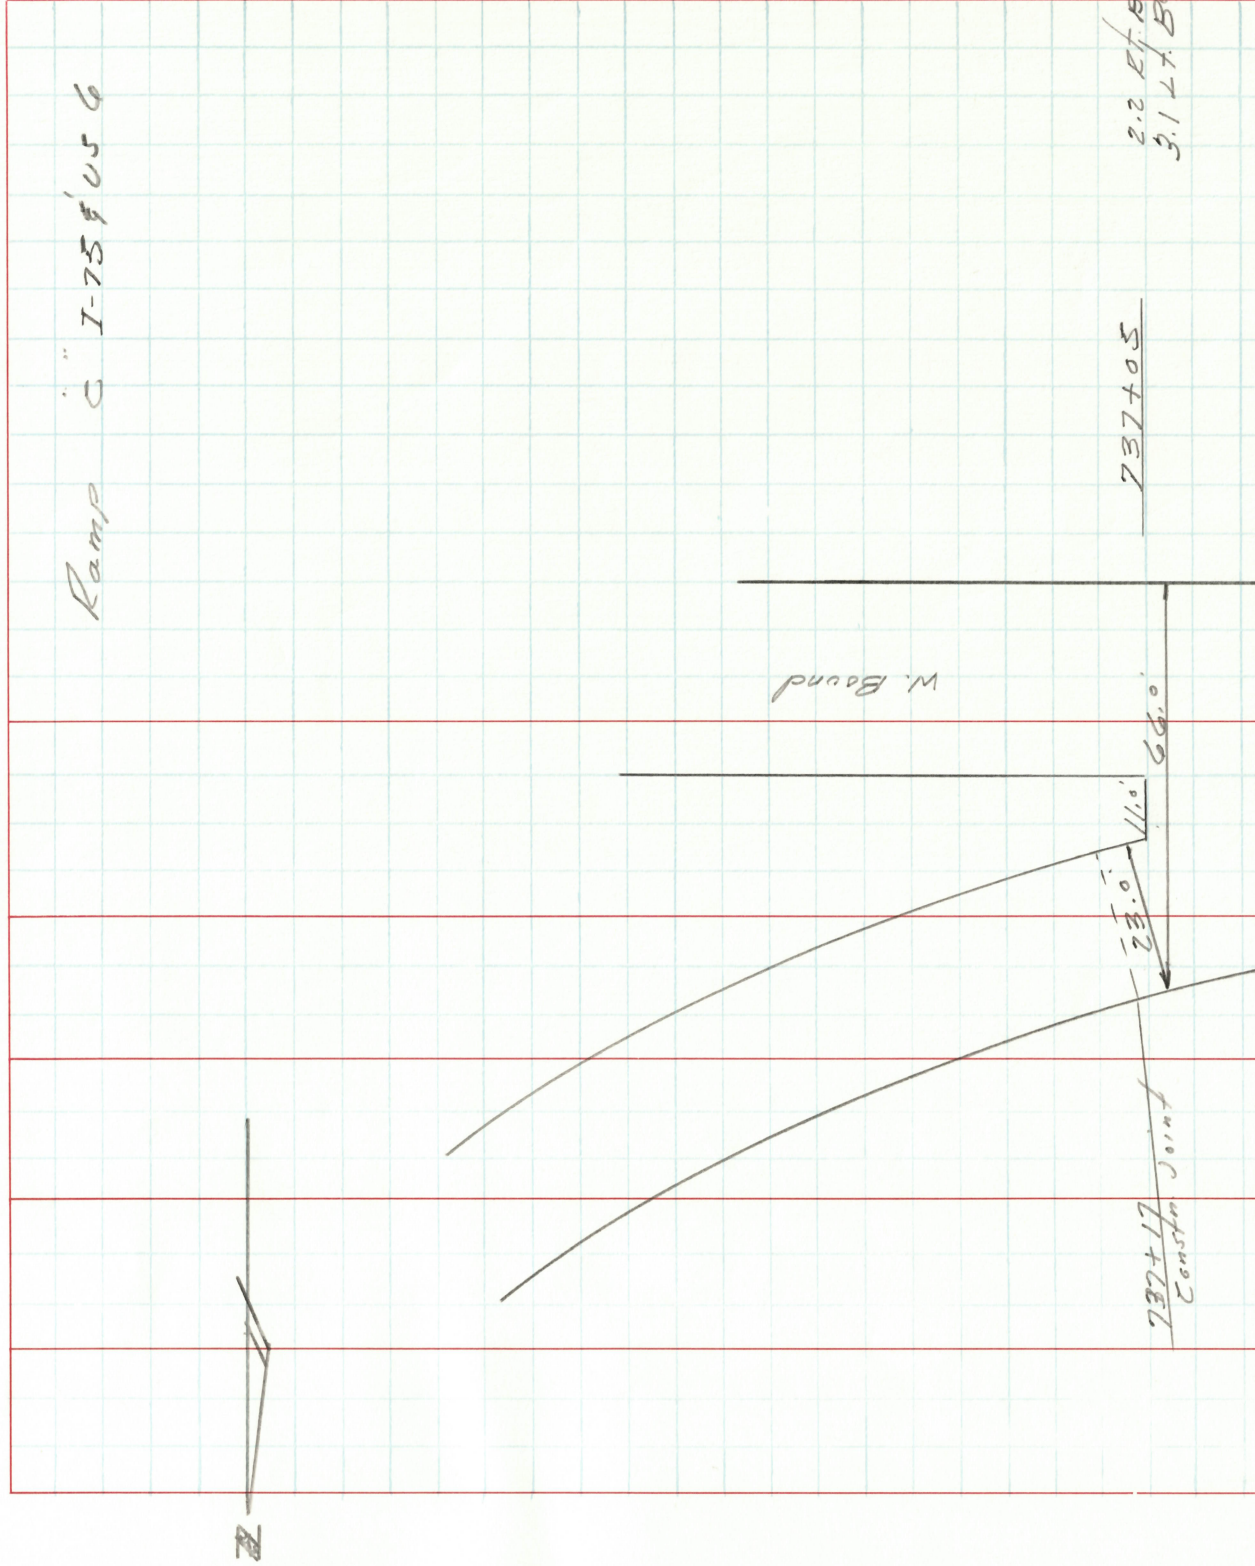

PERSONNEL	TITLE	PERSONNEL	TITLE	COUNTY	DATE	WEATHER	TEMP.
Van Duren				Wood	6-27-01	Clear	90°F
Loehke				S. R.			
Barnhisel				US 6			
Kusz				SEC.	11.8		

DESCRIPTION WOOD US-6 FOUR LANE RESURFACE JOB NO. _____


LEFT CENTER LINE RIGHT

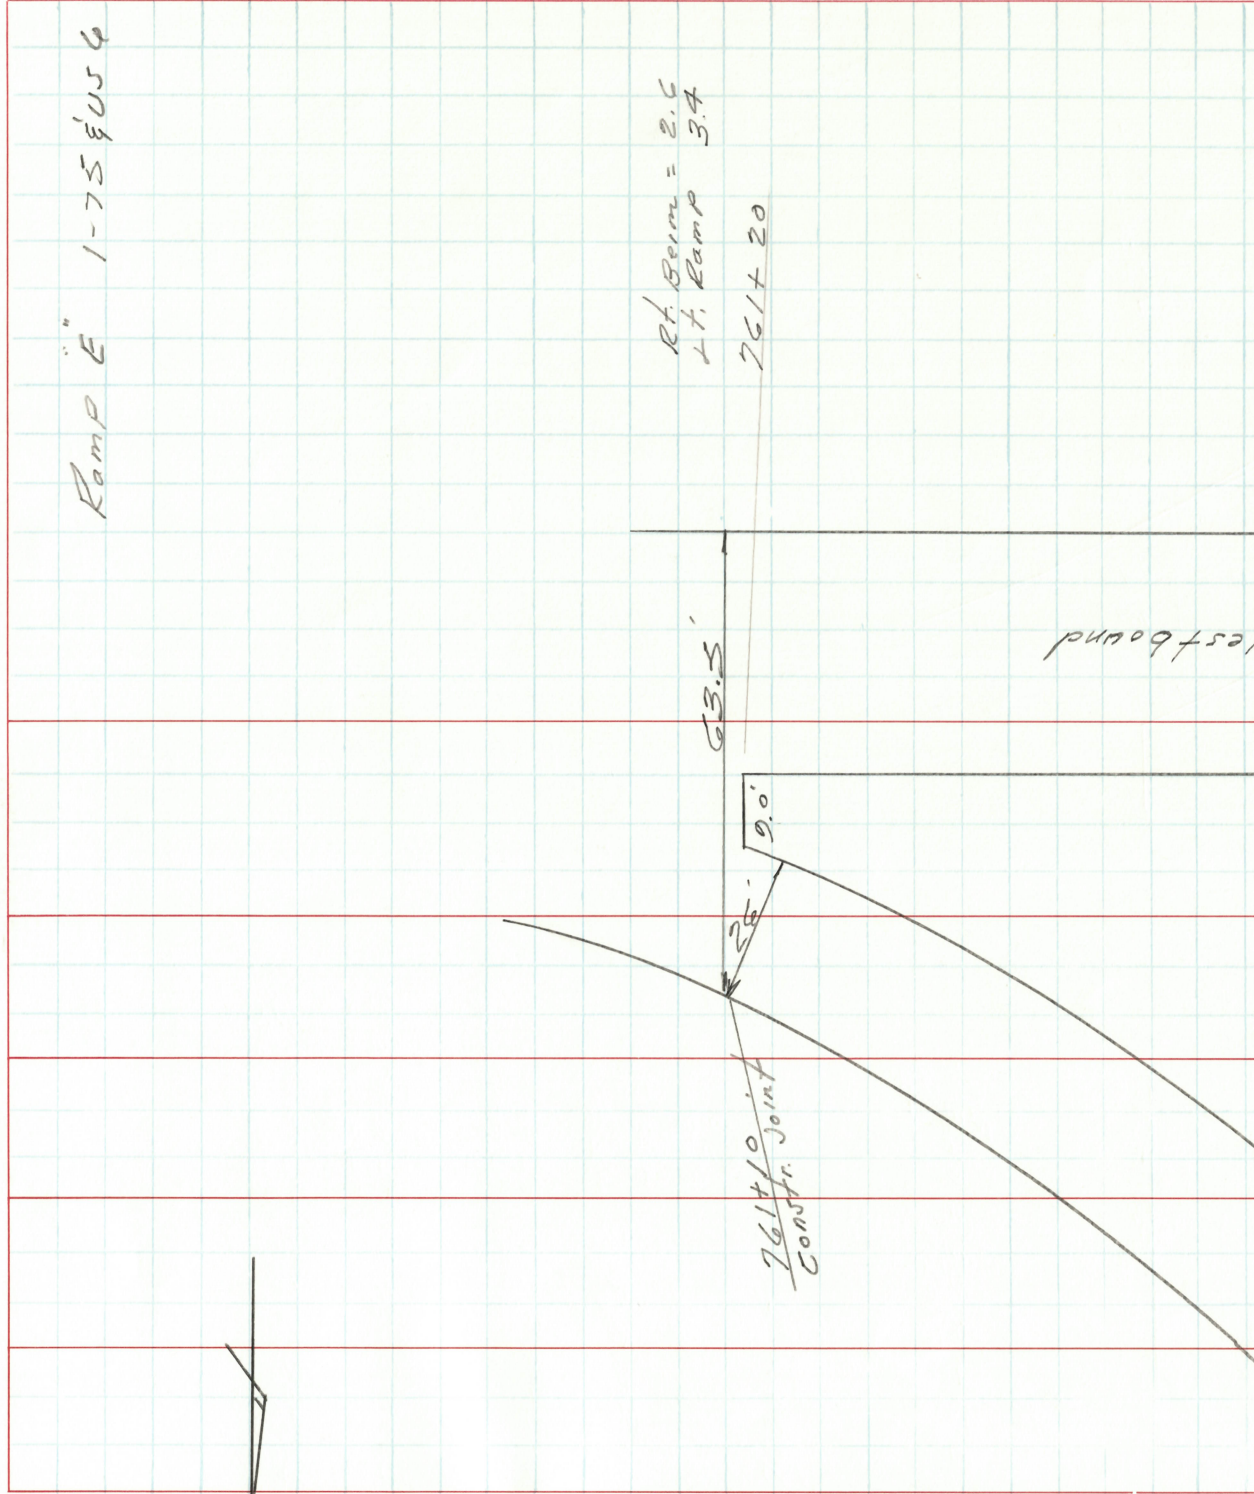

PERSONNEL TITLE PERSONNEL TITLE
 Van Duren
 Loehrke
 Barnhisel
 Kusz

COUNTY Wood DATE 6-26-91
 S. R. US 6 WEATHER Clear
 SEC. 11.8 TEMP. 90°F

DESCRIPTION Wood US 6 Four Lane Resurfaced JOB NO. _____
 LEFT CENTER LINE RIGHT

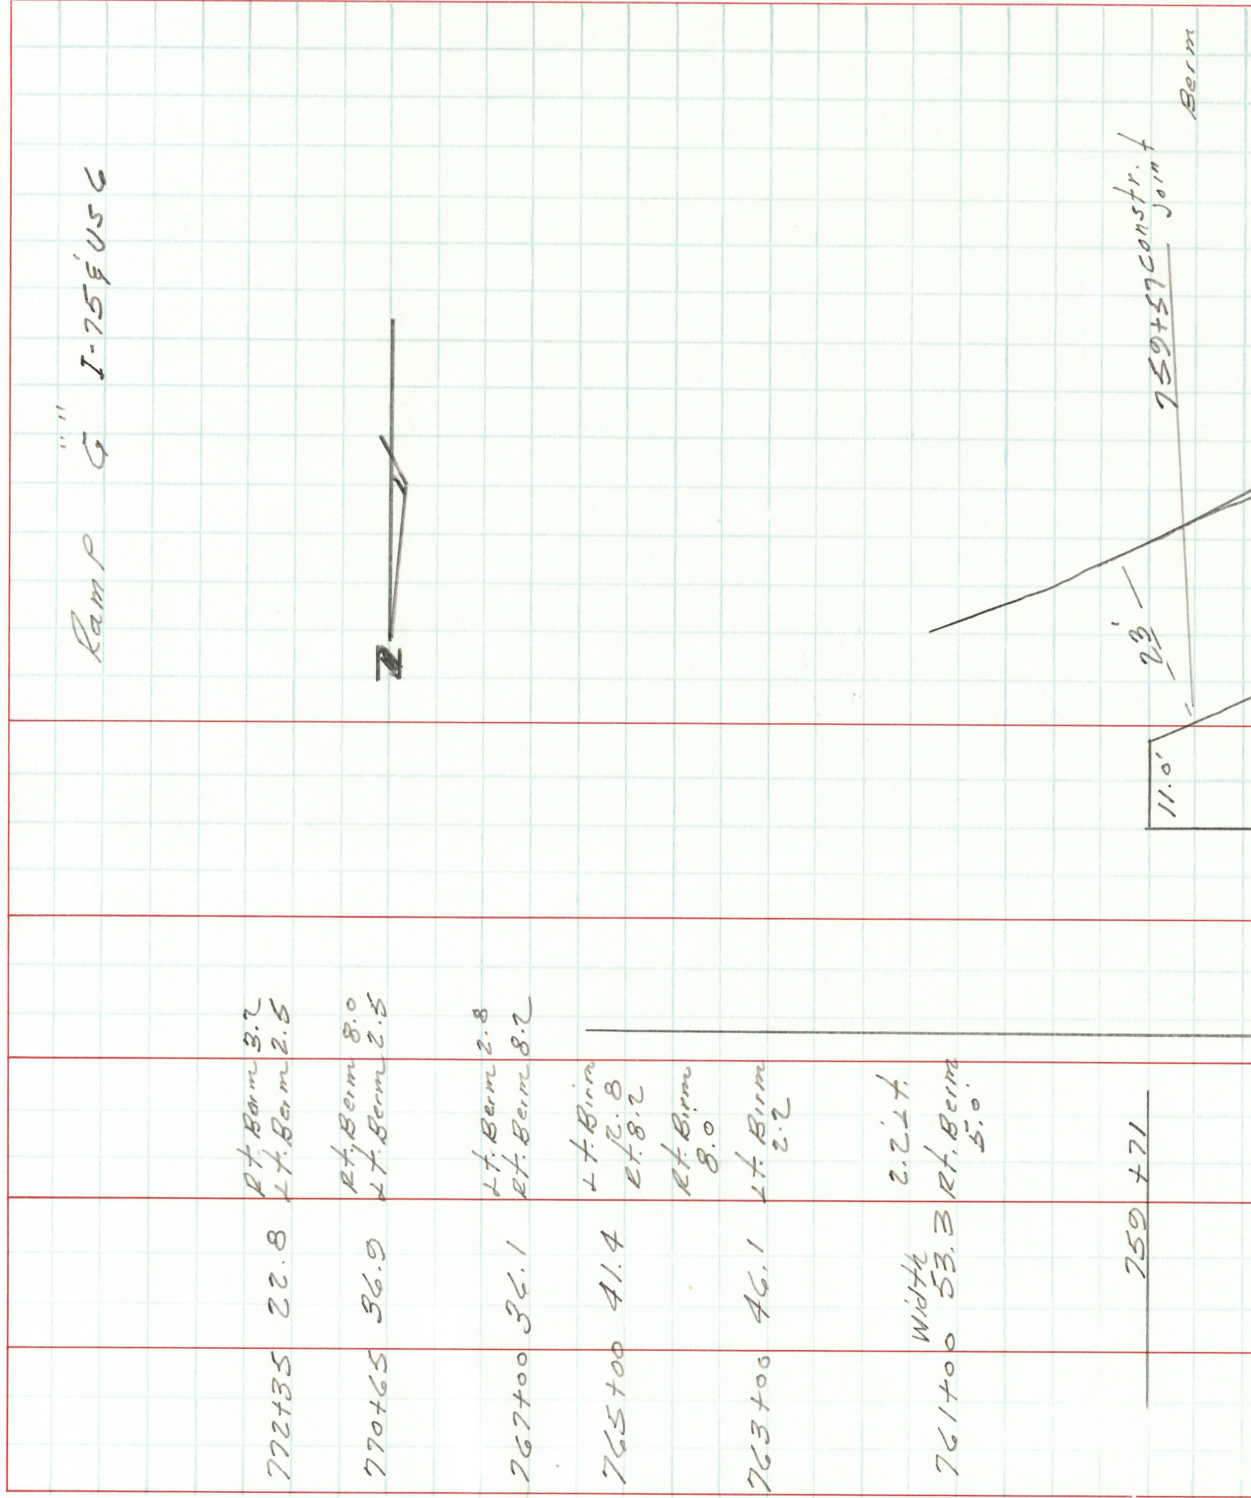

PERSONNEL	TITLE	PERSONNEL	TITLE	COUNTY	DATE	WEATHER	TEMP.
Van Dusen				Wood	6-27-91	Clear	90° F.
Loehrke				S. R.	US 6		
Barnhiser				SEC.	11.8		
Kusz							

DESCRIPTION Wood US #6 FOUR LANE RESURFACING JOB NO. _____

LEFT CENTER LINE RIGHT

