


OHIO DEPARTMENT OF TRANSPORTATION

SHEET NO.

LD-5 Rev. 2-83

PERSONNEL TITLE PERSONNEL TITLE COUNTY Wood DATE 6-26-91
Van Dusen Loehrke S. R. 6 WEATHER
Banthiesel SEC. 11.8 TEMP. 20° F
Kuss

DESCRIPTION W. Bound Exit Ramp to 25 CENTER LINE RIGHT JOB NO.

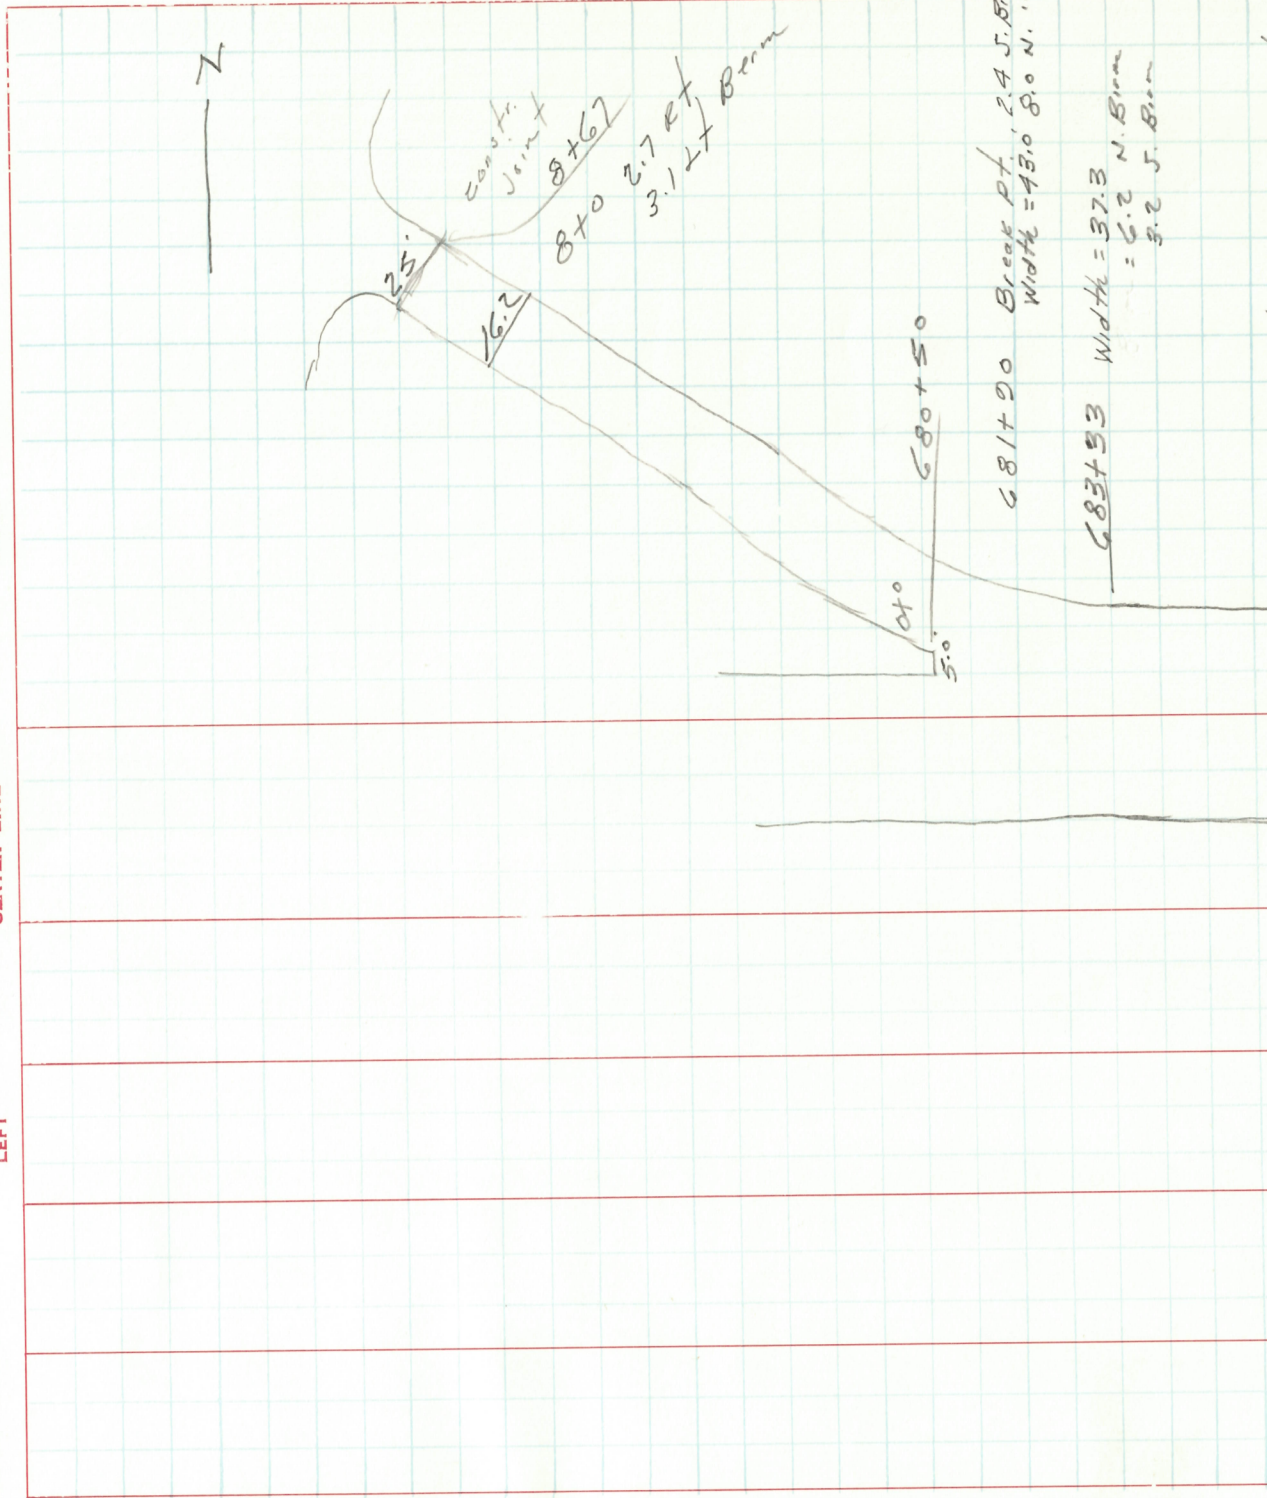

OHIO DEPARTMENT OF TRANSPORTATION

SHEET NO. _____


LD-5 Rev. 2-83

PERSONNEL	TITLE	PERSONNEL	TITLE	COUNTY	DATE
_____	_____	_____	_____	_____	_____
_____	_____	_____	_____	_____	_____
_____	_____	_____	_____	_____	_____
_____	_____	_____	_____	_____	_____

WEATHER _____

TEMP. _____

JOB NO. _____

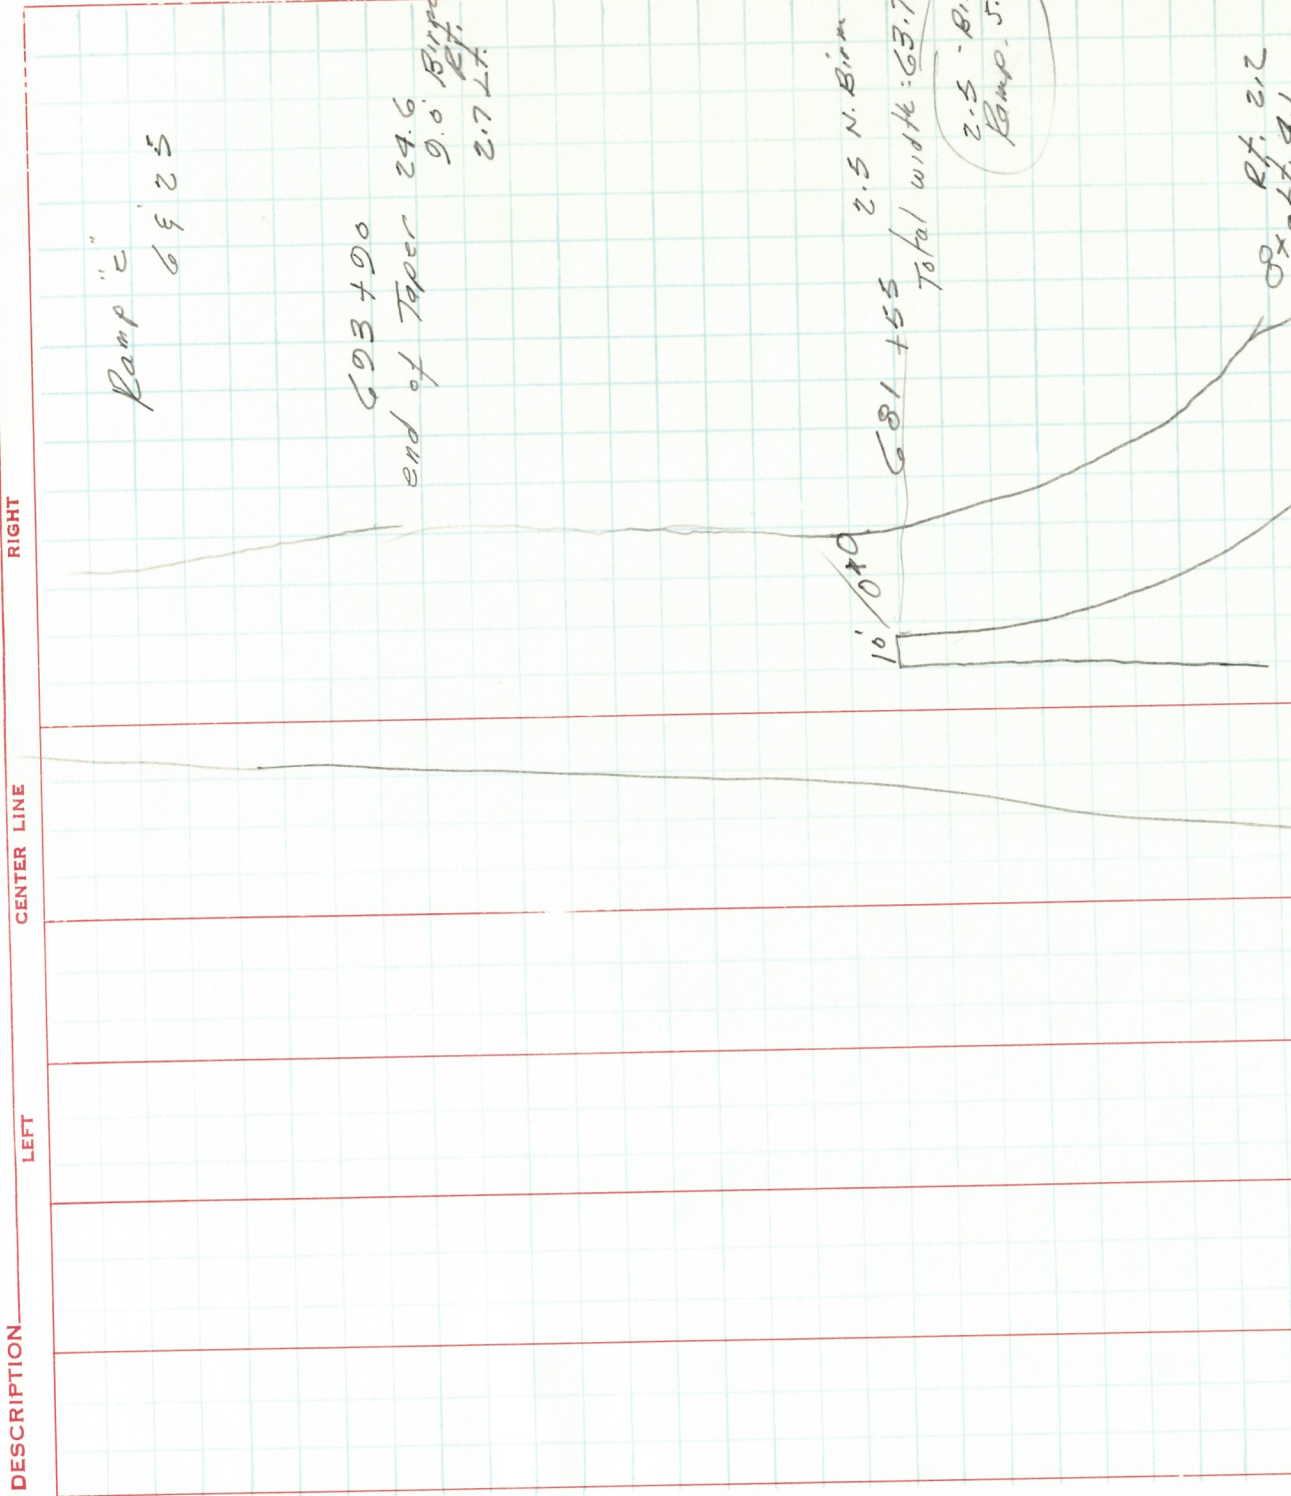

INTERCHANGE IR 75 & US 6 WOOD COUNTY

INTERCHANGE US 6 & SR 25 WOOD COUNTY

