


SHEET NO. 1
DATE 3-9-81
COUNTY Wood
WEATHER cloudy
TEMP. 35°


PERSONNEL TITLE PERSONNEL TITLE
Schneider
Mosser
Barbour

DESCRIPTION Maint. Program CENTER LINE (Guardrail runs) RIGHT
JOB NO. _____

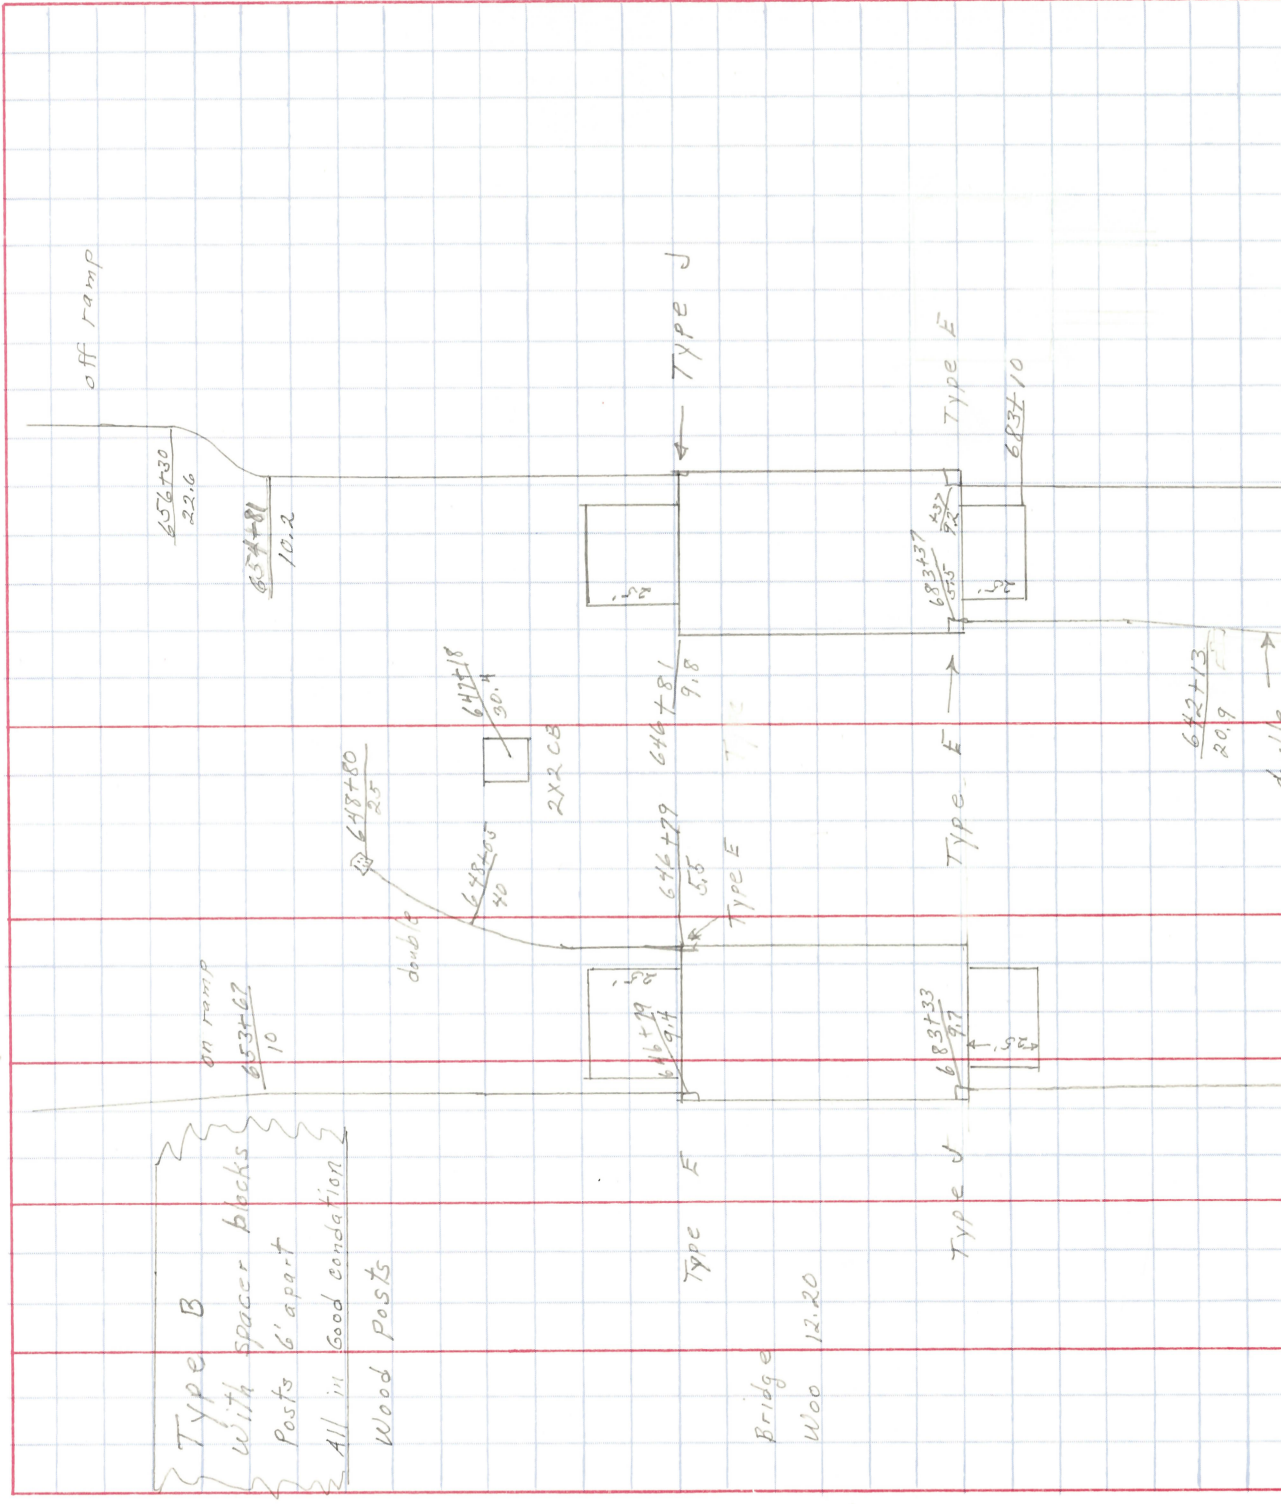

PERSONNEL TITLE PERSONNEL TITLE COUNTY Wood DATE 3-9-81
 S. R. 6 WEATHER Cloudy
 SEC. 11.99 TEMP. 35°

DESCRIPTION Maint. Program (Guardrail runs) JOB NO. _____
 LEFT CENTER LINE RIGHT

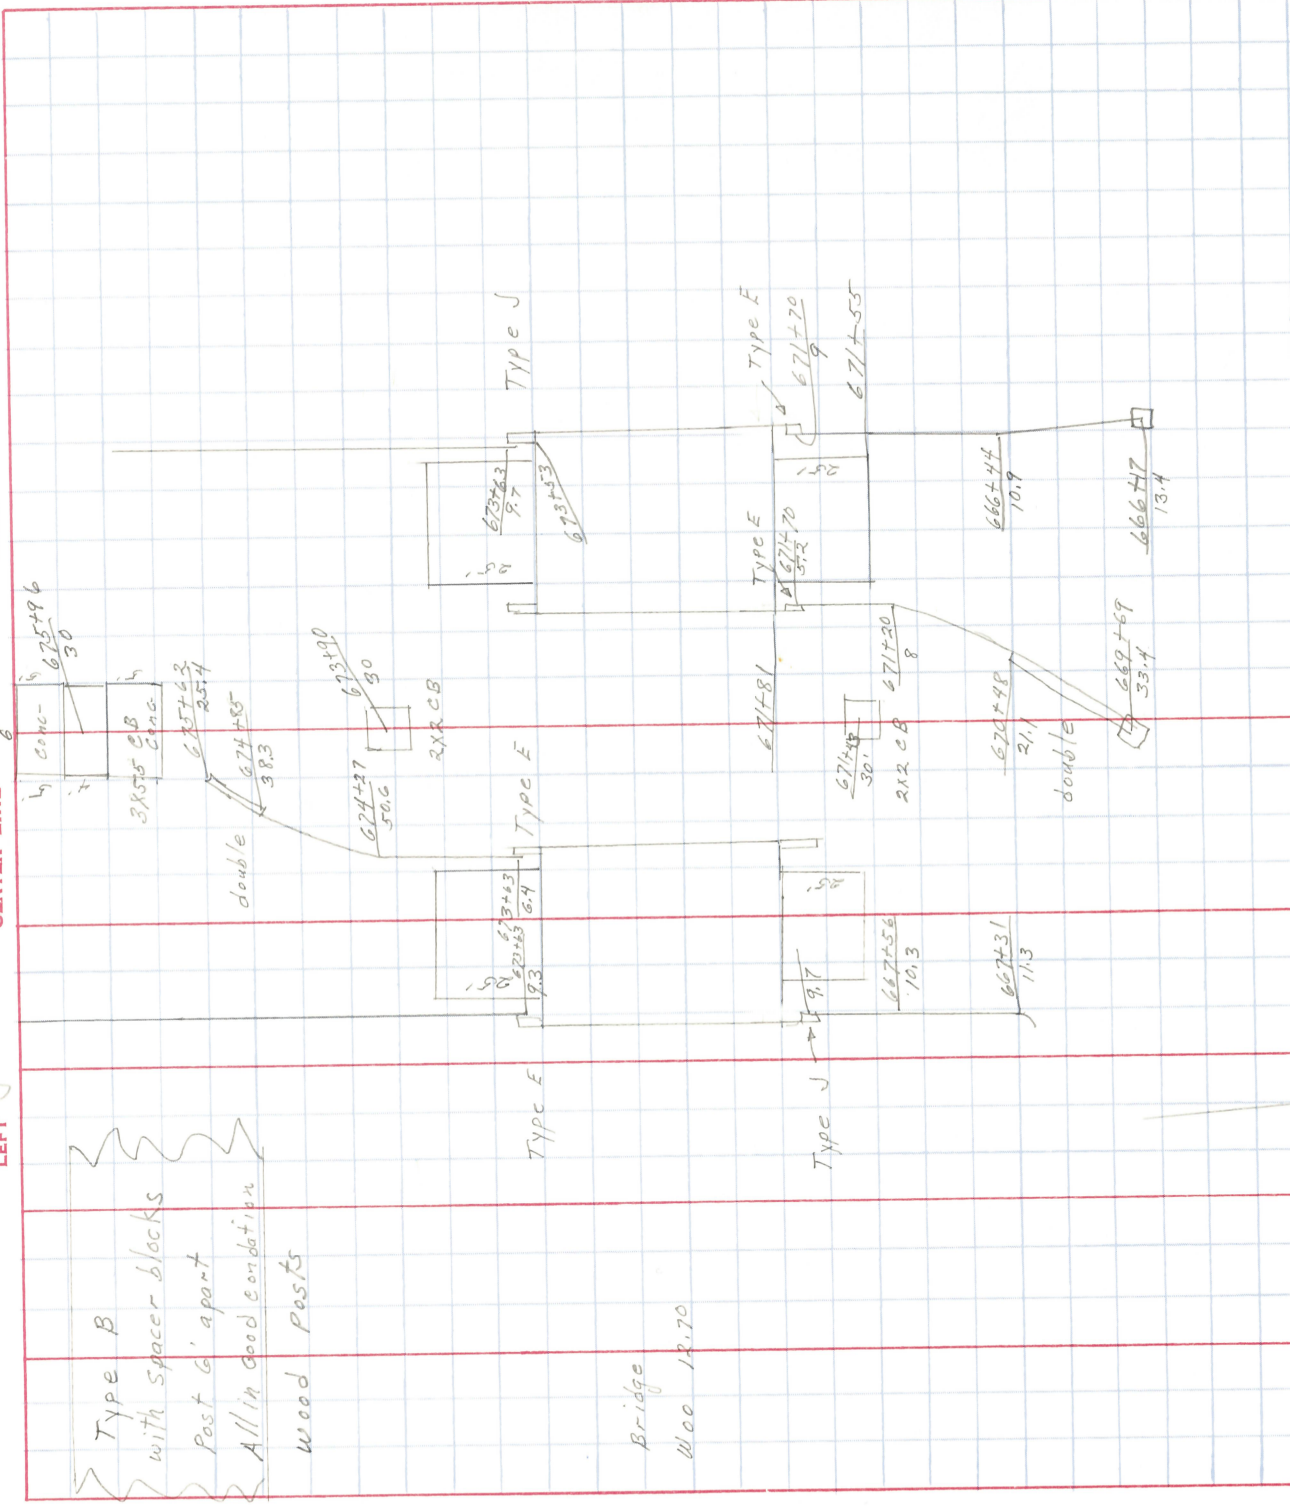


Type B
 with spacer blocks
 Post 6' apart
 All in good condition
 Wood Posts

Bridge
 Wood 12.70

PERSONNEL TITLE PERSONNEL TITLE COUNTY Wood DATE 3-9-81
 PERSONNEL TITLE PERSONNEL TITLE S. R. 6 WEATHER Fair
 Schneider Mosser
 Barbour

DESCRIPTION Maint. Program Guardrail runs JOB NO.
 LEFT CENTER LINE RIGHT

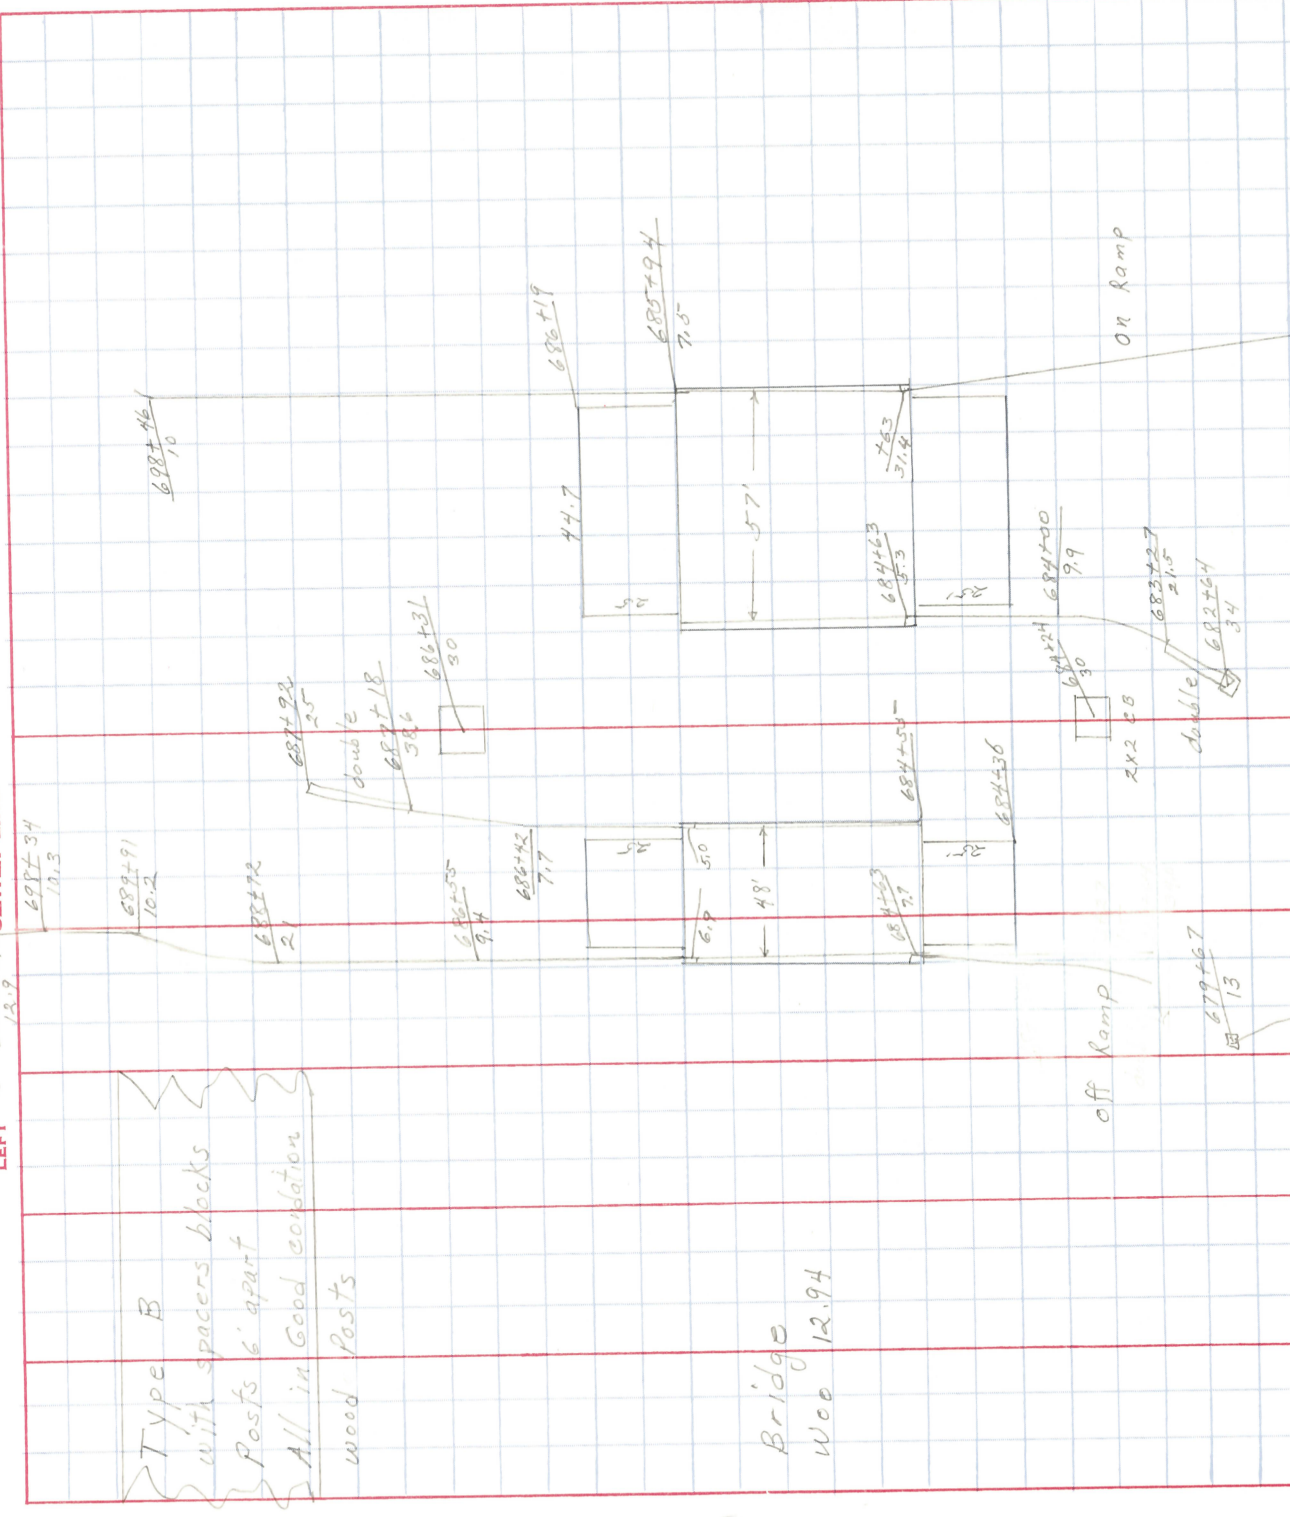


SHEET NO. 4

PERSONNEL TITLE PERSONNEL TITLE COUNTY Wood DATE 3-9-81

Schneider Mosser S. R. 6 WEATHER Fair

Barbour SEC. 11.99 TEMP. 40°

DESCRIPTION Maint. Program (Guardrail Funs) JOB NO. _____

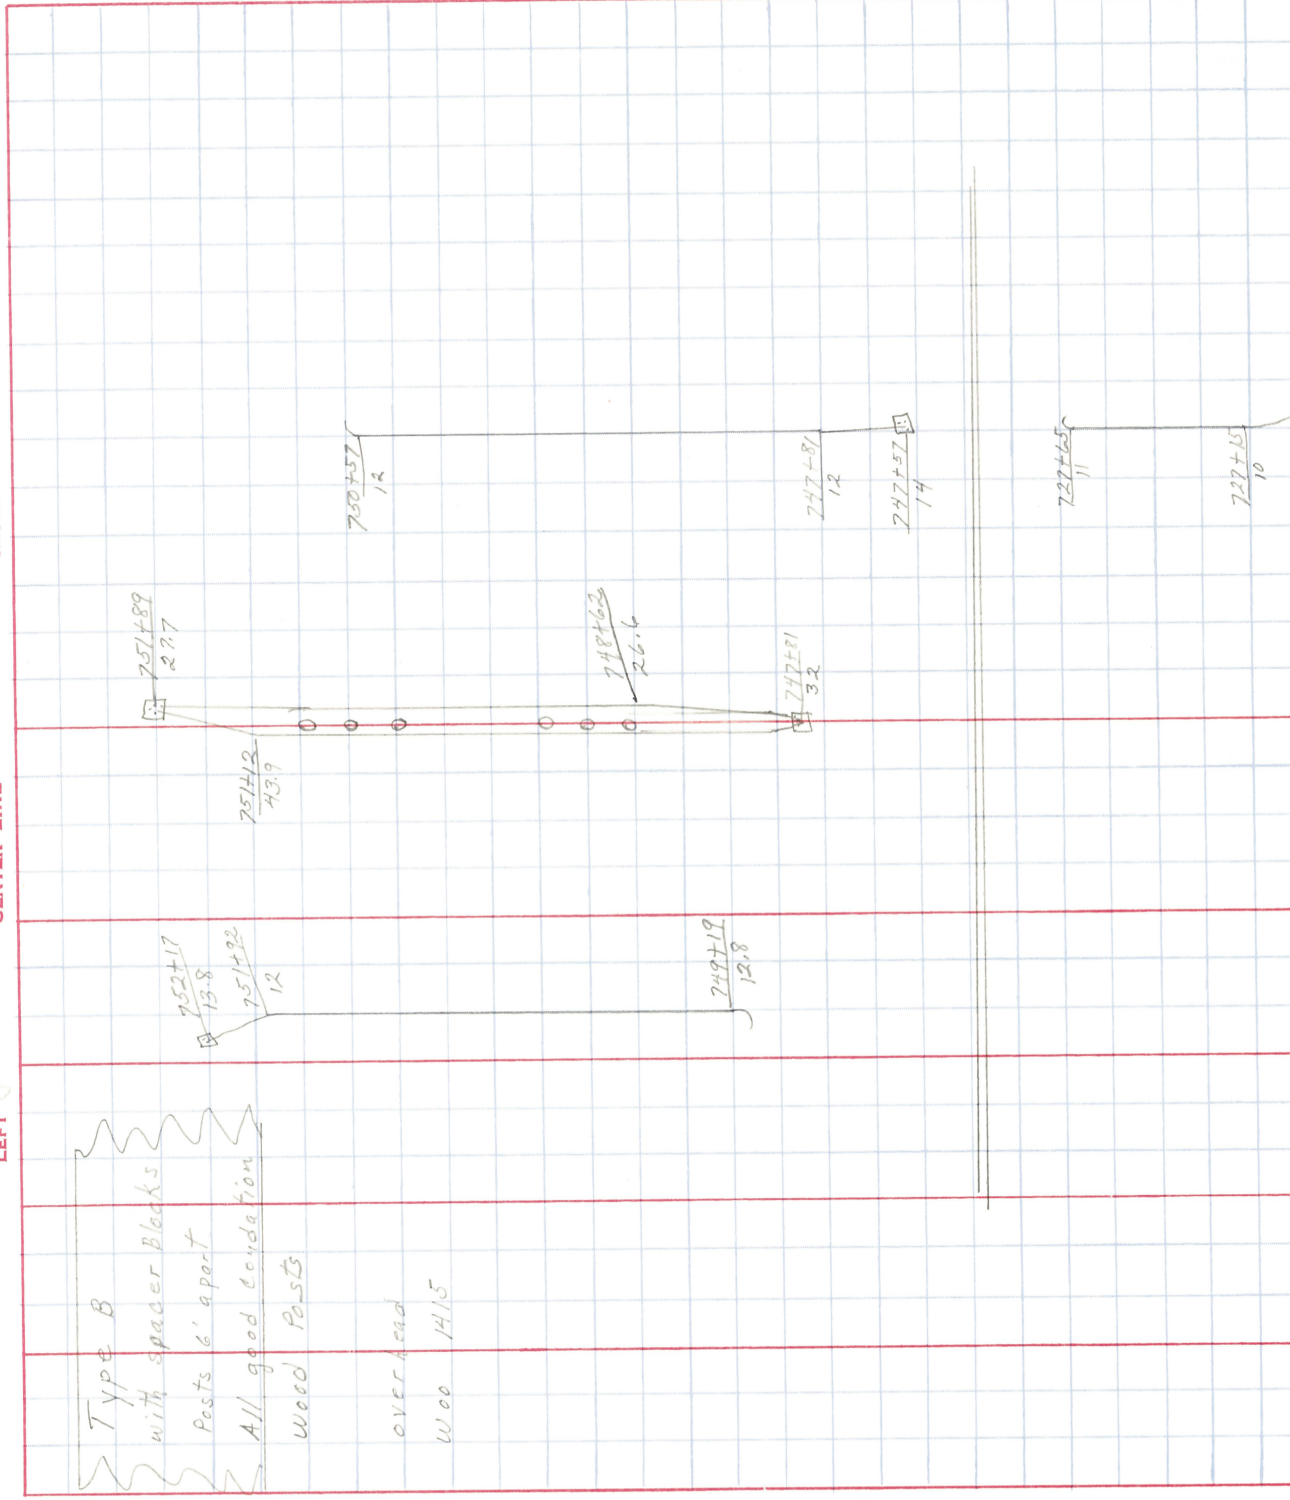

PERSONNEL TITLE PERSONNEL TITLE PERSONNEL TITLE
 Schneider Mosser Barbour
 COUNTY Wood DATE 3-9-81 WEATHER Fair
 S. R. 6 TEMP. 45°
 SEC. 11.99

DESCRIPTION Maint. Program (Guardrail runs) CENTER LINE RIGHT JOB NO.
 LEFT

