

ODOT (D-2)

Notes
J. P. Luss
11-6-96

1997 TWO-LANE RESURFACING PROGRAM

Also file
See file
Wood 186

DATE 11-04-96

PERSONNEL Van Dusen

Mosen

Huggs

PRIORITY NO. 20 PART 2 OF 2 SHEET 1 OF 9
COUNTY WOOD ROUTE US 60 SECTION 17.53
BEGIN LOG (SLM) 17.53 TERMINI CONST. JOINT - EAST OF B.G. ROAD EAST
END LOG (SLM) 21.05 TERMINI SR 199 (SOUTH)
TOTAL LENGTH 3.52 MILES

MUNICIPALITY BEGIN LOG (SLM) END LOG (SLM)
MUNICIPALITY BEGIN LOG (SLM) END LOG (SLM)

PROPOSED WORK: Resurface existing pavement
PAVEMENT 1 1/2" 404 SHOULDER Same - 617
OTHER locate bed pavement & shoulder areas (minor) (9"-301)
STATION ESTABLISHED FROM: 924+00 FROM PREVIOUS PROJECT
524+28+194

792.20
11.56
780.64

Has been resurfaced

STRUCTURES:	NUMBER	STATION	WIDTH	LENGTH	PROPOSED WORK
	WOOD - 32+780.64 App. Slab				
	6-2037 32+792.2 exp joint	10.88	76.5	32+856.8 Joint	1 1/2" of 404
				32+848.7 SLABS	
	WOOD - 33+266.20 App Slab				
	6-2068 33+276.55 exp. joints	10.88	40.45	33+328.08 SLAB	
				33+317.60 exp joint	

RAILROAD CROSSING:

(NO WORK)

NAME None STATION NO. TRACKS LENGTH ALONG C L FT

DATE 11-04-96

TWO-LANE RESURFACING PROGRAM
PAVEMENT DATA

SHEET 2 OF 9

NOTE: LOCATE ALL
CHANGES IN PVMT WIDTH

COUNTY Wood

ROUTE RT-6 SECTION 17.53

MILE MARKER	STATION	LEFT BERM WIDTH (TYPE)	PAVEMENT WIDTH OUT/OUT WHITE LINES	RIGHT BERM WIDTH (TYPE)
	28+173.5 ^M	1.35 ^M	7.20 ^M	0.93 ^M
	28+200 ^M	0.72 ^M	7.40 ^M	0.90 ^M
18	29+000.6 ^M	0.70 ^M	7.16 ^M	0.86 ^M
	29+700 ^M	0.65 ^M	7.33 ^M	0.78 ^M
19	30+669.25 ^M	0.51 ^M	7.18 ^M	0.95 ^M
	31+300	0.73 ^M	7.26 ^M	0.80 ^M
20	32+210.44	0.61 ^M	7.29 ^M	0.70 ^M
	32+500	0.68 ^M	8.00 ^M	0.50 ^M
	32+900	0.84 ^M	7.75 ^M	0.68 ^M
	33+400	0.23 ^M	7.68 ^M	0.88 ^M
21	33+791.3	0.83 ^M	8.21 ^M	0.70 ^M
	33+900	0.91 ^M	7.85 ^M	0.95 ^M

* = STATION LOCATION

STATION	LANE LT/RT	OTHERS (SKETCH)	* ↑	* R/R	*SCHOOL	*ONLY	* ↑	* ↘

COUNTY

ROUTE

9

SECTION

17.53

[illegible]

COUNTY Wood ROUTE 6 SECTION 17.53

R = RAISE F = FEATHER

[illegible]

COUNTY Wood ROUTE 6 SECTION 17.53

TWO-LANE RESURFACING PROGRAM
CROSSWALKS AND STOP BARS


COUNTY Wood ROUTE 6 SECTION 17.53

[illegible]

PERSONNEL TITLE PERSONNEL TITLE
 VAN DUSEN
 MOSEY
 HUSS

COUNTY WOOD DATE 11-4-26
 S.R. U.S. 6 WEATHER CLEAR
 SEC. 17.53 = 28.21 JCK. TEMP. +4°C

DESCRIPTION INTERSECTION - U.S. 6 & S.R. 199 NORTH JOB NO.
 LEFT CENTER LINE RIGHT

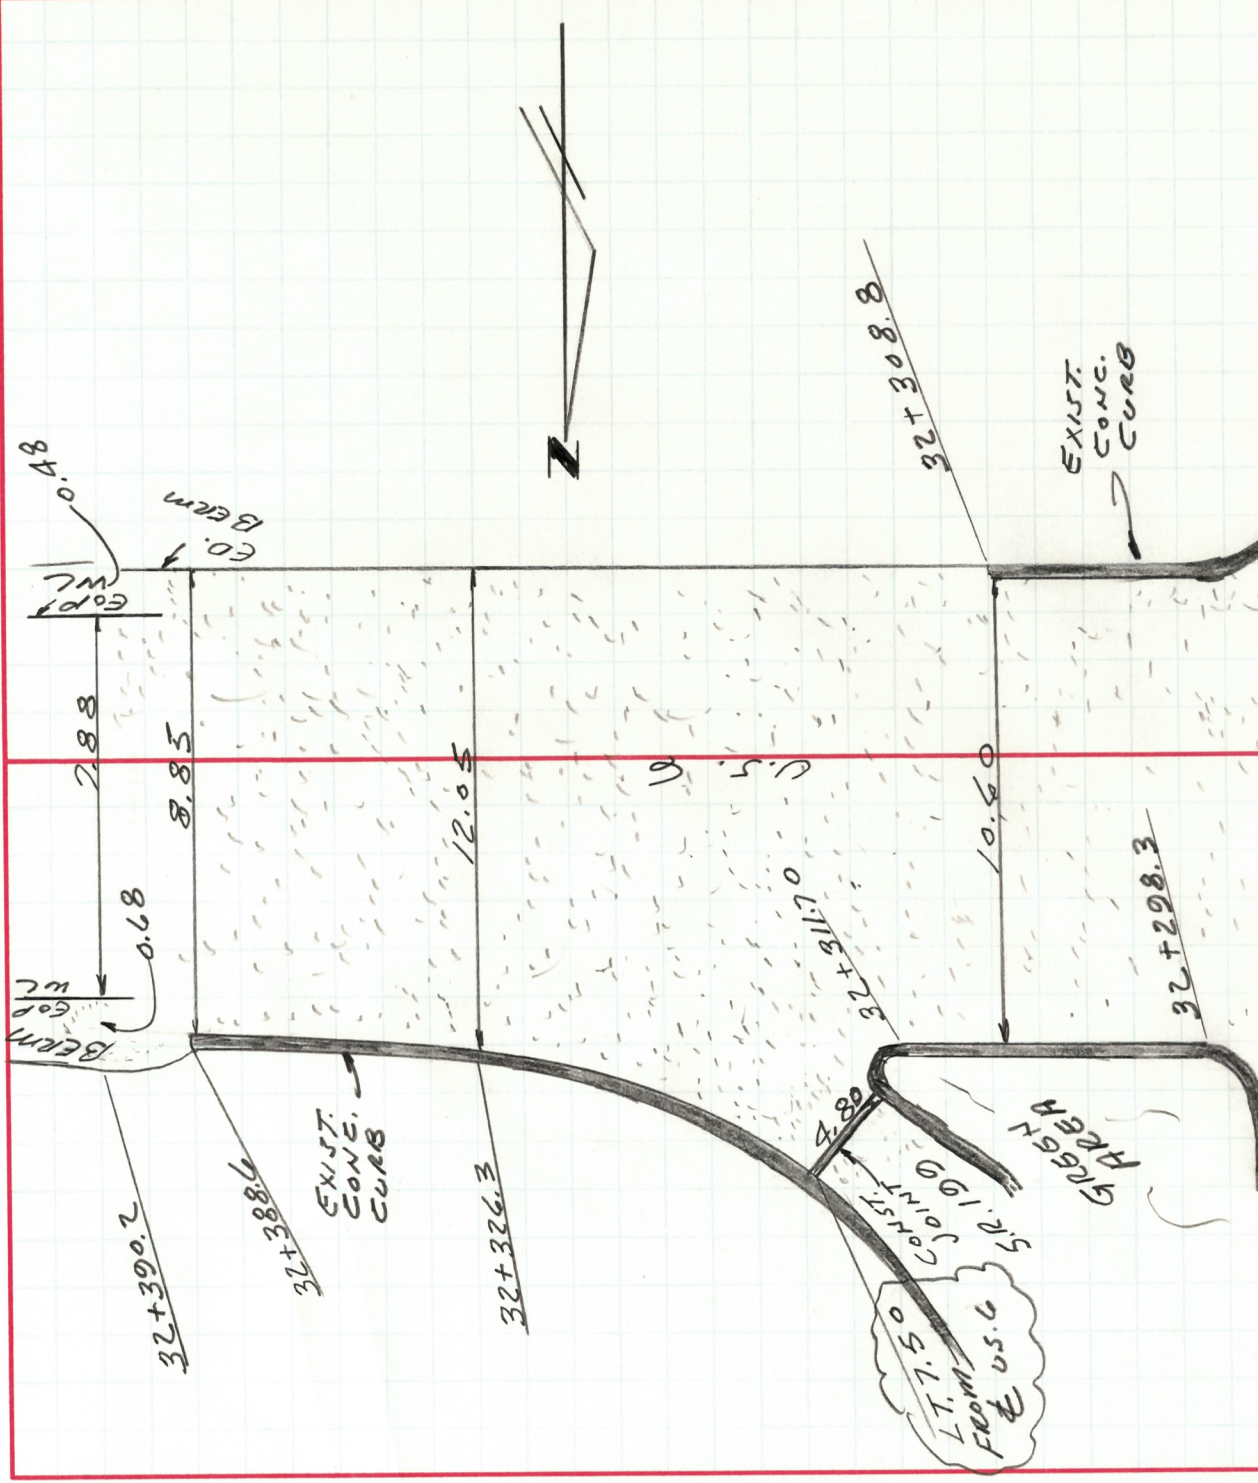

TITLE

COUNTY Wood

DATE 11-4-96

S.F. 0.5. 4

WEATHER CLEAR

SEC. 17.53 ÷ 28.211 56K TEMP. 44°C

TEMP. +4:0

DESCRIPTION	JOB NO.
WATER SECTION - U.S. 65 S.R. 199 SOUTH	

LEFT

CENTER LINE

RIGHT

