

O.D.O.T. DISTRICT 2 SURVEY OFFICE (USE ONLY)

PERSONNEL

REFERENCE NO. 2

SHEET 3 OF 24

NOTES RHOADES

DATE 7/21/23

ROUTE US 6

H.C. AUBLE

WEATHER CLOUDY

COUNTY WOOD

R.C. RHOADES

TEMP. 71°

TOWNSHIP GRAND RAPIDS

SECTION 30

DWG BY RHOADES PID 115398

T 5 N R 9 E


TYPE MONUMENT MAG/WASHER

ON SURFACE - ~~BELOW~~ ON

OFFSET C PAVEMENT 0.5' LT : ~~RT~~

11.4' TO LT EDGE PAVEMENT

STATION: 27+65.87

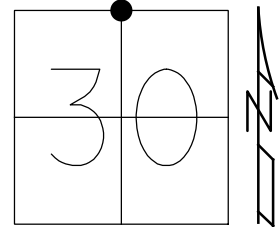


HORZ.DATUM: NAD83 2011

GEOID: NAVD88 2018

GRID: NORTHING: 624169.010

EASTING: 1591589.335

RECORD: P.I.
 $\Delta = 00^{\circ}13'$ RT
 STA 27+66.31
 FD P.K./WASHER
 2" DOWN
 10/30/01
 1/23/02, SAH
 FD P.K.NAIL
 1" DOWN
 REF2
 7/21/14, JLL
 FD P.K./WASHER
 1 1/2" DOWN
 7/18/16, DCH
 SET MAG/WASHER
 REF2
 4/5/17, JLL
 FD MAG/WASHER
 REF2
 7/7/22, DSA
 10/20/23, DSA

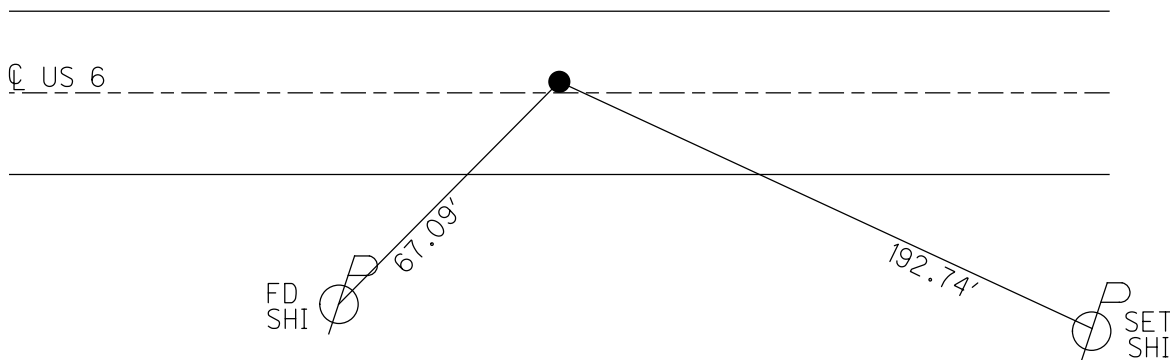

O.D.O.T. DISTRICT 2 SURVEY OFFICE (USE ONLY)

PERSONNEL

REFERENCE NO. 2

SHEET 3 OF 22

NOTES LEU

DATE 7/18/16

ROUTE US 6

H.C. HOMAN

WEATHER CLOUDY

COUNTY WOOD

R.C. LEU

TEMP. 82°

TOWNSHIP GRAND RAPIDS

SECTION 30

DWG BY RHOADES PID 85271

T 5 N R 9 E

TYPE MONUMENT P.K./WASHER

~~ON SURFACE~~ - BELOW 1 1/2"

OFFSET 0.5' LT : ~~RT~~

11.4' TO LT EDGE PAVEMENT


STATION: 27+65.87

HORZ.DATUM: NAD83 2011


GEOID: NAVD88 2012A

GRID: NORTHING: 624168.997

EASTING: 1591589.347

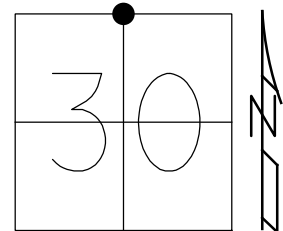

RECORD: P.I.
Δ = 00°13' RT
STA 27+66.31
FD P.K./WASHER
2" DOWN
10/30/01
1/23/02, SAH
FD P.K.NAIL
1" DOWN
REF2
7/21/14, JLL
SET MAG/WASHER
REF2
4/5/17, JLL

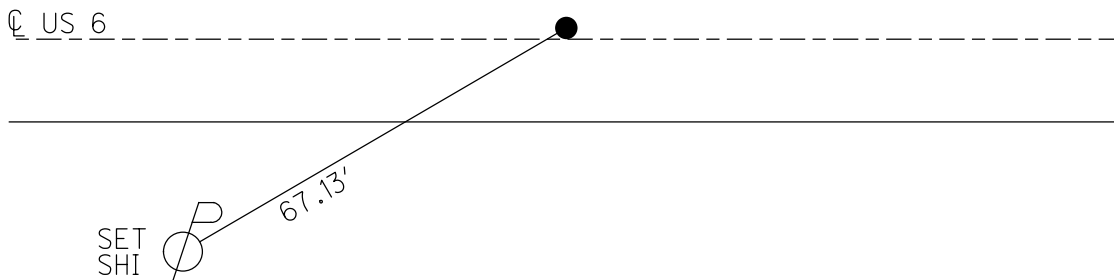

O.D.O.T. DISTRICT 2 SURVEY OFFICE (USE ONLY)

PERSONNEL

REFERENCE NO. 2

SHEET 3 OF 22

NOTES HUSS

DATE 10/30/01

ROUTE US 6

H.C. ROUSOS

WEATHER CLOUDY/COOL

COUNTY WOOD

R.C. VAN DUSEN

TEMP. 57°

TOWNSHIP GRAND RAPIDS

DWG BY NIESE PID _____

SECTION 30

T 5 N R 9 E

TYPE MONUMENT P.K./WASHER

~~ON SURFACE~~ - BELOW 2"


OFFSET \odot PAVEMENT 0.5' LT : ~~RT~~

11.4' TO LT EDGE PAVEMENT


STATION: 27+66

HORZ.DATUM: _____ GEOID: _____

GRID: NORTHING: _____ EASTING: _____

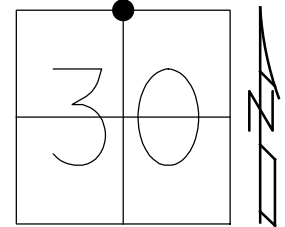

RECORD:
 $\Delta = 00^{\circ}13'00''$ RT
STA 27+66.31
FD P.K./WASHER
2" DOWN
10/30/01, SAH
1/23/02, SAH

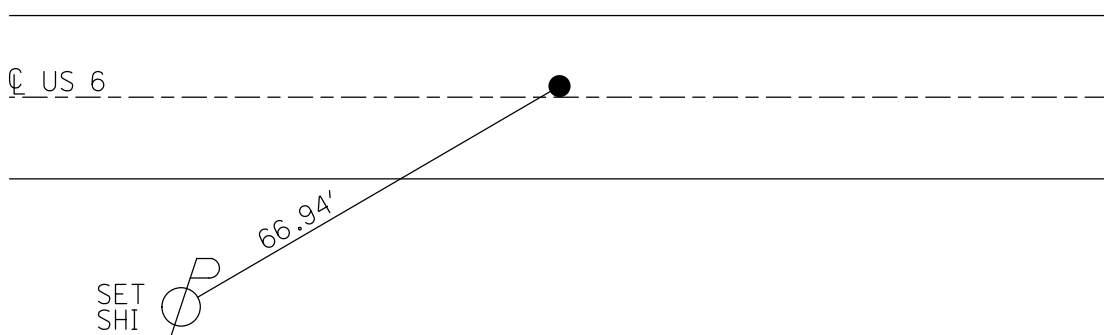

O.D.O.T. DISTRICT 2 SURVEY OFFICE

PERSONNEL

REFERENCE NO. 2

SHEET 2 OF 12

NOTES SAH

H.C. TR

R.C. BVD

DATE 10-30-01

WEATHER CLDY, cool

TEMP. 57°F

ROUTE US 6

COUNTY WOOD

TOWNSHIP GRAND RAPIDS

SECTION 30

T. 5 N. R. 9 E


TYPE MONUMENT PK/WASHER

ON SURFACE - BELOW 2" Below

LEFT - 0 PAV'T. - RIGHT - 0.5

11.4 TO L EDGE PAVEMENT

S.L.M. 27+66

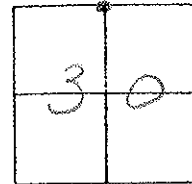


RECORD:

Sta 27+66.31

$\Delta = 0^{\circ} 13' RT$

1-23-02
Fd. Dug OUT
2" Deep
S.M.H.

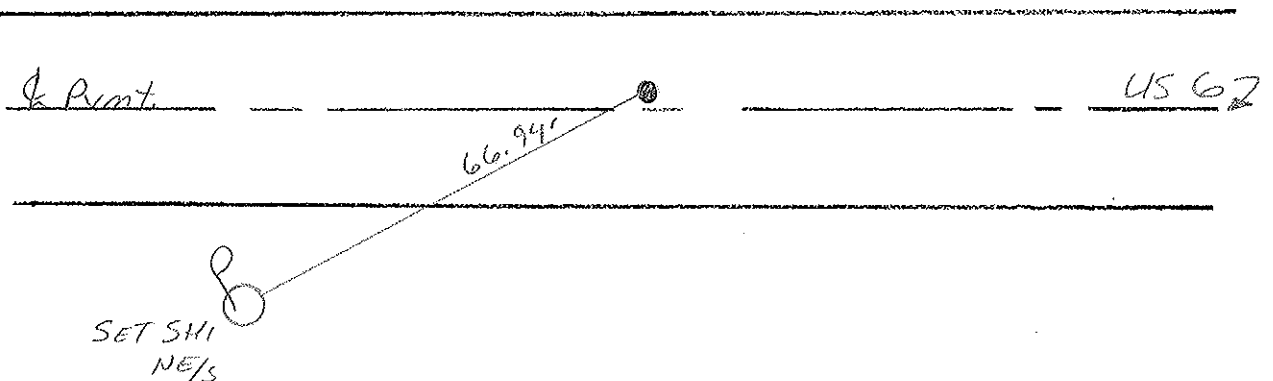

O.D.O.T. DISTRICT 2 SURVEY OFFICE

PERSONNEL

REFERENCE NO. 2

SHEET OF

NOTES HOFFMAN

H.C. BARNHISEL

R.C. LOSHRKE

DATE 7-24-90

WEATHER CLEAR

TEMP. 80

ROUTE US 6

COUNTY WOOD

TOWNSHIP GRAND RAPIDS

SECTION 30

T5 N R 9 E

TYPE MONUMENT P.K. / WASHER


ON SURFACE - BELOW YES

LEFT - C PAV'T. - RIGHT 0.5


11.4 TO LT. EDGE PAVEMENT

S.L.M. 27+66

Set
P.K. / WASHER
8-10-90
SWK

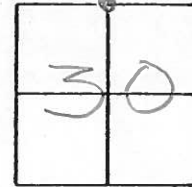

RECORD:
Sta. 27+66.31
Δ = 0°-13' RT.

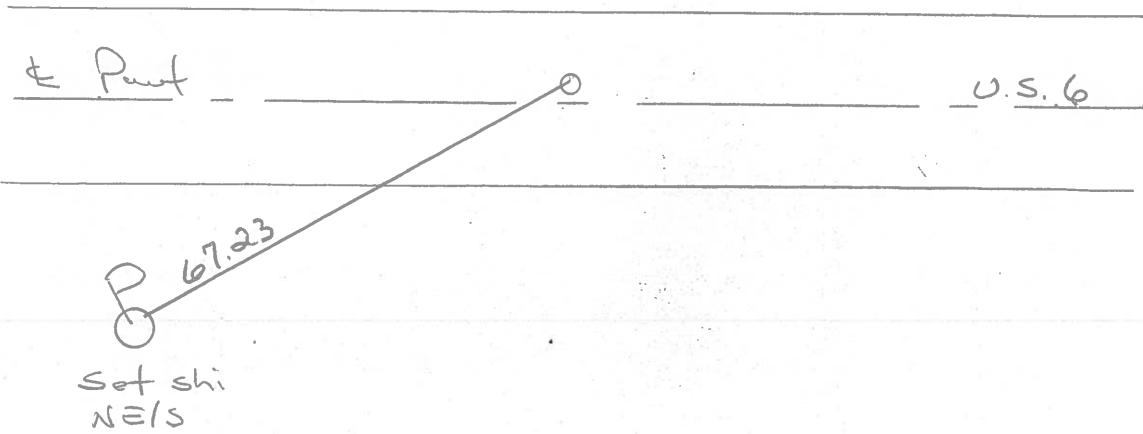

O.D.O.T. DISTRICT 2 SURVEY OFFICE

SHEET 2 OF

1-21-83

County WOOD ^{U.S.} S.R. 6

Date 6-24-74

Township GRAND RAPIDS

Weather CLEAR

Section 30

Temp. 60° 30°


T5N, R9E

Personnel BURNSIDE

SMITH

BOWERS

KJOWSKI

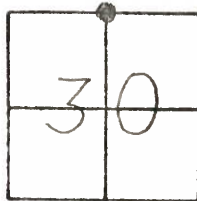

#2 ✓ Sta 27+66


12.5 ft.
12.5 ft.
0.5 ft ctr.

SET SMALL R.R. SPK. 10-16-74

STA. 27+66.31

$\Delta = 0^\circ - 13' RT.$

ADJ. BRASS MON. UNDERNEATH

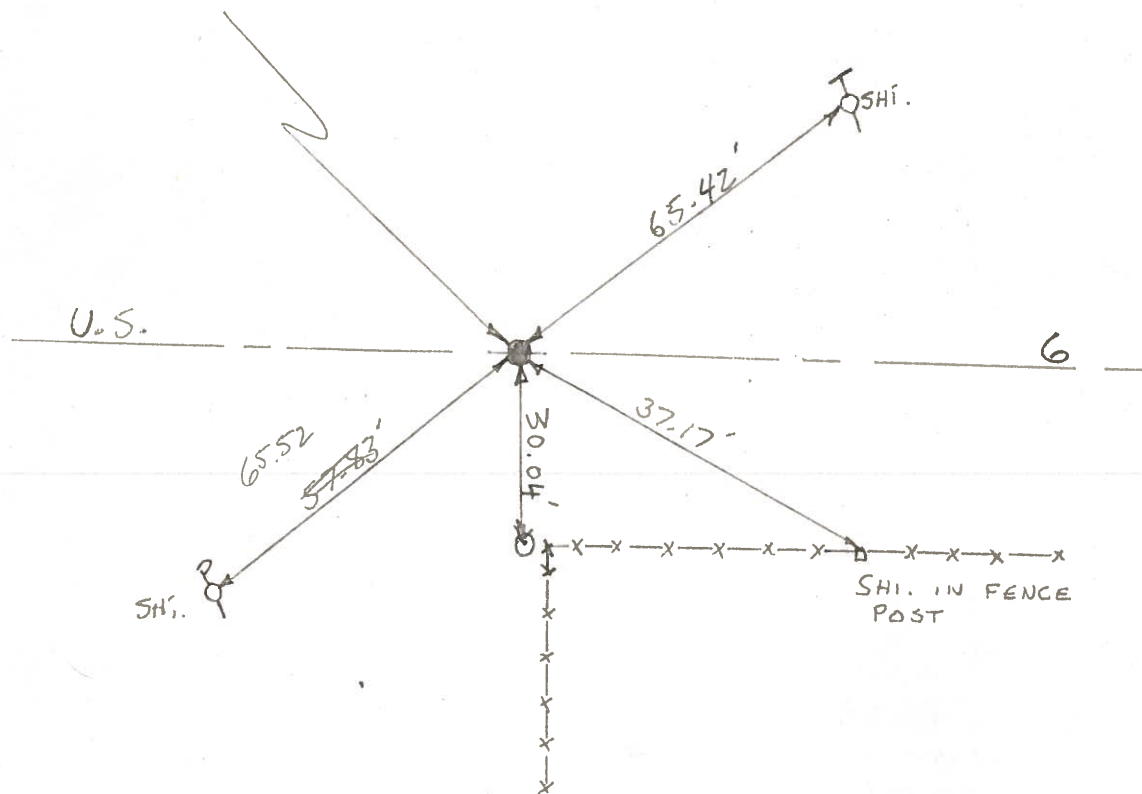

County Wood S.R. 6

Date 1-21-83

Township Grand Rapids


Weather Partly Cloudy

Section 30


Temp. +30


T₆N, R₉E


Personnel Hoffman 

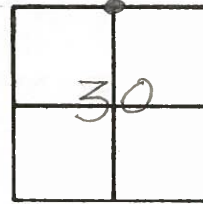

2

Householder 

Barnhisel 


Loehrke 

Fd. small r.r. spike at surface
0.5' Lt. of centr. line pavement
12.5' to S.E.P.
11.5' to N.E.P.

S.L.M. 27+66

Set P.K.
5-28-84
C.L.

Record: Sta. 27.+66.31
 $\Delta = 0^{\circ} 13' \text{rt.}$

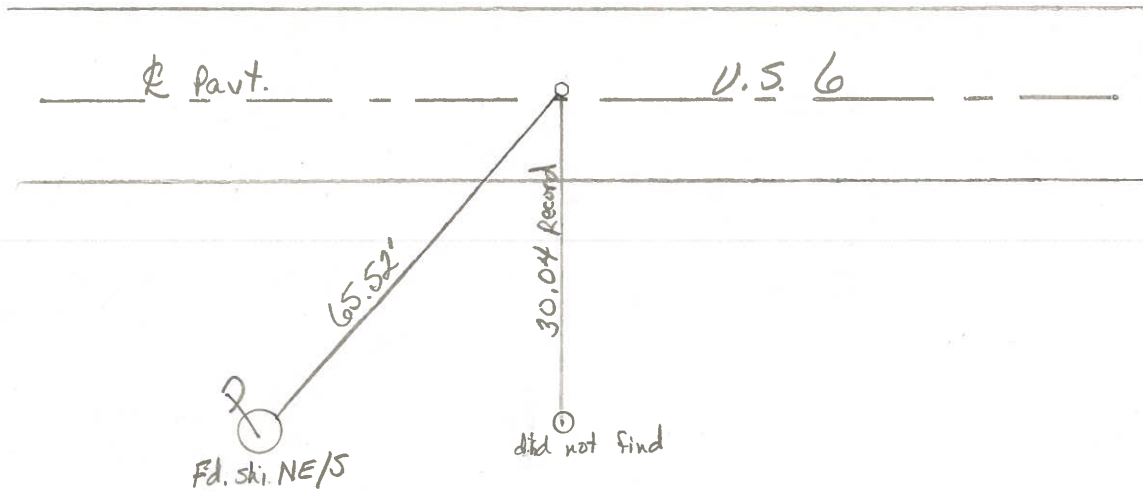

County WOOD ^{U.S.} S.R. 6

Date 6-24-74

Township GRAND RAPIDS

Weather CLEAR

Section 30

Temp. 60°


T5N, R9E

Personnel BURNSIDE

SMITH

BOWERS

KIJOWSKI

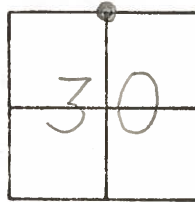

#2




SET SMALL R.R. SPK. 10-16-74

STA. 27+66.31


$\Delta = 0^\circ - 13' \text{ RT.}$

ADJ. BRASS MON. UNDERNEATH

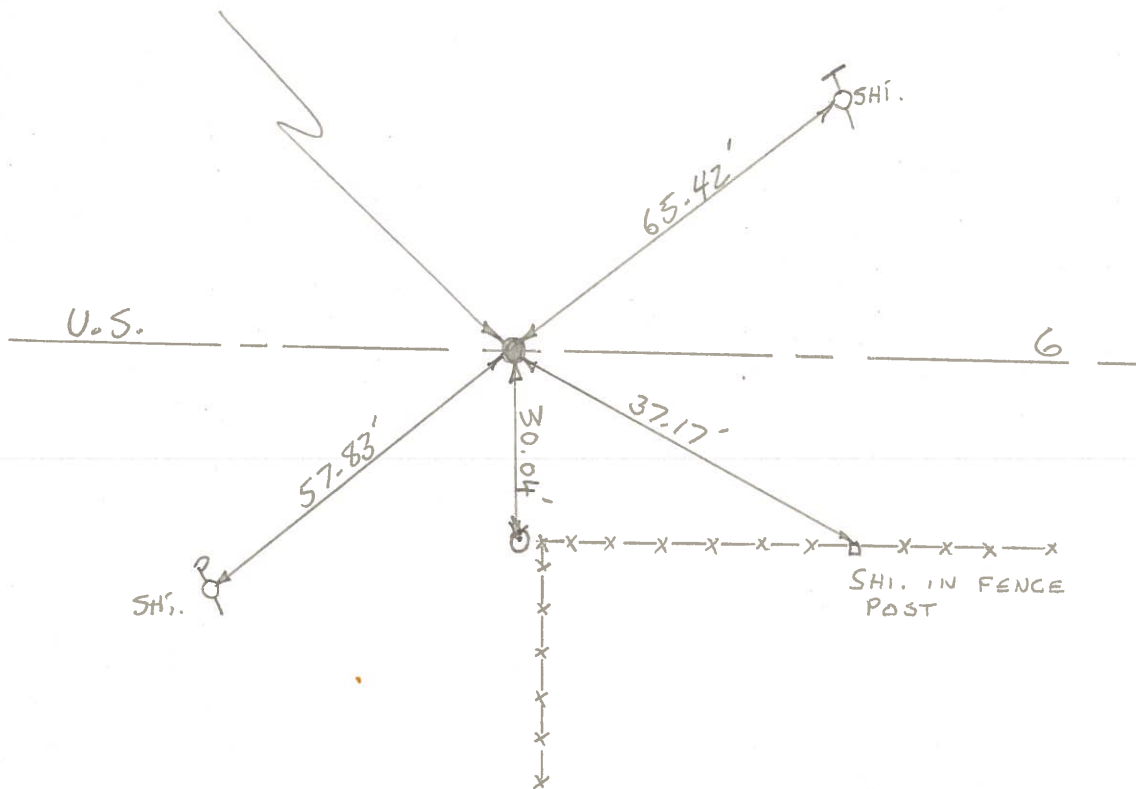

PERSONNEL	TITLE	PERSONNEL	TITLE	COUNTY	DATE
BURNSIDE				WOOD	6-24-74
SMITH				S. R. U.S. 6	WEATHER CLEAR
BOWERS				SEC. N 1/4 Post Sec. 30	TEMP. +60°
KIJOWSKI					

DESCRIPTION: CONTROL TIES JOB NO. _____

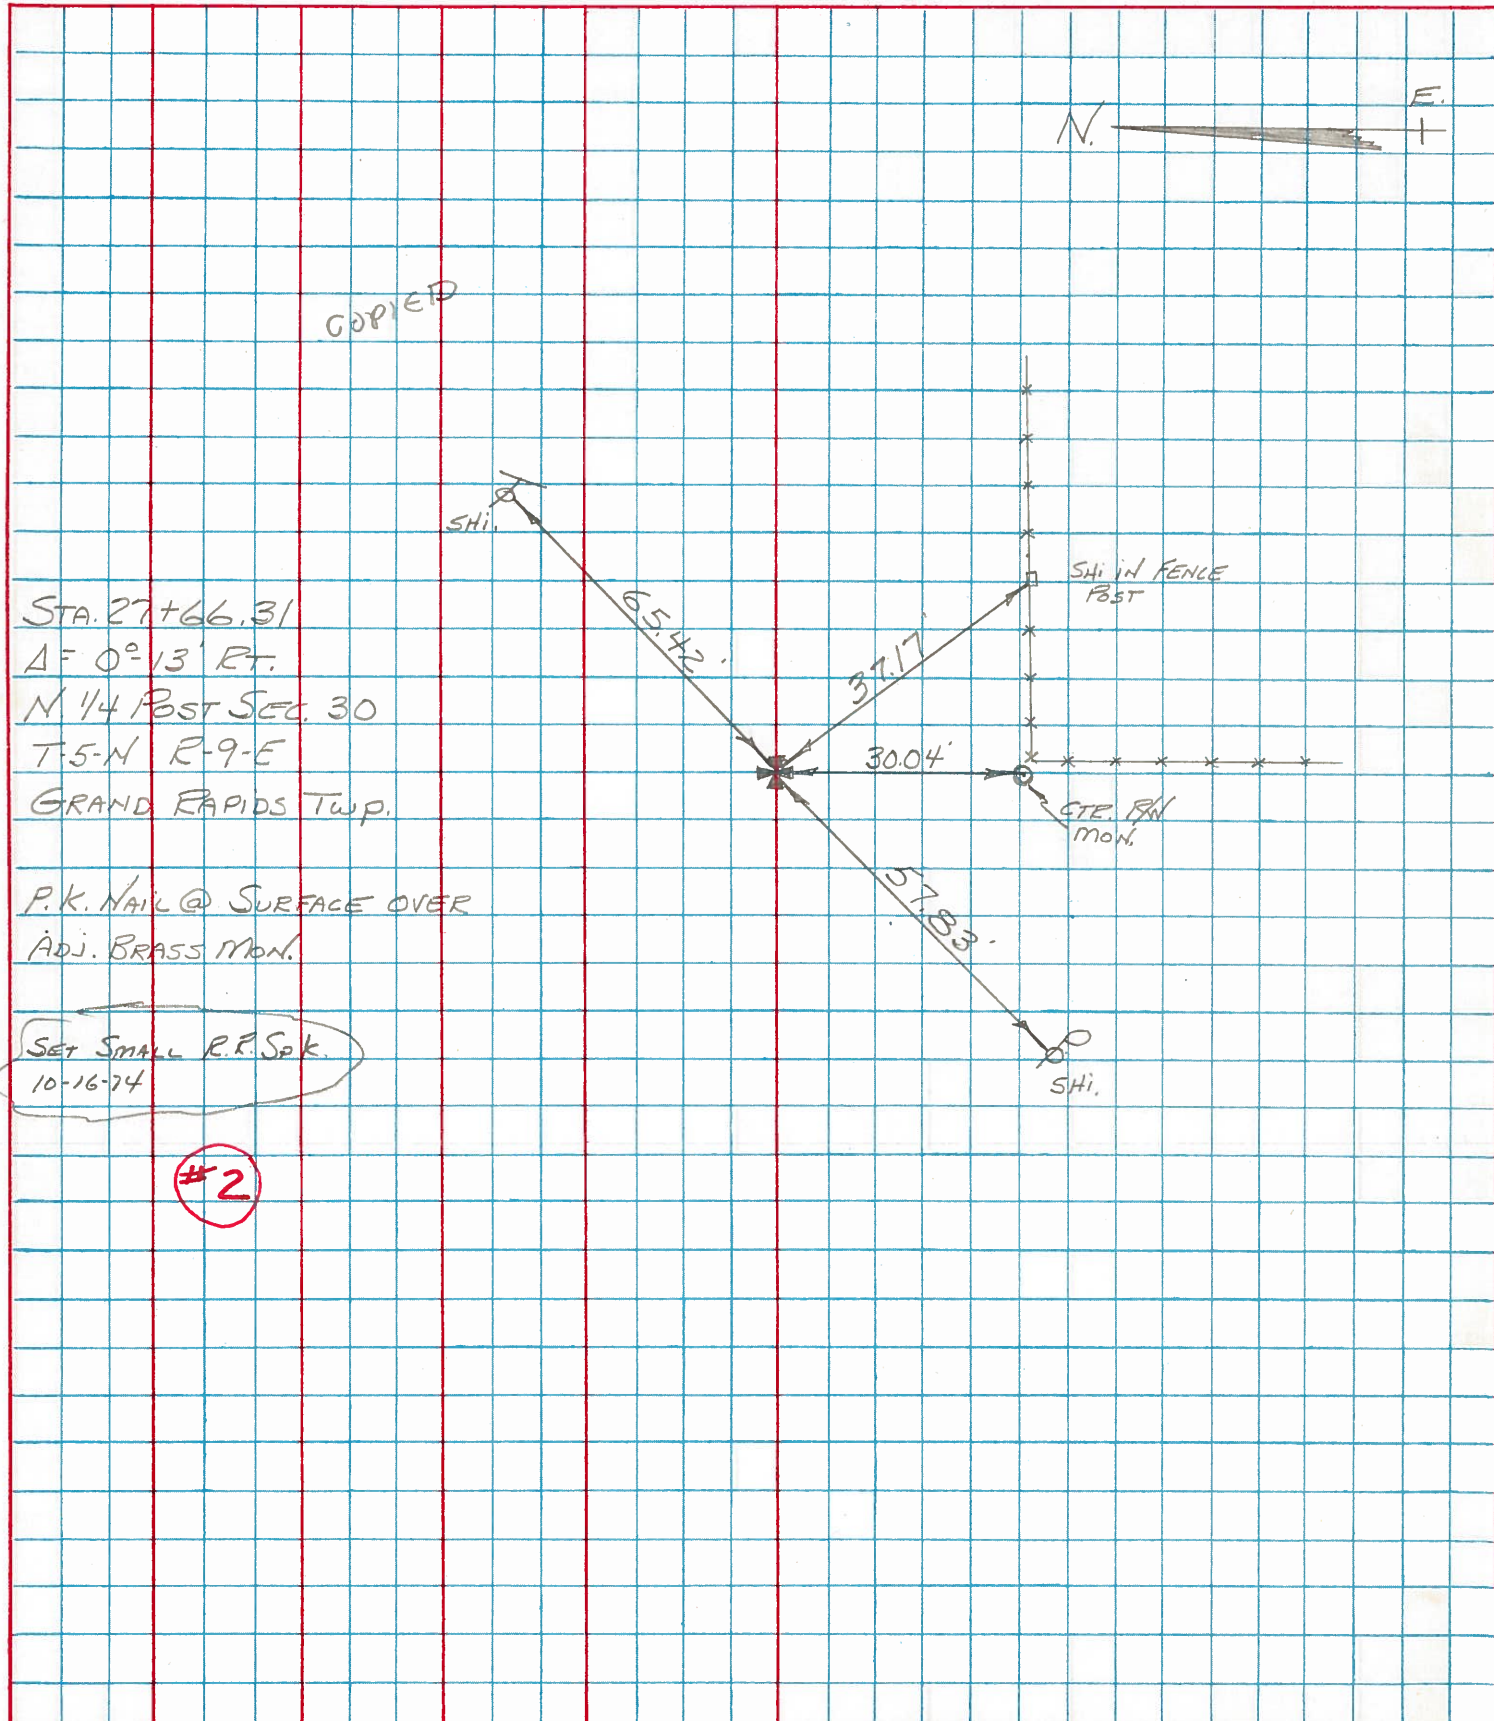

PERSONNEL TITLE PERSONNEL TITLE
 Morrison _____ Smith _____
 Bowers _____ Burnside _____
 Halcombe _____
 Kern _____

COUNTY Wood DATE FEB, 5, 1968
 S. R. 45*6 WEATHER Clear
 SEC. _____ TEMP. 40°

DESCRIPTION Control points from Wood-Henry Co line East JOB NO. _____

