



O.D.O.T. DISTRICT 2 SURVEY OFFICE (USE ONLY)

PERSONNEL \_\_\_\_\_ REFERENCE NO. 3 SHEET 4 OF 24  
 NOTES RHOADES DATE 7/21/23 ROUTE US 6  
 H.C. AUBLE WEATHER CLOUDY COUNTY WOOD  
 R.C. RHOADES TEMP. 71° TOWNSHIP GRAND RAPIDS  
 DWG BY RHOADES PID 115398 SECTION 29  
 T 5 N R 9 E

TYPE MONUMENT MAG/WASHER  
 ON SURFACE - ~~BELOW~~ ON  
 OFFSET CL PAVEMENT 1.3' ~~LT~~ : RT  
- TO - EDGE PAVEMENT  
 STATION: 54+19.12

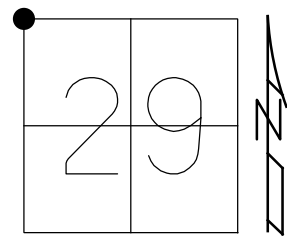

HORIZ.DATUM: NAD83 2011 GEOID: NAVD88 2018  
 GRID: NORTHING: 624138.621 EASTING: 1594242.422

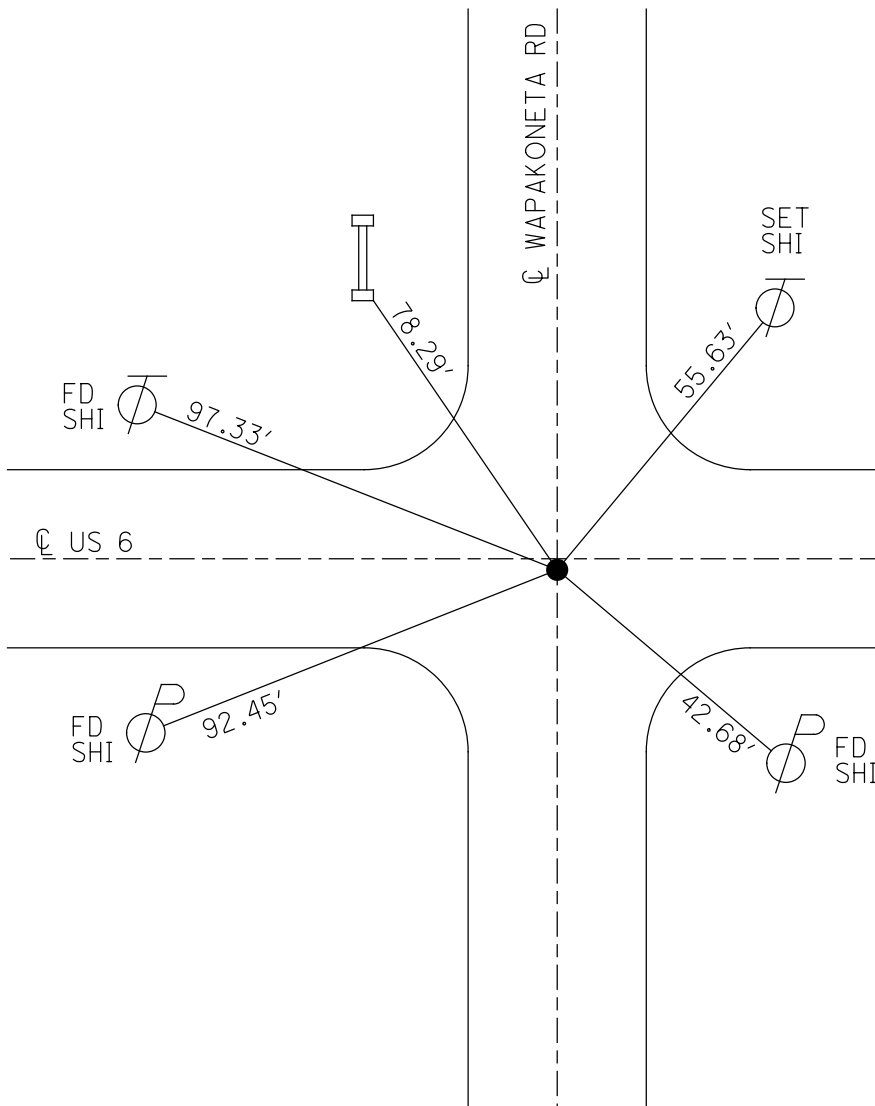

RECORD: P.I.  
 $\Delta = 00^\circ 41' \text{ LT}$   
 STA 54+18.28  
 FD P.K./WASHER  
 10/30/01, SAH  
 SET P.K./WASHER  
 1/23/02, SAH  
 SET P.K./WASHER  
 1/23/02, SAH  
 FD P.K.NAIL  
 REF3  
 7/21/14, JLL  
 FD P.K./WASHER  
 7/18/16, DCH  
 SET MAG/WASHER  
 REF3  
 4/5/17, JLL  
 FD MAG/WASHER  
 REF3  
 7/7/22, DSA  
 10/20/23, DSA

O.D.O.T. DISTRICT 2 SURVEY OFFICE (USE ONLY)

PERSONNEL \_\_\_\_\_

REFERENCE NO. 3

SHEET 4 OF 22

NOTES LEU DATE 7/18/16  
 H.C. HOMAN WEATHER CLOUDY  
 R.C. LEU TEMP. 82°

ROUTE US 6  
 COUNTY WOOD  
 TOWNSHIP GRAND RAPIDS  
 SECTION 29  
T 5 N R 9 E

DWG BY RHOADES PID 85271

TYPE MONUMENT P.K./WASHER

ON SURFACE - ~~BELOW~~ ON

OFFSET  $\odot$  PAVEMENT 0.7' LT : RT

- TO - EDGE PAVEMENT



STATION: 54+19.12

HORZ.DATUM: NAD83 2011

GEOID: NAVD88 2012A

GRID: NORTHING: 624138.611

EASTING: 1594242.366

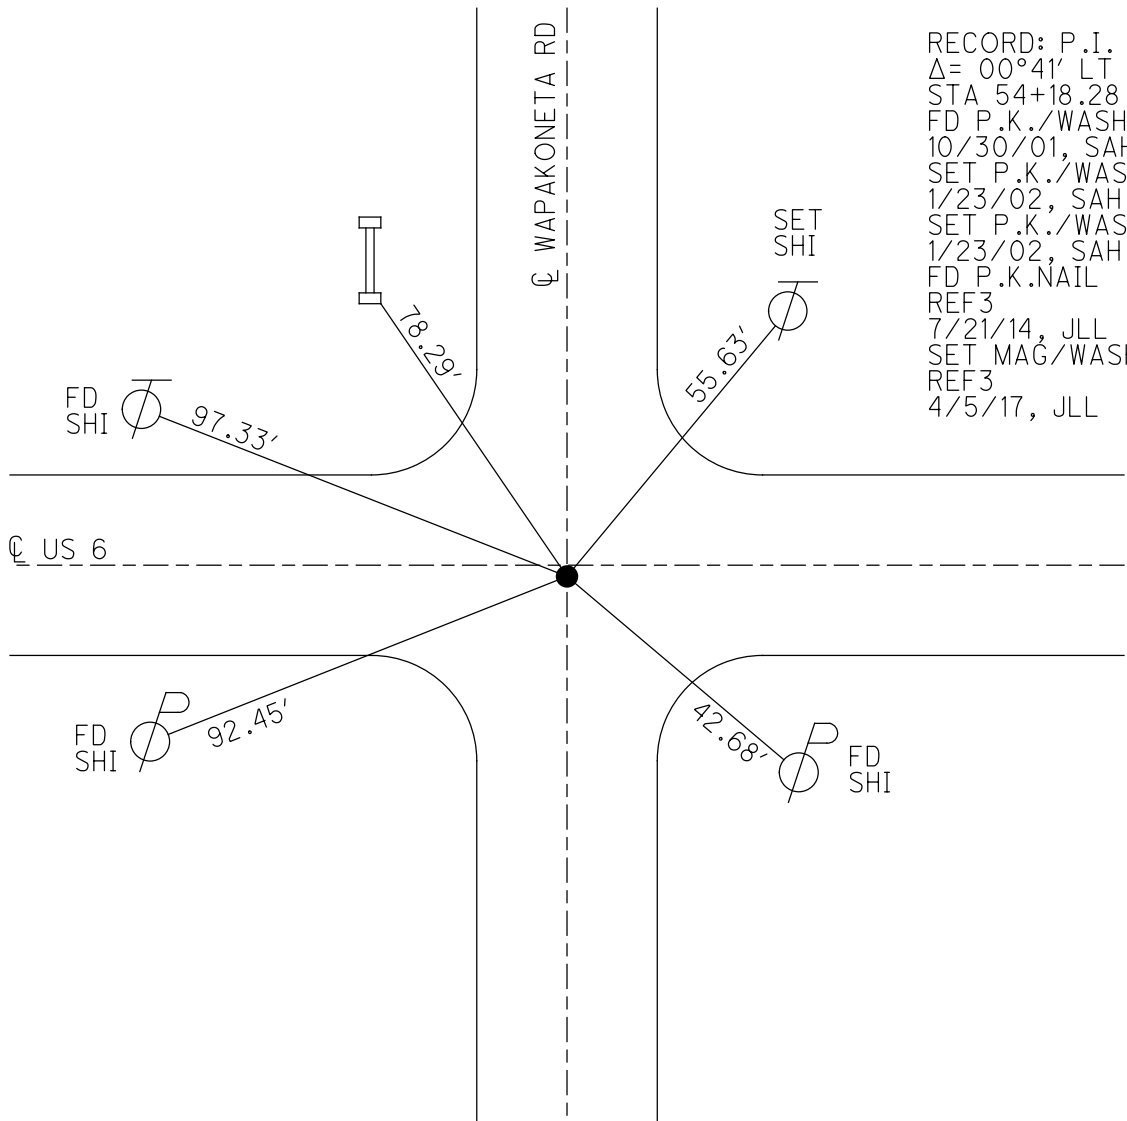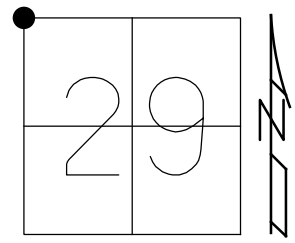

RECORD: P.I.  
 $\Delta = 00^{\circ}41' LT$   
 STA 54+18.28  
 FD P.K./WASHER  
 10/30/01, SAH  
 SET P.K./WASHER  
 1/23/02, SAH  
 SET P.K./WASHER  
 1/23/02, SAH  
 FD P.K.NAIL  
 REF3  
 7/21/14, JLL  
 SET MAG/WASHER  
 REF3  
 4/5/17, JLL

O.D.O.T. DISTRICT 2 SURVEY OFFICE (USE ONLY)

PERSONNEL \_\_\_\_\_

REFERENCE NO. 3

SHEET 4 OF 22

NOTES HUSS

DATE 10/30/01

ROUTE US 6

H.C. ROUSOS

WEATHER CLOUDY/COOL

COUNTY WOOD

R.C. RC

TEMP. 57°

TOWNSHIP GRAND RAPIDS

DWG BY NIESE PID \_\_\_\_\_

SECTION 29

T 5 N R 9 E

TYPE MONUMENT P.K./WASHER

ON SURFACE - ~~BELOW~~ ON \_\_\_\_\_

OFFSET  $\phi$  PAVEMENT 0.7' ~~LT~~ : RT

- TO - EDGE PAVEMENT


STATION: 54+70

HORIZ.DATUM: \_\_\_\_\_


GEOID: \_\_\_\_\_

GRID: NORTHING: \_\_\_\_\_

EASTING: \_\_\_\_\_

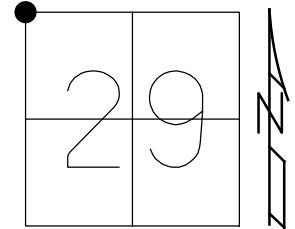

RECORD:  
 $\Delta = 00^{\circ}41'00''$  LT  
 STA 54+18.28  
 SET P.K./WASHER  
 10/30/01, SAH  
 SET P.K./WASHER  
 1/23/02, SAH

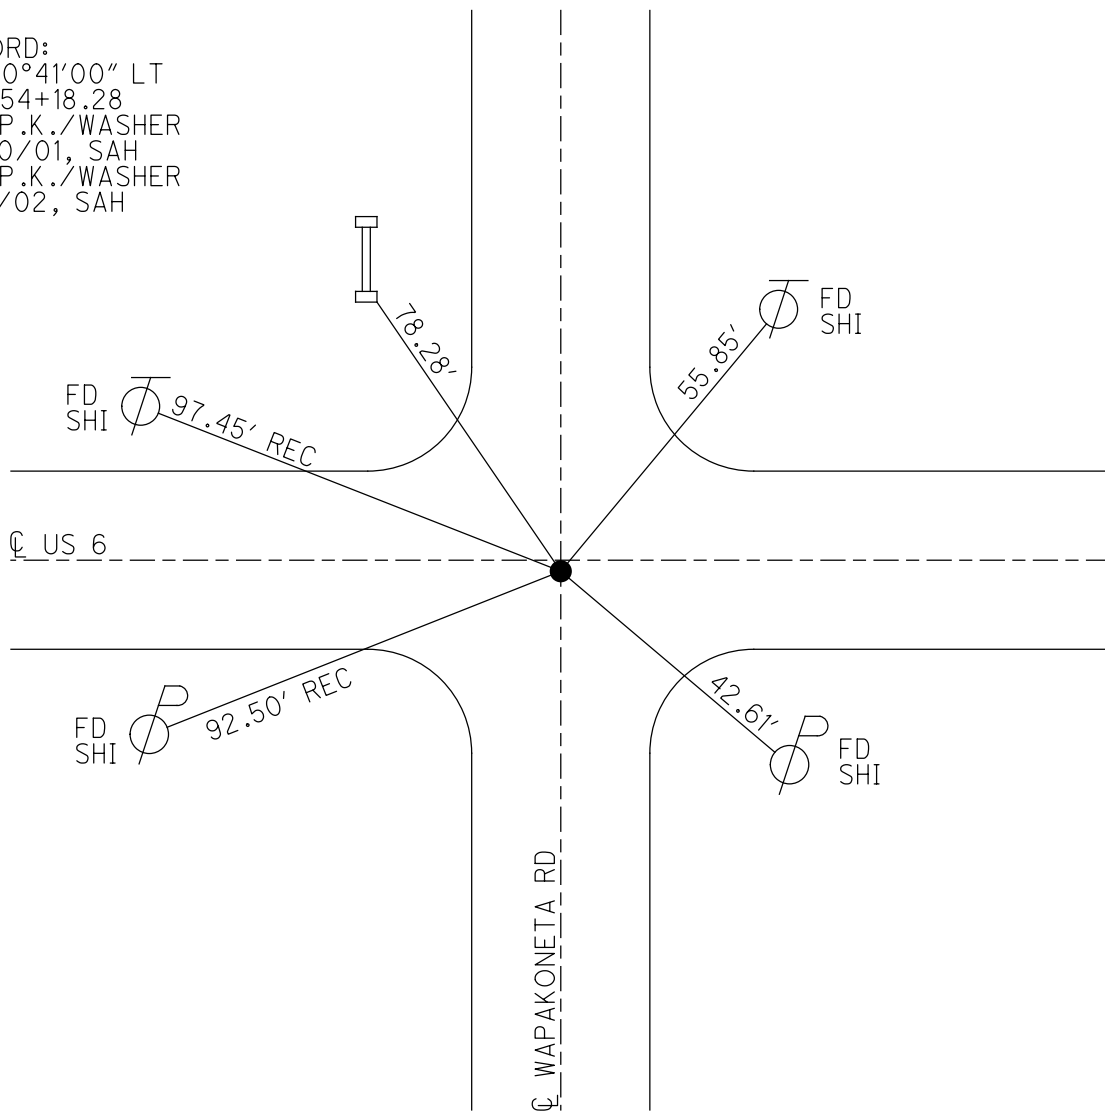

# O.D.O.T. DISTRICT 2 SURVEY OFFICE

PERSONNEL \_\_\_\_\_

REFERENCE NO. 3

SHEET 3 OF 12

NOTES SAH

H.C. TR

R.C. RC

DATE 10-30-01

WEATHER CLDY Cool

TEMP. 57°F

ROUTE US 62

COUNTY Wood

TOWNSHIP GRAND RAPIDS

SECTION 29

T5 N R 9 E


TYPE MONUMENT PK & WASHER

ON SURFACE - BELOW YES

~~LEFT~~ - ~~PAV'T.~~ - RIGHT 0.7'


TO EDGE PAVEMENT ON E PAV'T NORTH

S.L.M. 54+20

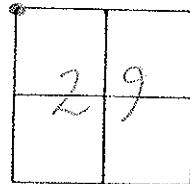

RECORD  
Sta. 54+18.28  
 $\Delta = 0^\circ 41' \text{LT}$

SET PK & WASHER  
1-23-02  
SAH

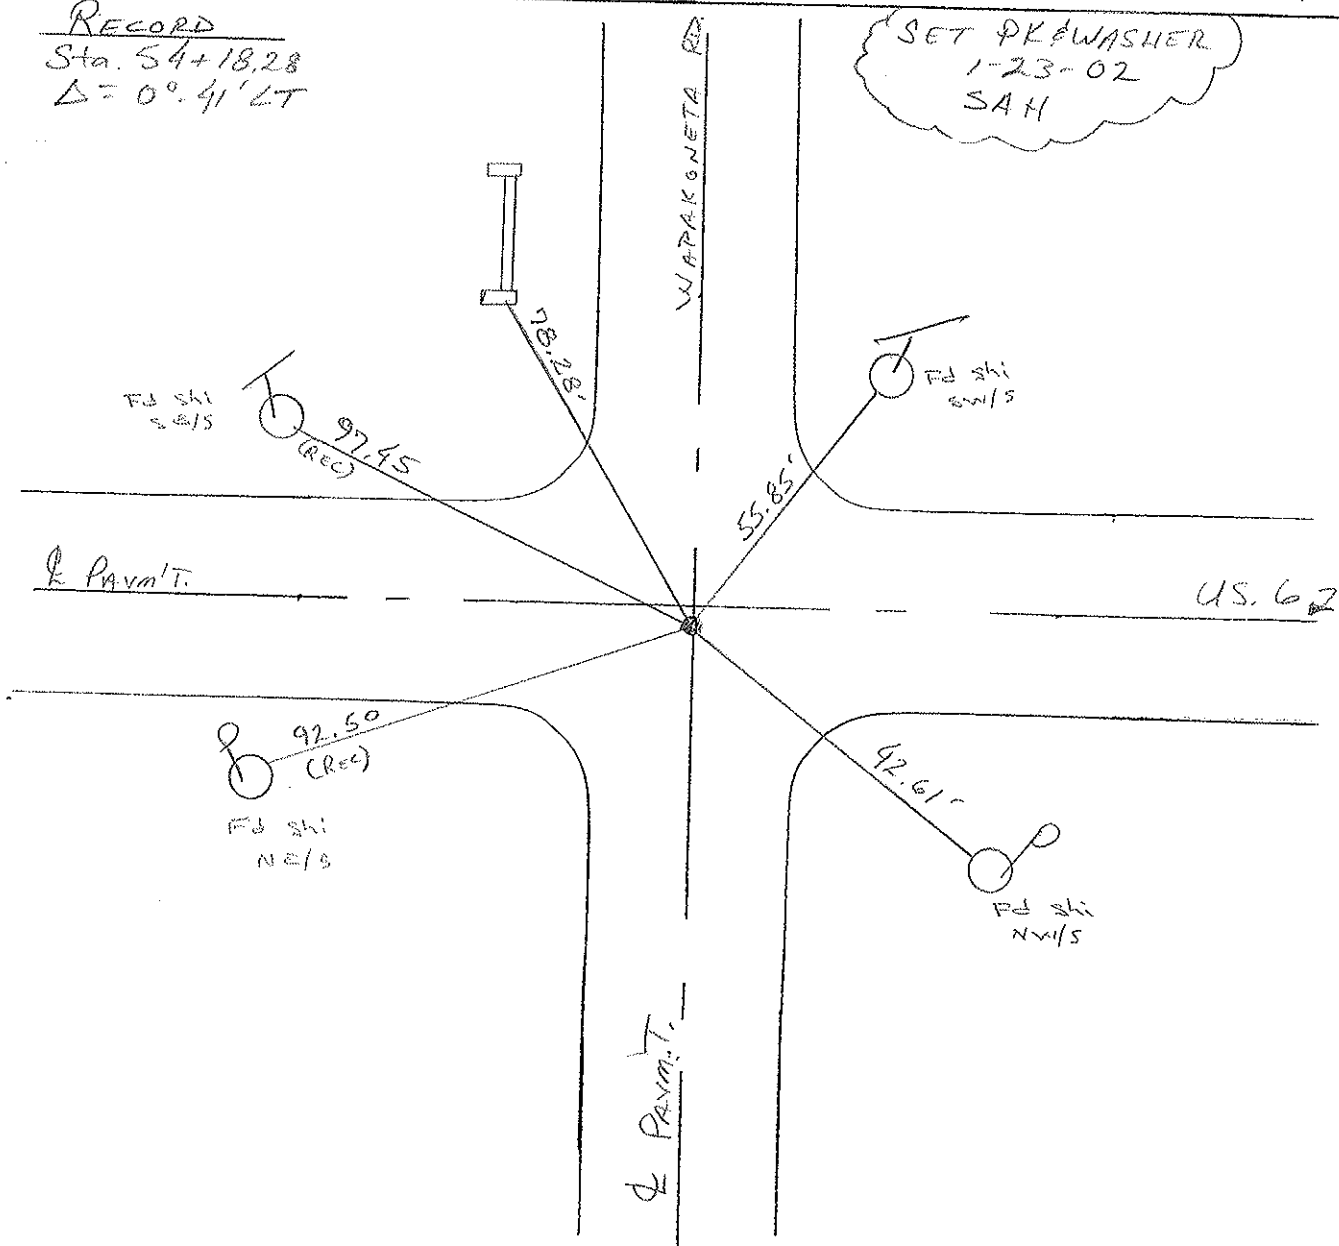

# O.D.O.T. DISTRICT 2 SURVEY OFFICE

PERSONNEL

REFERENCE NO. 3

SHEET      OF     

NOTES HOFFMAN

H.C. BARNHISEL

DATE 7-24-90

ROUTE US 6

R.C. LOEHRKE

WEATHER CLEAR

COUNTY WOOD

TEMP. 80

TOWNSHIP GRAND RAPIDS

SECTION 29

T5 N R 9 E

TYPE MONUMENT P.K./WASHER


Set  
P.K./WASHER  
8-10-90 SWA

ON SURFACE - BELOW YES


LEFT - C PAV'T. - RIGHT 0.7'

     TO      EDGE PAVEMENT ON & Part North

S.L.M. 54+20

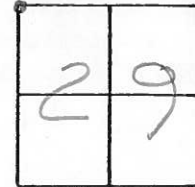

Record:  
Sta. 54+18.28  
A = 0° 41' Lt.

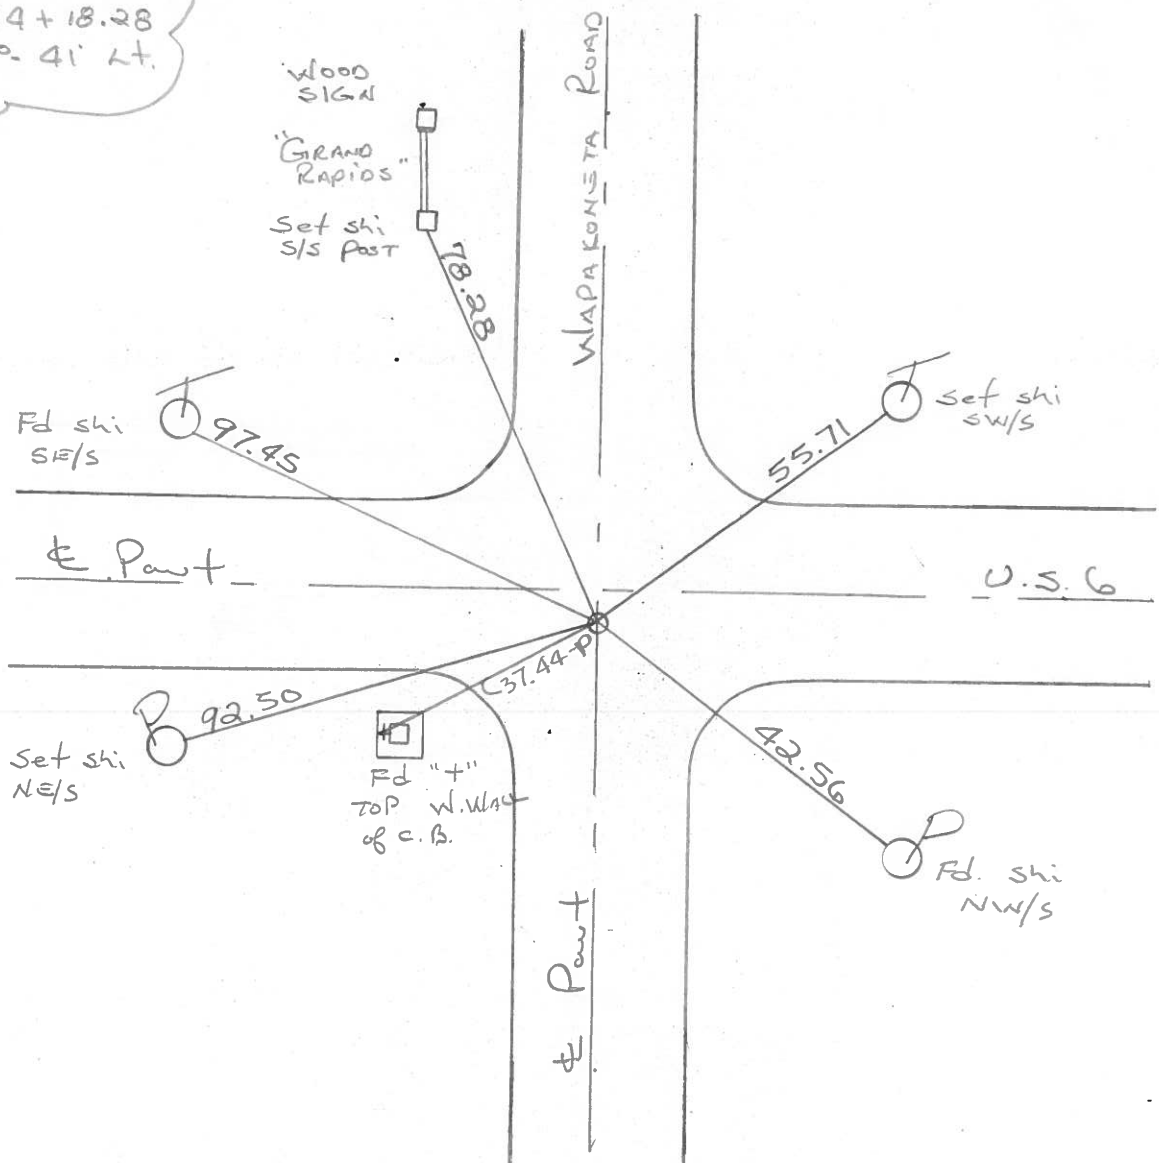

County Wood S.R. U.S. 6

Date 1-21-83

Township \_\_\_\_\_


Weather Cloudy

Section 29

Temp. 38°

T5N, R9E

Personnel Hoffman

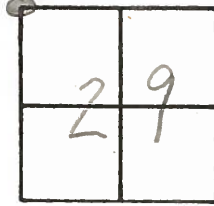

#3


+  
Crew

Fd. P.K. nail at surface  
1.0' rt. of ctr. line pavement U.S. 6  
On ctr. line pavt. Wapakoneta Rd.

S.L.M. 54+20

Set P.K.  
5-28-84  
C.L.

Record: Sta. 54+18.28  
 $\Delta = 0^\circ - 41' \text{ Lt.}$

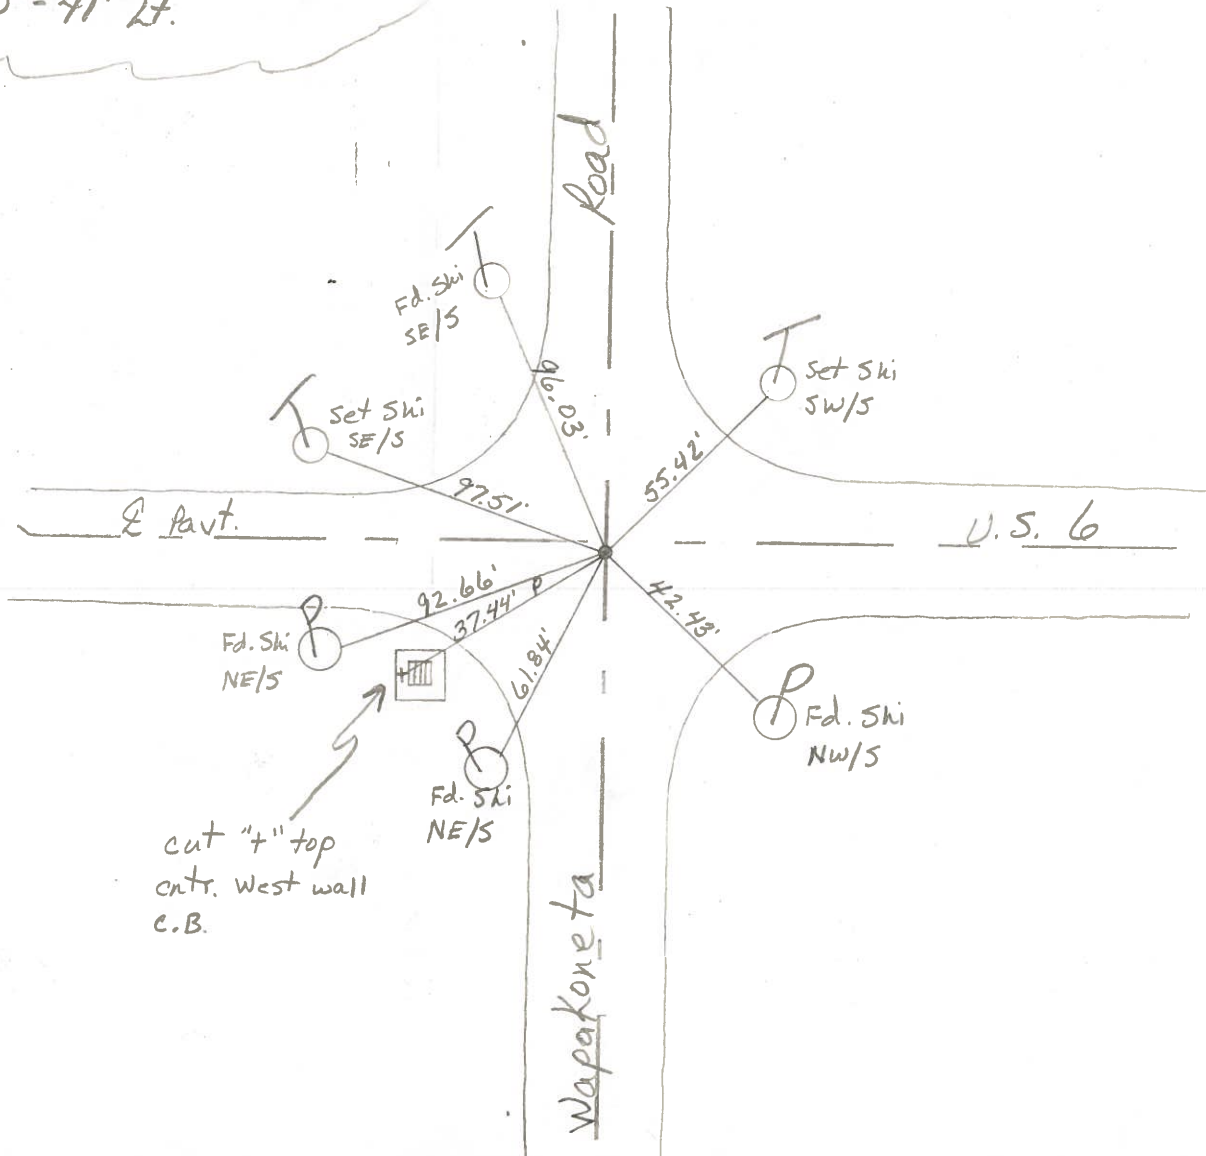

County WOOD <sup>U.S.</sup> ~~S.R.~~ 6

Date 1-21-83  
~~6-24-74~~

Township GRAND RAPIDS


Weather CLEAR

Section 29

Temp. 62° 30°

T5N, R9E

Personnel BURNSIDE  
SMITH  
BOWERS  
KIJOWSKI

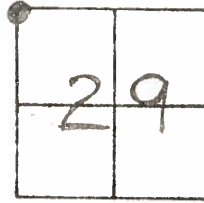

# 3 ✓

Sta. 54+20


rt.  
ft.

10' rt. of ctr.

P.K. NAIL AT SURFACE  
OVER ADJ. BRASS MON.

STA. 54+18.28

$\Delta = 0^\circ - 41' \text{ LT.}$

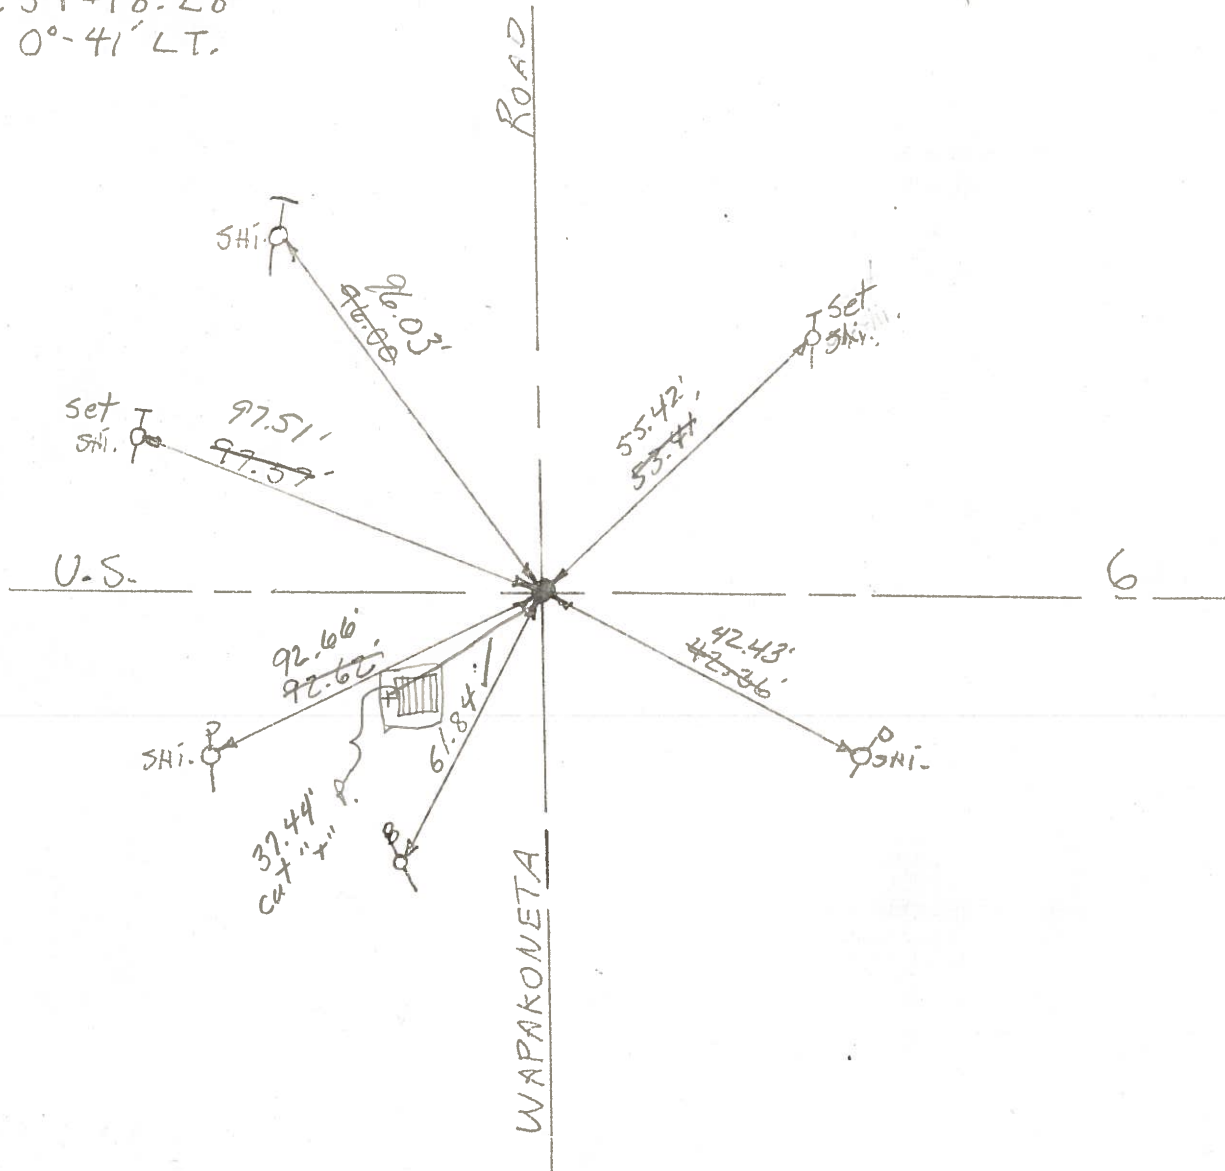

County WOOD <sup>U.S.</sup> ~~S.R.~~ 6

Date 6-24-74

Township GRAND RAPIDS

Weather CLEAR

Section 29

Temp. 62°

T5N, R9E

Personnel BURNSIDE

SMITH

BOWERS

KIJOWSKI




#3

P.K. NAIL AT SURFACE  
OVER ADJ. BRASS MON.

STA. 54+18.28


$\Delta = 0^{\circ}-41' LT.$

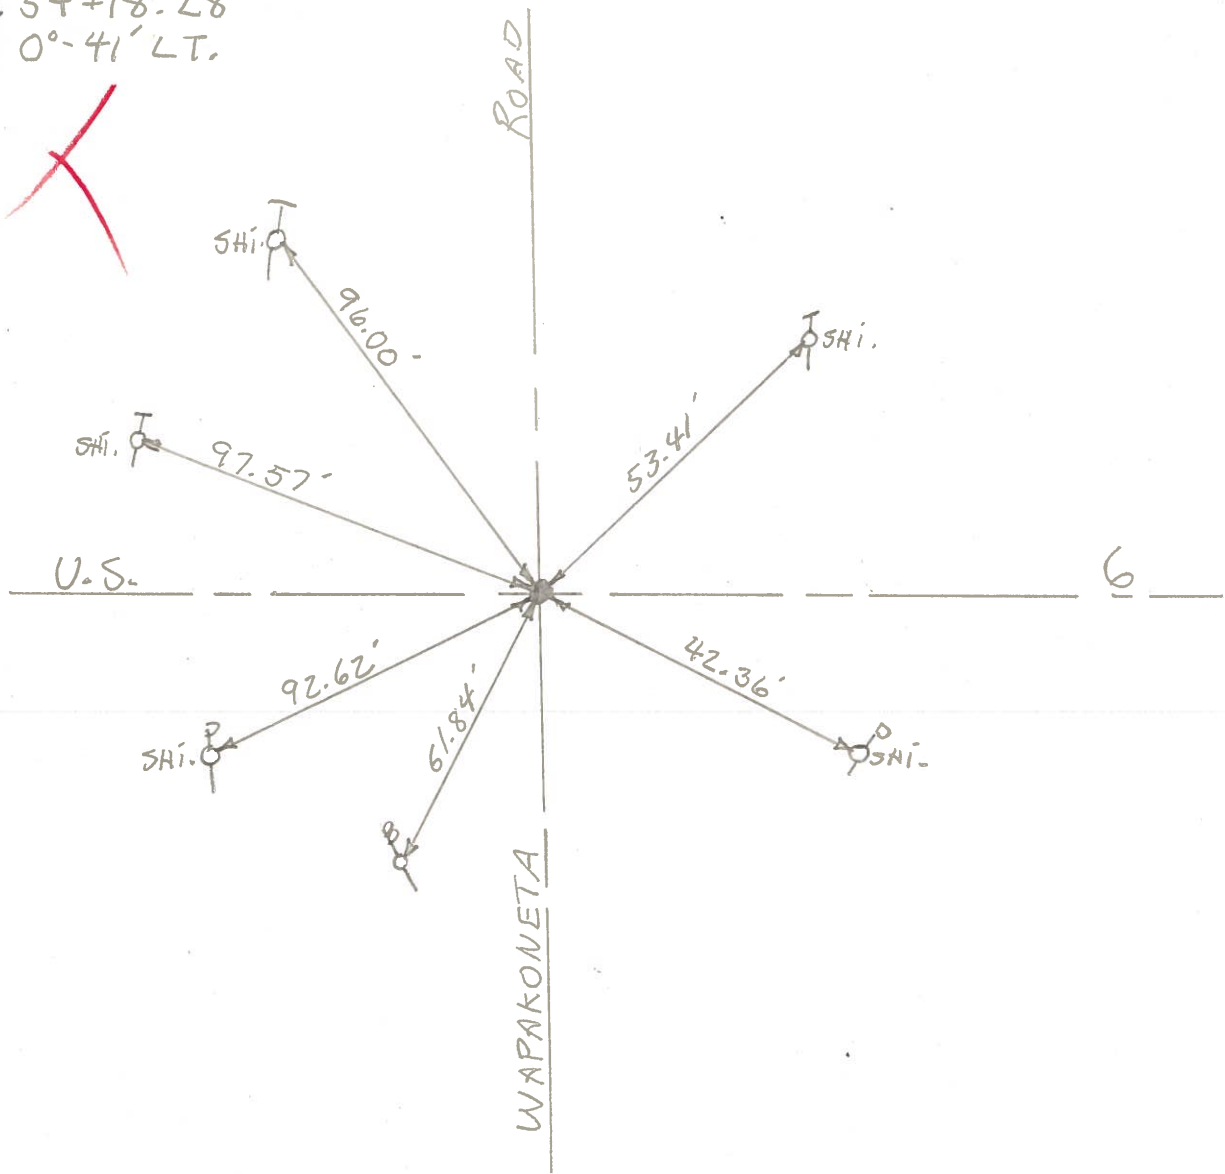



PERSONNEL	TITLE	PERSONNEL	TITLE	COUNTY	DATE
BURNSIDE				Wood	6-24-74
SMITH				S. R. U.S. 6	WEATHER CLEAR
BOWERS				SEC. N.W. COR. SEC. 29	TEMP. +62°
KIJOWSKI					

DESCRIPTION: SEC. COR. & CONTROL POINT TIES

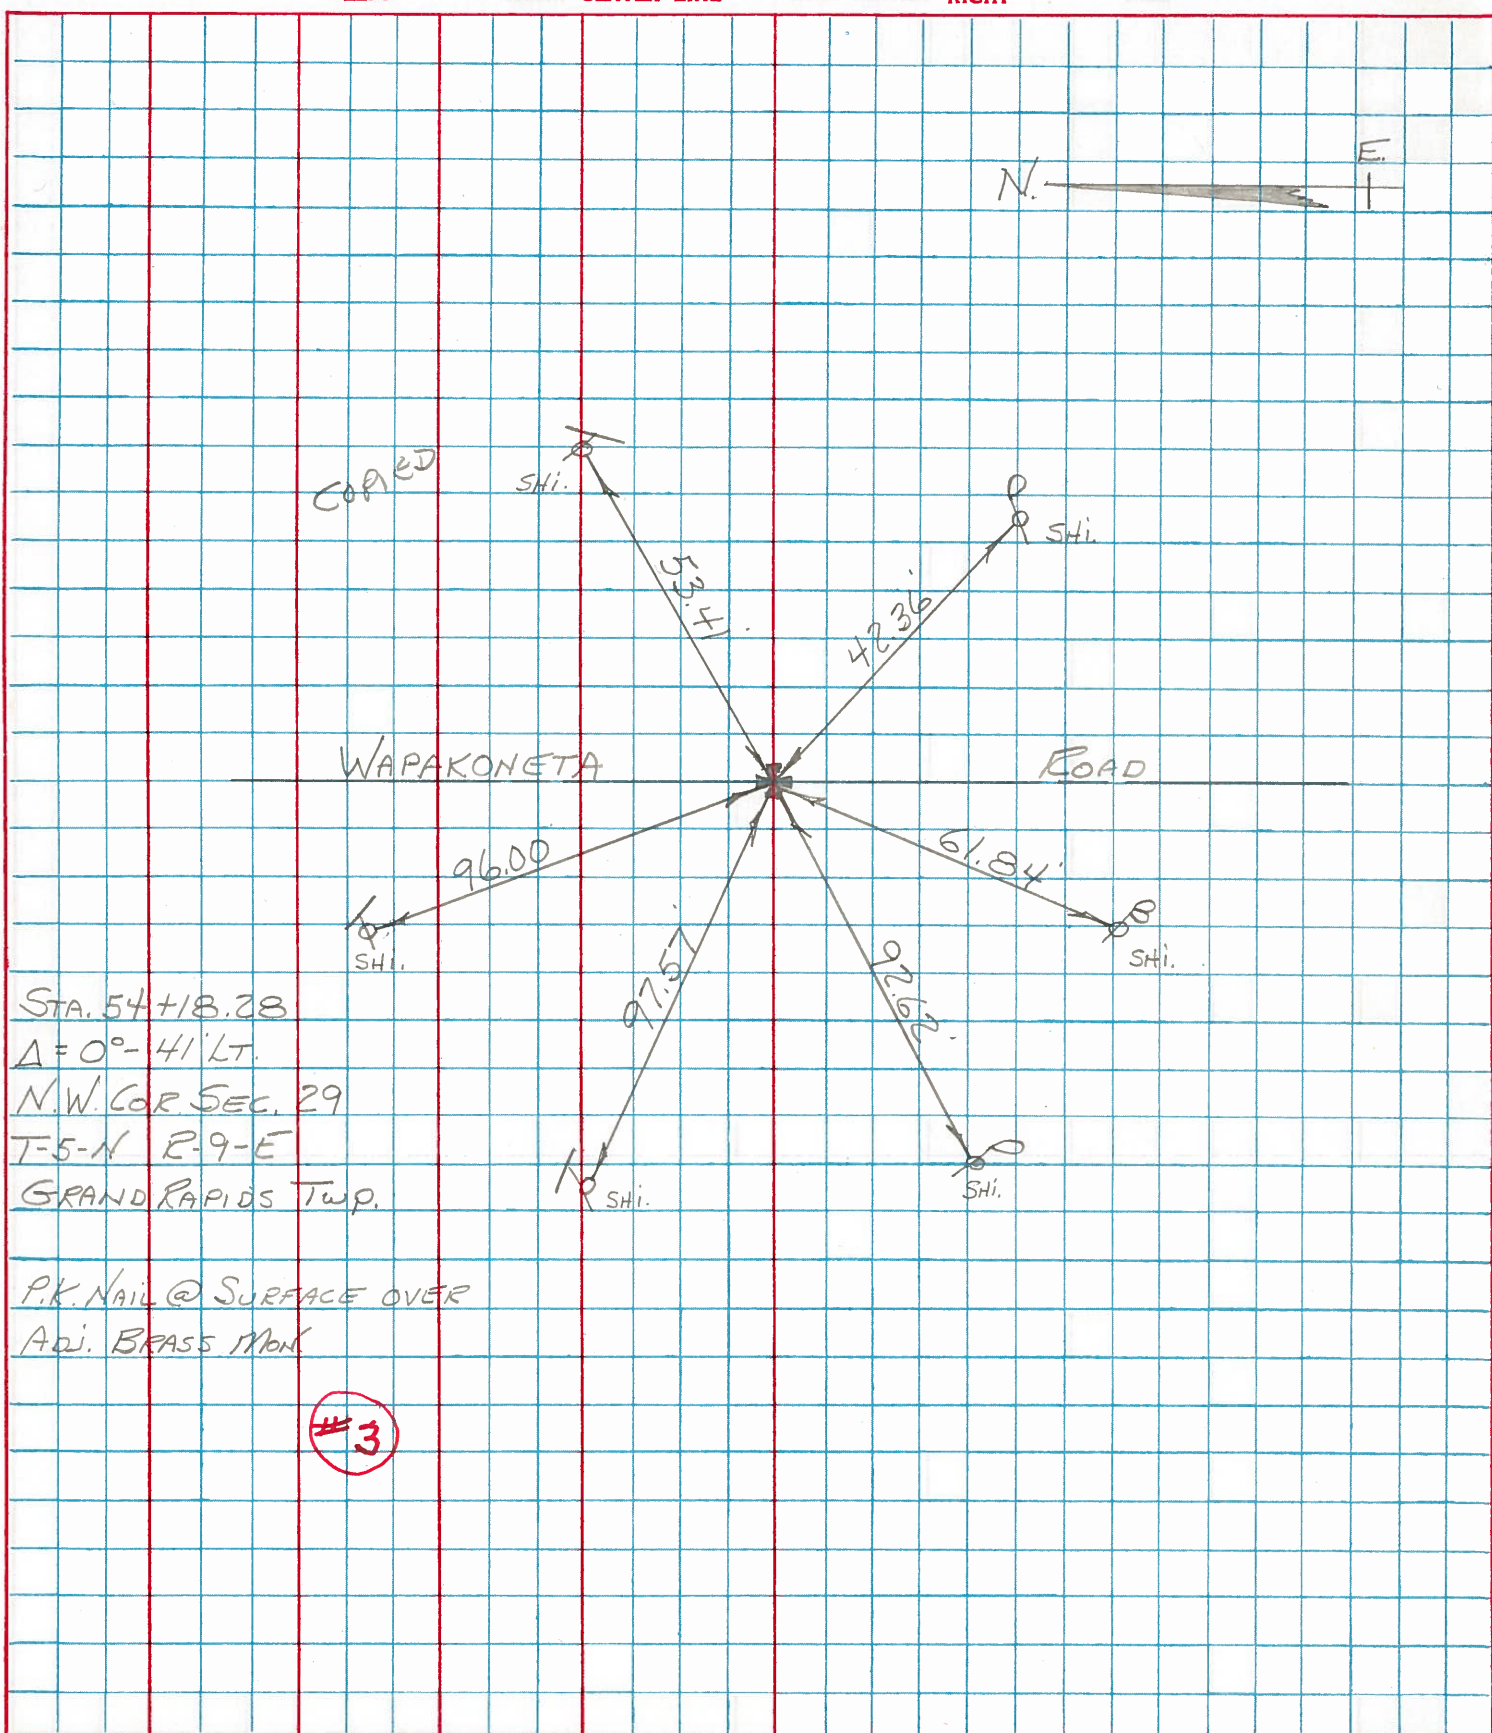



PERSONNEL Morrison TITLE \_\_\_\_\_ PERSONNEL Smith TITLE \_\_\_\_\_ COUNTY Wood DATE FEB, 5, 1968  
 PERSONNEL Bowers TITLE \_\_\_\_\_ PERSONNEL Burnsidas TITLE \_\_\_\_\_ S. R. US#6 WEATHER Clear  
 PERSONNEL Halcombe TITLE \_\_\_\_\_ PERSONNEL \_\_\_\_\_ TITLE \_\_\_\_\_ SEC. \_\_\_\_\_ TEMP. 40°  
 PERSONNEL Kern TITLE \_\_\_\_\_ PERSONNEL \_\_\_\_\_ TITLE \_\_\_\_\_

DESCRIPTION Control points from Wood-Henry Co line East JOB NO. \_\_\_\_\_

