

PERSONNEL TITLE PERSONNEL TITLE

COUNTY Wood DATE ok 4-3-58

S.R. U.S.#6 WEATHER 10-28-60

SEC. TEMP.


DESCRIPTION Bowling Green

JOB NO.

LEFT CENTER LINE RIGHT


Sta. 581+03  
P.I. Δ = 12°-15' Lt.

#783

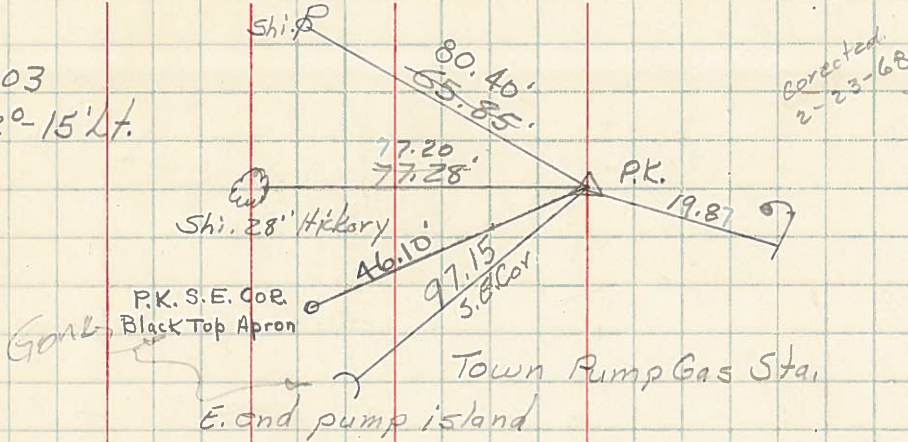


Sta. 587+49.58  
Bowling Green Corp.

Iron pin  
#784

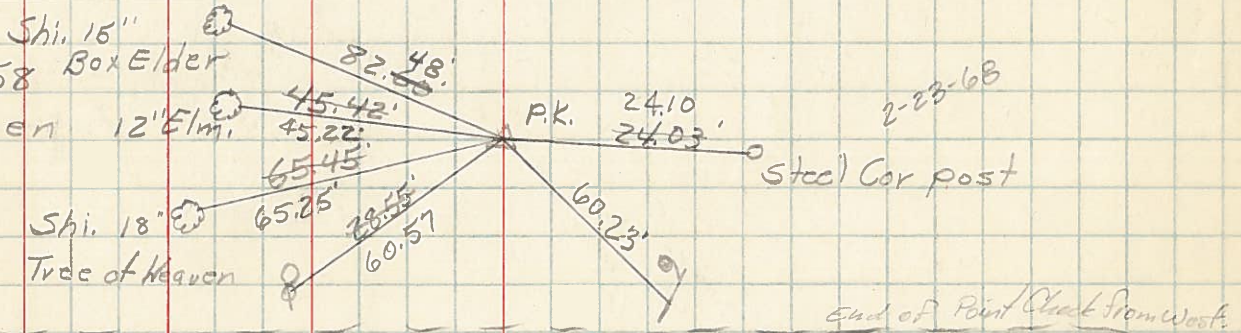


Sta. 587+85.04  
P.I. Δ = 11°-26' Lt.

Nail  
#785

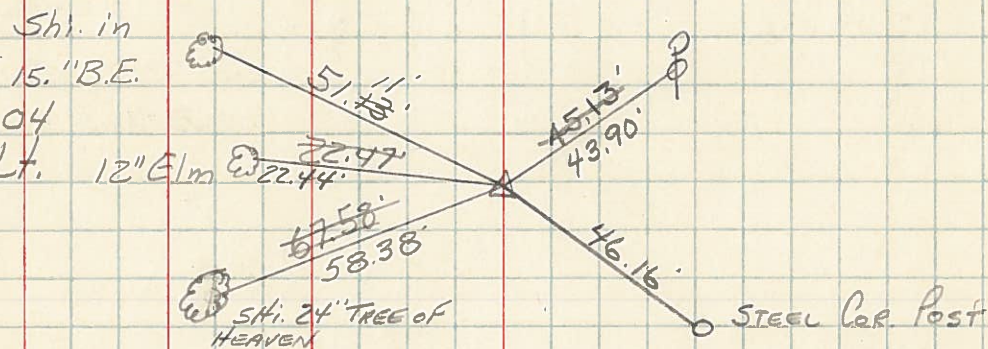

Sta. 592+89.12  
Found R.R. Spk. 12  
Lt. of Survey

#786

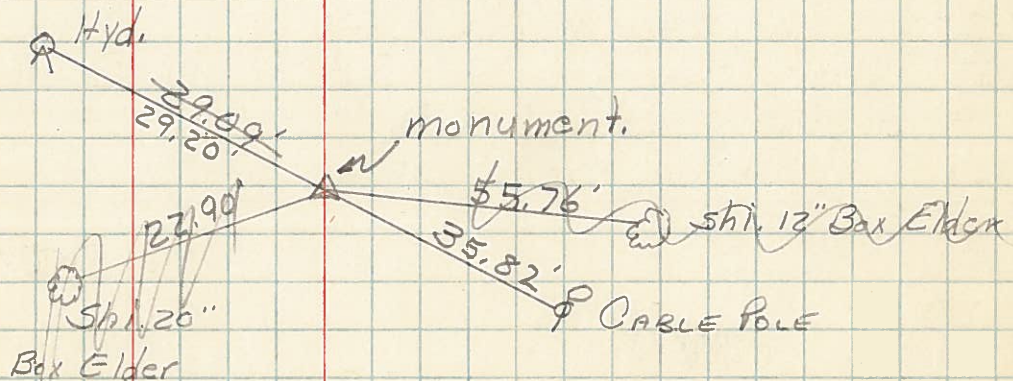

SEE SHEET B-A  
FOR