

PERSONNEL TITLE PERSONNEL TITLE

COUNTY Wood

DATE OK 4-3-58

S. R. U.S. #6

WEATHER

SEC.

TEMP.

DESCRIPTION


LEFT

CENTER LINE

RIGHT

JOB NO.


+78.30 fd E.P. Spike  
 Sta. 595+78.80  
 P.I. Δ = 5°57' E.  
 #787

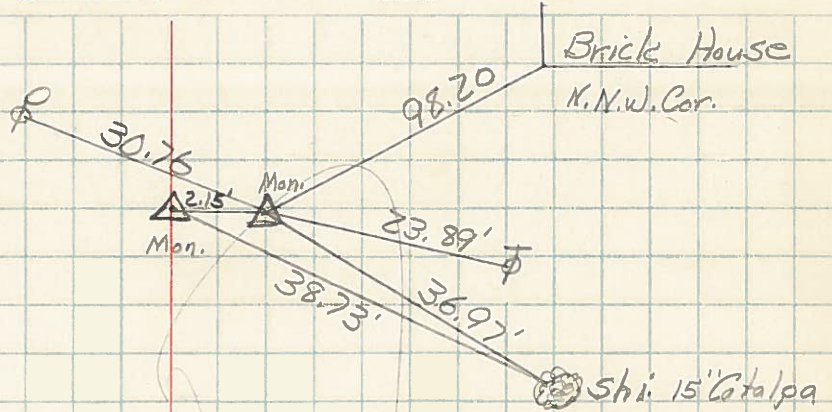

Sta. 601+21.20  
 P.I. Δ = 5°50' E.  
 #788



Sta. 601+48  
 Set E.P. Spike  
 #789

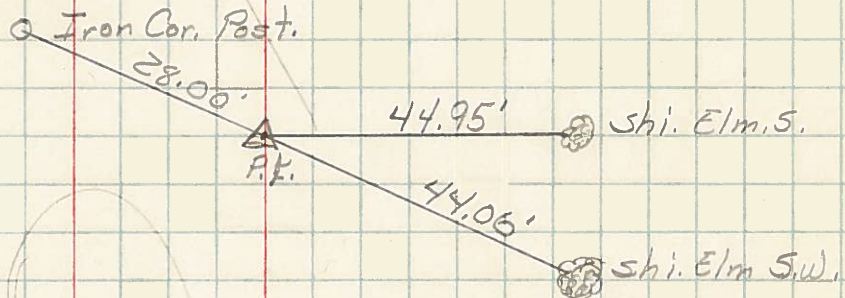

Sta. 601+58.25  
 Cor. Stone mt. set  
 #790

