

PERSONNEL TITLE PERSONNEL TITLE

COUNTY Wood

DATE OK 4-3-58

S.R. U.S.#6

WEATHER

SEC.

TEMP.

DESCRIPTION


LEFT

CENTER LINE


RIGHT

JOB NO.


Sta. 605+10.4
Mon. Set
792

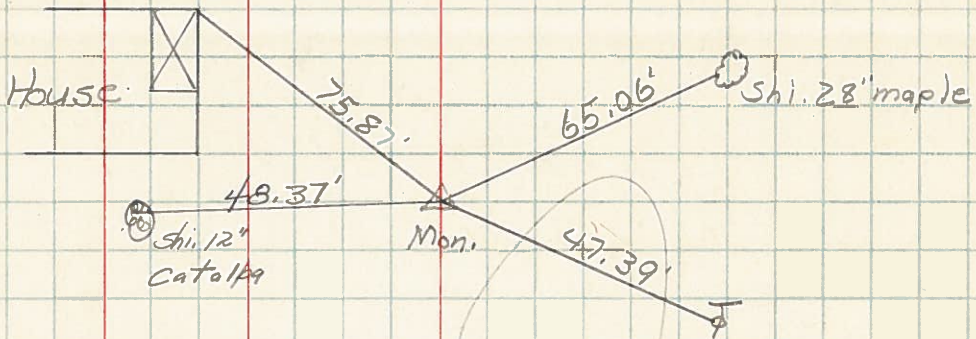

Sta. 605+06.70
P.I. Δ = 5° 46' Lt.
791

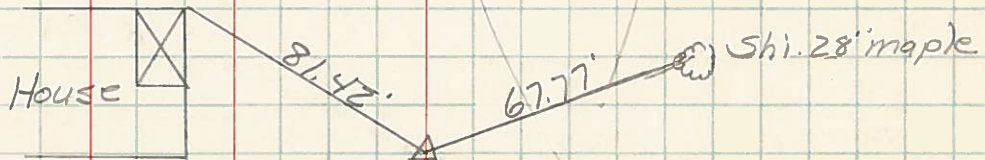

Sta. 610+78.47
Mon. Set
793

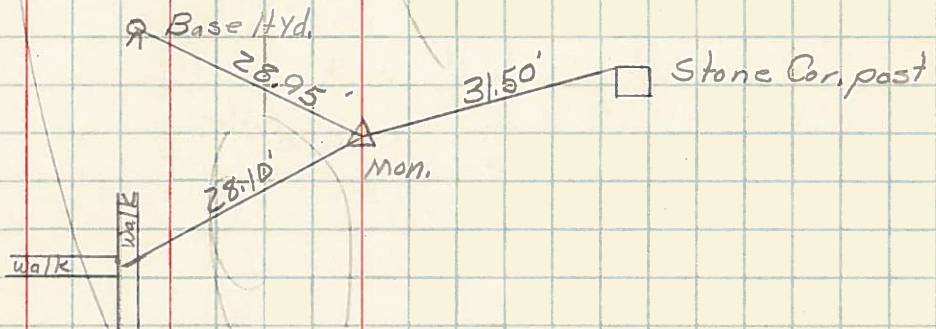

Sta. 611+30.4
Mon. set
794

