

PERSONNEL TITLE PERSONNEL TITLE



COUNTY Wood DATE 04-3-58

S. R. U.S.#6 & SE#64 WEATHER

SEC. TEMP.

DESCRIPTION Intersection W. Wooster & Has Kins St. JOB NO.

LEFT CENTER LINE RIGHT

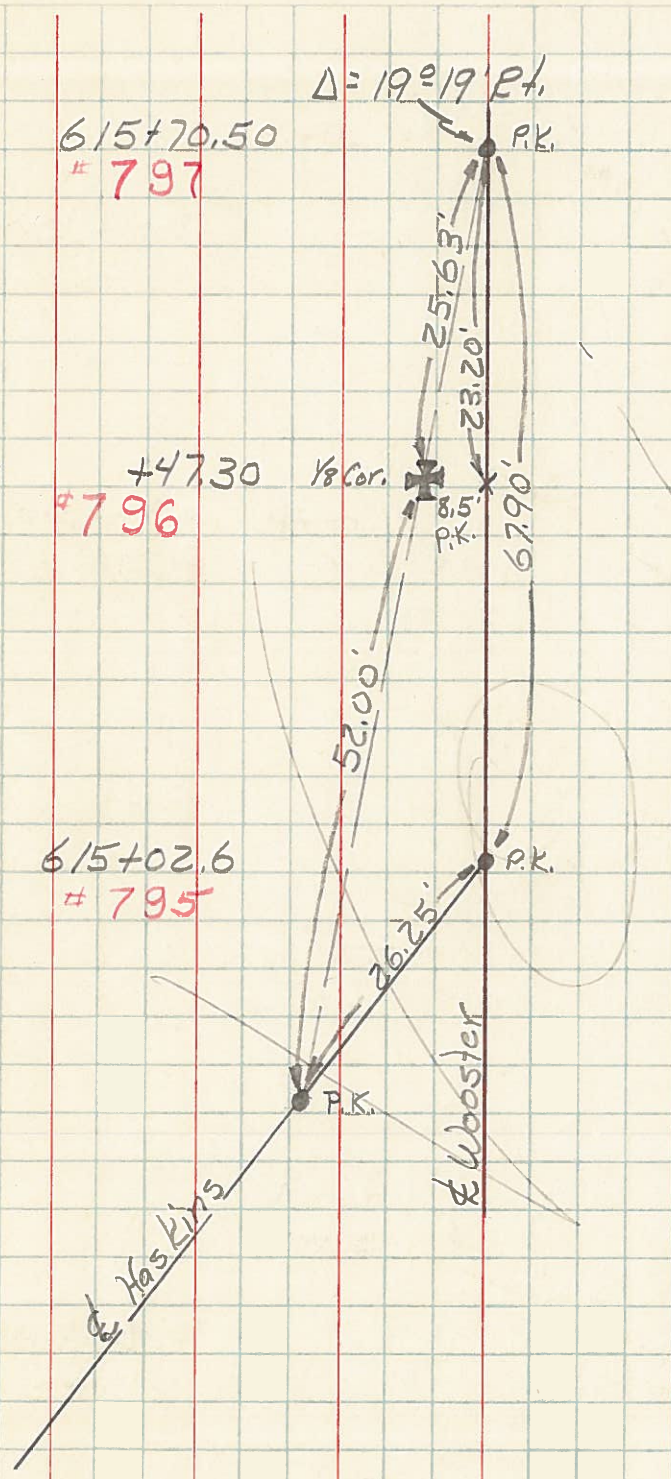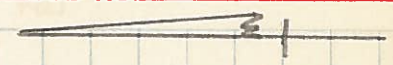

Sta. 615+70.50  
 37.59' N.E. to near edge Gas tap in Conc. Dr.  
 56.67' N.N.E. to S.W. Cor. stone step Rail to res. #714  
 34.00' N.W. to face fire Hyd.  
 31.40' int. st. walk & Res. #714 walk.

Ref for 1/8 Cor. +47.30  
 E. Wooster is 52'E. Has Kins st.  
 16.44' N. to X in Curb  
 62.10' N.E. to Fdn. Porch to house  
 69.16' N.W. to House Fdn.

W. Wooster & Has Kins  
 51.60' E.N.E. near edge Hyd. base  
 62.17' S.W. Cor. house fnd. N.E.  
 38.57' S.W. 28' maple N.W.

615+70.50 #797

+47.30 1/8 Cor. #796

615+02.6 #795