


O.D.O.T. DISTRICT 2 SURVEY OFFICE (USE ONLY)

PERSONNEL _____ REFERENCE NO. 19 B SHEET 2 OF 22

NOTES LOEHRKE DATE 4-29-92 ROUTE US 6
 H.C. CURTIS WEATHER RAIN COUNTY WOOD
 R.C. ROMETO TEMP. 50°F TOWNSHIP CENTER
 SECTION 33
 T 5 N R 11 E


TYPE MONUMENT MON BOX
 ON SURFACE - ~~BELOW~~ ON
 LEFT - ☉ PAV'T - ~~RIGHT~~ 21.97'
8' TO LT EDGE PAVEMENT
 S.L.M. 834+49.65

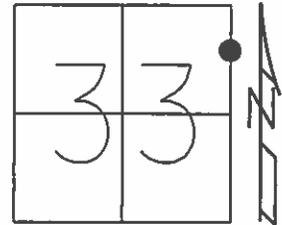

Grid: Northing: 615946.6617 Easting: 1668868.871

RECORD:
 MONUMENT BOX
 DESTROYED BY
 SNOWPLOW, MARCH 2001
 BOX REPLACED- RESET BY
 WOOD COUNTY GARAGE
 PIN CHECKED & IS OK
 9-25-02, MDB

FD CMON
 GPS, REFB19
 8-26-13 JLL

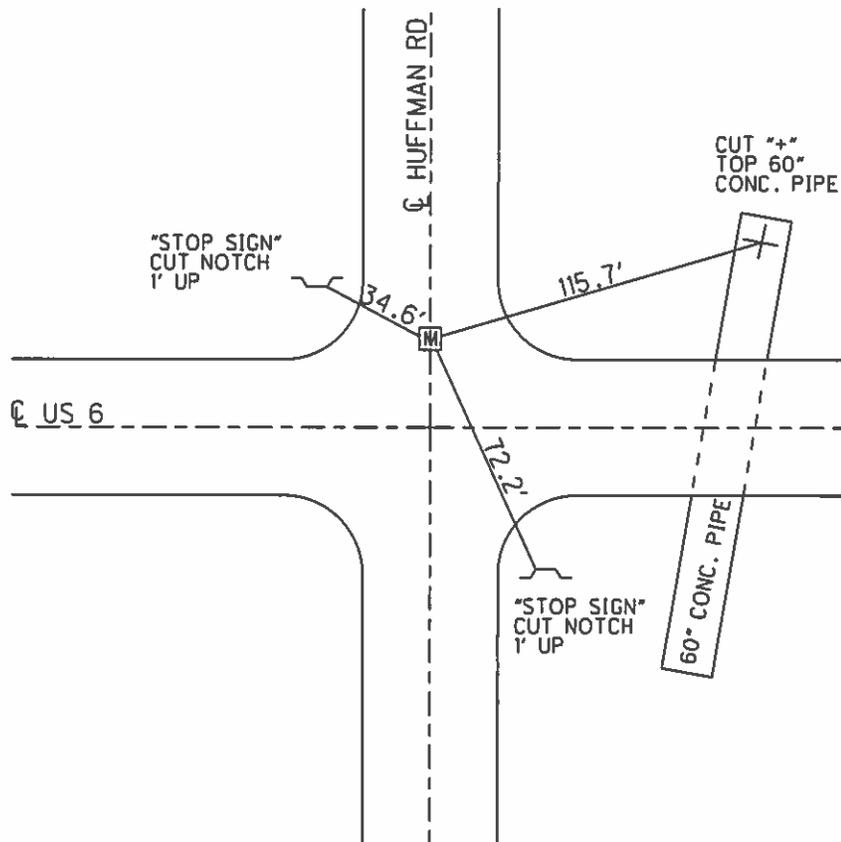

O.D.O.T. DISTRICT 2 SURVEY OFFICE

PERSONNEL _____

REFERENCE NO. _____

SHEET _____ OF _____

NOTES LOEHRKE

H.C. CURTIS

R.C. ROMETO

DATE 4-29-92

WEATHER RAIN

TEMP. +50

ROUTE U.S. 6

COUNTY WOOD

TOWNSHIP CENTER

SECTION 33

T S N R 11 E

TYPE MONUMENT Mon Box


ON SURFACE - BELOW Yes

LEFT- & PAV'T. - RIGHT 20.5'

8 NOT EDGE PAVEMENT

S.L.M. 834+55

19-B

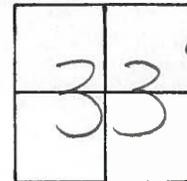

NOTE:

MONUMENT BOX DESTROYED BY
STAMPED MARCH 2001
BOX REPLACED - RE-SET BY WOOD CO.
GEORGE. PIN CHECKED \neq IS O.K.
MDS
9-25-02

Notch 1' up
Stop Sign
Post

CUT "4"
TOP 60"
CONC. PIPE

