

O.D.O.T. DISTRICT 2 SURVEY OFFICE (USE ONLY)

PERSONNEL

REFERENCE NO. 28 C

SHEET 33 OF 34

NOTES LEU
 H.C. LEU
 R.C. MILLER

DATE 9/12/18
 WEATHER CLOUDY
 TEMP. 65°

ROUTE US 6
 COUNTY WOOD
 TOWNSHIP FREEDOM
 SECTION 29
 T 5 N R 12 E

DWG BY NIESE PID 101242

TYPE MONUMENT MAG/WASHER

ON SURFACE - ~~BELOW~~ ON

OFFSET $\text{\textcircled{C}}$ PAVEMENT 0.4' LT : ~~RT~~
11.7' TO LT EDGE PAVEMENT


STATION: 1108+80

HORZ. DATUM: NAD83 2011


GEOID: NAVD88 2012A

GRID: NORTHING: 616712.856

EASTING: 1694505.521

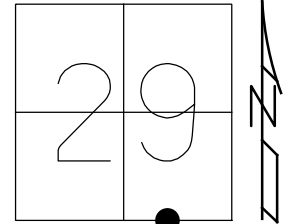

NOTE: REF 47 SR 199

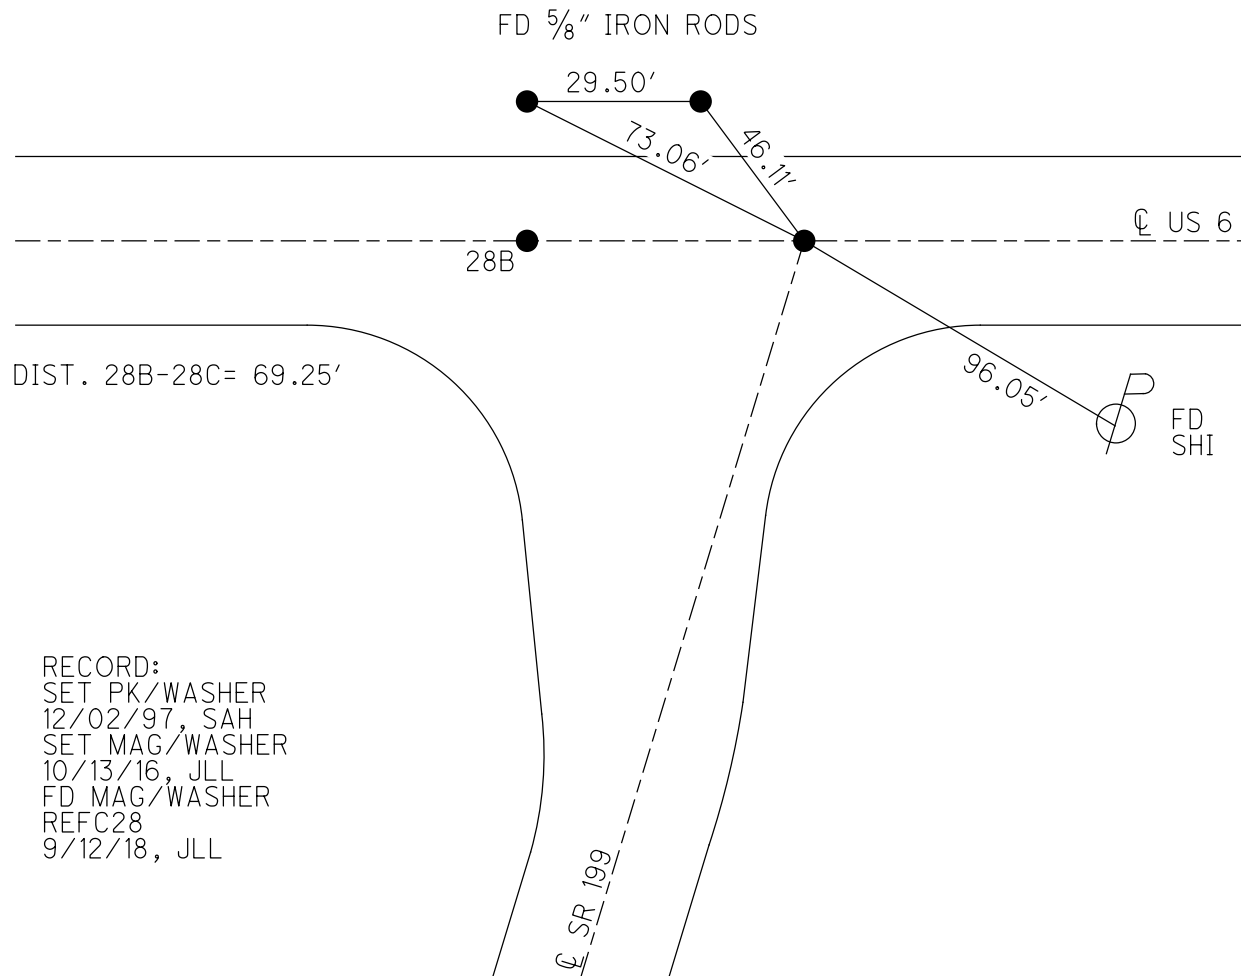


RECORD:
 SET PK/WASHER
 12/02/97, SAH
 SET MAG/WASHER
 10/13/16, JLL
 FD MAG/WASHER
 REFC28
 9/12/18, JLL

O.D.O.T. DISTRICT 2 SURVEY OFFICE (USE ONLY)

PERSONNEL _____ REFERENCE NO. 28 C SHEET 21 OF 22
 NOTES HUSS DATE 6-19-97 ROUTE US 6
 H.C. CORDES WEATHER CLOUDY COUNTY WOOD
 R.C. VAN DUSEN TEMP. 70°F TOWNSHIP FREEDOM
 _____ SECTION 29
 _____ T 5 N R 12 E


TYPE MONUMENT PK/WASHER
 ON SURFACE - ~~BELOW~~ ON _____
 LEFT - ☉ PAV'T - ~~RIGHT~~ 0.4'
11.7' TO LT EDGE PAVEMENT
 S.L.M. 1109+53.03

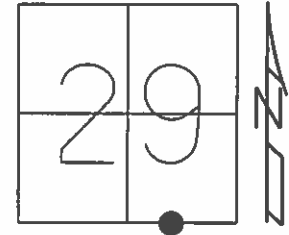

Grid: Northing: 616712.8154 Easting: 1694505.5891

RECORD:
 SET PK/WASHER
 12-2-97, SAH
 SET MAG/WASHER
 10-13-16, JLL

NOTE: DIST. BETWEEN REF 28B-REF 28C= 69.28'

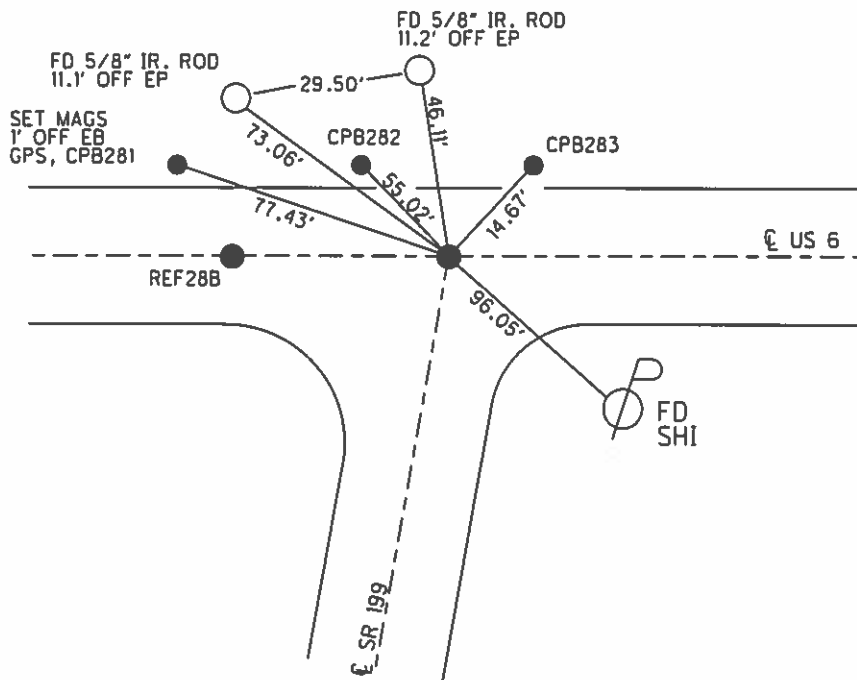

O.D.O.T. DISTRICT 2 SURVEY OFFICE (USE ONLY)

PERSONNEL

REFERENCE NO. 28 C

SHEET 2 OF 2

NOTES HUSS

DATE 06-19-97

ROUTE US6 & SR 199

H.C. CORDES

WEATHER CLOUDY

COUNTY WOOD

R.C. VAN DUSEN

TEMP. 70° F

TOWNSHIP FREEDOM

SECTION 29

T 5 N R 12 E

TYPE MONUMENT PK/WASHER


ON SURFACE - ~~BELOW~~ ON

LEFT - ☉ PAV'T - ~~RIGHT~~ 0.4'

11.7' TO LT. EDGE PAVEMENT


S.L.M. -

Grid: Northing: - Easting: -

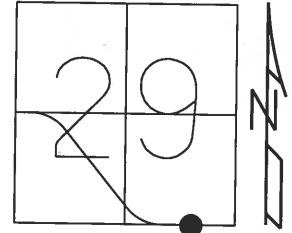

RECORD

12-02-97 SAH
SET PK/WASHER

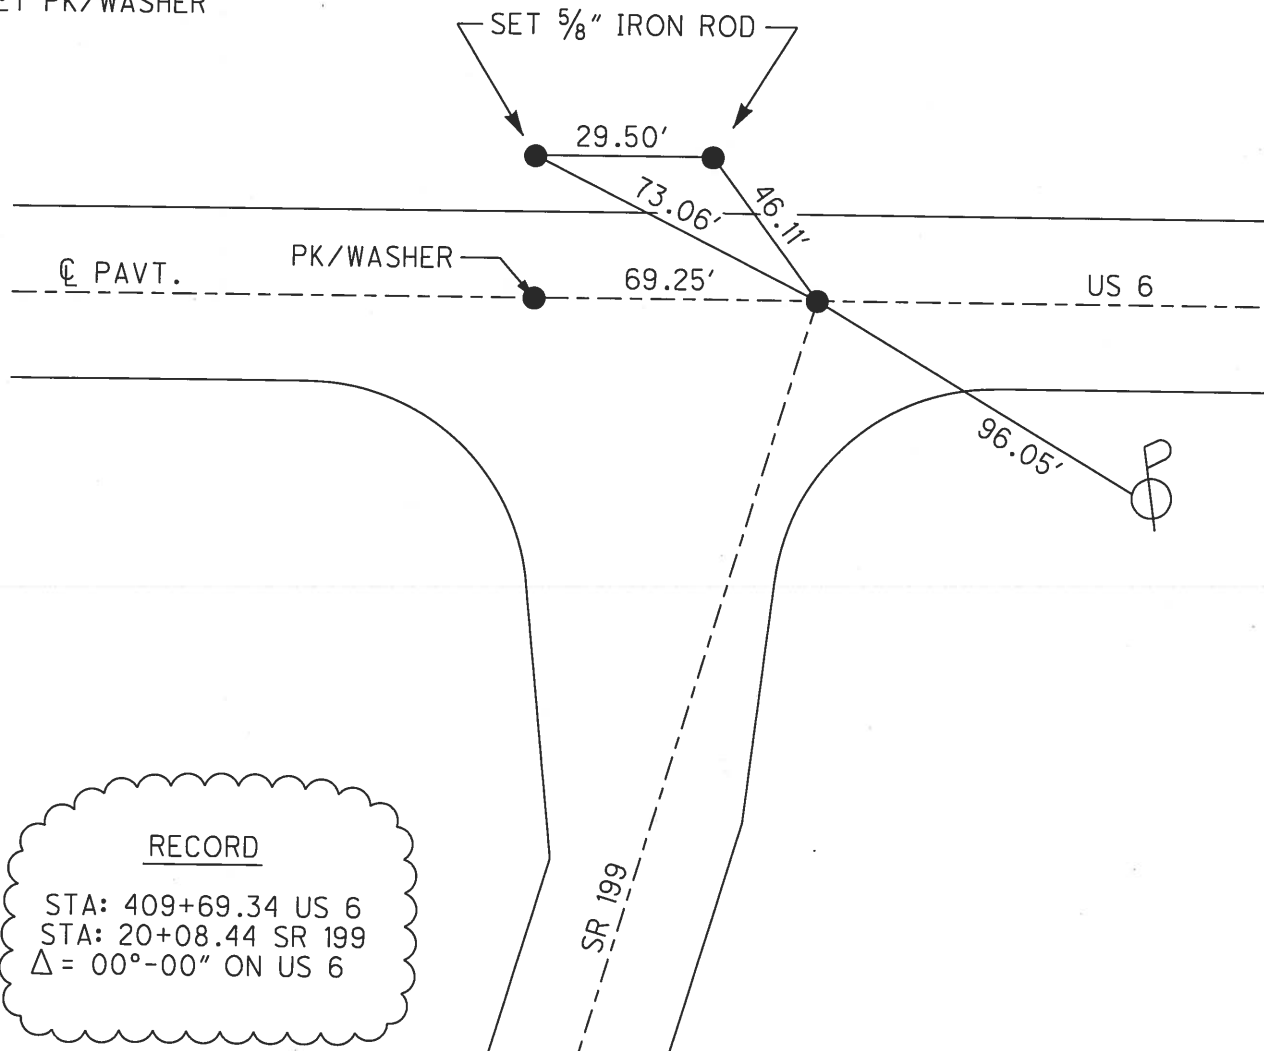

RECORD

STA: 409+69.34 US 6
STA: 20+08.44 SR 199
Δ = 00°-00" ON US 6

O.D.O.T. DISTRICT 2 SURVEY OFFICE

PERSONNEL

REFERENCE NO. 28B, 28C SHEET 15 OF 15

NOTES Huss

H.C. CORDES

R.C. VAN DUSEN

DATE 6-19-97

WEATHER Cloudy

TEMP. +70° F

ROUTE US 6 & SR 199

COUNTY WOOD

TOWNSHIP FREEDOM

SECTION 29

T. 5 N R. 12 E


TYPE MONUMENT PK^s WASHERS

ON SURFACE - BELOW YES


LEFT- & PAV'T. - RIGHT YES P.T. A P.T. B 0.4 LT. &

12.0 TO LT. EDGE PAVEMENT = P.T. A.

S.L.M. A = 33+849.14 B = 33+870.25 (Plan Sta) P.T. B = 11.7 LT 6095

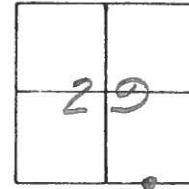

SET PK^s WASHERS
12-2-97
JAH

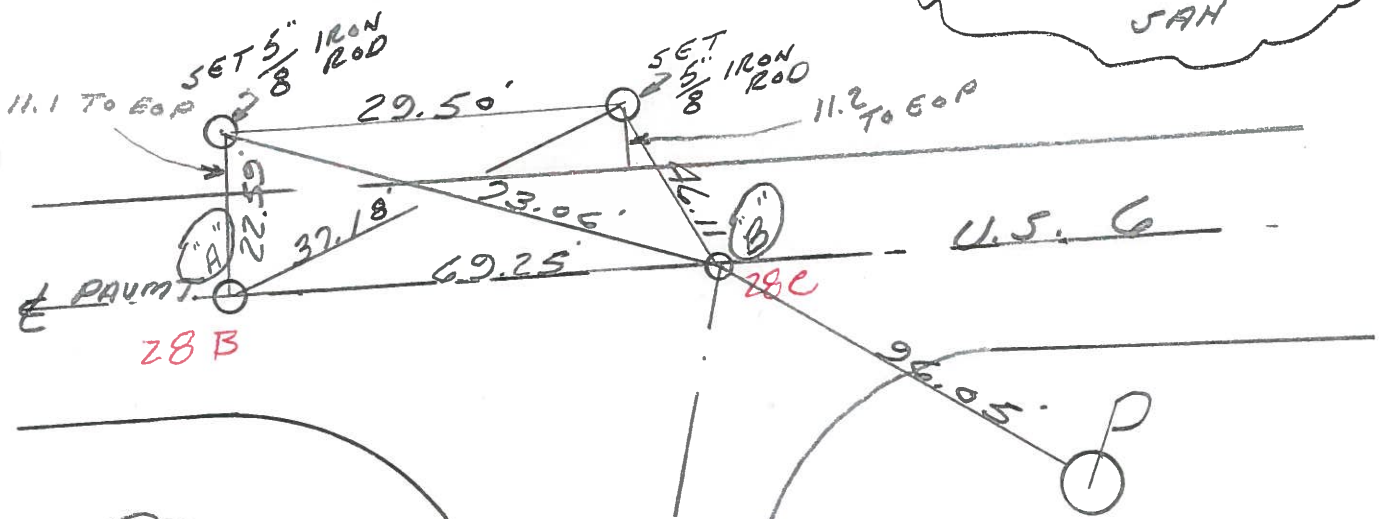

RECORD:
409+69.34 U.S. 6 =
20+08.44 S.R. 199 SOUTH
Δ = 0°-00" ON U.S. 6

S.R. 199

O.D.O.T. DISTRICT 2 SURVEY OFFICE

PERSONNEL

REFERENCE NO. 28-A

SHEET _____ OF _____

NOTES BARNHISEL

H.C. SOCKMAN

R.C. LOEHEKE

LUCE

DATE May 6, 1987

WEATHER SUNNY

TEMP. +65°

ROUTE U.S. 6 + S.R. 199

COUNTY WOOD

TOWNSHIP FREEDOM

SECTION 29

T. 5 N. R. 12 E


28-B

28-C

TYPE MONUMENT Both Sm RR Spk's

ON SURFACE - BELOW YES

LEFT - C PAV'T. - RIGHT Pt "A+B" 1/2 ± of 6 - Pt "B" on E 199

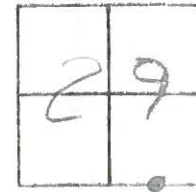

PT "A" 12.0 Lt
PT "B" 10.8 Lt


TO EDGE PAVEMENT

S.L.M. |||| +23 - (Pt. "B")

RECORD:

409+69.34 U.S. 6 =
20+08.44 SR 199 South.
Δ 0°-00' ON U.S. 6

*Set Sm RR Spk's
6-9-87
T.M.B.*

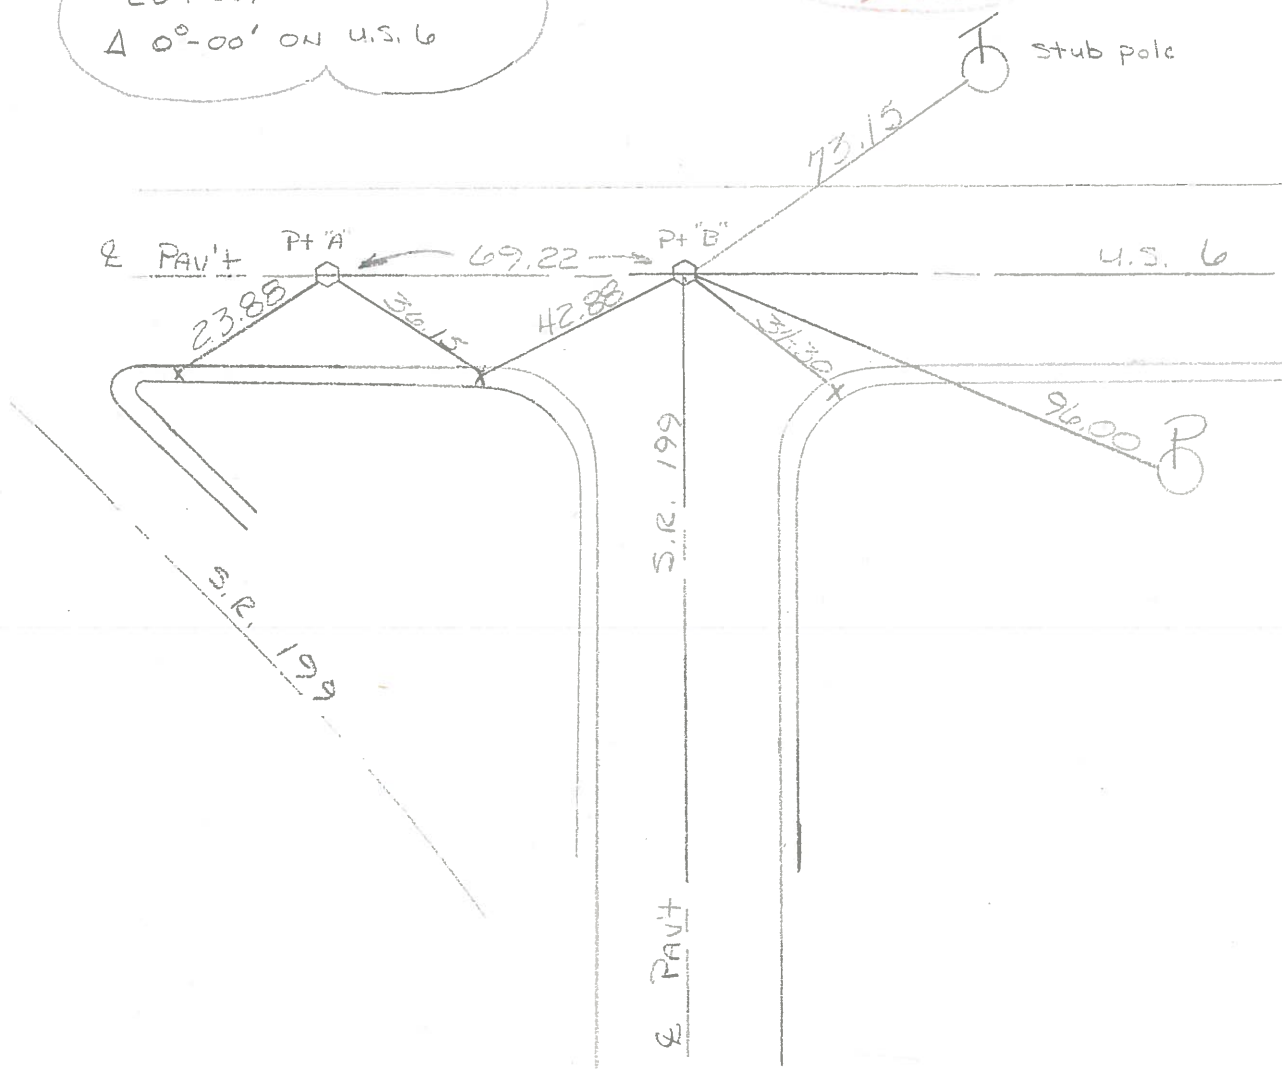

County WOOD ~~SR~~ US 6
Township FREEDOM
Section 29


Date 3-20-85
Weather CLEAR
Temp. 40°

TSN, R12E

Personnel Hoffman
LOEHRKE H.C.
BARNHISEL R.C.

28-B

28-C

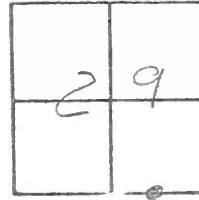


#28-A

"A" = Fd small R.R. spk @ surface
1.0' Lt of $\frac{1}{2}$ Pavt, US 6
12.0' to Lt. EP.

"B" = Fd small R.R. spk @ surface S.L.M. = 1111 + 51
1.0' Lt of $\frac{1}{2}$ Pavt, US 6
10.8' to Lt. EP.

RECORD!
409 + 69.24 U.S. 6 =
20 + 08.44 SR 199 SOUTH
 $\Delta = 00-00'$ on U.S. 6

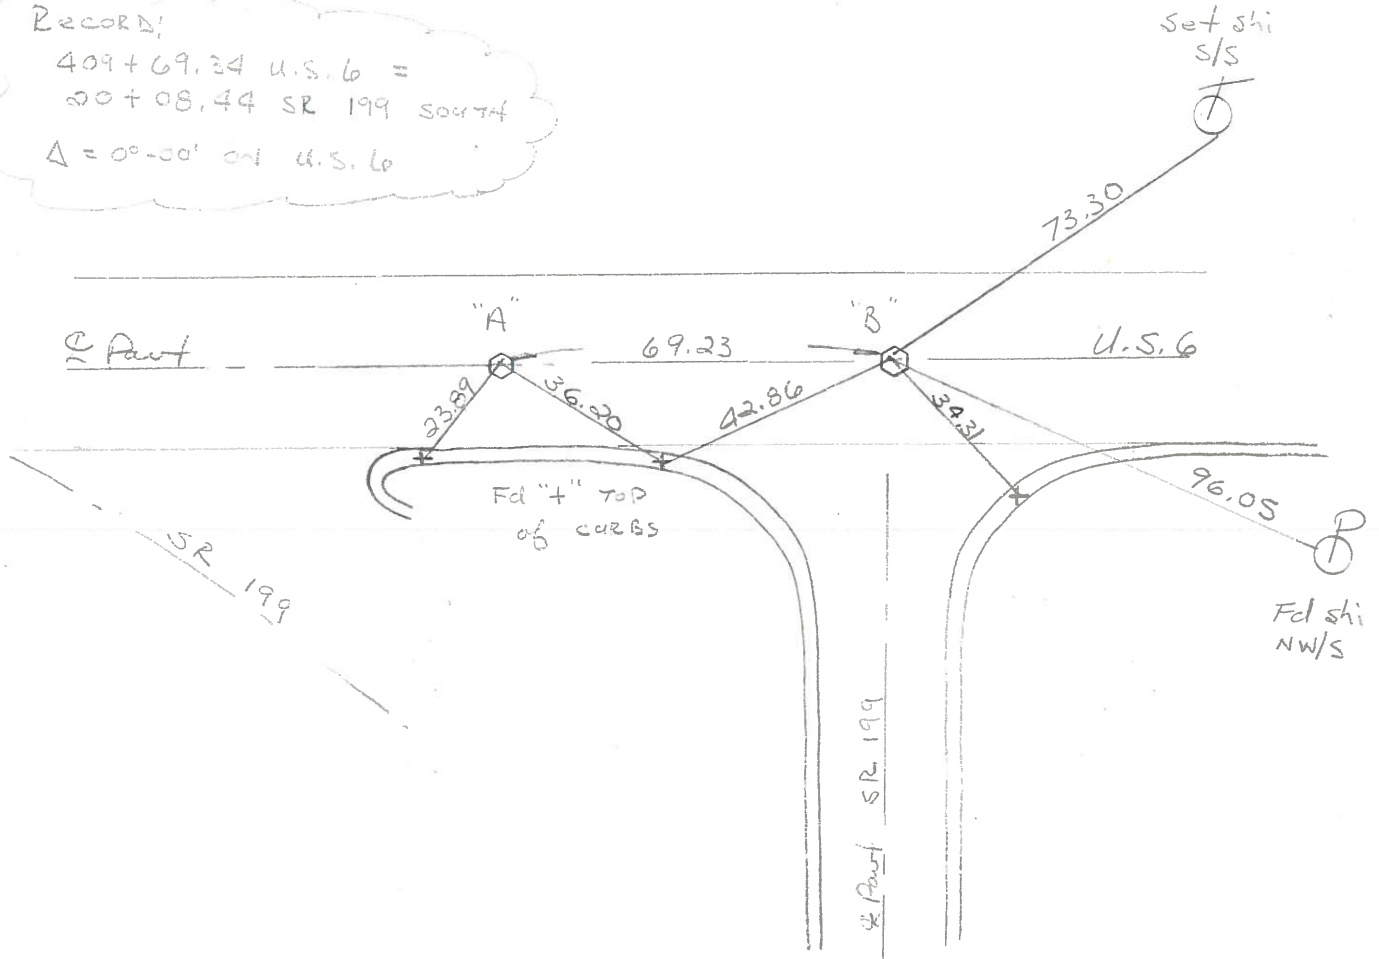

County WOOD U.S. 6

Date 5-25-72

Township FREEDOM

Weather CLEAR


Section 29

Temp. 78°

TSN, RIZE

Personnel BURNSIDE


SMITH

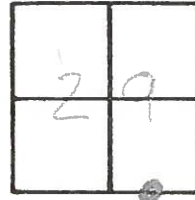

28-A

28-B


28-C

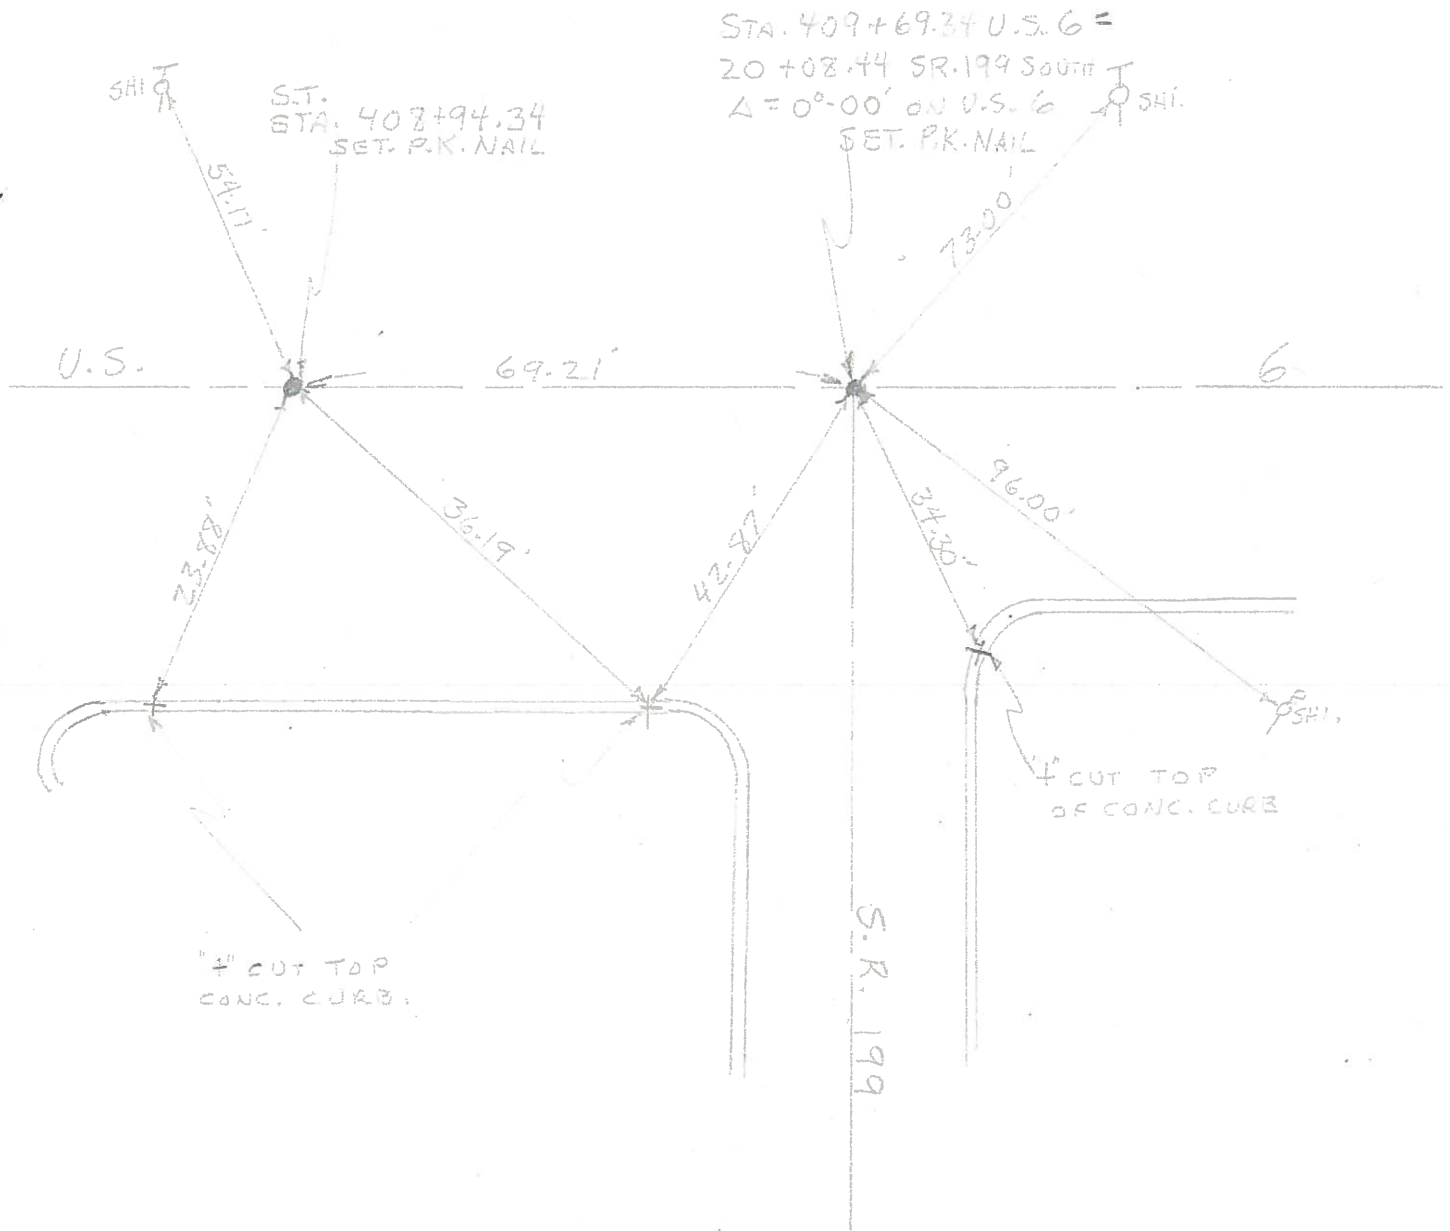


PERSONNEL	TITLE	PERSONNEL	TITLE
BURNSIDE			
SMITH			

COUNTY Wood DATE 5-25-72
 S. R. U.S. 6 & S.R. 199 WEATHER CLEAR
 SEC. _____ TEMP. +72°

DESCRIPTION BEGIN POINT CHECK - EAST - JOB NO. _____
 LEFT CENTER LINE RIGHT

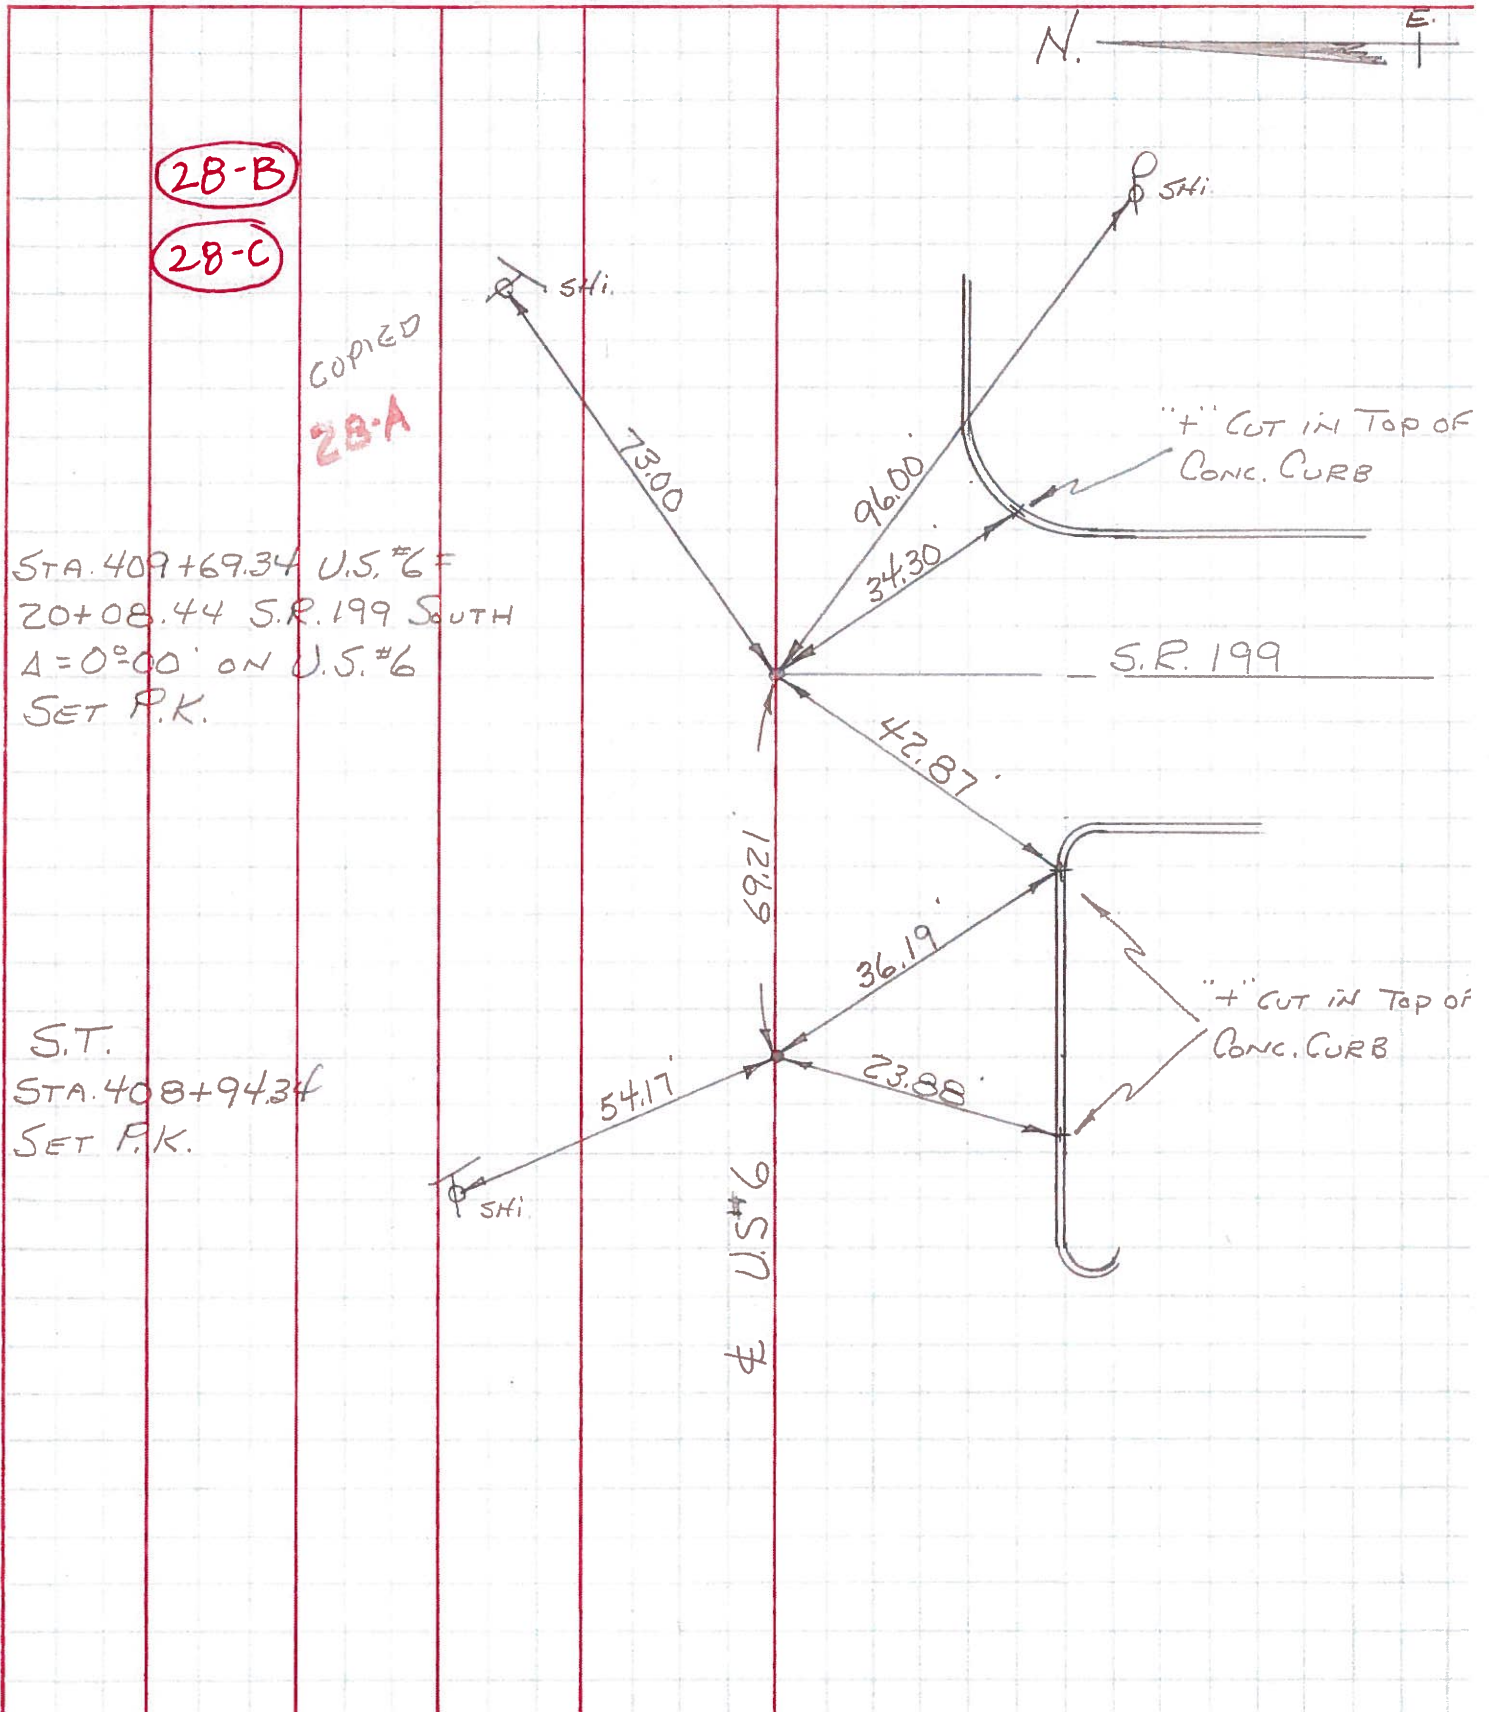

PERSONNEL TITLE PERSONNEL TITLE COUNTY Wood DATE May 15, 1968
Morrison _____ Bowers _____ S. R. 45#6 WEATHER Pt. Cloudy
Holcombe _____ SEC. _____ TEMP. 70°
Kern _____
 DESCRIPTION Ties to Control Points. JOB NO. _____

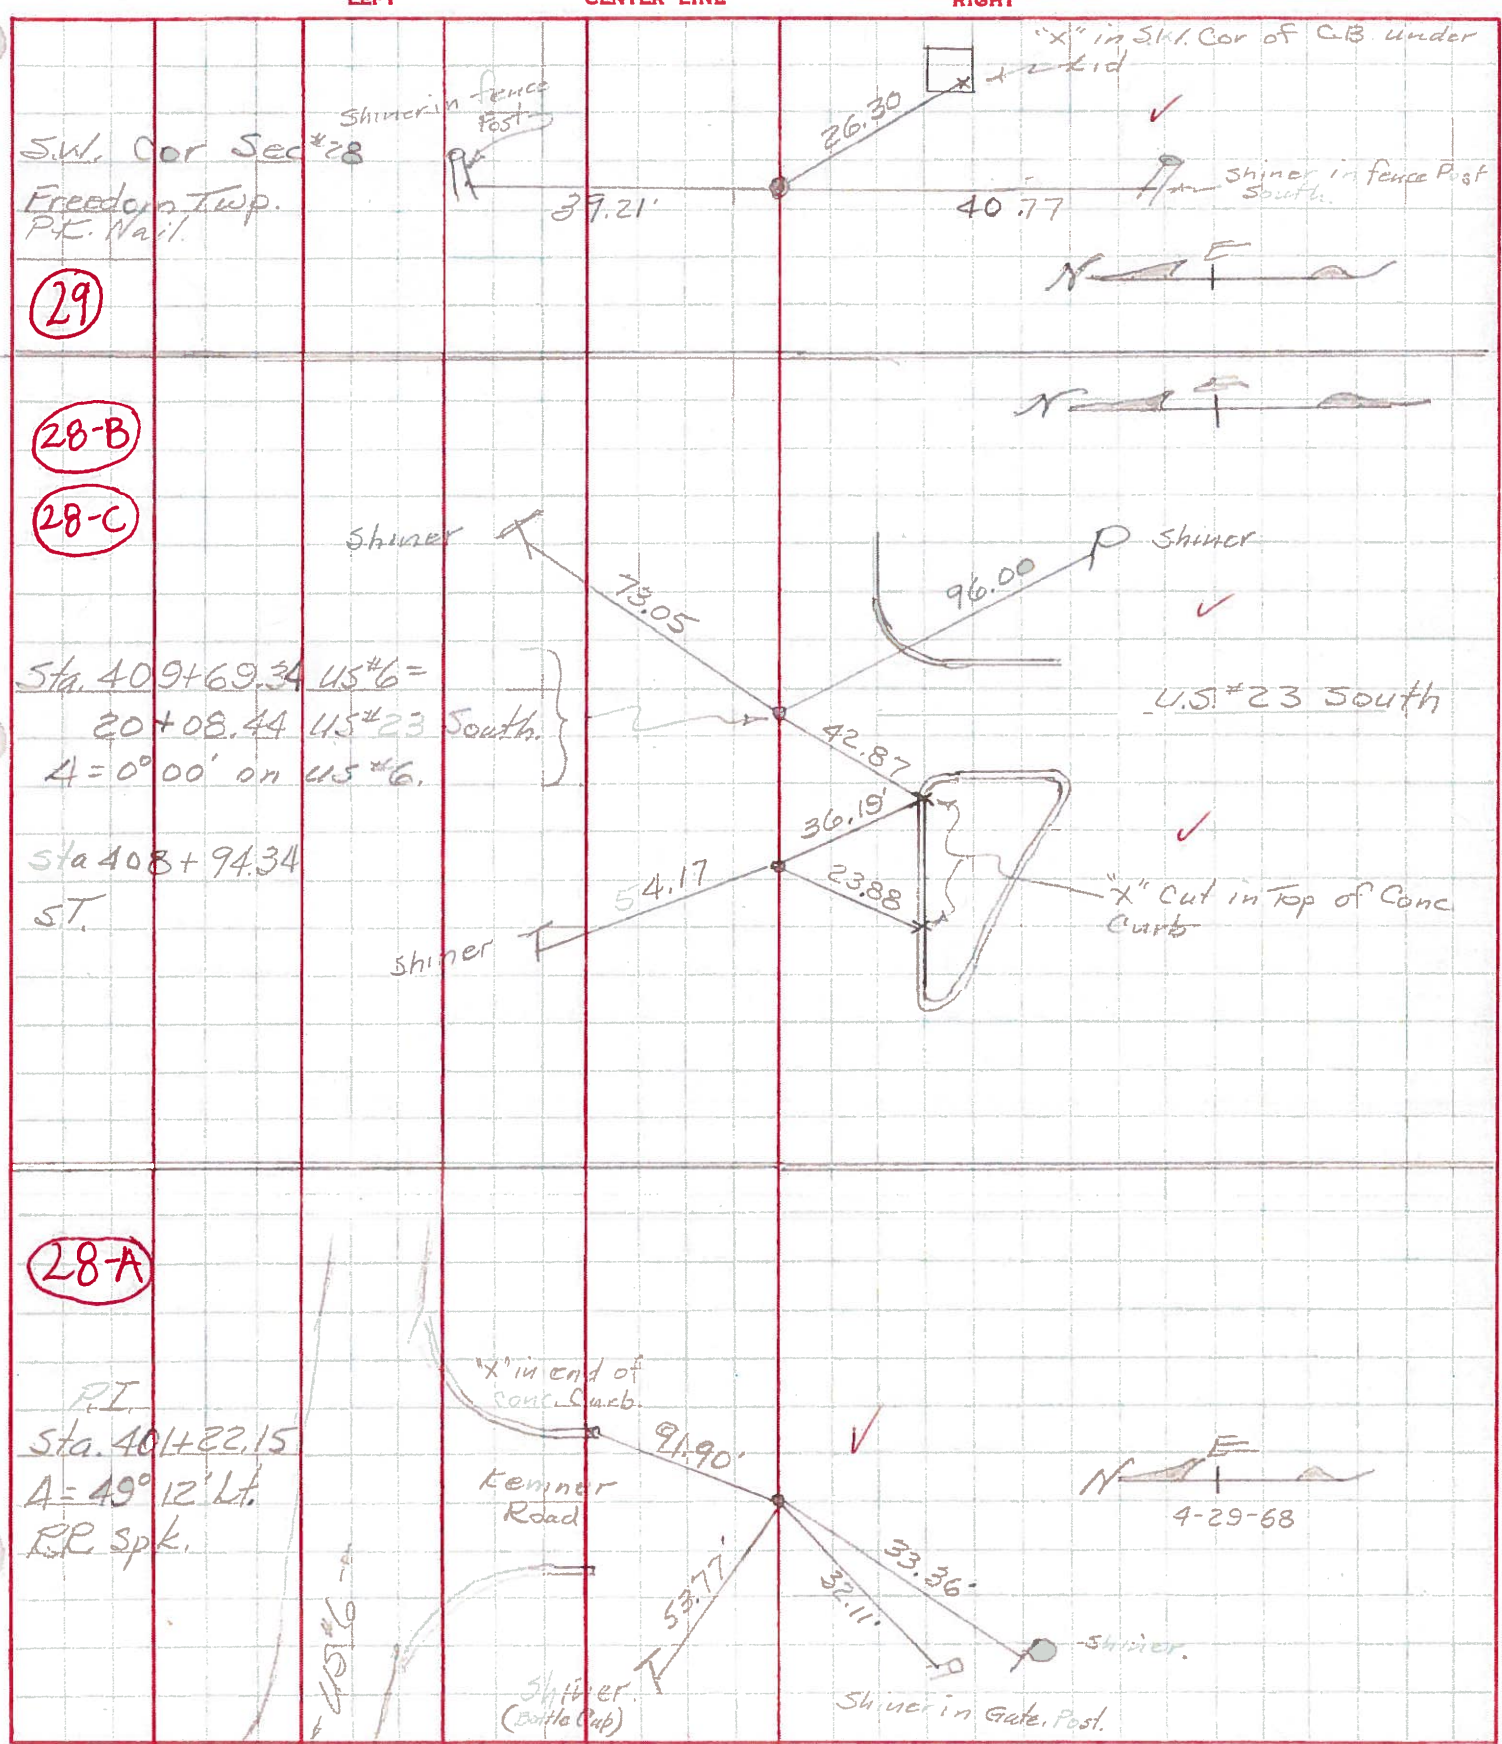

PERSONNEL TITLE PERSONNEL TITLE

COUNTY Wood

DATE 12-10-54

S.R. 4.5#6

WEATHER

SEC.

TEMP.

DESCRIPTION New Rochester Pt. #6 Relocation

JOB NO.

LEFT


CENTER LINE

RIGHT

Sta. 401+22.15
Δ = 49° 12' Lt.
R.P. Spike

4-29-1968


28-A

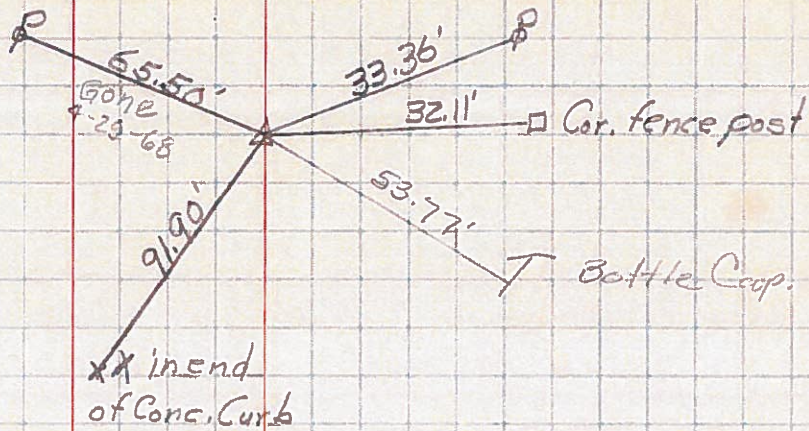

Sta. 408+94.34
S.T.

4-29-1968

28-B

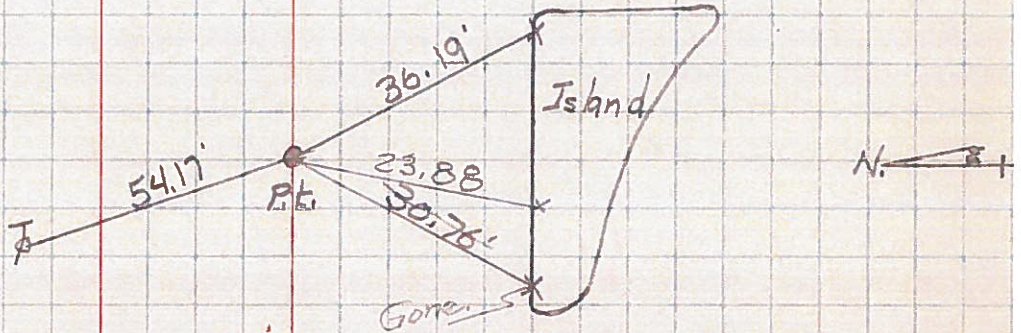

Sta. 409+69.34 U.S.#6
P.I. 20+08.44 U.S.#23
Δ = 0°-0'

28-C

