



O.D.O.T. DISTRICT 2 SURVEY OFFICE (USE ONLY)

PERSONNEL _____ REFERENCE NO. 32 SHEET 6 OF 14
 NOTES LEU DATE 9/12/18 ROUTE US 6
 H.C. LEU WEATHER CLOUDY COUNTY WOOD
 R.C. MILLER TEMP. 65° TOWNSHIP FREEDOM
 DWG BY NIESE PID 101242 SECTION 34
 T 5 N R 12 E


TYPE MONUMENT CALC POINT
 ON SURFACE - BELOW ON
 OFFSET \varnothing PAVEMENT - LT : RT
- TO - EDGE PAVEMENT
 STATION: 1178+77.93

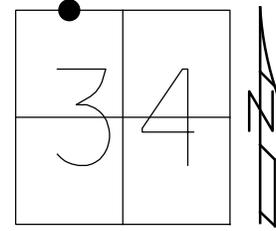

HORIZ.DATUM: NAD83 2011 GEOID: NAVD88 2012A
 GRID: NORTHING: 616792.799 EASTING: 1701502.948

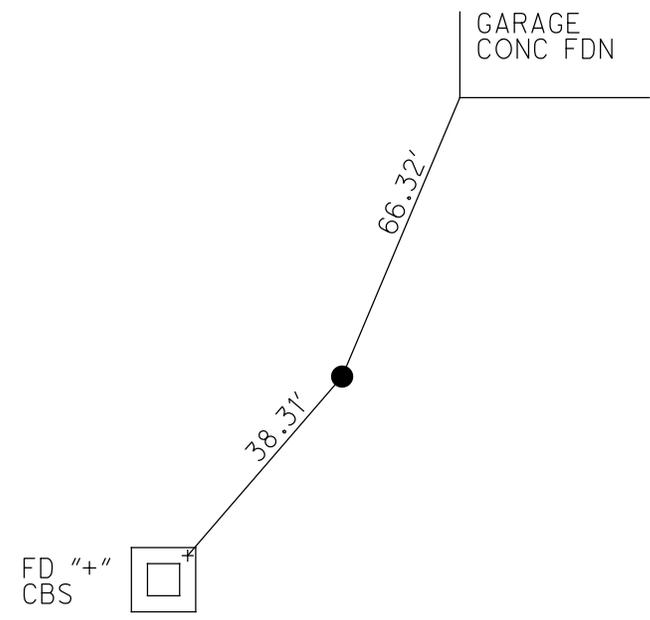

RECORD: P.I.
 STA 358+85.30
 $\Delta = 29^{\circ}43'$ RT
 $D = 2^{\circ}45'$
 $T = 552.75'$
 $L = 1080.61'$
 $E = 72.07'$
 $R = 2083.48'$
 D.N.F.
 3/20/85, SWH
 CALC POINT
 9/26/2018, JLL

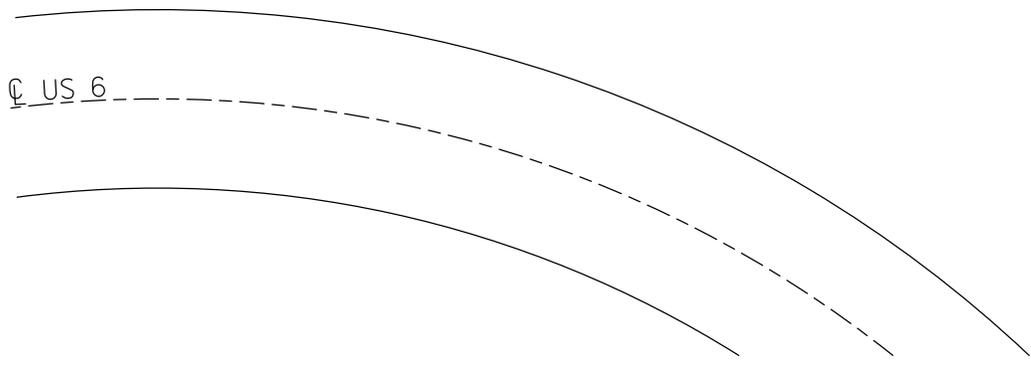

County WOOD U.S. 6

Date 6-20-1973

Township FREEDOM

Weather CLOUDY

Section 34

Temp. 80°


T5N, R12E

Personnel SMITH

BAWERS

KIOWSK

BAGDONAS

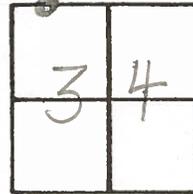

#32 P.I. STA 358+85.30 1ST P.I. E. OF WAYNE RD.

$\Delta = 29^{\circ}43'$ RT.


D = 20.45'

T = 552.75'


L = 1080.61'

E = 72.07'

R = 2083.48'

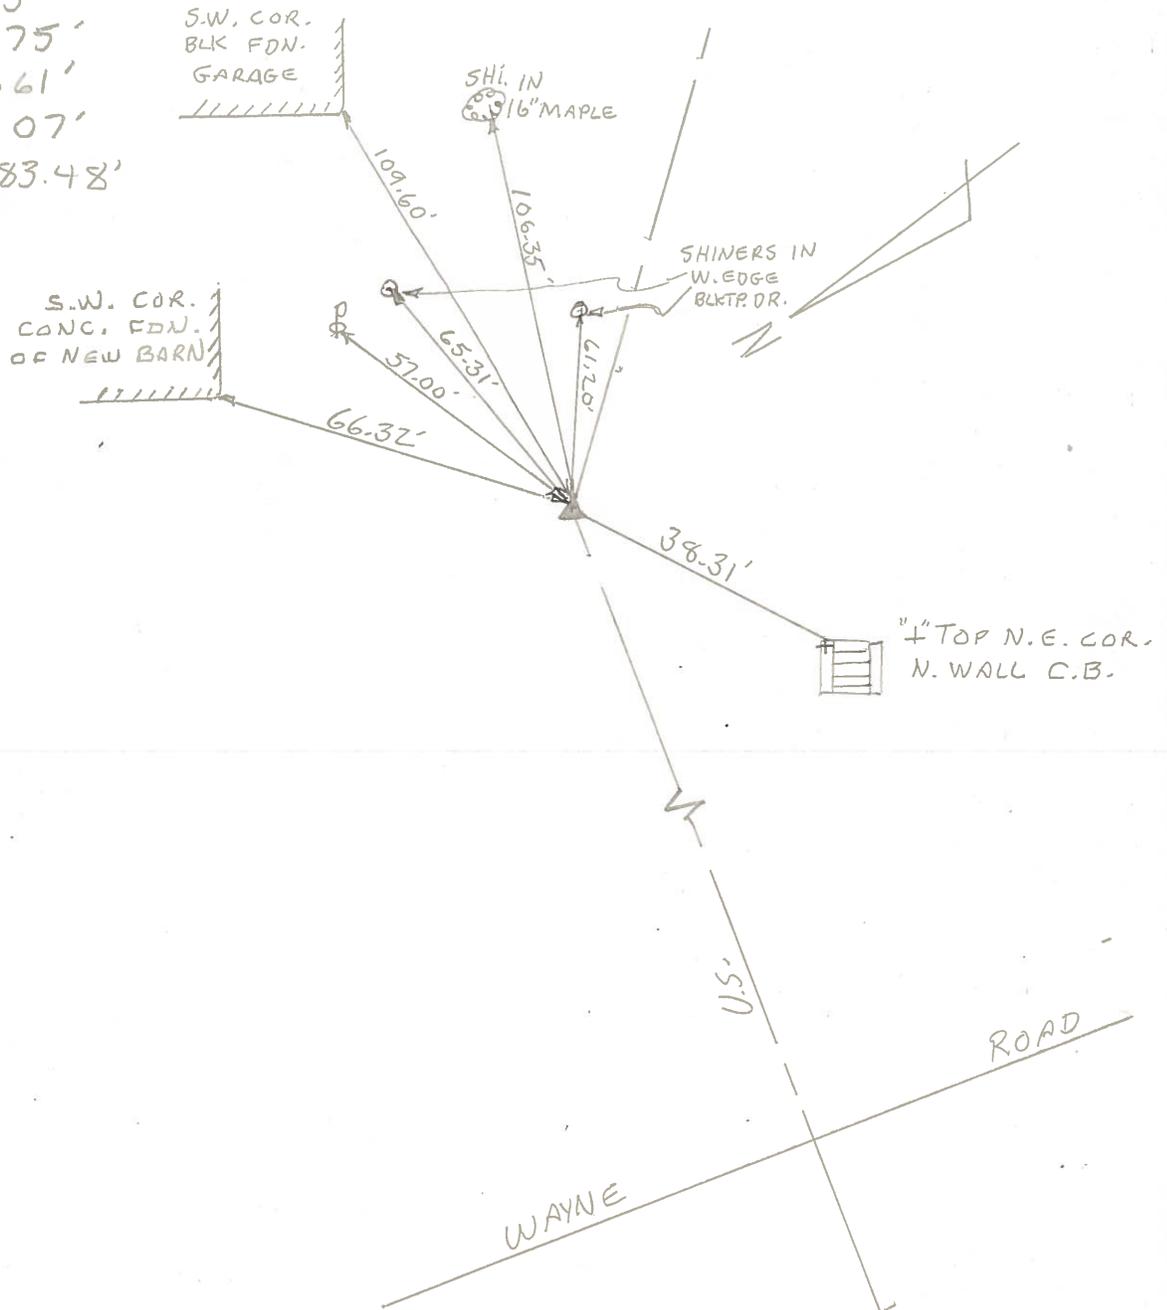

PERSONNEL	TITLE	PERSONNEL	TITLE	COUNTY	Wood	DATE	6-20-1973
Smith				S. R.	US 6	WEATHER	Cloudy-Warm
Bowers				SEC.		TEMP.	80°
Kijowski							
Bagdonas							
DESCRIPTION	1st P.I East of Wayne Road			JOB NO.			

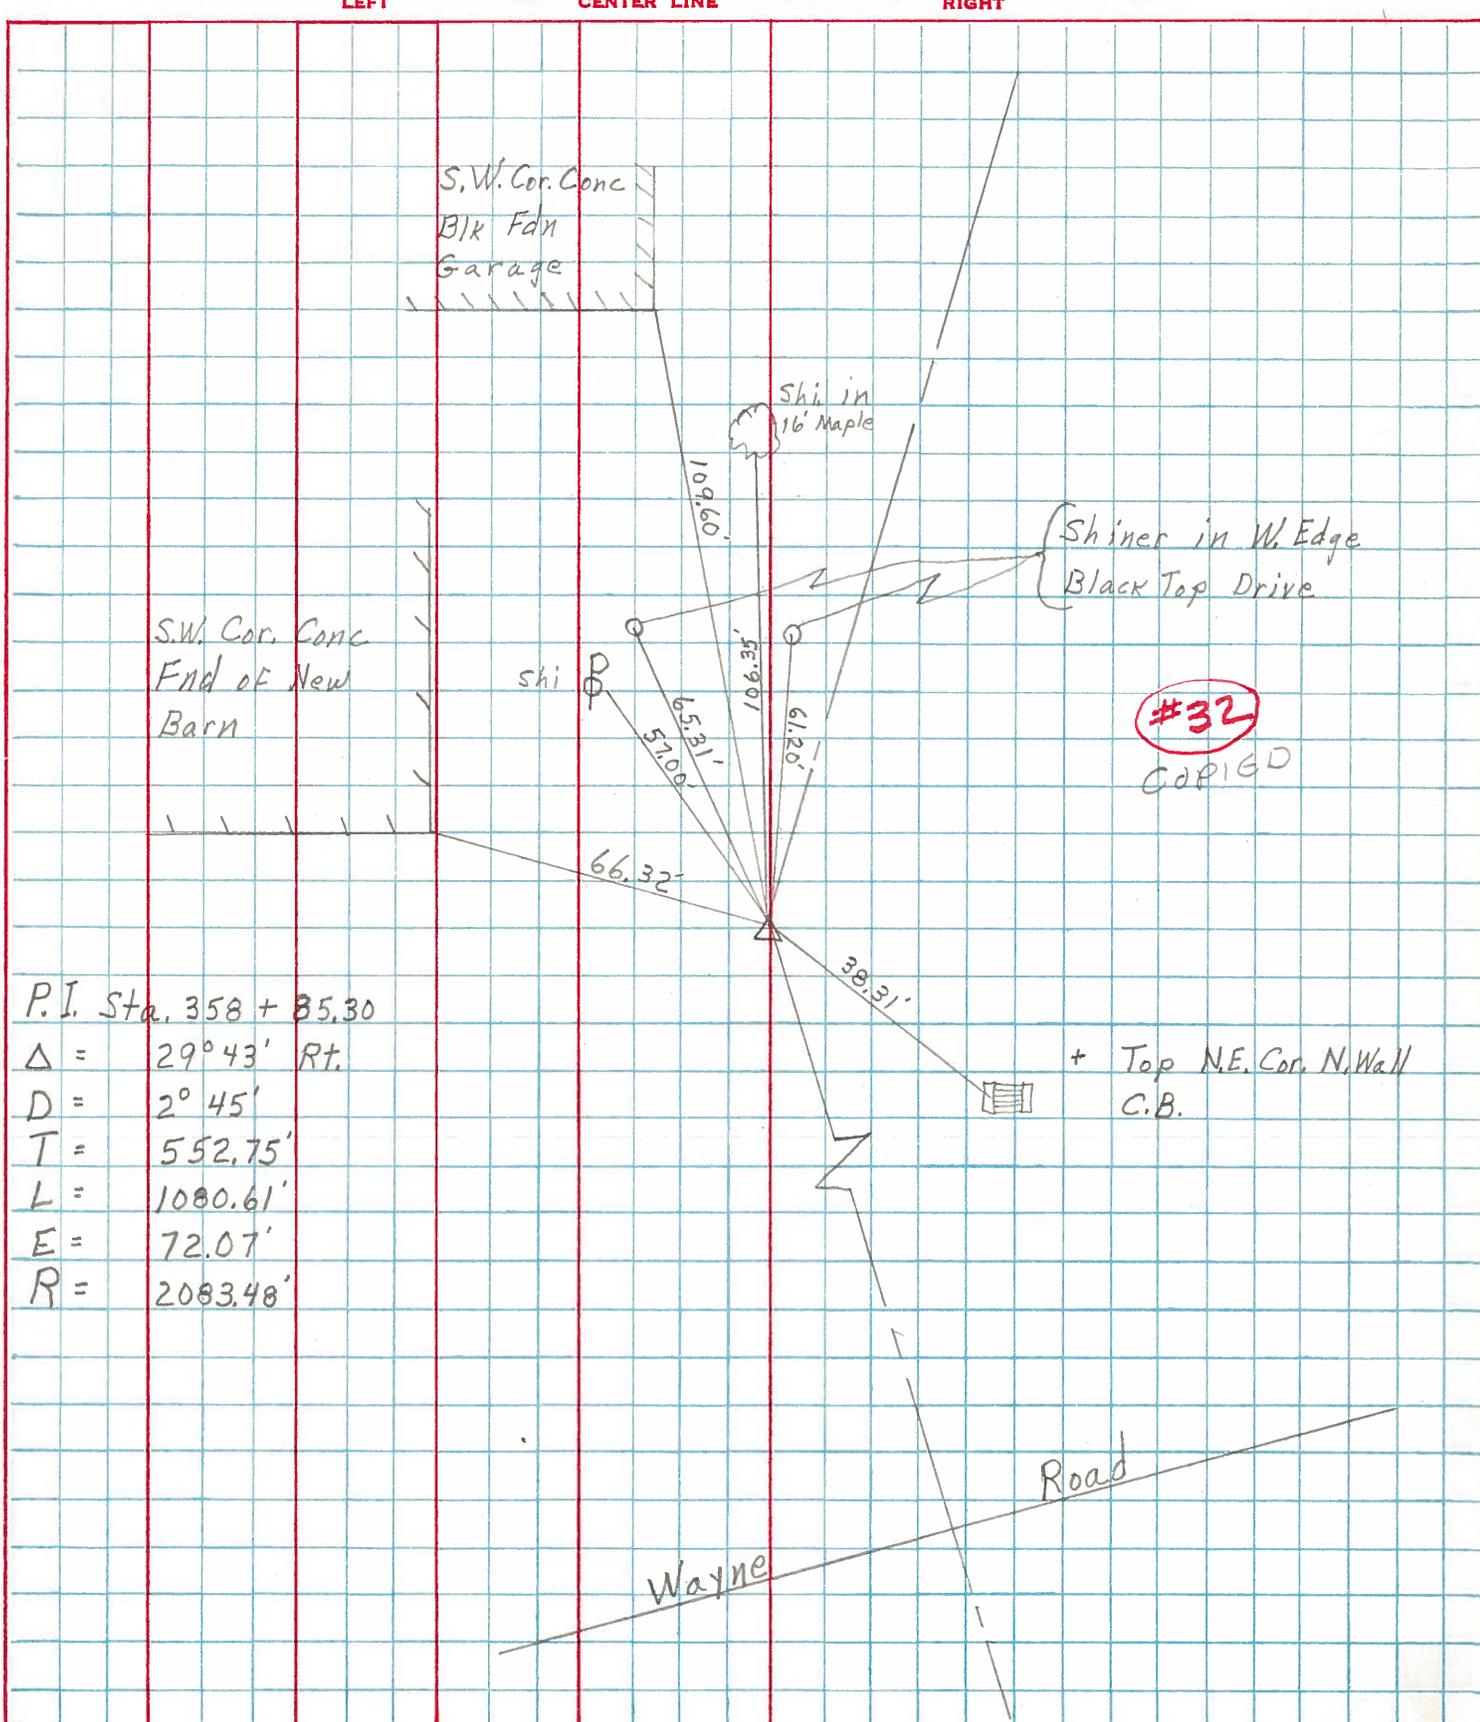


P.I. Sta. 358 + 85.30
 $\Delta = 29^{\circ}43'$ RT.
 $D = 2^{\circ}45'$
 $T = 552.75'$
 $L = 1080.61'$
 $E = 72.07'$
 $R = 2083.48'$

#32
COPIED

See Next Page

PERSONNEL	TITLE	PERSONNEL	TITLE	COUNTY	DATE	WEATHER	TEMP.
BURNSIDE				WOOD	5-17-72	CLEAR	+79°
SMITH				U.S. 6			
BOWERS							

DESCRIPTION 1st P.I. EAST OF WAYNE ROAD JOB NO. _____

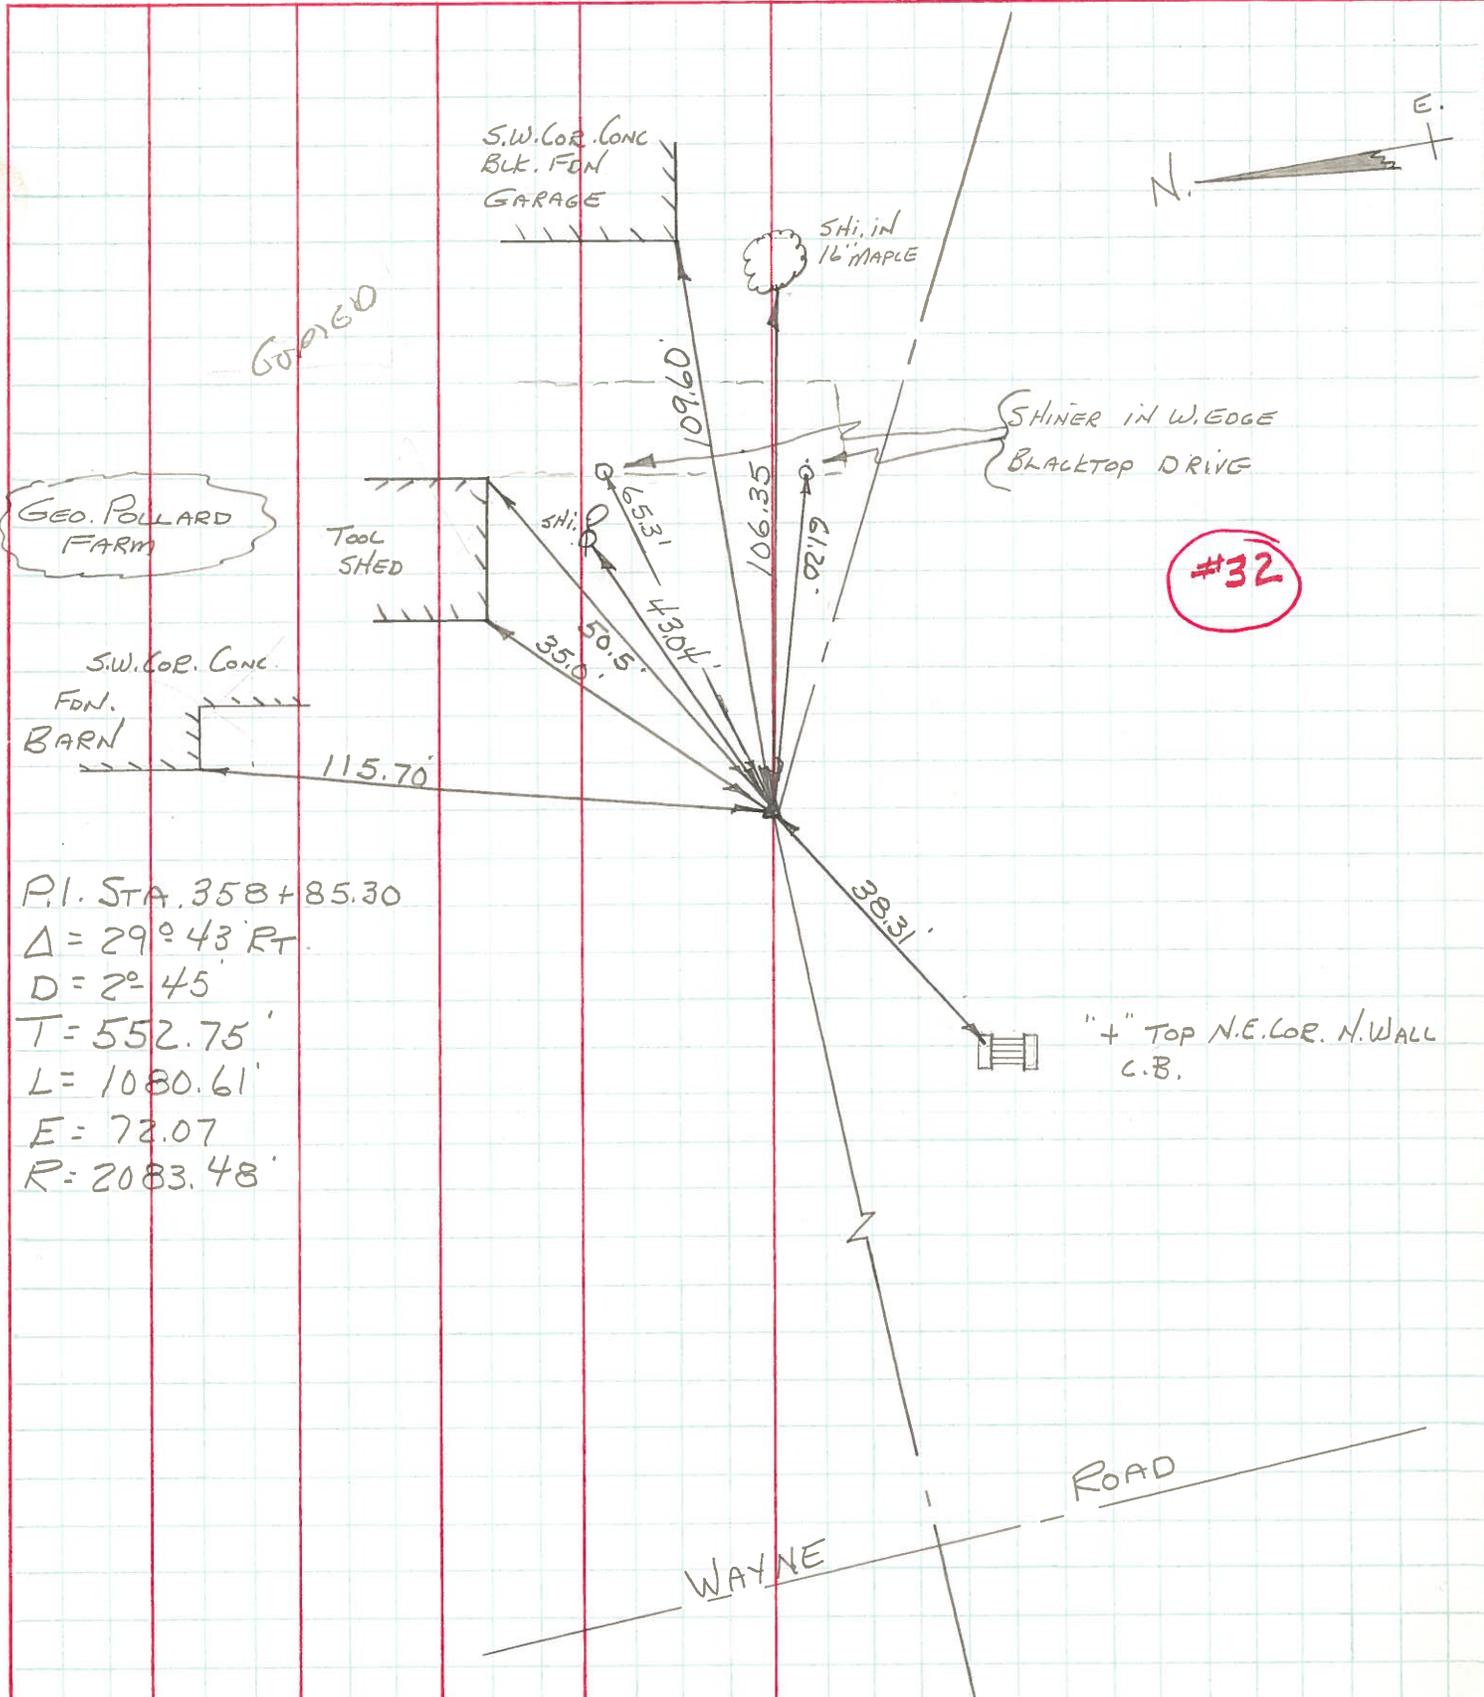

P.I. STA. 358+85.30
 $\Delta = 29^\circ 43' RT.$
 $D = 2^\circ 45'$
 $T = 552.75'$
 $L = 1080.61'$
 $E = 72.07'$
 $R = 2083.48'$

PERSONNEL TITLE PERSONNEL TITLE

COUNTY Wood

DATE

S.R. U.S #6

WEATHER

SEC.

TEMP.

DESCRIPTION

LEFT

CENTER LINE

RIGHT

JOB NO.

Sta. 463 + 60.82

Shiner over mon. 5/4
post sec. 28

5-4-60

10" walnut N.E. 50.62

12" wild cherry N.W. 34.42

T.P. S.E. 38.23

spk. P. Pole S 37.80

Shiner T. Pole N.W. 45.92

N.E. Cor. Conc. Foundation of Ho SW 99.85

(30)

#53-A

Cor. abut
4-29-68
Set
and set
on new
5-15-68

Sta. 476 + 86.28

P.K. nail
OK 12-13-57

5-4-60

C.B. N.N.E. Gone, 23.35

B.R. Post SSE. Gone, 27.0

X in Conc. Post S. 26.40

Shiner in P.P.S.S.W. 26.59 26.55

Shiner in T.P. N. 36.90

(30-A)

#54

4-30-68

Sta. 490 + 09.65

Cor. Stone P.I. P.P. spike
is 1.06' N. set. P.K. Nail's from 28
4-30-68

Cor
stone

X N. end E. abut. 37.37

X S. end E. abut. 32.27

Shiner in T.P. SE. 41.82

5-4-60

P.P. SPK
P.I.

X N. end E. abut. 36.65

X S. end E. abut. 32.96

Shiner in T.P. SE. 42.65

WAYNE ROAD

(31)

#55

P.I. Sta. 358 + 85.30

Iron pin
(Did not find 12-30-57)
(1st P.I. EAST OF
WAYNE ROAD)

5-4-60

S.W. Cor. Garage E. 109.6

P.P. E.N.E. 40.95

S.E. Cor. tool shed N.E. 50.5

S.W. Cor. tool shed N.N.E. 35.0

S.W. Cor. of W. side of Barn N. 115.7

Pole N.N.W. 10.7

X in N.E. Cor. of N. Wall. of C.B. SW. 38.1

(32)

#56