

O.D.O.T. DISTRICT 2 SURVEY OFFICE (USE ONLY)

PERSONNEL

REFERENCE NO. 33

SHEET 7 OF 14

NOTES RHOADES

DATE 6/26/20

ROUTE US 6

H.C. LEU

WEATHER SUNNY

COUNTY WOOD

R.C. GARRETT  
MAHLER

TEMP. 79°

TOWNSHIP FREEDOM

DWG BY NIESE PID 101242

SECTION 34

T 5 N R 12 E

TYPE MONUMENT P.K.NAIL

ON SURFACE - ~~BELOW~~ ON

OFFSET CL PAVEMENT 0.6' LT : ~~RT~~

12.8' TO RT EDGE PAVEMENT


STATION: 1206+30.68

HORIZ.DATUM: NAD83 2011


GEOID: NAVD88 2012A

GRID: NORTHING: 615435.121

EASTING: 1703926.215

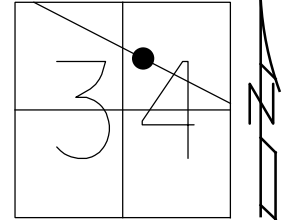

RECORD:  
STA 386+37.89  
FD SM.R.R.SPIKE  
7/19/94, JLR  
FD P.K.NAIL  
9/12/18  
6/26/20, JLL  
SET MAG/WASHER  
9/29/20, JFO

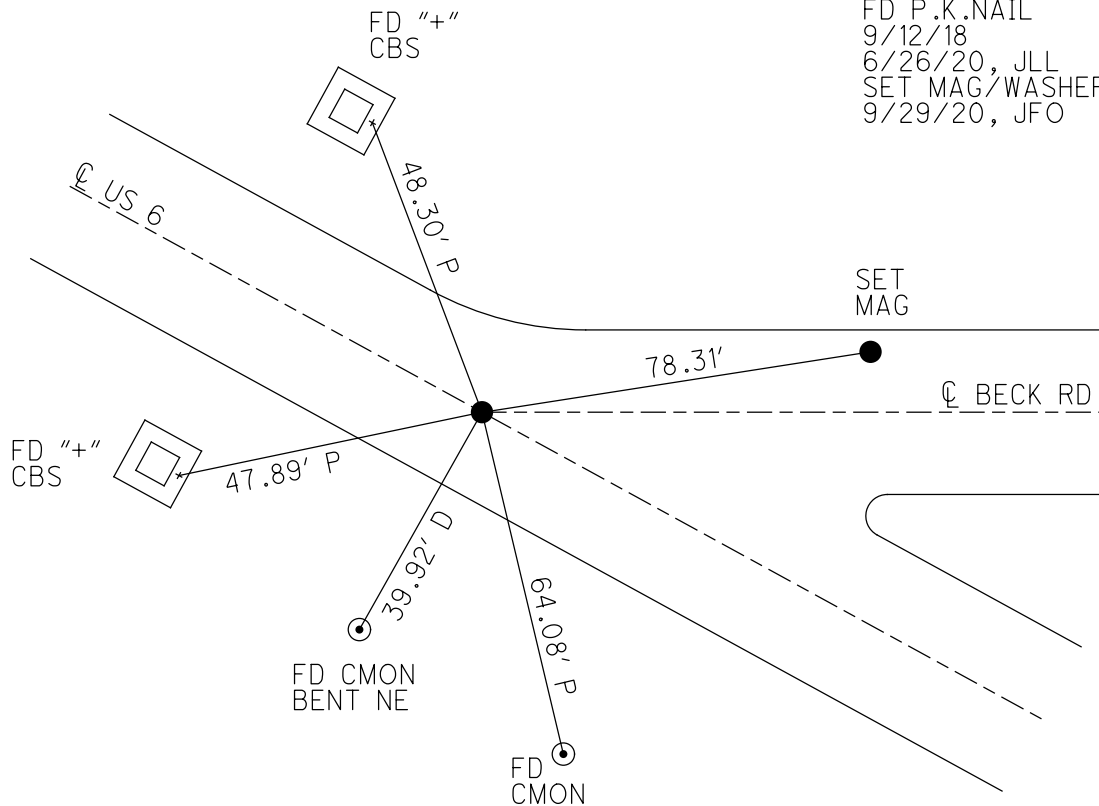

# O.D.O.T. DISTRICT 2 SURVEY OFFICE

PERSONNEL \_\_\_\_\_

REFERENCE NO. 33

SHEET 6 OF 10

NOTES Cheney

H.C. Ripple

R.C. Baerbaue

DATE 7-19-54

WEATHER Fair

TEMP. 78.4

ROUTE U.S. 6

COUNTY Wood

TOWNSHIP Freedom

SECTION 34

T. S N. R. 12 E.


TYPE MONUMENT Sm R.R. Spike

ON SURFACE - BELOW Yes


LEFT- $\odot$  PAV'T. - RIGHT Yes

12.8 TO RT EDGE PAVEMENT

S.L.M. 1209+01

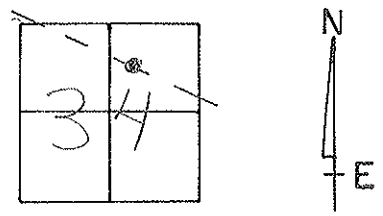

Record Sta 386+37.89  
No  $\times$  for U.S. 6

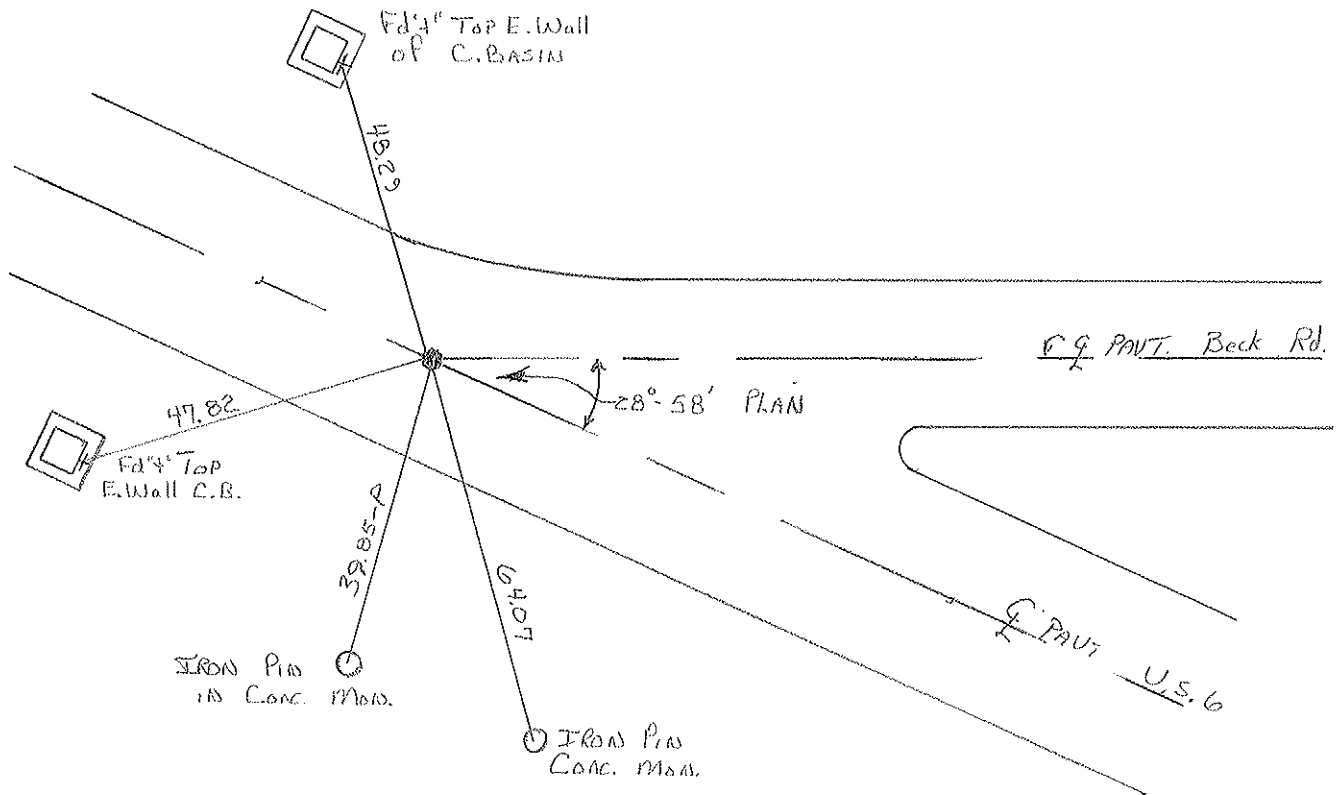

County Wood ~~S.R. U.S. 6~~

Date 3-20-85

Township FREEDOM

Weather CLEAR

Section 34


Temp. 40°

TSN, R12E

Personnel Hoffman

LOEHRKE H.C.


BARNHISEL R.C.

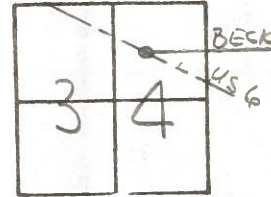

# 33

Fd small R.R. SPK @ SURFACE  
 ON & PAWT  
 10.6' TO RT. E.P.

SLM 1208 + 92  
 Set small R.R. SPK  
 8-30-85 SWN

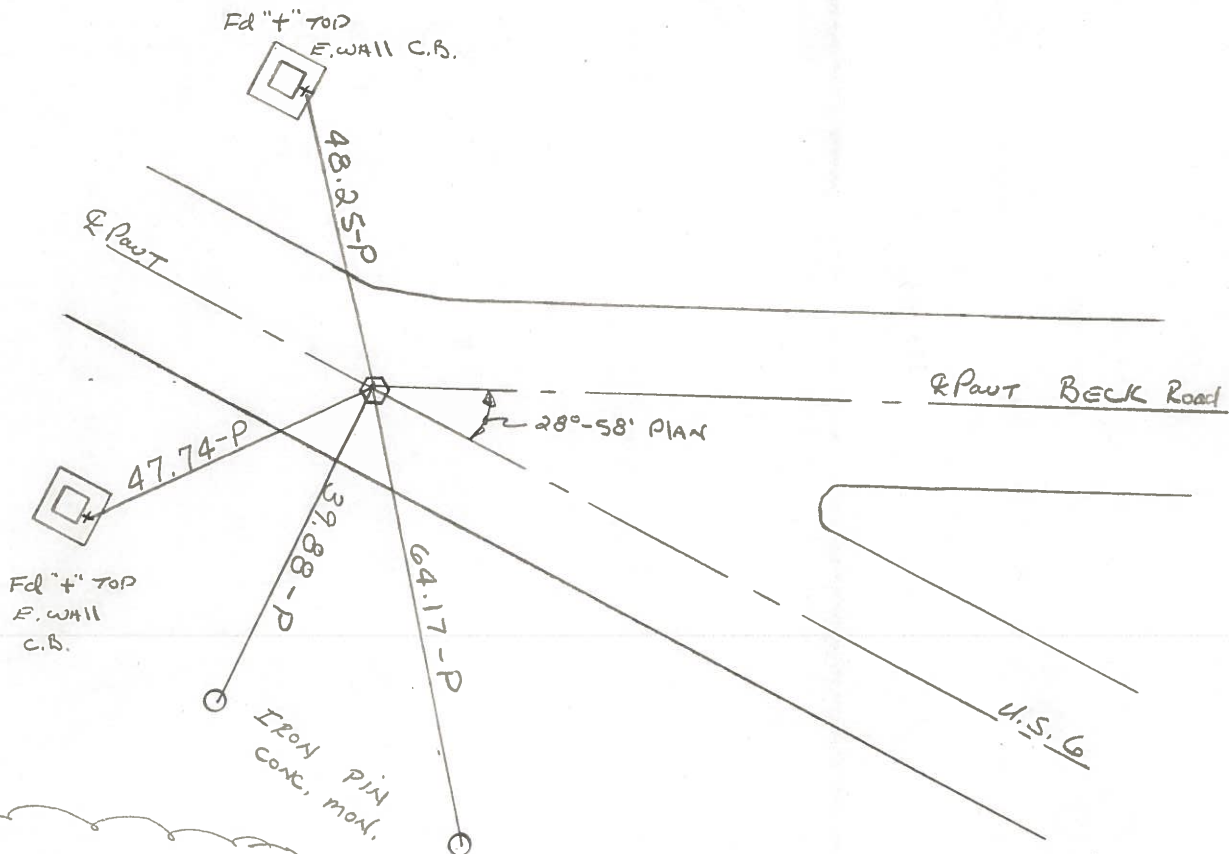

RECORDS:  
 386 + 37.89  
 Fd R.R. SPK 3 1/2" Deep  
 No  $\nabla$  on U.S. 6

QD.O.T. DISTRICT 2 SURVEY OFFICE

Sht. 33 of

County WOOD U.S. 6

Date 5-26-72

Township FREEDOM

Weather CLEAR

Section 34


Temp. 74°

T5N, R12E

Personnel BURNSIDE

SMITH

BOWERS

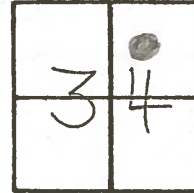


#33

STA. 386+37.89

FD. R.R. SPKE 3 1/2" DEEP

NO ANGLE ON U.S. 6

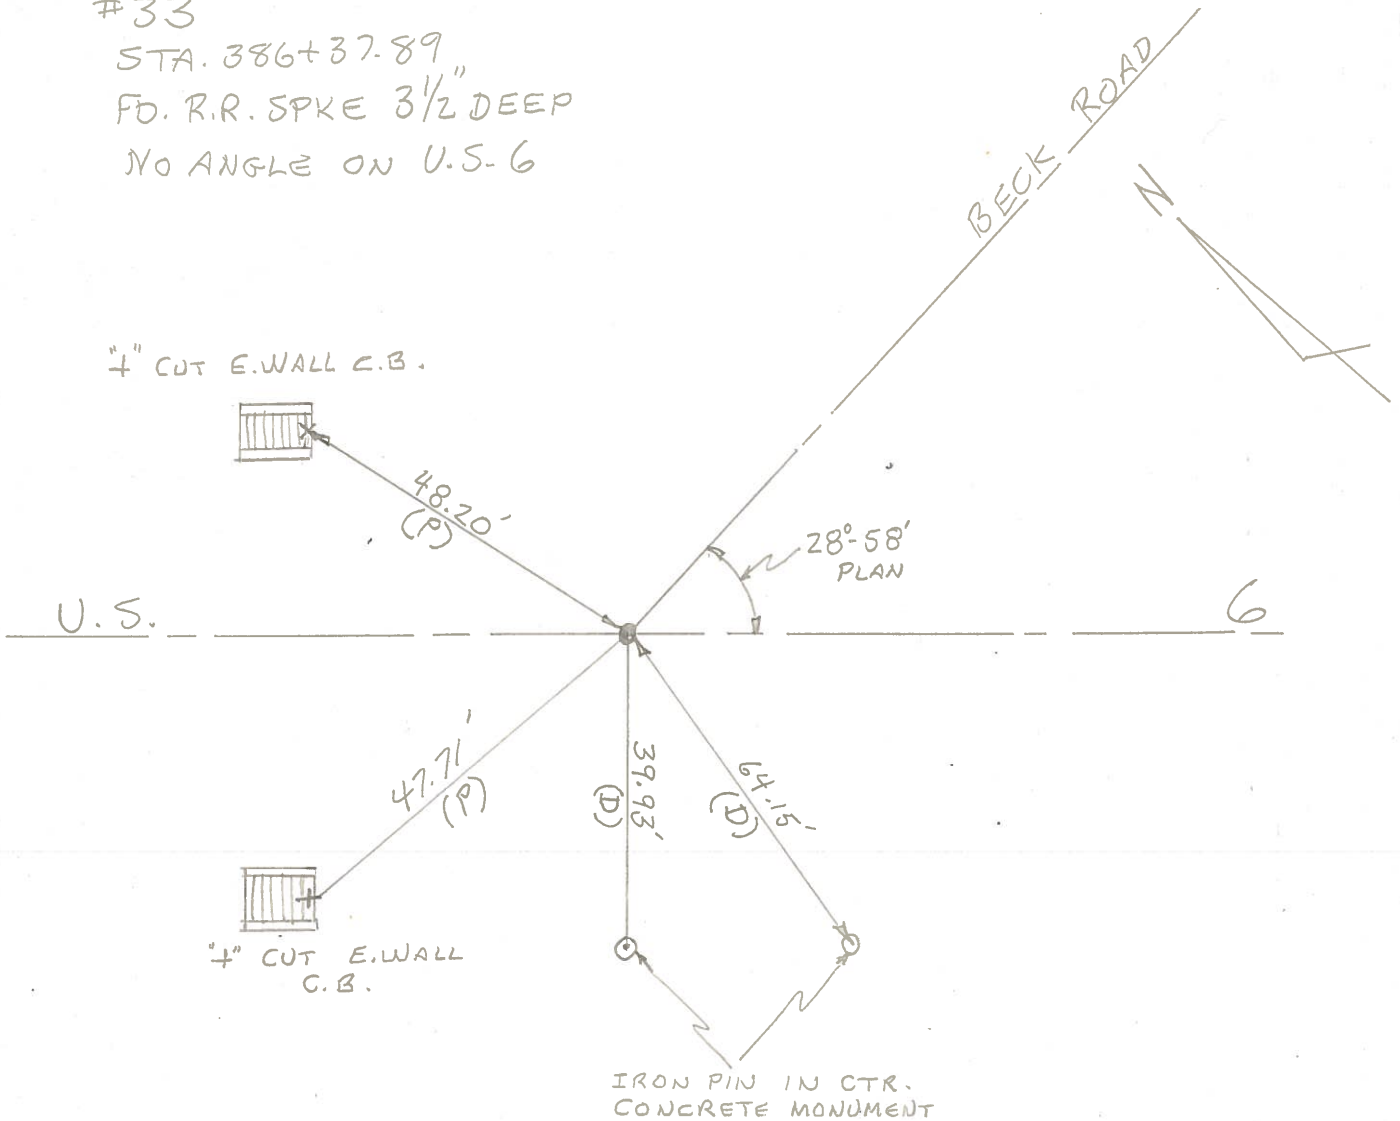

PERSONNEL	TITLE	PERSONNEL	TITLE
BURNSIDE			
SMITH			
BOWERS			

COUNTY Wood DATE 5-26-72  
 S. R. U.S.6 WEATHER CLEAR  
 SEC. BECK ROAD TEMP. +74°

DESCRIPTION \_\_\_\_\_ LEFT \_\_\_\_\_ CENTER LINE \_\_\_\_\_ RIGHT \_\_\_\_\_ JOB NO. \_\_\_\_\_

