


O.D.O.T. DISTRICT 2 SURVEY OFFICE (USE ONLY)


PERSONNEL _____ REFERENCE NO. 33 A SHEET 8 OF 14
 NOTES LEU DATE 9/17/18 ROUTE US 6
 H.C. LEU WEATHER CLOUDY COUNTY WOOD
 R.C. MILLER TEMP. 74° TOWNSHIP FREEDOM
 DWG BY NIESE PID 101242 SECTION 34
 T 5 N R 12 E

TYPE MONUMENT SM.R.R.SPIKE
~~ON SURFACE - BELOW~~ 3 1/2"
 OFFSET 11.0' TO RT EDGE PAVEMENT
 STATION: 1215+92.98

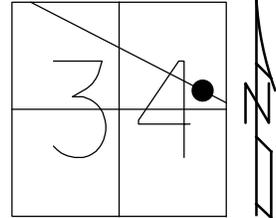

HORIZ.DATUM: NAD83 2011 GEOID: NAVD88 2012A
 GRID: NORTHING: 614964.652 EASTING: 1704765.667

RECORD: P.I.
 STA. 396+00
 $\Delta = 0^{\circ}37' \text{ LT}$
 $D = 0^{\circ}04'$
 $T = 462.81'$
 FD SM.R.R.SPIKE
 7/19/94, JLR
 FD SM.R.R.SPIKE
 3 1/2" DOWN
 9/17/18, JLL
 SET MAG/WASHER
 9/29/20, JFO

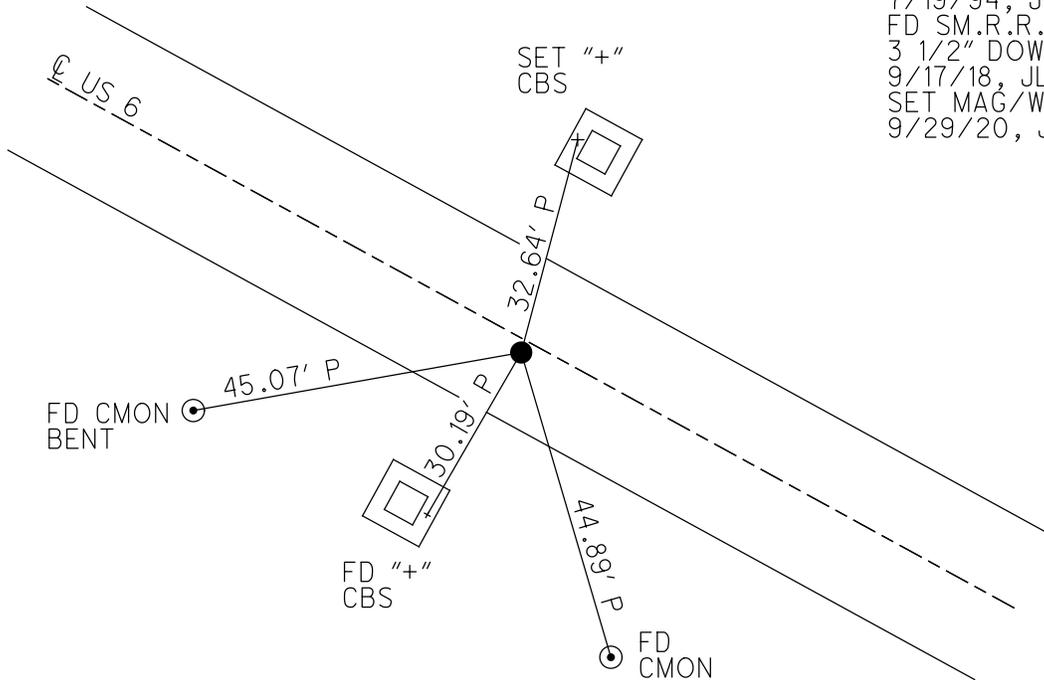

O.D.O.T. DISTRICT 2 SURVEY OFFICE

PERSONNEL

REFERENCE NO. 33-A

SHEET 7 OF 10

NOTES CHENEY

H.C. RIFFLE

R.C. BARBOUR

GEYMAN

DATE 7-19-94

WEATHER FAIR

TEMP. 78.2

ROUTE U.S. 6

COUNTY WOOD

TOWNSHIP FREEDOM

SECTION 34

T. 5 N. R. 12 E


TYPE MONUMENT SM. R.R. Spike

ON SURFACE - BELOW Yes


LEFT - C PAVT. - RIGHT 1.0

11.0 TO RT EDGE PAVEMENT

S.L.M. 1218 + 69

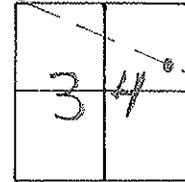

RECORD P.I.
Sta 396+00
 $\Delta = 0^{\circ} - 37' - 14''$
 $D = 0^{\circ} - 04'$
 $T = 462.81$

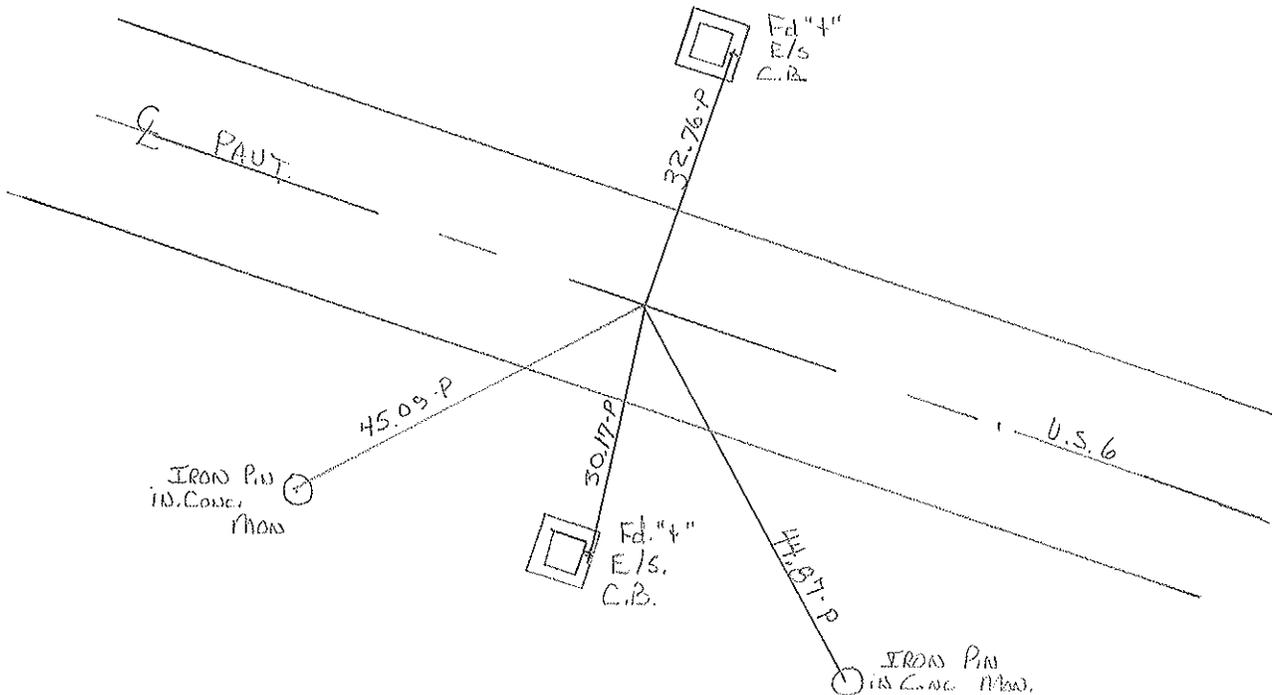

County WOOD S.R. 456

Date 3-20-85

Township FREEDOM

Weather Clear

Section 34

Temp. 45°


TSN, R12E

Personnel Hoffman

LOEHRKE H.C.


BARNHISEL R.C.

33-A

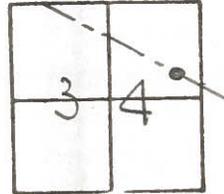

Fd small R.R. SPK @ surface
 1.0' RT. of & PWT
 9.4' TO RT. EP

SLM 1218+61
 Set small R.C. SPK
 8-30-85 SWK

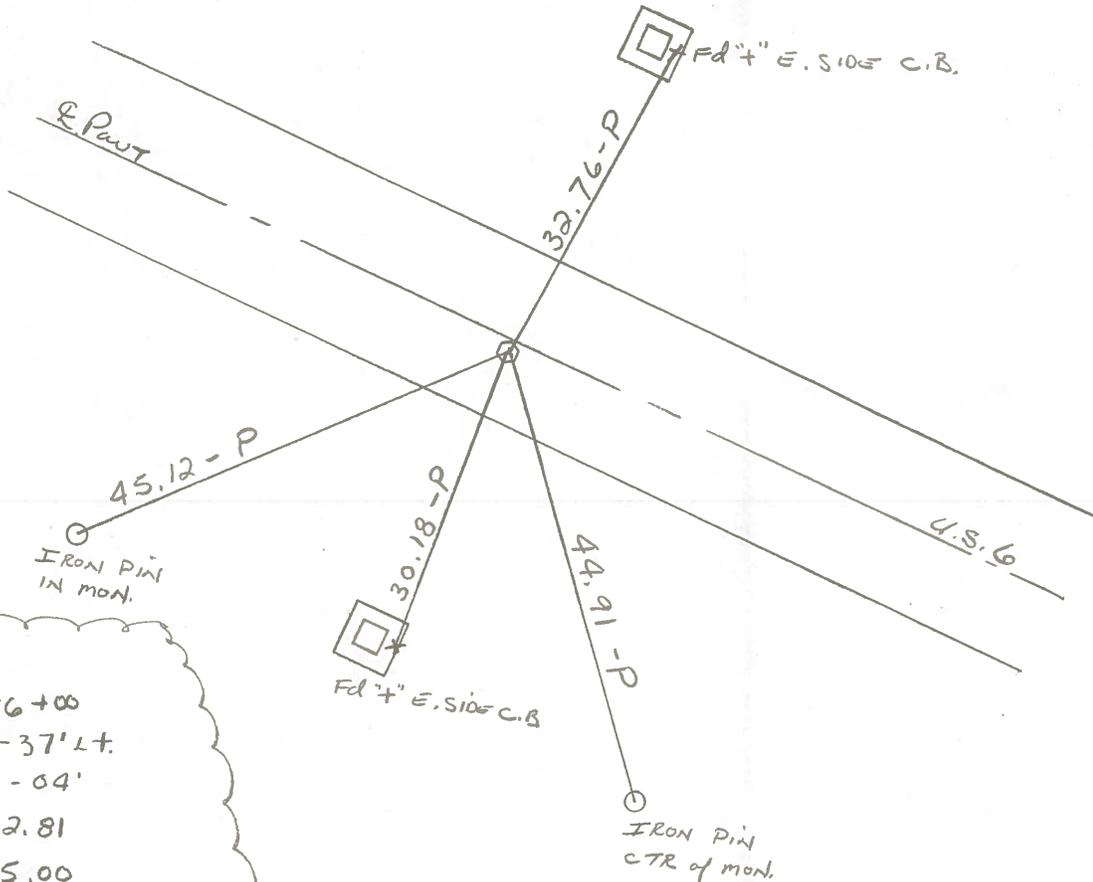

RECORD:

P.I. = 396+00

$\Delta = 0^\circ - 37' \text{ LT.}$

D = 0° - 04'

T = 462.81

L = 925.00

R = 85,943.67'

E = 1.25

Fd R.R. SPK 4 1/2" Deep
1.25' S of & PWT

QD.O.T. DISTRICT 2 SURVEY OFFICE

Sht. 33-A of _____

County WOOD S.R. 6

Date 5-26-72

Township CENTER

Weather CLEAR

Section 34


Temp. 75°

T5N, R12E

Personnel BURNSIDE

SMITH



BOWERS

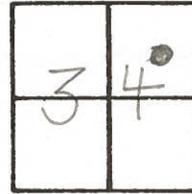

33-A

P.I.
 STA. 396+00
 $\Delta = 0^\circ - 37' \text{ LT.}$
 $D = 0^\circ - 04'$
 $T = 462.81'$
 $L = 925.00'$
 $R = 85943.67'$
 $E = 1.25'$


FD. R.R. SPK.
 4 1/2" DEEP ϕ 1.25' S.
 OF ϕ PAUT.

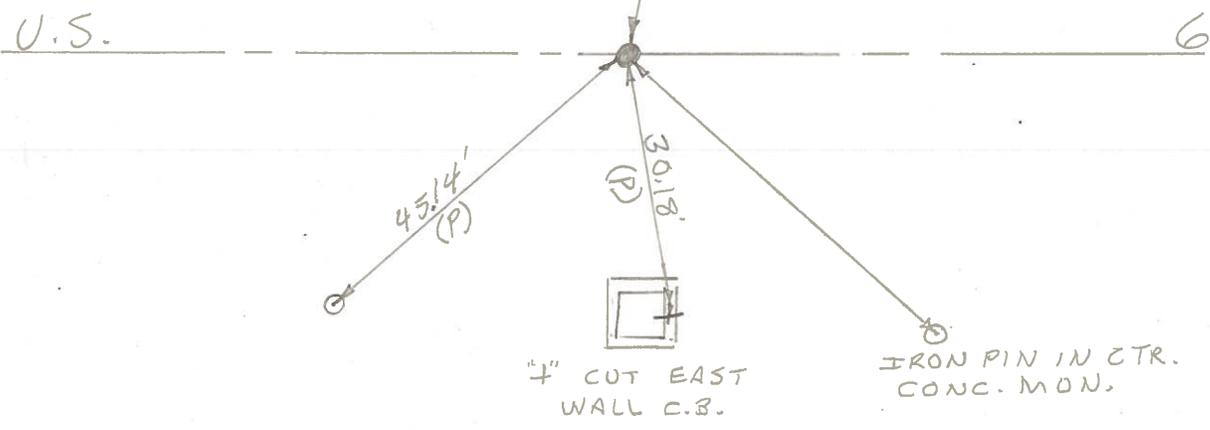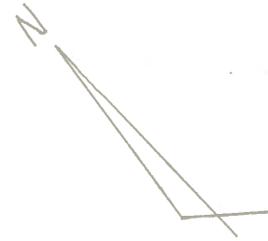

PERSONNEL	TITLE	PERSONNEL	TITLE
BURNSIDE			
SMITH			
BOWERS			

COUNTY WOOD DATE 5-26-72
 S. R. U.S. 6 WEATHER CLEAR
 SEC. _____ TEMP. +75°

DESCRIPTION P.I. @ STA 396+00 STA. ON P/W PLAN OF 1940 JOB NO. _____
 LEFT CENTER LINE RIGHT

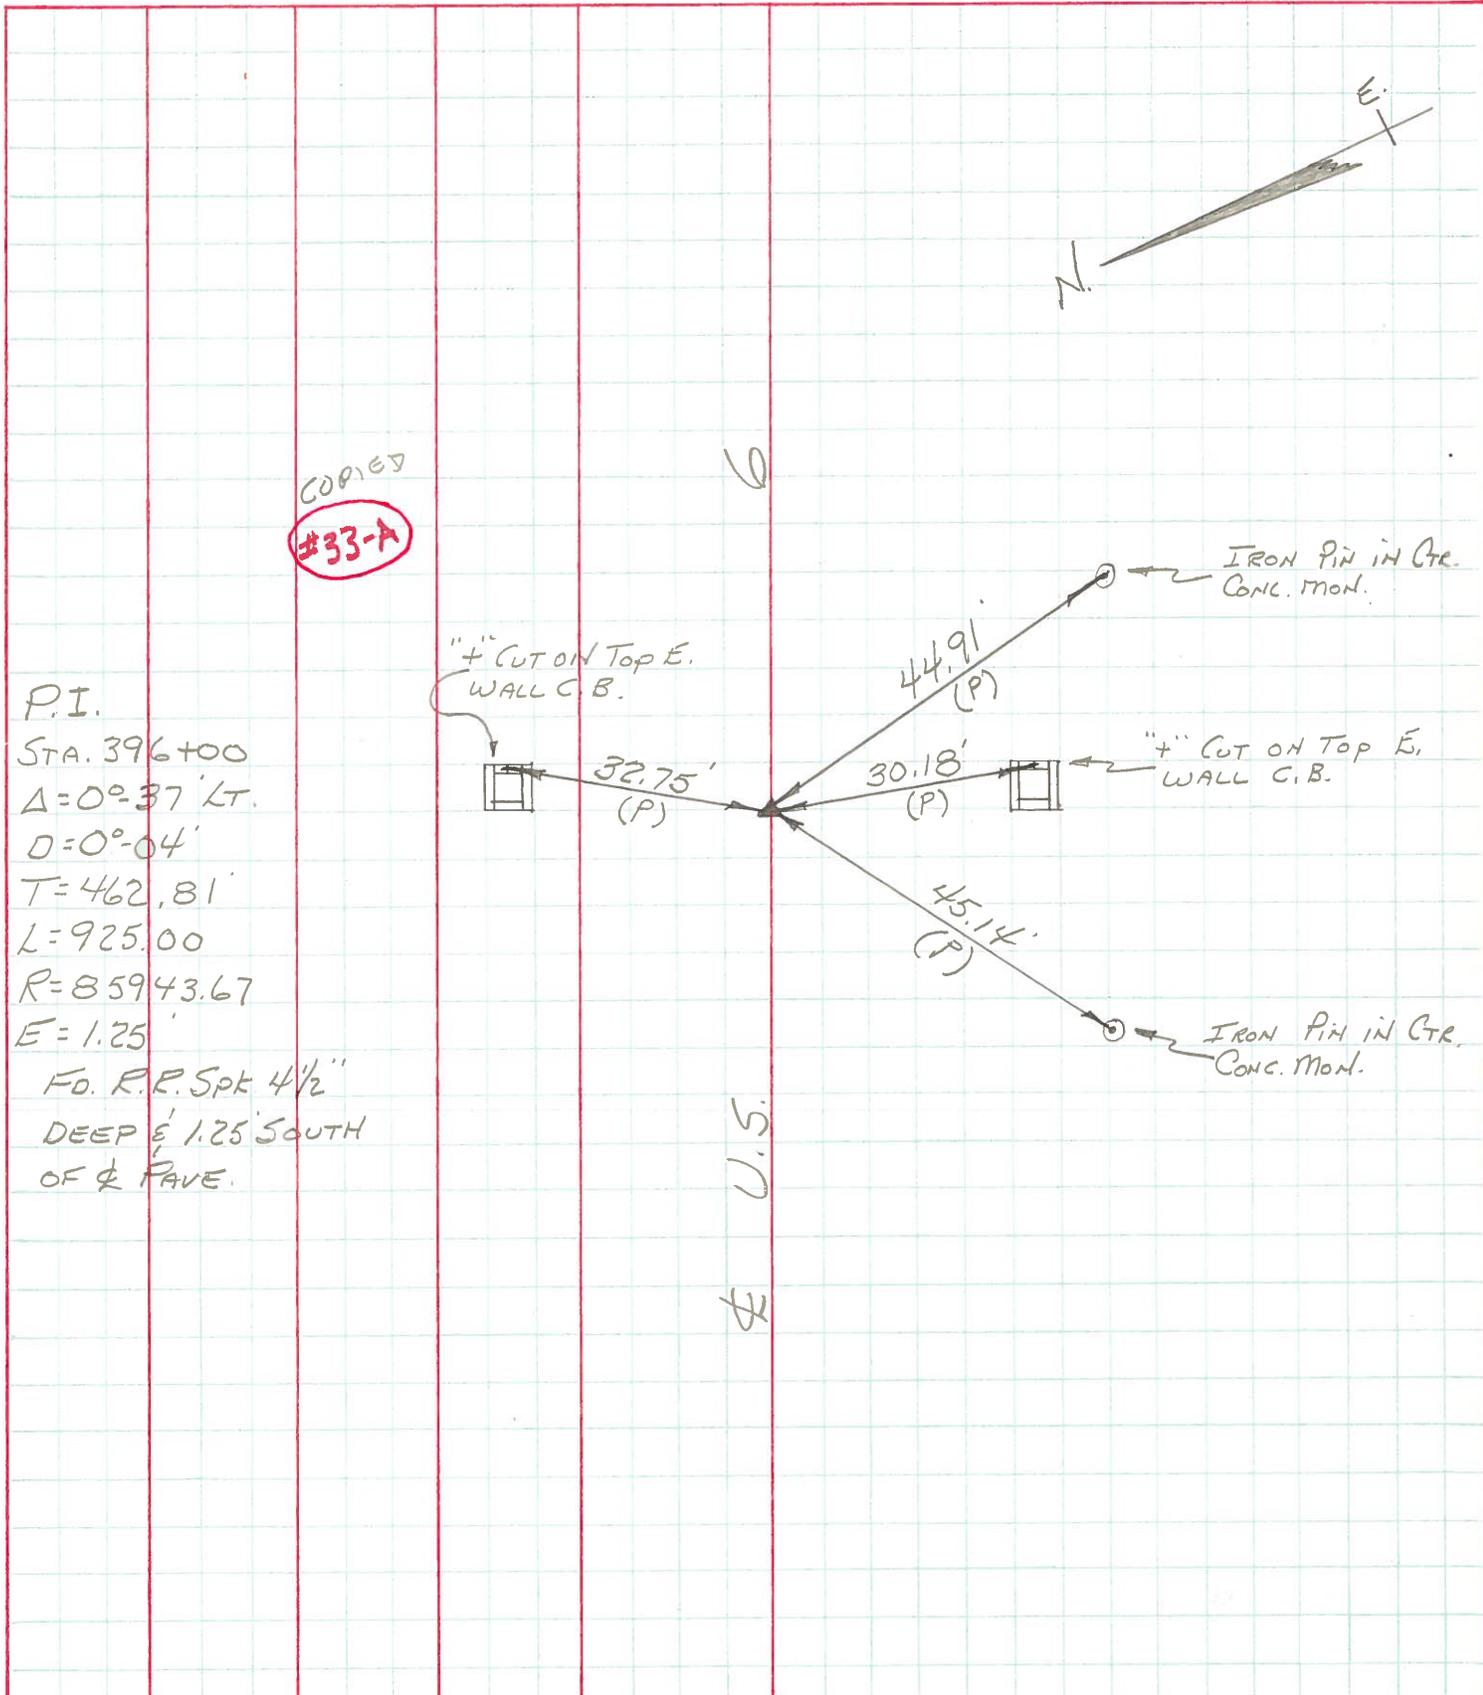

P.I.
 STA. 396+00
 $\Delta = 0^\circ 37' \text{ LT.}$
 $D = 0^\circ 04'$
 $T = 462.81'$
 $L = 925.00'$
 $R = 85943.67'$
 $E = 1.25'$

FO. R.R. SPK $4\frac{1}{2}''$
 DEEP $1.25'$ SOUTH
 OF $\&$ PAVE.

COPIED
 #33-A

" $\frac{1}{2}$ " CUT ON TOP E.
 WALL C.B.

IRON PIN IN CTR.
 CONC. MON.

" $\frac{1}{2}$ " CUT ON TOP E.
 WALL C.B.

IRON PIN IN CTR.
 CONC. MON.

$\&$ U.S.