

O.D.O.T. DISTRICT 2 SURVEY OFFICE (USE ONLY)

PERSONNEL

REFERENCE NO. 34

SHEET 9 OF 14

NOTES RHOADES

DATE 6/26/20

ROUTE US 6

H.C. LEU

WEATHER SUNNY

COUNTY WOOD

R.C. GARRETT

TEMP. 79°

TOWNSHIP FREEDOM

MAHLER

SECTION 34

DWG BY NIESE

PID 101242

T 5 N R 12 E

TYPE MONUMENT SM.R.R.SPIKE

~~ON SURFACE~~ - BELOW 3"

OFFSET Q PAVEMENT ON LT : RT

- TO - EDGE PAVEMENT


STATION: 1231+23.71

HORZ.DATUM: NAD83 2011


GEOID: NAVD88 2012A

GRID: NORTHING: 614230.877

EASTING: 1706109.068

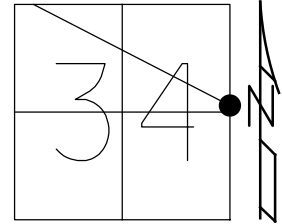

DIST.34-34A= 13.10'

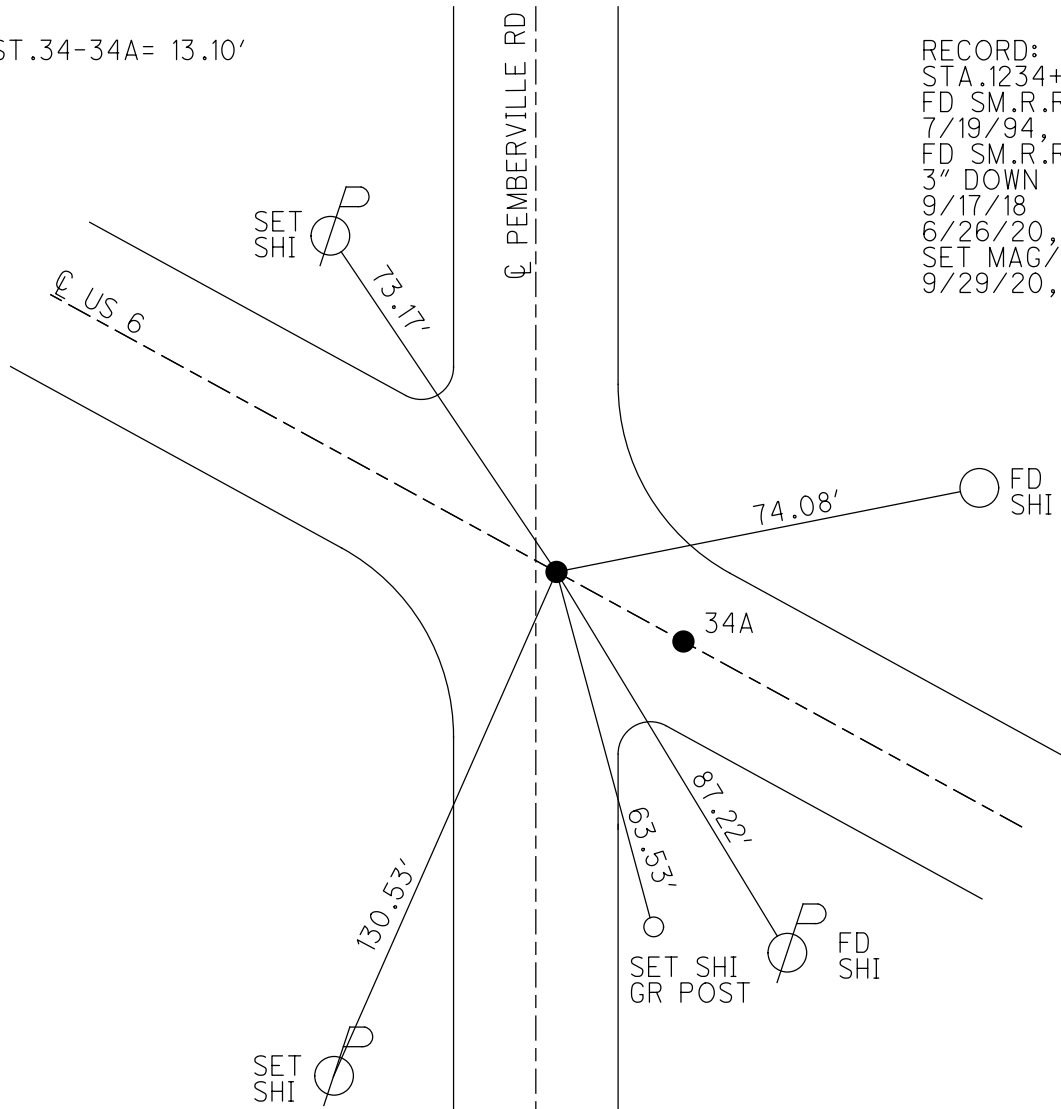

RECORD:
 STA.1234+02
 FD SM.R.R.SPIKE
 7/19/94, JLR
 FD SM.R.R.SPIKE
 3" DOWN
 9/17/18
 6/26/20, JLL
 SET MAG/WASHER
 9/29/20, JFO

O.D.O.T. DISTRICT 2 SURVEY OFFICE

PERSONNEL _____

REFERENCE NO. 34

SHEET 8 OF 10

NOTES Cheney

H.C. RIPPLE

R.C. BARBOUR

DATE 7-19-94

WEATHER Fair

TEMP. +85

ROUTE U.S. 6

COUNTY WOOD

TOWNSHIP FREEDOM

SECTION 34

T. 5 N. R. 12 E.



TYPE MONUMENT Sm R.P. Spike

ON SURFACE - BELOW Yes

LEFT- & PAV'T. - RIGHT Yes

TO _____ EDGE PAVEMENT

S.L.M. 1234402 1234+15

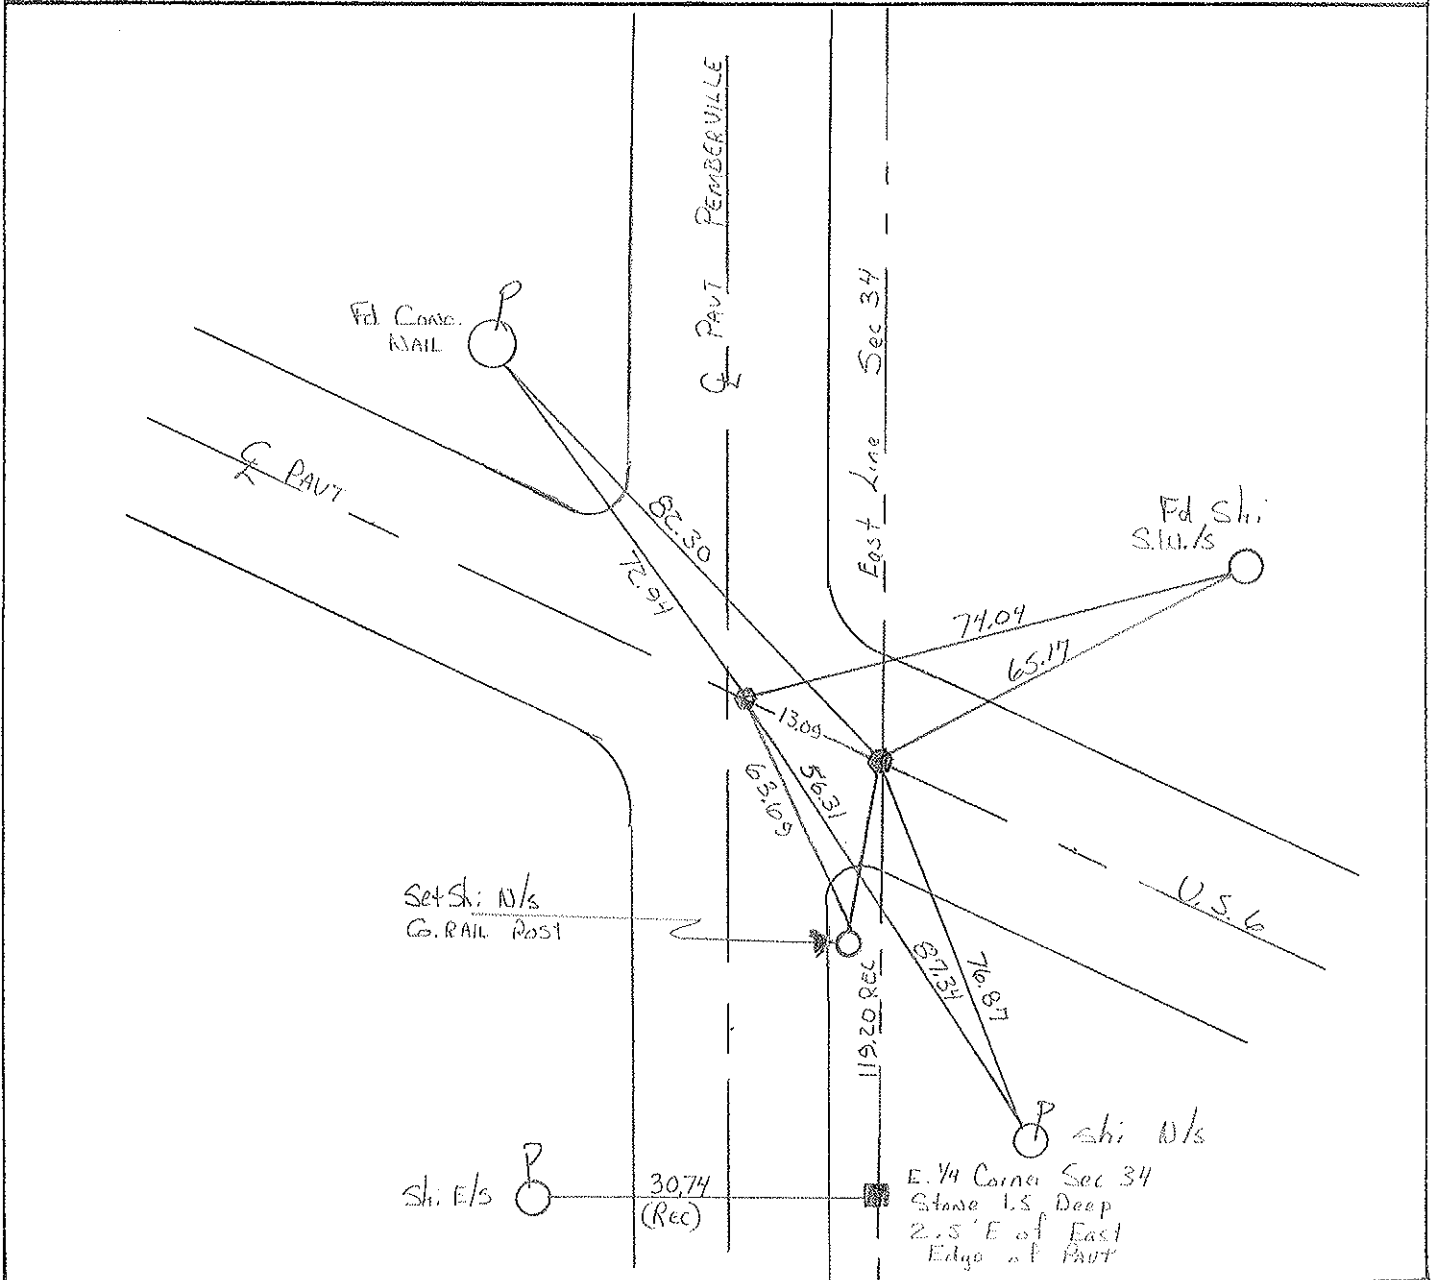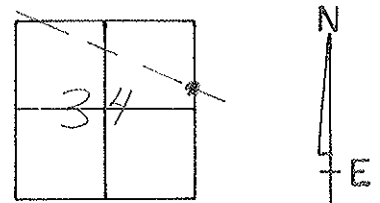

County Wood S.R. U.S. 6

Township FREEDOM

Section 34

TSN, R2E

Personnel Hoffman

LOEHRE H.C.


BARNHISEL R.C.

34

Date 3-20-85

Weather CLEAR

Temp. 45°

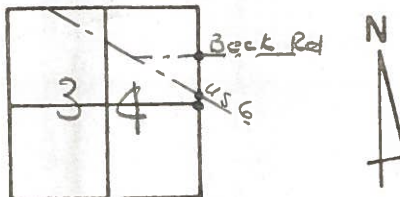

"A" = Fd small R.R. spike
 @ surface, 1.2' Lt. of & Paut
 U.S. 6 & 14' EAST of
 & Paut Pemberville Rd South

"B" Fd P.K. @ surface,
 1.2' Lt. of & Paut U.S. 6


Set small R.R. SPIKE

BOTH Points
9-3-85 SPOK

Beck Rd.

"All Record DISTANCES"

Record: E 1/4 of the
 NE 1/4 sec 34 Fd stone
 0.5 Deep & 7.0' E. of E.C.P.
 Fd "T" TOP E&W END CONC HDWL TO RES.

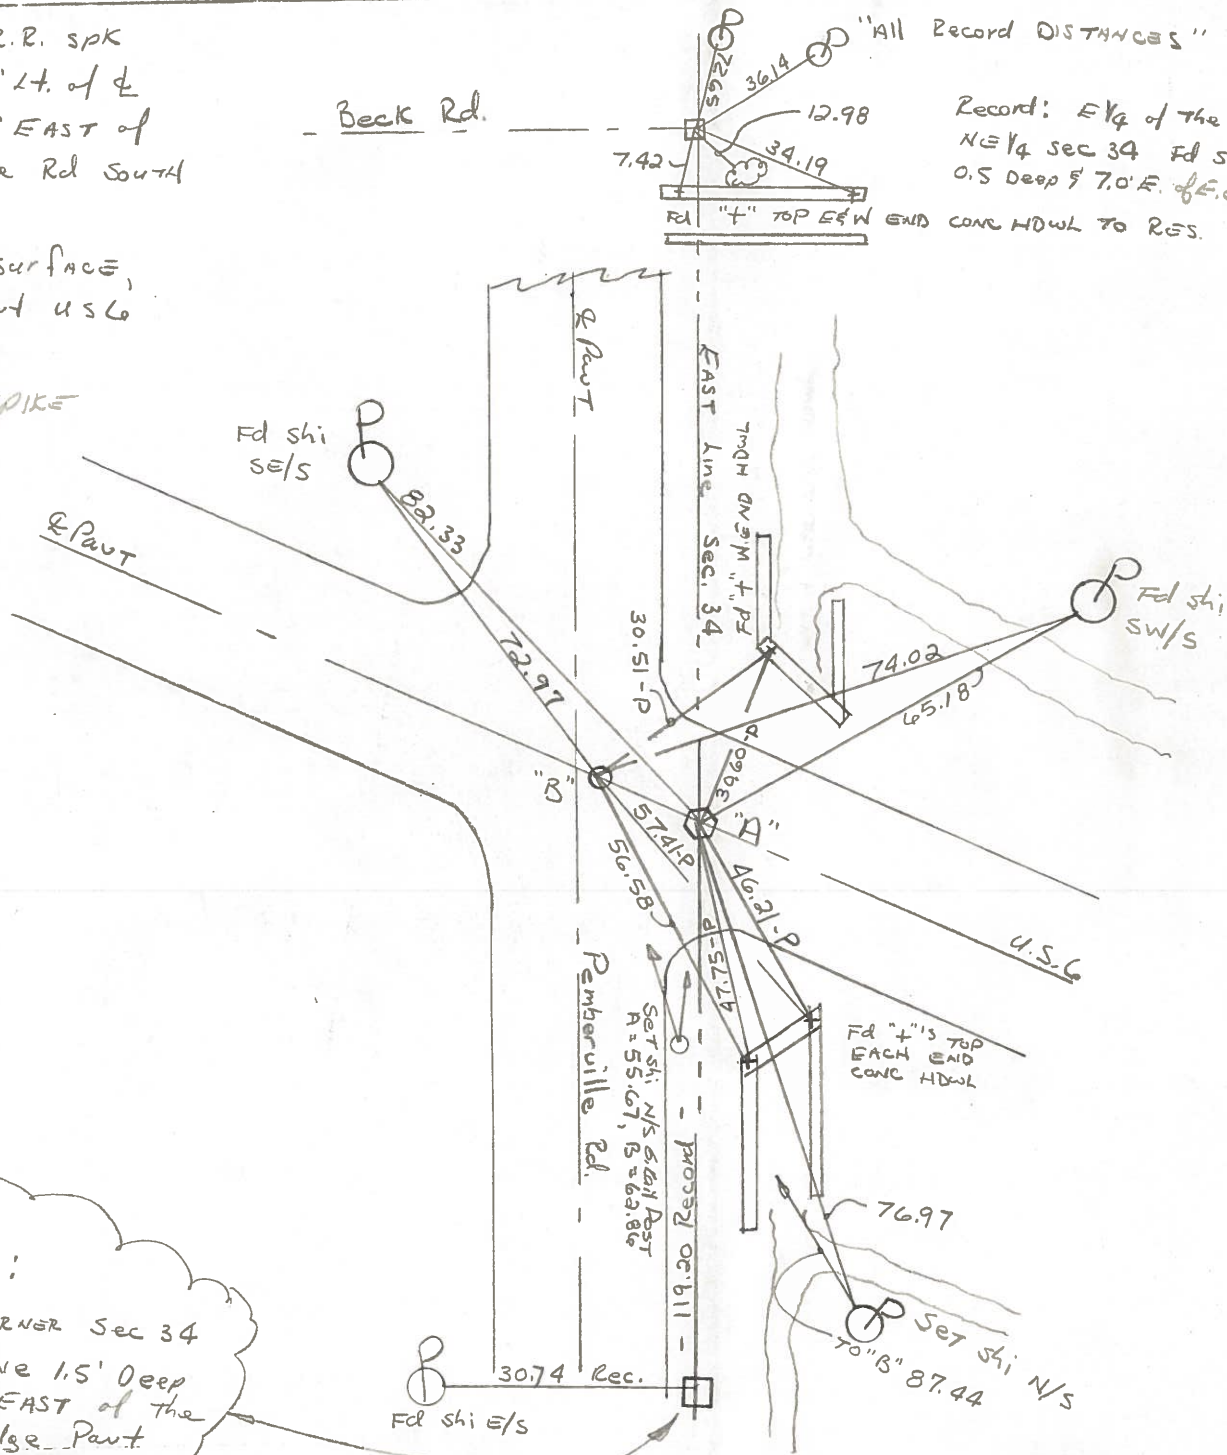

Record:
 E 1/4 CORNER Sec 34
 Fd stone 1.5' Deep
 & 2.5' EAST of the
 EAST Edge Paut.

Q.D.O.T. DISTRICT 2 SURVEY OFFICE

Sht. 34 of

County WOOD S.R. 6

Date 6-13-72

Township FREEDOM

Weather PT. CLOUDY

Section 34


Temp. 76°

T5N, R12E

Personnel BURNSIDE

SMITH

BOWERS

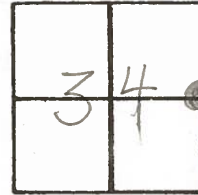

#34

E 1/4 OF THE N.E. 1/4
SEC. 34
FD. STONE .50' DEEP
AND 7.0' EAST OF THE
EAST EDGE PAVT.

BECK ROAD

4" F.T. FILLED
WITH CONG.
WIRE CENTER

4" TOP HDWL.
TO RES.

51.1'
30.1'
ELM
EAST

4" TOP HDWL.

SHI.

82.44'
73.05'

30.49'

30.59'

25.94'

65.07'

SHI.

U.S.

13.09'

6

FD. R.R. SPK.
4" DEEP

46.19'

47.72'
56.61'

LINE SEC. 34
119.20'

4" TOP HDWL.

ROADWAY
DITCH

E. 1/4 COR. SEC. 34
FD. STONE 1.5' DEEP
AND 2.5' EAST OF
THE E. EDGE PAVT.

30.74'

81.72'

SHI.

PERSONNEL TITLE PERSONNEL TITLE
 BURNSIDE _____
 SMITH _____
 BOWERS _____

COUNTY Wood DATE 6-13-72
 S. R. U.S. 6 WEATHER PT. CLOUDY
 SEC. PEMBERVILLE ROAD TEMP. +76°

DESCRIPTION LEFT CENTER LINE RIGHT JOB NO.

