

O.D.O.T. DISTRICT 2 SURVEY OFFICE (USE ONLY)

PERSONNEL

REFERENCE NO. 34 A

SHEET 10 OF 14

NOTES RHOADES DATE 6/26/20
 H.C. LEU WEATHER SUNNY
 R.C. GARRETT TEMP. 79°
MAHLER

ROUTE US 6
 COUNTY WOOD
 TOWNSHIP FREEDOM
 SECTION 34
 T 5 N R 12 E

DWG BY NIESE PID 101242

TYPE MONUMENT SM.R.R.SPIKE

~~ON SURFACE~~ - BELOW 3"

OFFSET C PAVEMENT ON LT : RT
- TO - EDGE PAVEMENT


STATION: 1231+36.84

HORZ.DATUM: NAD83 2011


GEOID: NAVD88 2012A

GRID: NORTHING: 614224.647

EASTING: 1706120.630

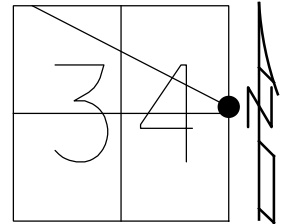

DIST.34-34A= 13.10'

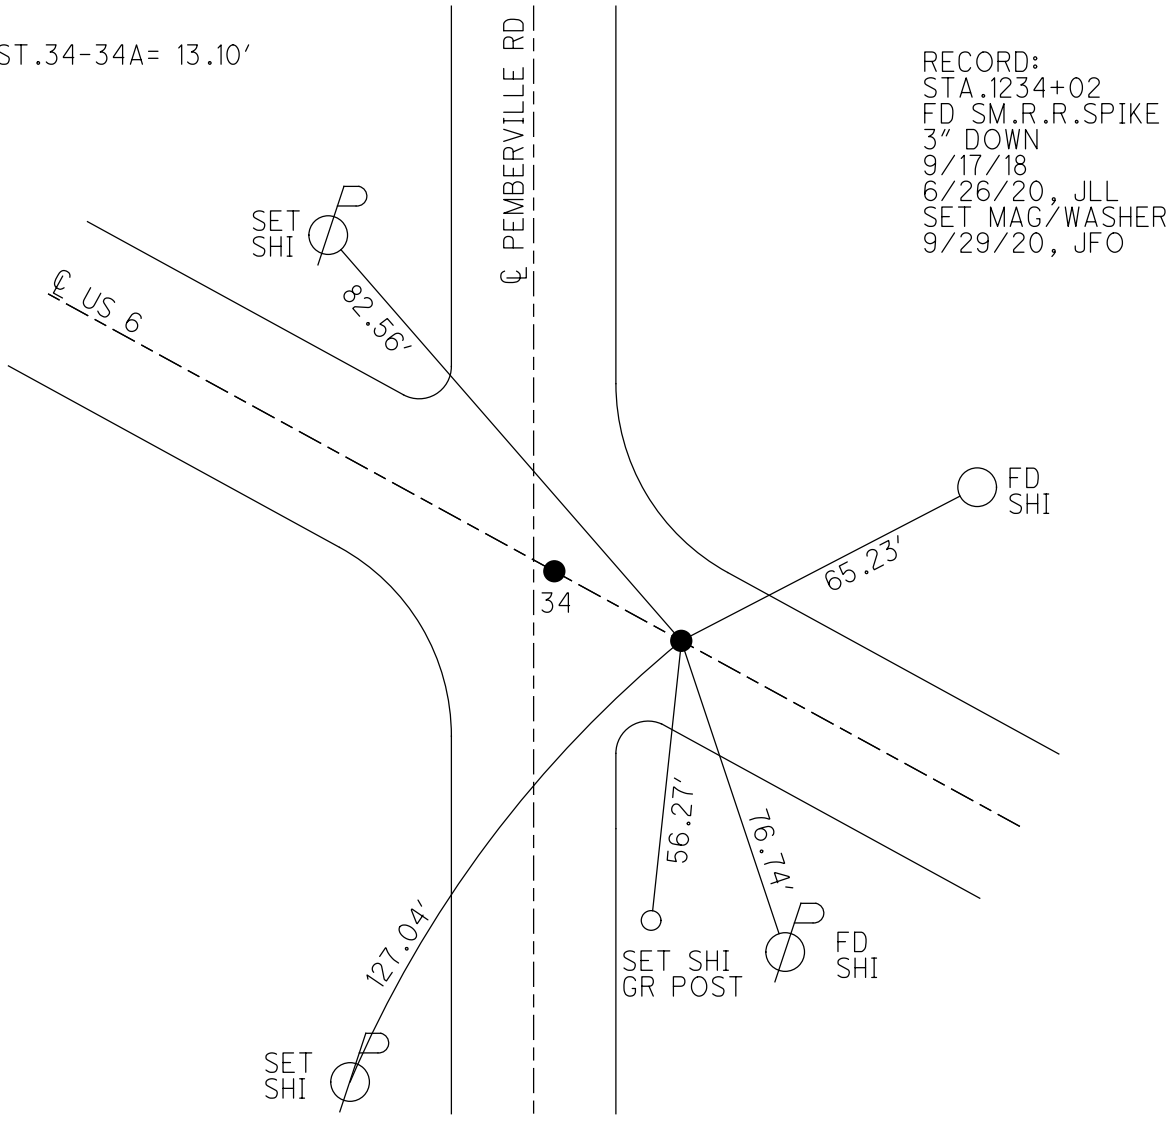

RECORD:
 STA.1234+02
 FD SM.R.R.SPIKE
 3" DOWN
 9/17/18
 6/26/20, JLL
 SET MAG/WASHER
 9/29/20, JFO

O.D.O.T. DISTRICT 2 SURVEY OFFICE

PERSONNEL _____

REFERENCE NO. 34

SHEET 8 OF 10

NOTES Cheney

H.C. RIPPLE

R.C. BARBOUR

DATE 7-19-94

WEATHER Fair

TEMP. +85

ROUTE U.S. 6

COUNTY WOOD

TOWNSHIP FREEDOM

SECTION 34

T. 5 N. R. 12 E.

TYPE MONUMENT Sm R.P. Spike

ON SURFACE - BELOW Yes

LEFT - & PAV'T. - RIGHT Yes

TO _____ EDGE PAVEMENT

S.L.M. 1234402 1234+15

