

O.D.O.T. DISTRICT 2 SURVEY OFFICE (USE ONLY)

PERSONNEL

REFERENCE NO. 35 A

SHEET 33 OF 34

NOTES AUBLE

DATE 7/31/23

ROUTE US 6

H.C. AUBLE

WEATHER FAIR

COUNTY WOOD

R.C. RHOADES

TEMP. 75°

TOWNSHIP FREEDOM

ASTON

SECTION 36

DWG BY ASTON

PID R/W

T 5 N R 12 E

TYPE MONUMENT MAG/WASHER

ON SURFACE - ~~BELOW~~ ON

OFFSET CL PAVEMENT 8.4' ~~LT~~ : RT

3.3' TO RT EDGE PAVEMENT


STATION: 1303+64.56

HORIZ.DATUM: NAD83 2011

GEOID: NAVD88 2018


GRID: NORTHING: 611451.880

EASTING: 1712666.709

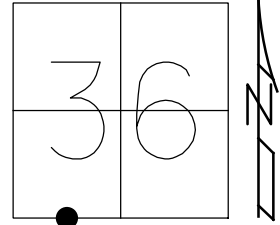

RECORD:
 FD SM.R.R.SPIKE
 7/19/94, CL
 SET P.K./WASHER
 10/3/94, CL
 FD P.K./WASHER
 9/14/18, JFO
 6/26/20, JLL
 SET MAG/WASHER
 9/29/20, JFO
 FD MAG/WASHER
 REF35A
 7-31-23, DSA

WOOD LDP:
 N: 434089.173
 E: 223988.190

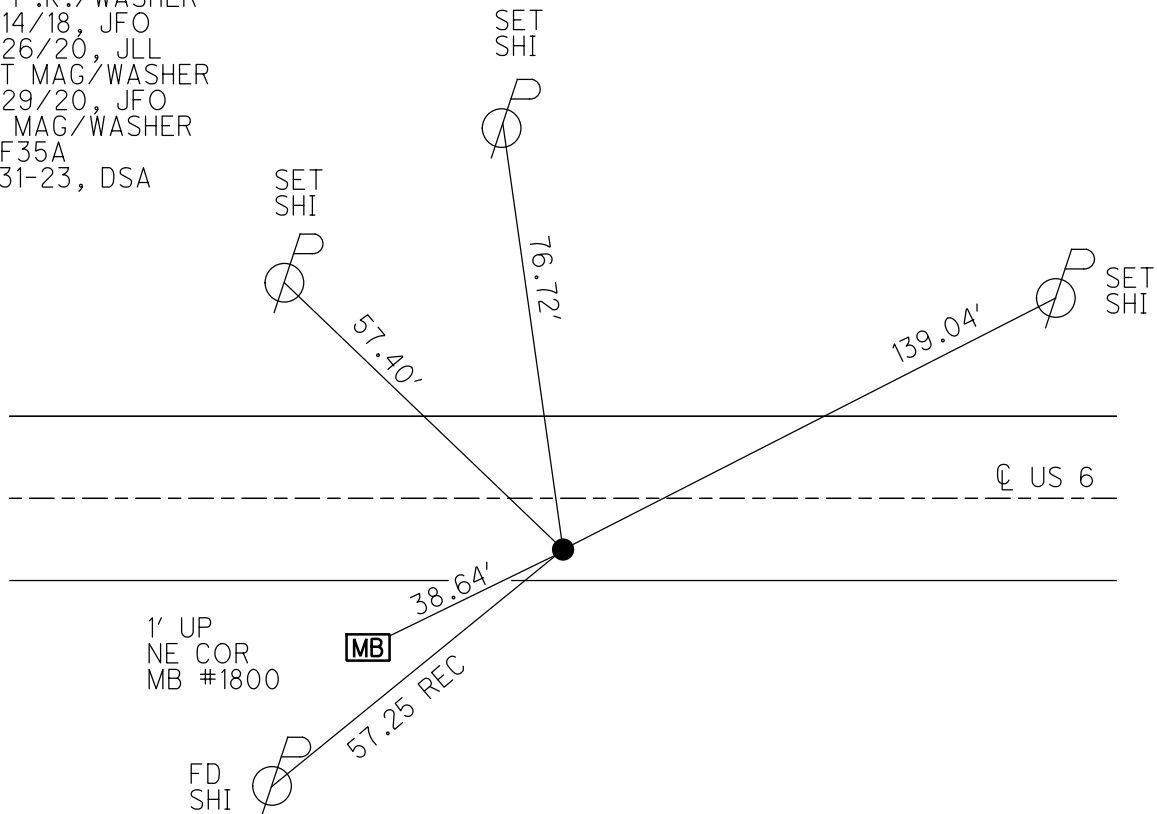

O.D.O.T. DISTRICT 2 SURVEY OFFICE (USE ONLY)

PERSONNEL

REFERENCE NO. 35 A

SHEET 12 OF 14

NOTES RHOADES

DATE 6/26/20

ROUTE US 6

H.C. LEU

WEATHER SUNNY

COUNTY WOOD

R.C. MAHLER

TEMP. 70°

TOWNSHIP FREEDOM

GARRETT

DWG BY NIESE

PID 101242

SECTION 36

T 5 N R 12 E

TYPE MONUMENT P.K./WASHER

ON SURFACE - ~~BELOW~~ ON

OFFSET Q PAVEMENT 8.4' ~~±~~ : RT

3.3' TO RT EDGE PAVEMENT


STATION: 1303+64.56

HORZ. DATUM: NAD83 2011


GEOID: NAVD88 2012A

GRID: NORTHING: 611451.880

EASTING: 1712666.709

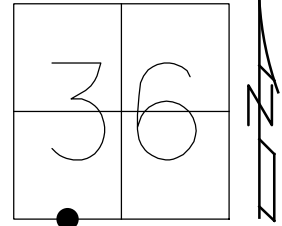

RECORD:
 FD SM.R.R.SPIKE
 7/19/94, CL
 SET P.K./WASHER
 10/3/94, CL
 FD P.K./WASHER
 9/14/18, JFO
 SET MAG/WASHER
 9/29/20, JFO

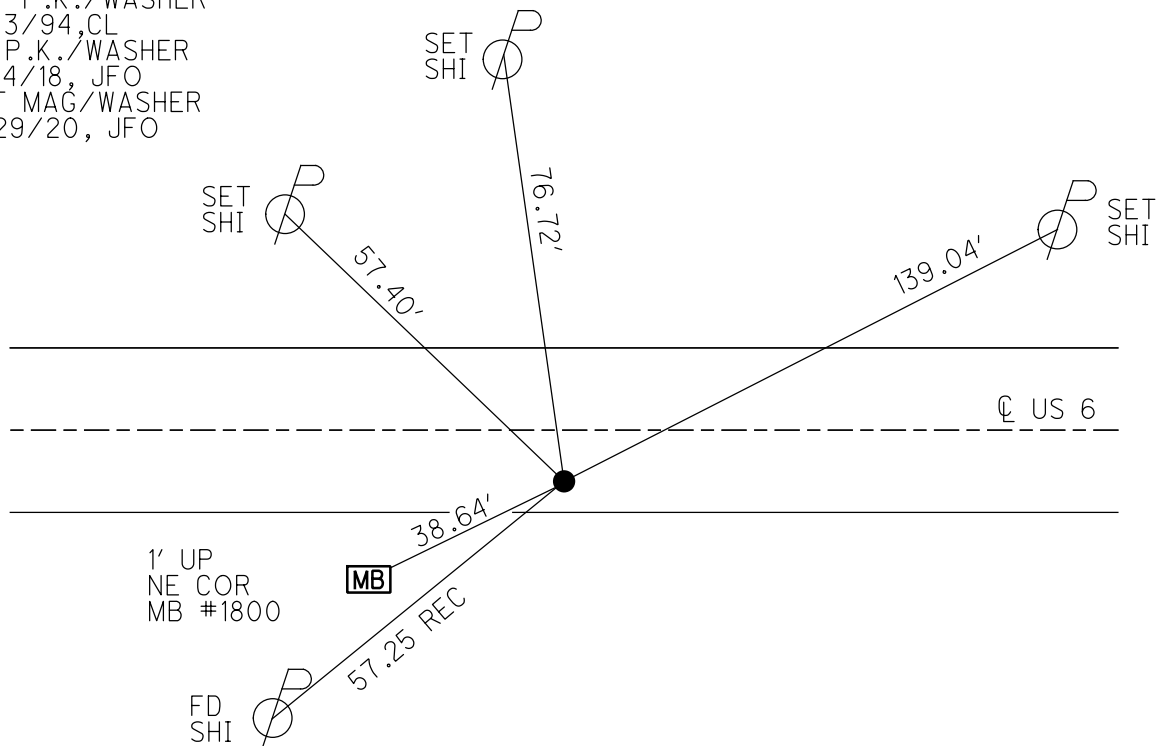

O.D.O.T. DISTRICT 2 SURVEY OFFICE

PERSONNEL _____

REFERENCE NO. 35-A

SHEET 9 OF 10

NOTES Lochare

H.C. CANTERBURY

R.C. Vogel

DATE 7-19-94

WEATHER FAIR

TEMP. _____

ROUTE U.S. 6

COUNTY WOOD

TOWNSHIP FREEDOM

SECTION 36

T 5 N R 12 E

TYPE MONUMENT Em. R.R. SPIKE



Set PK/WASHER
ID-2-94

ON SURFACE - BELOW 7.5

LEFT - CL PAV'T. - RIGHT 8.4

33 TO Rt EDGE PAVEMENT

S.L.M. 1306 + 62

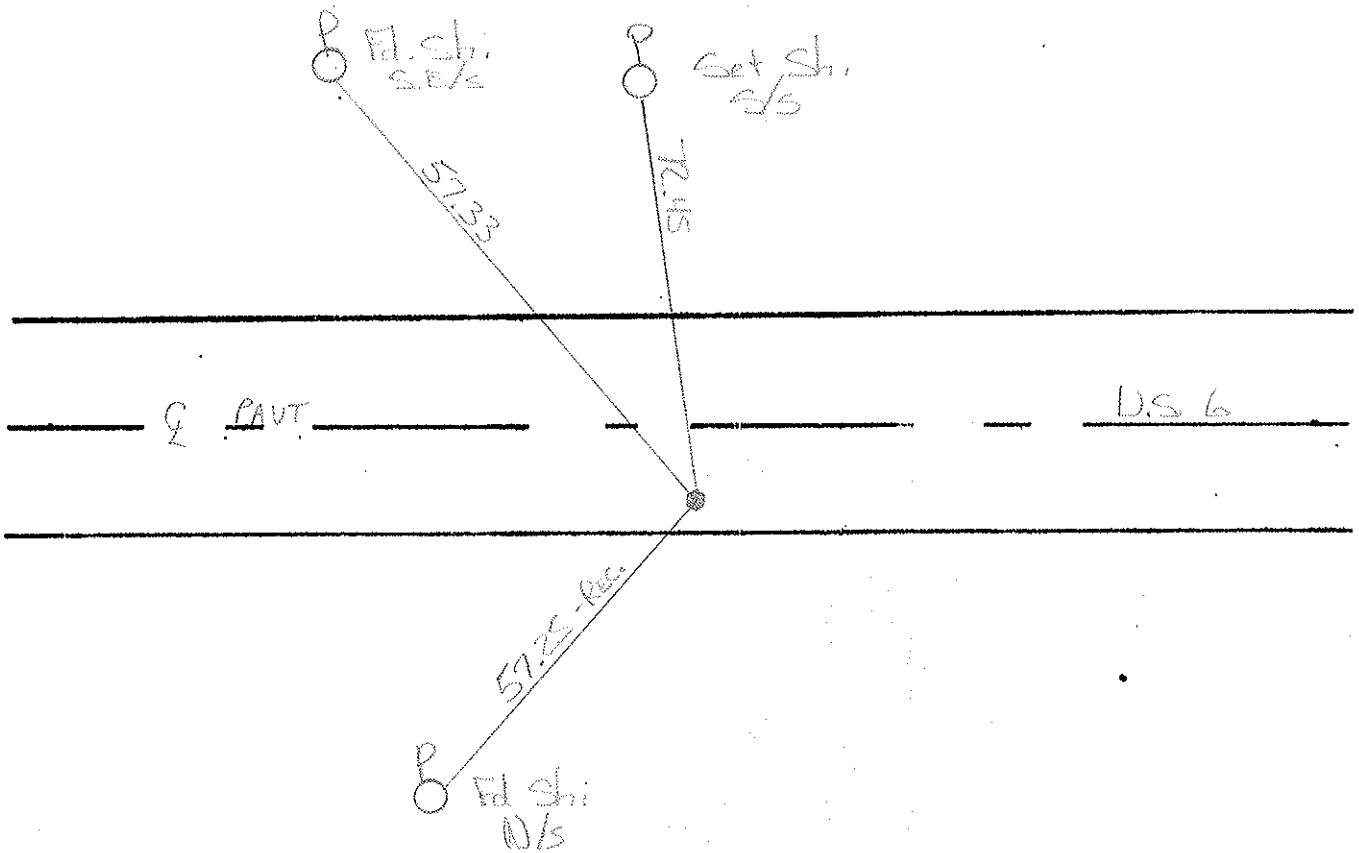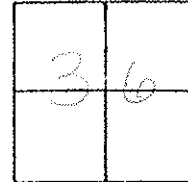

County Wood ~~SR~~ 456

Date 3-20-85

Township FREEDOM

Weather CLEAR

Section 36

Temp. 45°


T5N, R12E

Personnel Hoffman

LOHRKE H.C.


BARNHISEL R.C.

35-A

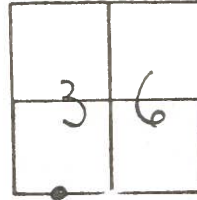

Fd. small R.R. SPK @ surface
 8.7' rt. of & part
 1.1' to rt. EP.

SLM 1306 + 38
 Set small R.R. SPK
 9-3-85 SWH

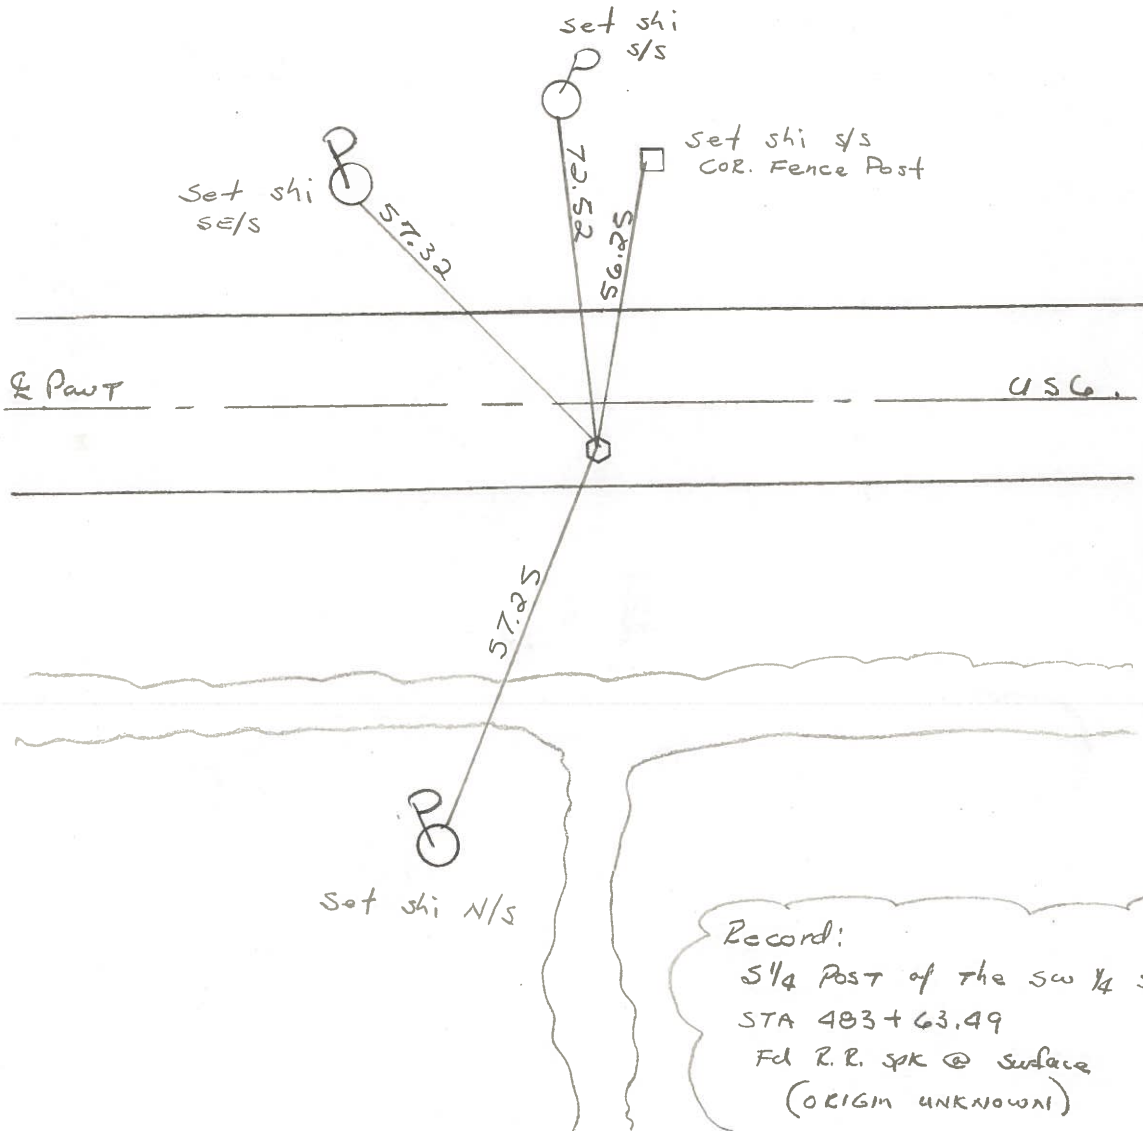

Record:
 1/4 Post of the SW 1/4 sec 36
 STA 483 + 63.49
 Fd R.R. SPK @ surface
 (ORIG UNKNOWN)

QD.O.T. DISTRICT 2 SURVEY OFFICE

Sht. 35 A of

County WOOD U.S. 6

Date 5-26-72

Township FREEDOM

Weather CLEAR

Section 36


Temp. 84°

TSN, RIZE

Personnel BURNSIDE


SMITH

BOWERS

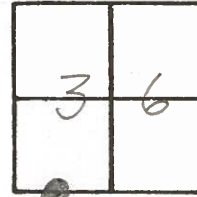

#35A

S 1/4 POST OF THE
 S.W. 1/4 SEC. 36
 STA. 483+63.49
 F.D. R.R. SPK. @ SURFACE
 AND 1.75' N. OF S. EDGE PAUT.
 (ORIGIN UNKNOWN)

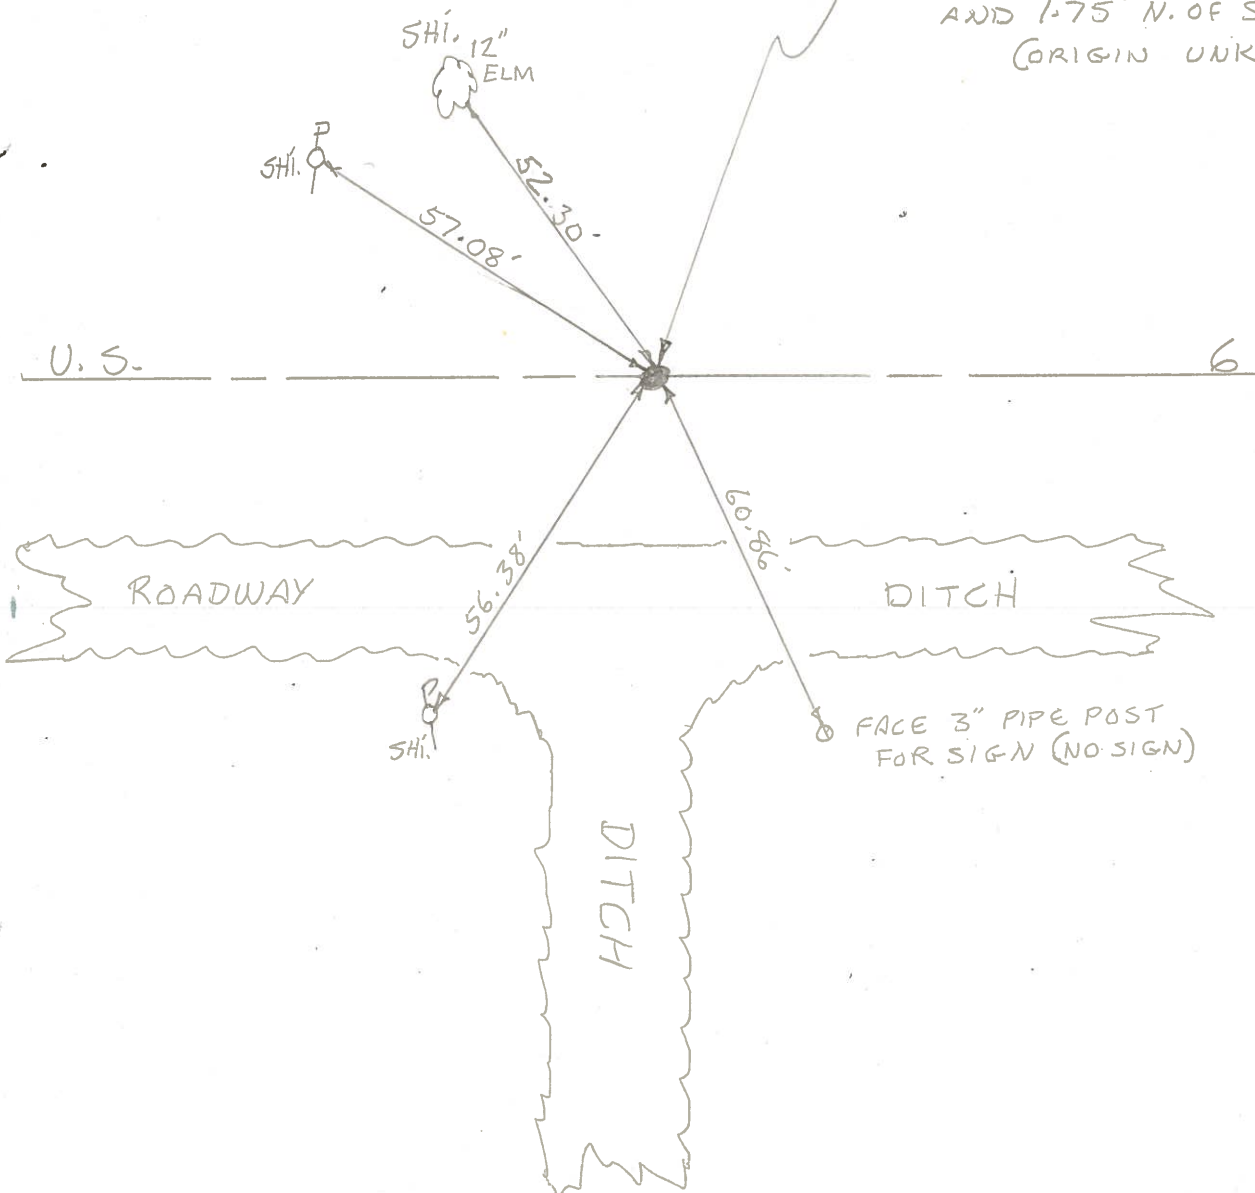

PERSONNEL	TITLE	PERSONNEL	TITLE
BURNSIDE			
SMITH			
BOWERS			

COUNTY WOOD DATE 5-26-72
 S. R. U.S. 6 WEATHER CLEAR
 SEC. _____ TEMP. +84°

DESCRIPTION S. 1/4 Post of the S.W. 1/4 Sec. 36 JOB NO. _____
 LEFT CENTER LINE RIGHT

