

O.D.O.T. DISTRICT 2 SURVEY OFFICE (USE ONLY)

PERSONNEL

REFERENCE NO. 26 A

SHEET 25 OF 26

NOTES HOMAN

DATE 8/4/14

ROUTE SR 18

H.C. LEU

WEATHER SUNNY

COUNTY WOOD

R.C. THOMAS

TEMP. 70°

TOWNSHIP HENRY

SECTION 35

DWG BY MILLER

PID 93417

T 3 N R 10 E

TYPE MONUMENT "+" CUT

ON SURFACE - ~~BELOW~~ ON

OFFSET ☉ PAVEMENT ON LT : RT

- TO - EDGE PAVEMENT 1' RT OF ☉ FRAZIER ST



STATION: 630+51.06

HORIZ.DATUM: NAD83 (2011)

GEOID: 2012A

GRID: NORTHING: 553942.914

EASTING: 1643370.336

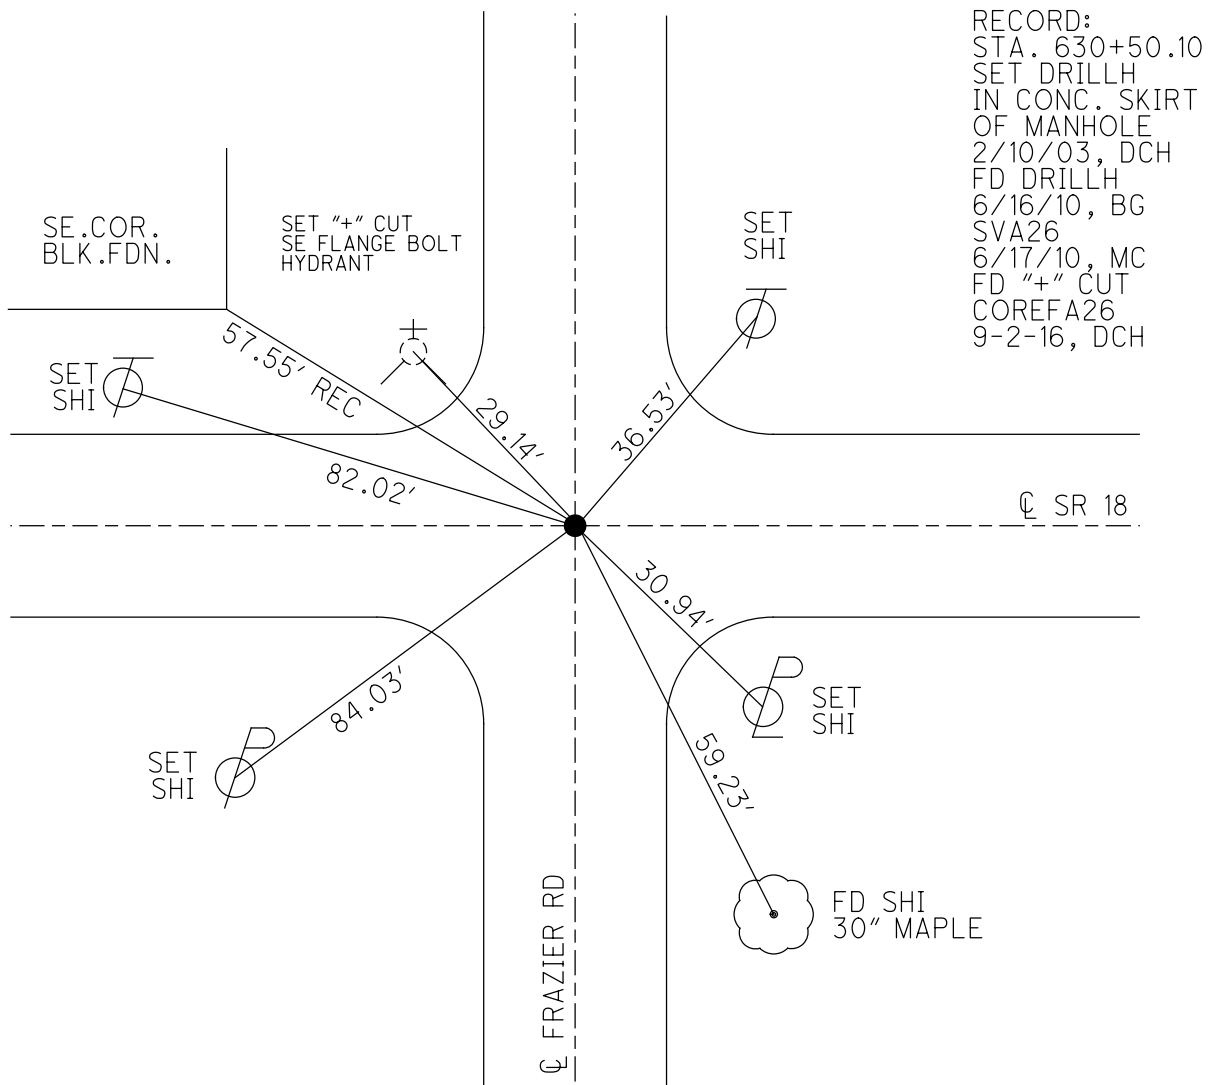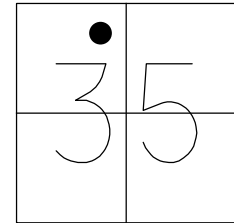


RECORD:
 STA. 630+50.10
 SET DRILLH
 IN CONC. SKIRT
 OF MANHOLE
 2/10/03, DCH
 FD DRILLH
 6/16/10, BG
 SVA26
 6/17/10, MC
 FD "+" CUT
 COREFA26
 9-2-16, DCH


O.D.O.T. DISTRICT 2 SURVEY OFFICE (USE ONLY)

PERSONNEL _____ REFERENCE NO. 26 A SHEET 25 OF 26
 NOTES HOMAN DATE 7/8/02 ROUTE SR 18
 H.C. ZEBROWSKI WEATHER SUNNY COUNTY WOOD
 R.C. MICHALAK TEMP. 70° TOWNSHIP HENRY
BEAUMONT SECTION 35
 T 3 N R 10 E

TYPE MONUMENT P.K./WASHER
 ON SURFACE - ~~BELOW~~ ON
 LEFT - ☉ PAV'T - ~~RIGHT~~ ON
- TO - EDGE PAVEMENT
 S.L.M. 629+01.28

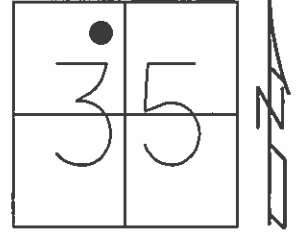

Grid: Northing: 553942.915 Easting: 1643370.426

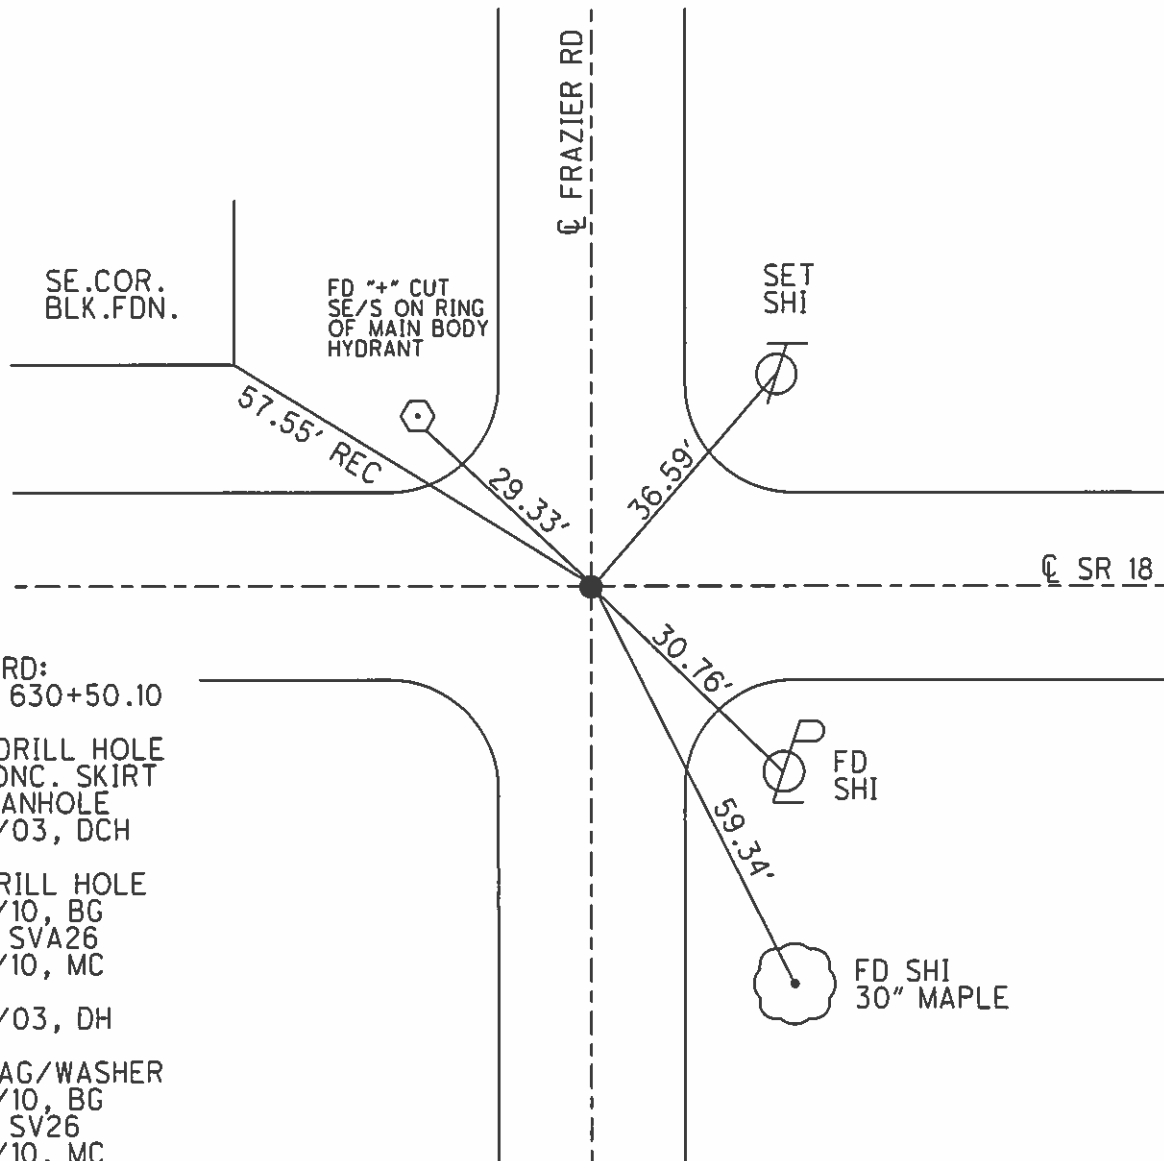

RECORD:
 STA. 630+50.10

SET DRILL HOLE
 IN CONC. SKIRT
 OF MANHOLE
 2/10/03, DCH

FD DRILL HOLE
 6/16/10, BG
 GPS, SVA26
 6/17/10, MC

2/10/03, DH

FD MAG/WASHER
 6/16/10, BG
 GPS, SV26
 6/17/10, MC

O.D.O.T. DISTRICT 2 SURVEY OFFICE

PERSONNEL

REFERENCE NO. 26-A

SHEET 13 OF

NOTES HOFFMAN

H.C. LOSHRKE

R.C. BARNHISEL

Sockman

DATE 6-17-87

WEATHER CLEAR

TEMP. 80°

ROUTE SR 18

COUNTY WOOD

TOWNSHIP HENRY

SECTION 35

T3 N R 10 E

TYPE MONUMENT SMALL RR SPIKE


ON SURFACE - ~~BELOW~~ YES

~~LEFT & PAV'T.~~ - ~~RIGHT~~ BOTH Pav'ts


 TO EDGE PAVEMENT

S.L.M. 629 + 90

Set P.K. / washer
7-24-87
SOH

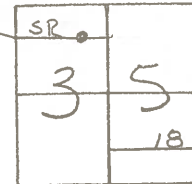

RECORD!
Sta. 630 + 50.10

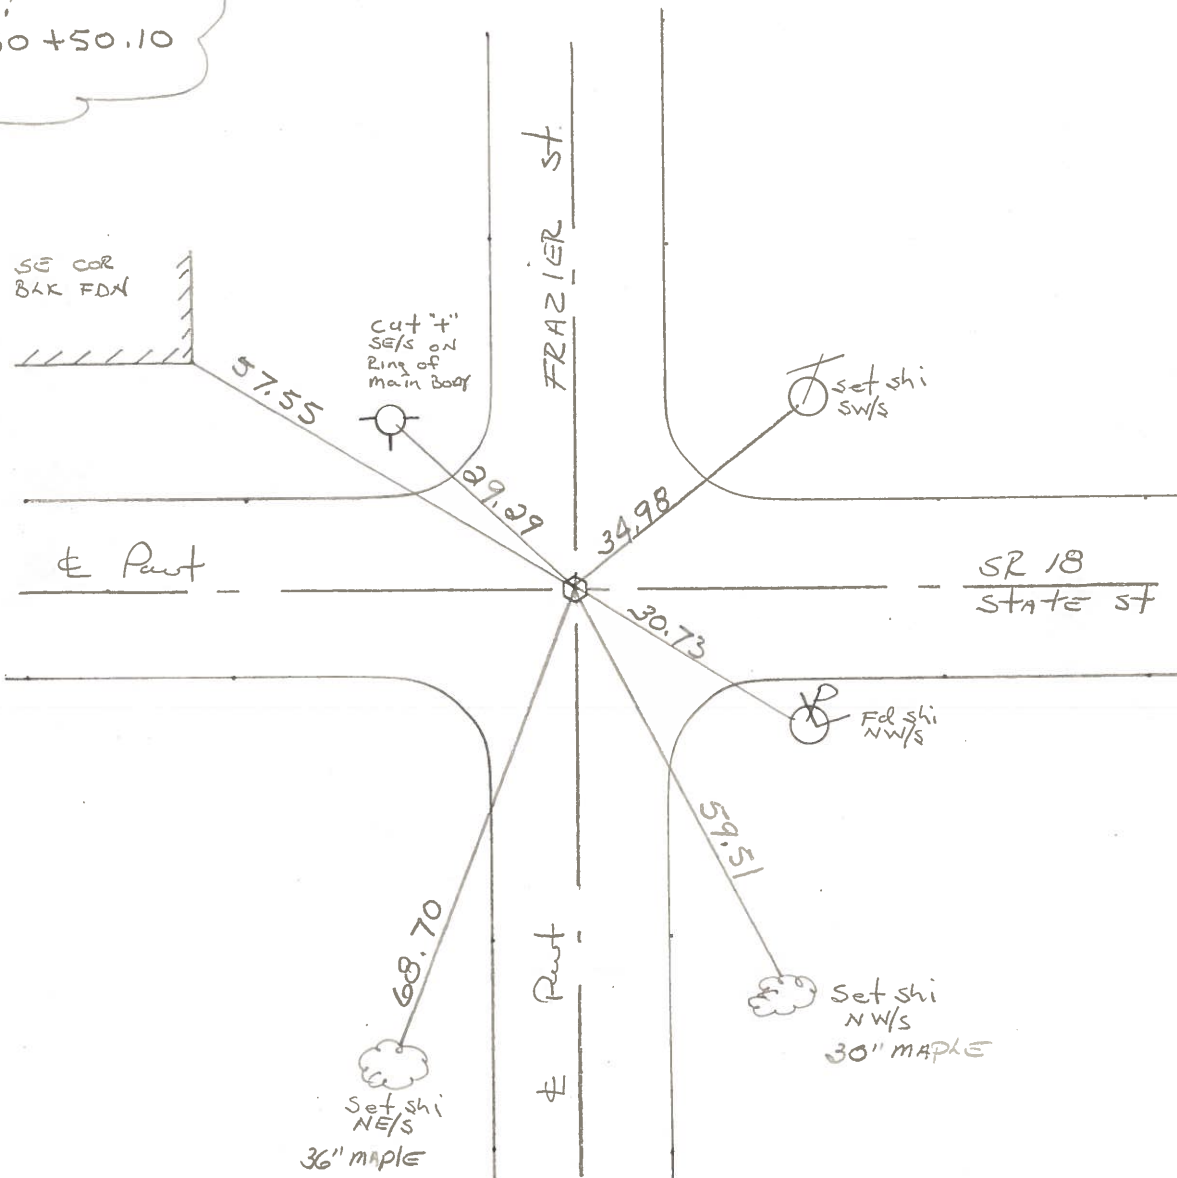

O.D.O.T. DISTRICT 2 SURVEY OFFICE

Sht. 7 of 22
S-R-18

County WOOD

Township HENRY

Section N. BALTIMORE



T N, R E

Personnel BURNSIDE
SMITH
BOWERS
KAPE
MEAD


Date 6-15-78

Weather CLEAR

Temp. +70

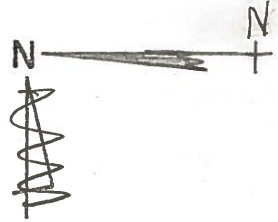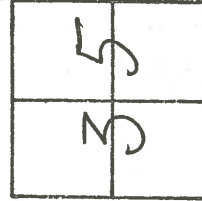

#26-A

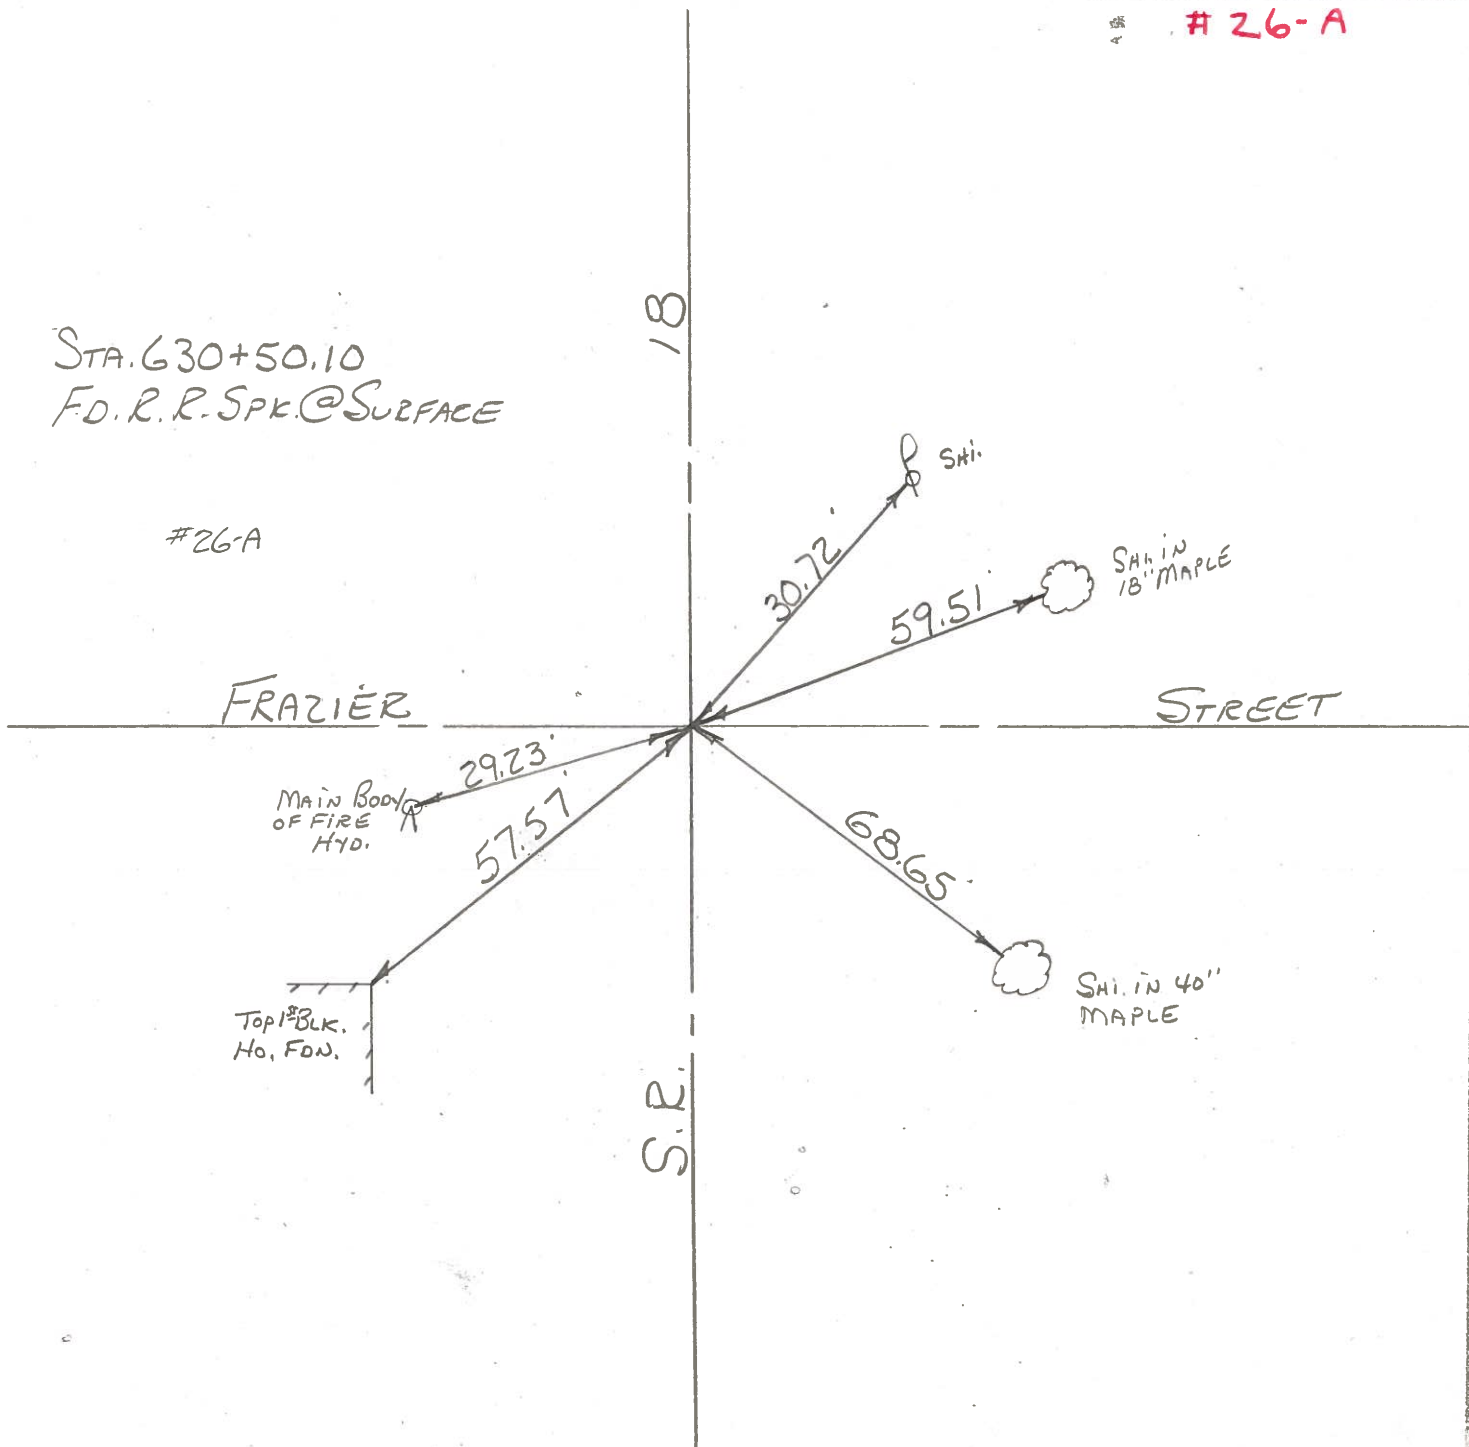

PERSONNEL	TITLE	PERSONNEL	TITLE	COUNTY	DATE
BURNSIDE				WOOD	1-4-71
SMITH				S. R. #18	WEATHER CLOUDY
BOWERS				SEC. 11.55-12.63	TEMP. +20°
HOLCOMBE					

DESCRIPTION	LEFT	CENTER LINE	RIGHT	JOB NO.
-------------	------	-------------	-------	---------

