


FOR ANY QUESTIONS PLEASE CONTACT ODOT DISTRICT 2 REAL ESTATE AT 419-363-8131

July 1997

R/W OK as shown F.S.F 4/8/44

**WOOD CO.**  
**S.H.224 SEC. N. BALTIMORE**  
**R./W. PLANS**

DATE: FEB. 1936. DRAWN BY: A.P.  
 REVISED  
 LENGTH OF PROJECT = 0.50 MI.

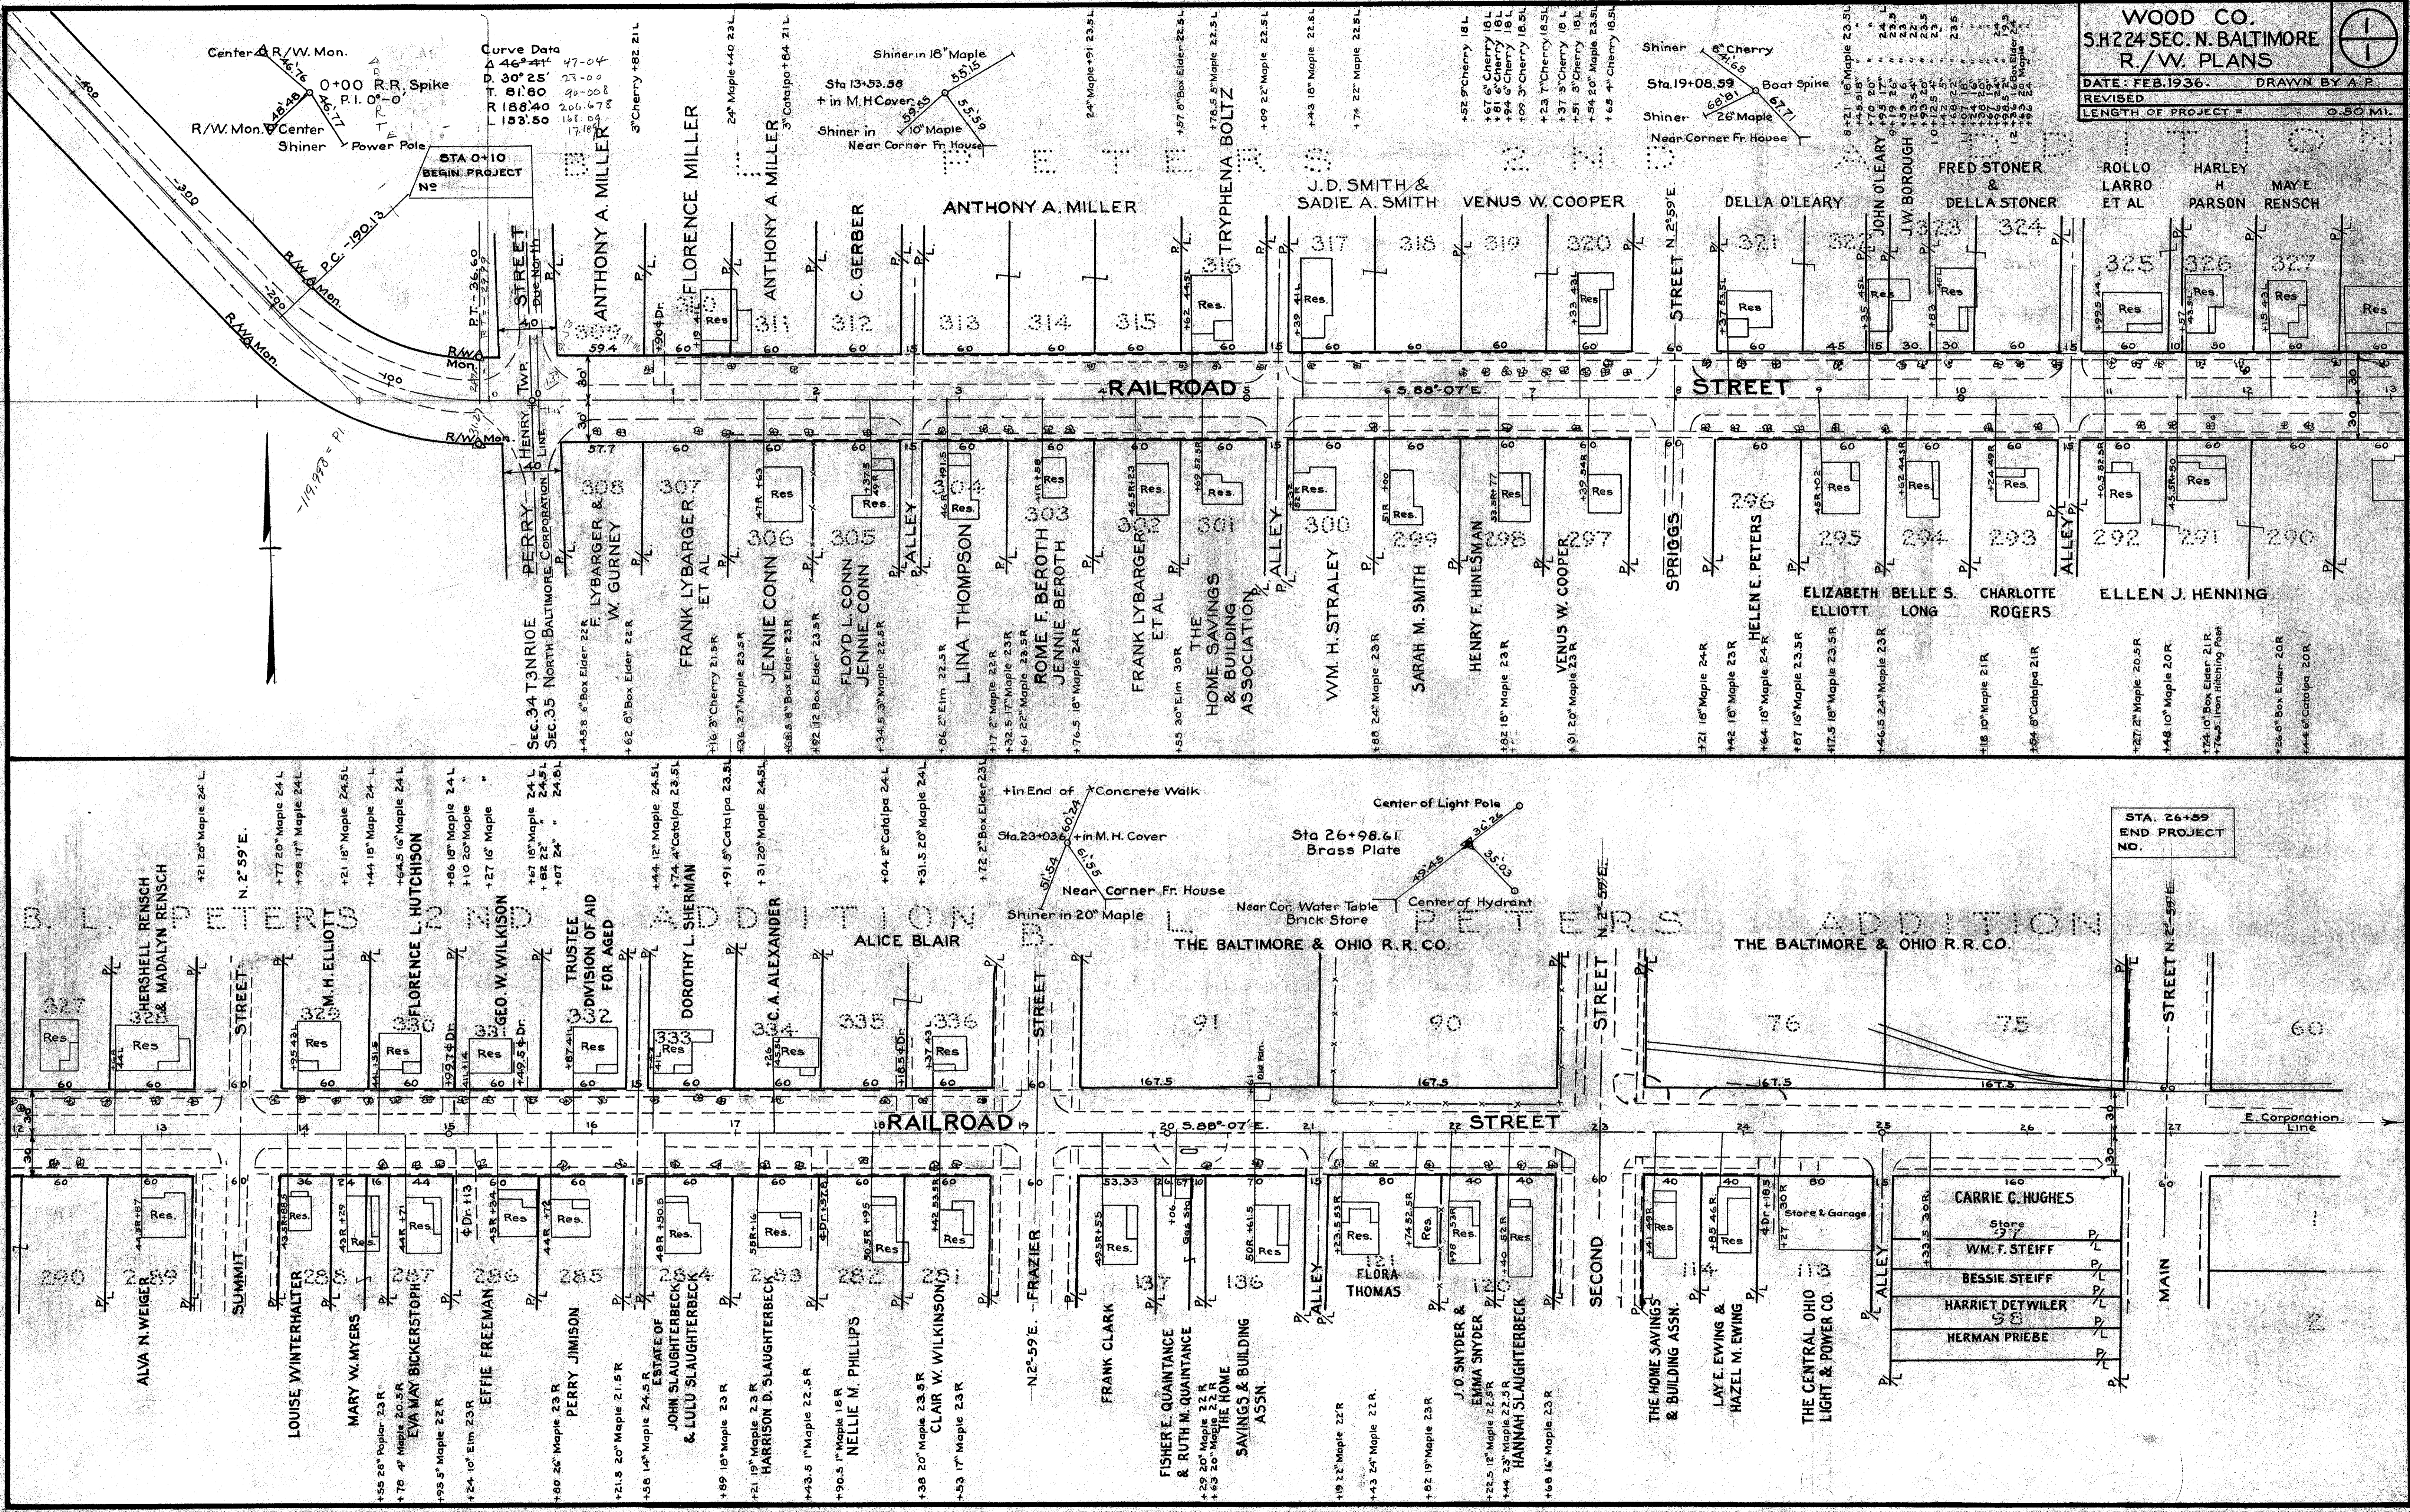

11-0 R-8018 9f

D-11