

O.D.O.T. DISTRICT 2 SURVEY OFFICE (USE ONLY)

PERSONNEL _____

REFERENCE NO. 13A

SHEET 5 OF 52

NOTES NIESE DATE 10/28/24
 H.C. NIESE WEATHER CLEAR
 R.C. PRESTON-COLVIN TEMP. 42°F

ROUTE SR 18
 COUNTY WOOD
 TOWNSHIP JACKSON
 SECTION 25
 T 3 N R 9 E

DWG BY BARRIERE PID 101290

TYPE MONUMENT MAGNAIL/WASHER

ON SURFACE - BELOW ON

OFFSET \odot PAVEMENT 1' LT LT : RT

_____ TO _____ EDGE PAVEMENT

STATION: _____

HORZ. DATUM: WOOD LDP


GEOID: 18

GRID: NORTHING: 378924.939

EASTING: 127076.686

LDP: NORTHING: 557574.922

EASTING: 1615044.014

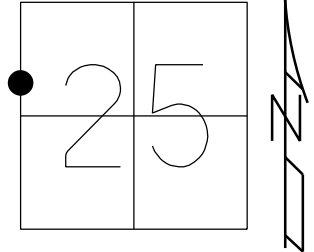

RECORD:
 FD MAG
 2/1/23, JAM
 5/21/24, TDN
 SET MAG/WASHER
 10/28/24, TDN

NOTE: REF4A SR 235

