


O.D.O.T. DISTRICT 2 SURVEY OFFICE (USE ONLY)


PERSONNEL _____ REFERENCE NO. 15 B SHEET 3 OF 51
 NOTES BARNHISEL DATE 3/19/91 ROUTE SR 18
 H.C. LOEHRKE WEATHER CLOUDY/WINDY COUNTY WOOD
 R.C. HOFFMAN TEMP. 45° TOWNSHIP JACKSON
 DWG BY O'DONNELL PID PAVETRAIN SECTION 26
 T 3 N R 9 E

TYPE MONUMENT P.K./WASHER
 ON SURFACE - ~~BELOW~~ ON
 LEFT - ☉ PAV'T - RIGHT ON ☉ E.
- TO - EDGE PAVEMENT
 STATION: 343+47.58

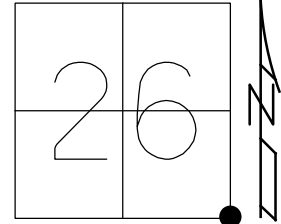

HORIZ.DATUM: NAD83 (2011) GEOID: NAVD88-2012A
 GRID: NORTHING: 554946.063 EASTING: 1615008.300

NOTE:
 27.5' E. OF ☉ SR 235
 FD MAG/WASHER
 GPS, SV B15
 6/16/10, BG
 FD MAG NAIL
 REFB15
 6/15/20, JFO

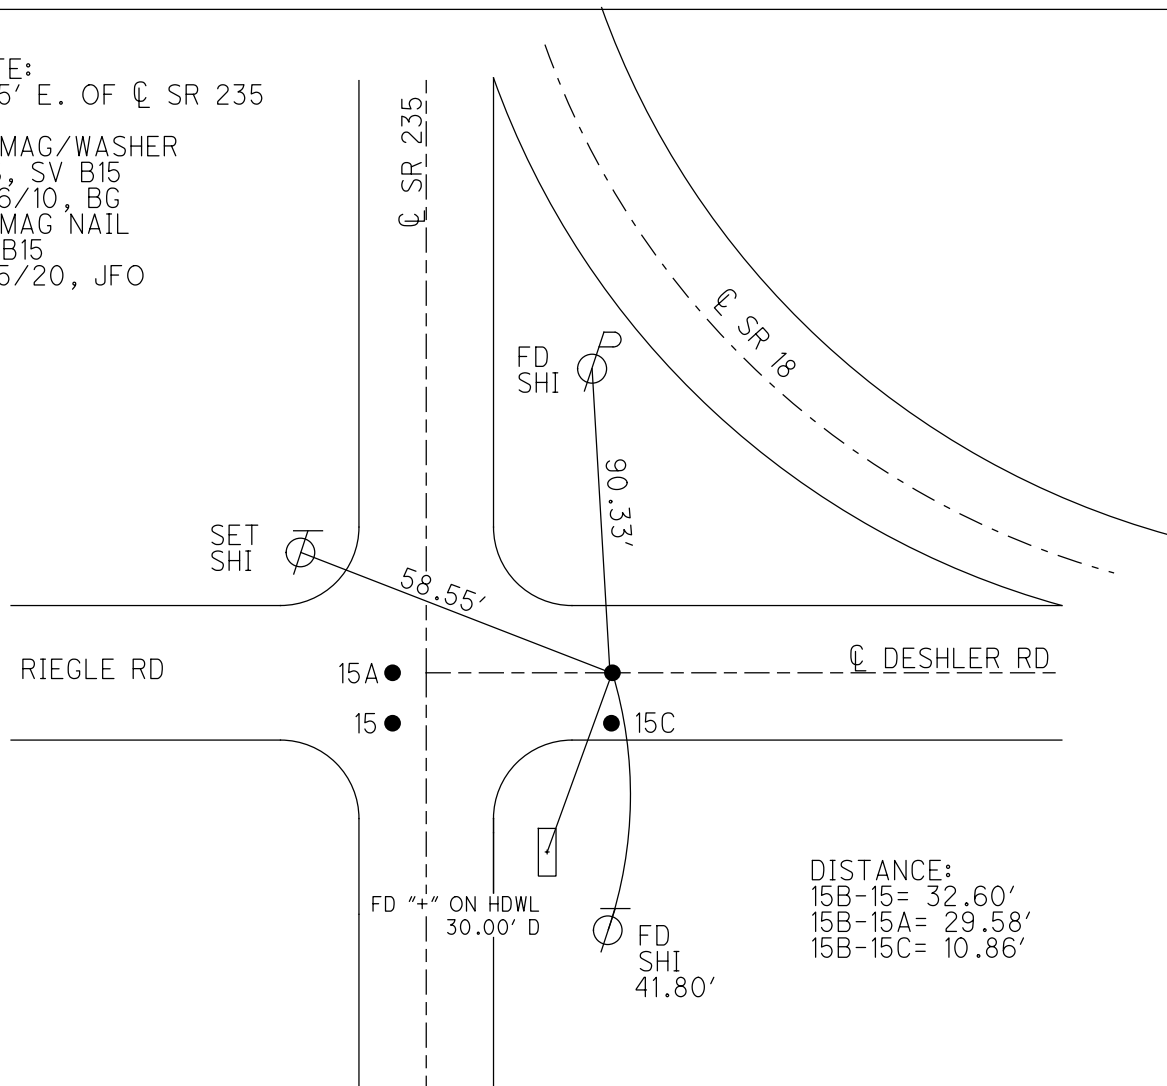


O.D.O.T. DISTRICT 2 SURVEY OFFICE (USE ONLY)

PERSONNEL _____ REFERENCE NO. 3 C SHEET 8 OF 8

NOTES NUHFER DATE 5-06-04 ROUTE SR 235
 H.C. CANERBURY WEATHER SUNNY COUNTY WOOD
 R.C. ARMS TEMP. 65°F TOWNSHIP JACKSON
 SECTION 26
 T 3 N R 9 E

TYPE MONUMENT MAG/WASHER
 ON SURFACE - ~~BELOW~~ ON _____
~~LEFT~~ - ☉ PAV'T - RIGHT 27.5'
 - TO - EDGE PAVEMENT
 S.L.M. 53+87

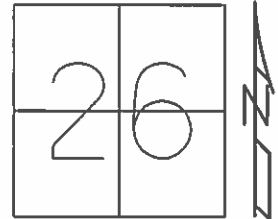


Grid: Northing: 554945.976 Easting: 1615008.281

RECORD:
 PK SHINER @ 2" DOWN
 ON ☉ PAVEMENT EAST
 27.5 E. OF ☉ S.R. 235

- REF 3B TO REF 3C = 10.99'
- REF 3B TO REF 3A = 31.68'
- REF 3B TO REF 3 = 30.84'
- REF 3C TO REF 3A = 29.60'
- REF 3C TO REF 3 = 32.65'
- REF 3A TO REF 3 = 11.05'

SET MAG/WASHER
 ALL FOUR POINTS
 08-03-04, MC

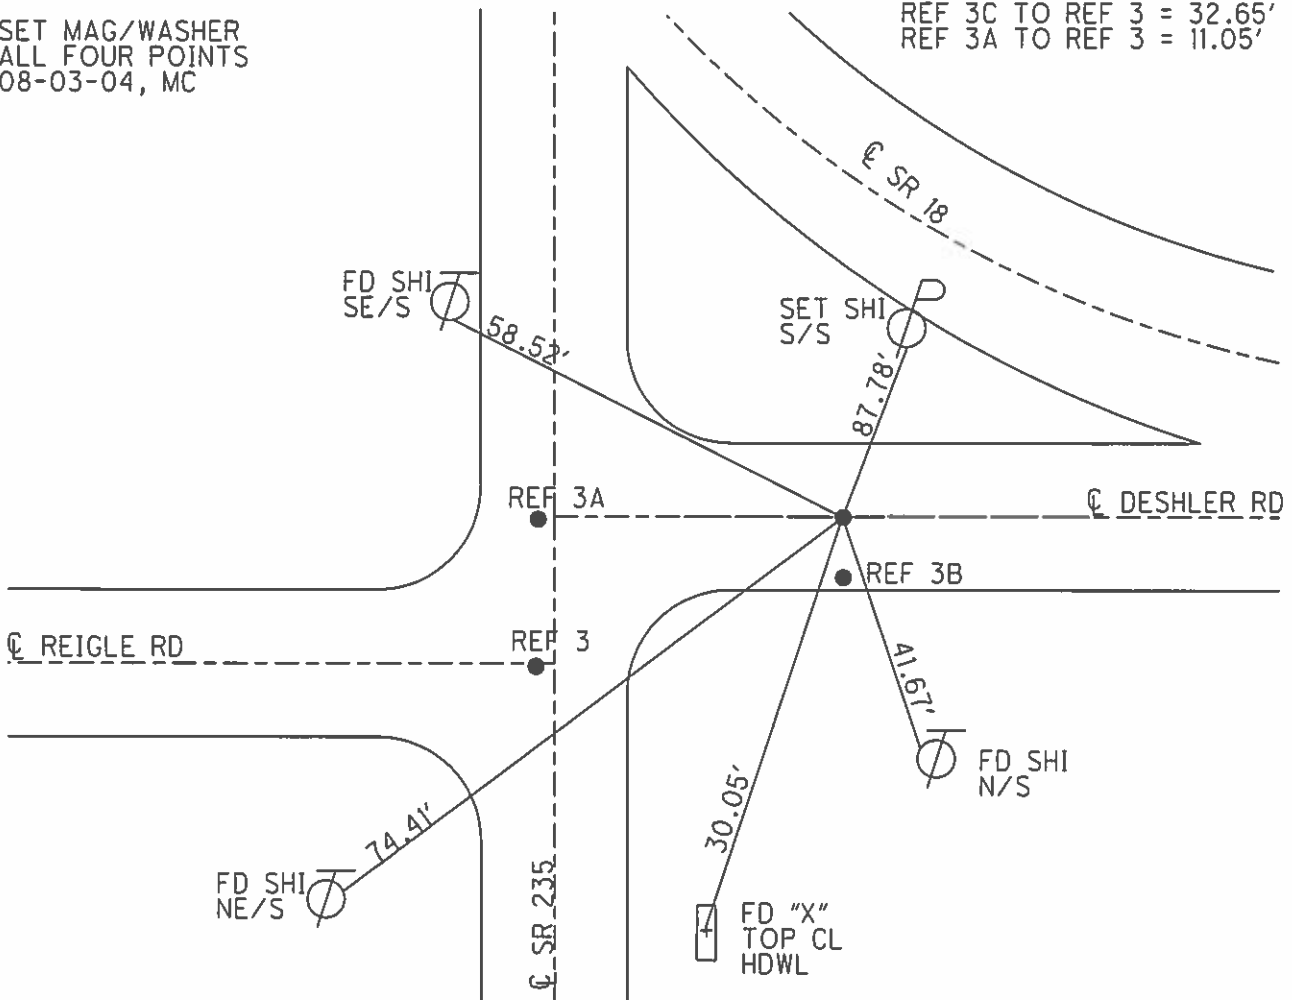


O.D.O.T. DISTRICT 2 SURVEY OFFICE (USE ONLY)

PERSONNEL _____ REFERENCE NO. 15 B SHEET 3 OF 26

NOTES BARNHISEL DATE 3/19/91 ROUTE SR 18
 H.C. LOEHRKE WEATHER CLOUDY/WINDY COUNTY WOOD
 R.C. HOFFMAN TEMP. 45° TOWNSHIP JACKSON
 _____ SECTION 26
 _____ T 3 N R 9 E


TYPE MONUMENT P.K./WASHER
 ON SURFACE - ~~BELOW~~ ON _____
 LEFT - ☉ PAV'T - RIGHT ON ☉ E.
 - TO - EDGE PAVEMENT
 S.L.M. 343+47.58

Grid: Northing: 554946.078 Easting: 1615008.229

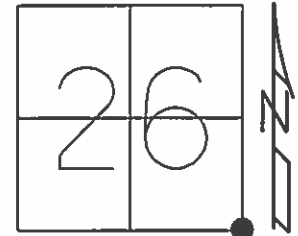

NOTE:
 27.5' E. OF ☉ SR 235

FD MAG/WASHER
 GPS, SV B15
 6/16/10, BG

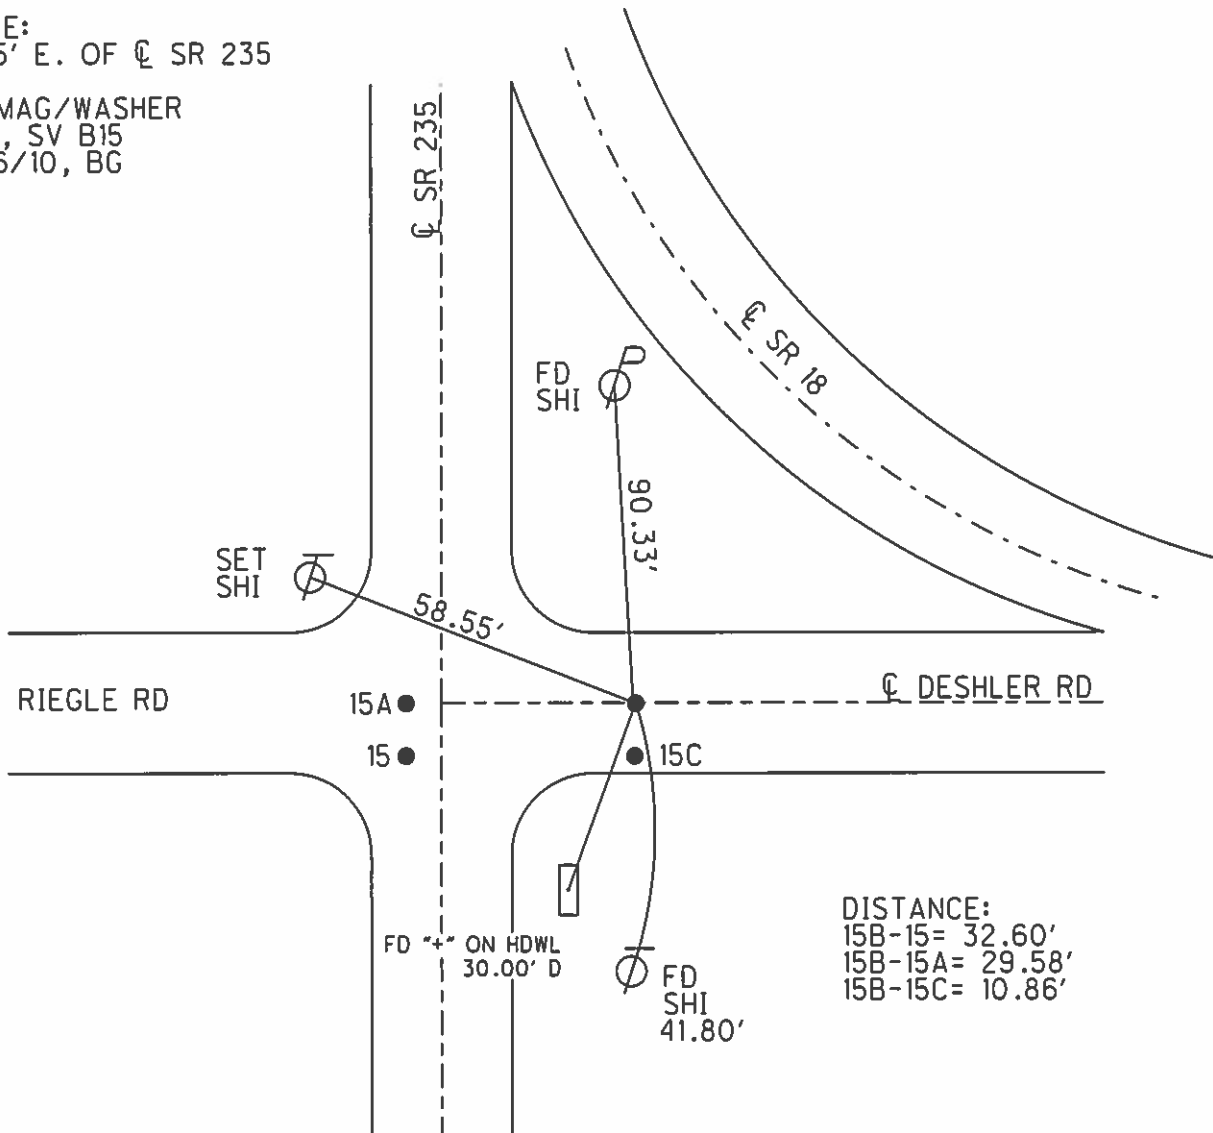

DISTANCE:
 15B-15= 32.60'
 15B-15A= 29.58'
 15B-15C= 10.86'

O.D.O.T. DISTRICT 2 SURVEY OFFICE

PERSONNEL _____

REFERENCE NO. 15

SHEET _____ OF _____

NOTES BARNHISEL

H.C. Loehake

DATE 3-19-91

ROUTE 18 & 235

R.C. HOFFMAN

WEATHER cloudy - Windy

COUNTY Wood

TEMP. +45°

TOWNSHIP JACKSON

SECTION 26

T 3 N R 9 E

TYPE MONUMENT P.K.'s & Washers


ON SURFACE - BELOW YES (ALL)

LEFT- & PAV'T. - RIGHT INFORMATION Below

- TO - EDGE PAVEMENT

S.L.M. NOT COVERED IN 1991 RESURFACING OF S.R. 18

PT. "D"
1/2" IRON PIN
1 1/2" DOWN

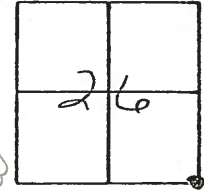


PT. "A"
11.0 S. OF & EAST,
27.5 E. OF & S.R. 235

PT. "B"
ON & PAVT E.
27.5 E. OF & S.R. 235

PT. "C"
ON & PAVT E.
2.2 W. OF & S.R. 235

PT. "D"
11.0 S. OF & E.
2.5 W. OF & S.R. 235
2" DOWN

A TO B	=	10.86
B TO C	=	29.58
A TO C	=	31.63
C TO D	=	11.03
D TO A	=	30.83
D TO B	=	32.60

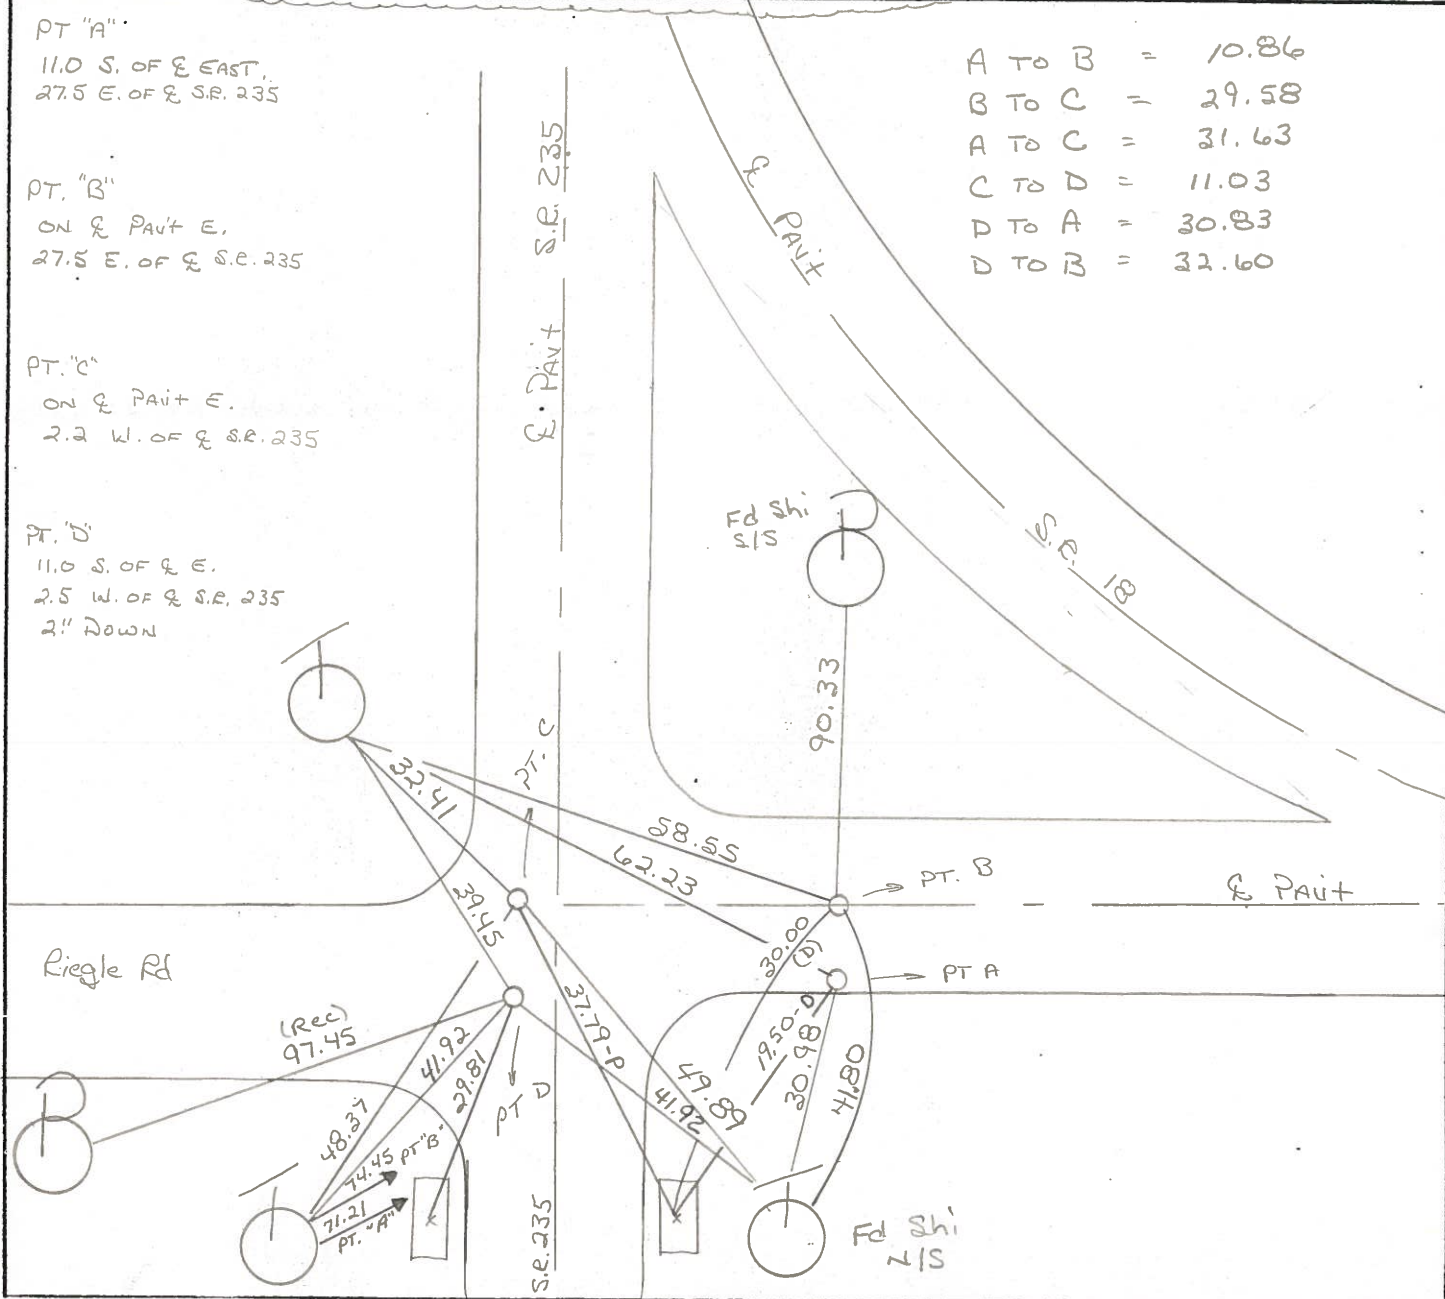

ED "X" ON BOTH HDWS

County WOOD S.R. 18

Date 11-28-83

Township JACKSON

Weather RAIN, CLOUDY


Section 26

Temp. +40°

T. N, R. E

Personnel

BARNHISEL	H.C
HOUSEHOLDER	R.C
LOEHRKE	

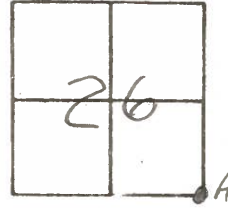


"A" RR SPIKE @ SURFACE OVER STONE
 SLM 53+75 (SR 235)
 10.9 S of Q PAVT 18 #15
 27.1 E of Q PAVT 235

"C" RR SPIKE @ SURFACE
 SLM 53+86 (SR 235)
 ON Q PAVT SR 18 E
 2.5' W of Q PAVT 235

#15

"B" BOAT SPIKE @ SURFACE
 SLM 53+86 (SR 235)
 ON CL PAVT 18
 27.1 E of Q PAVT 235

SET PK+WASHEN
 @ ALL PTS
 7-25-85
 C.L.

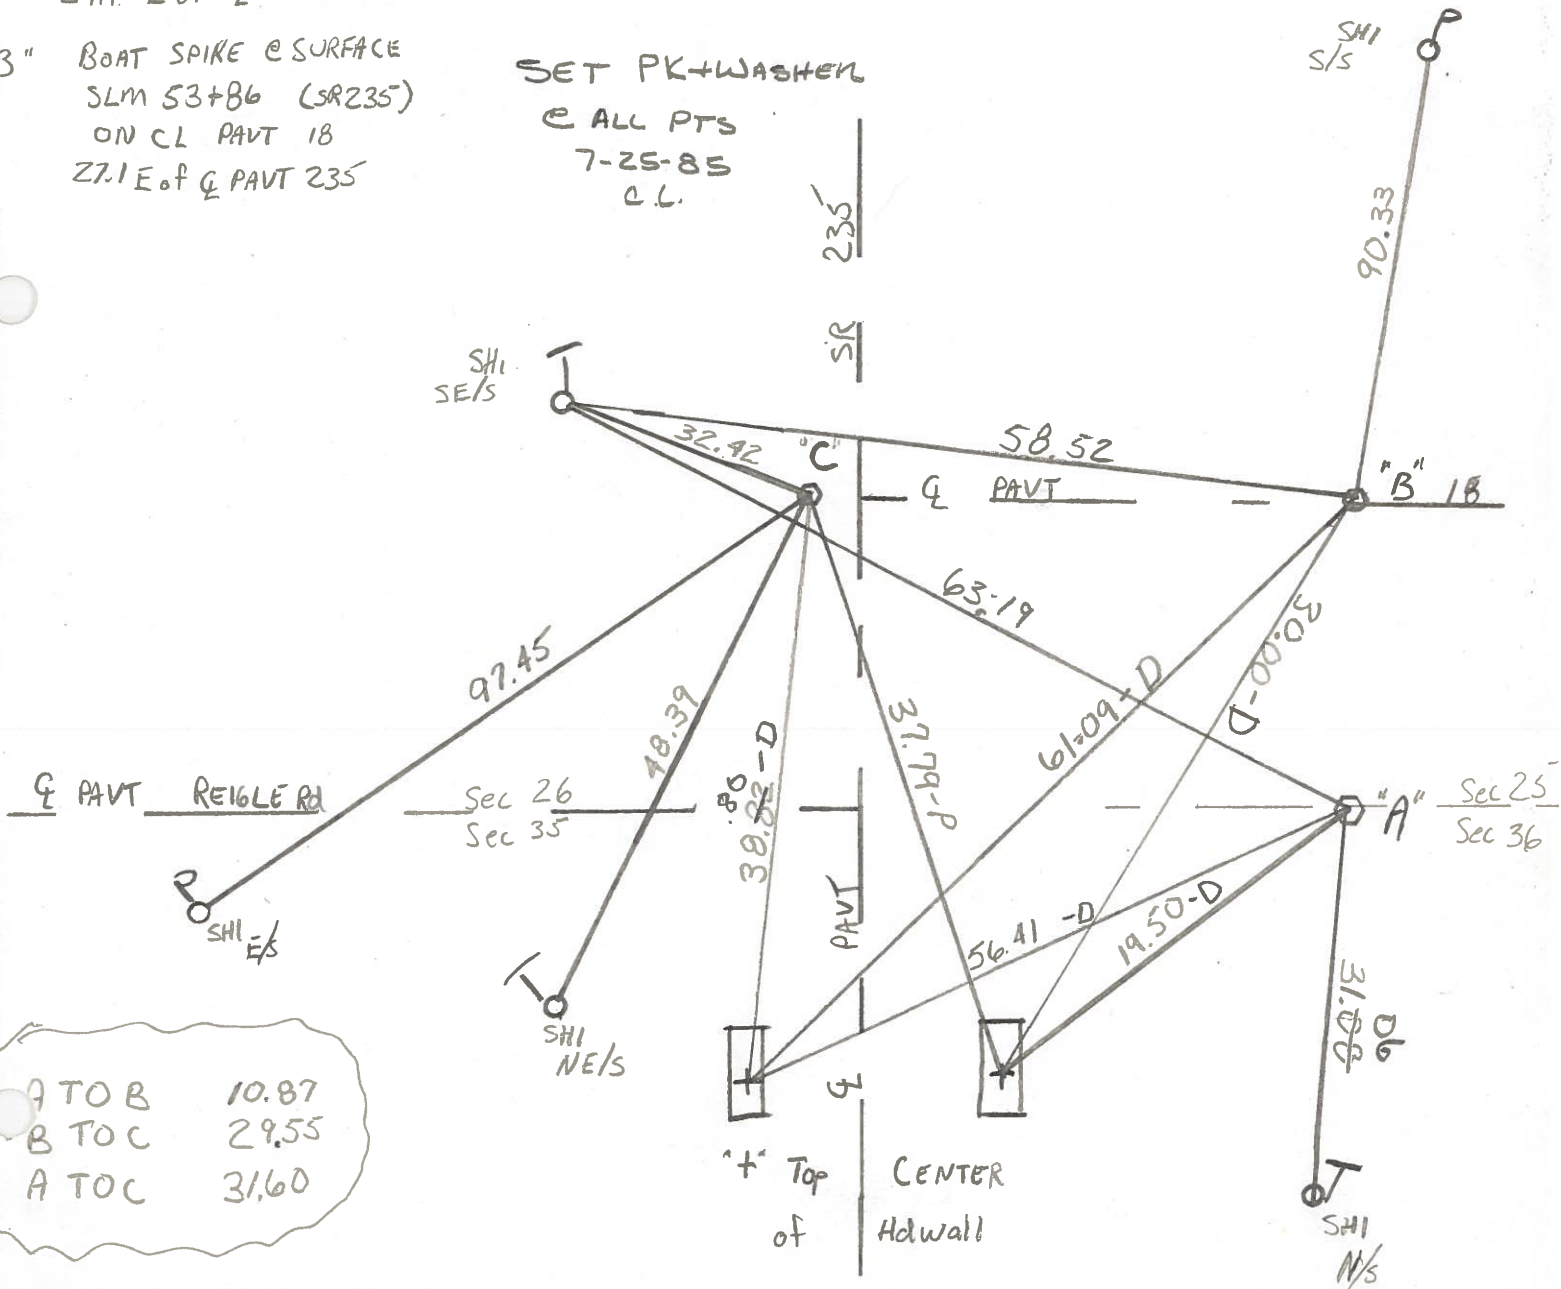

A TO B	10.87
B TO C	29.55
A TO C	31.60