


O.D.O.T. DISTRICT 2 SURVEY OFFICE (USE ONLY)


PERSONNEL _____ REFERENCE NO. 15 C SHEET 4 OF 51
 NOTES BARNHISEL DATE 3/19/91 ROUTE SR 18
 H.C. LOEHRKE WEATHER CLOUDY/WINDY COUNTY WOOD
 R.C. HOFFMAN TEMP. 45°F TOWNSHIP JACKSON
 SECTION 26
 DWG BY O'DONNELL PID PAVETRAIN T 3 N R 9 E

TYPE MONUMENT P.K./WASHER
 ON SURFACE - ~~BELOW~~ ON _____
 LEFT - ☉ PAV'T - RIGHT 11.0' S. OF ☉ E.
 - TO - EDGE PAVEMENT
 STATION: 343+47.58

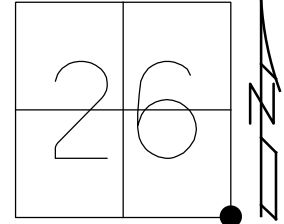

HORZ.DATUM: NAD83 (2011) GEOID: NAVD88-2012A
 GRID: NORTHING: 554935.113 EASTING: 1615008.337

NOTE:
 27.5' E. OF ☉ SR 235
 FD MAG/WASHER
 GPS, SV A15
 6/16/10, BG
 FD PK/WASHER
 1-1/2" DOWN
 REFC15
 6/15/20, JFO

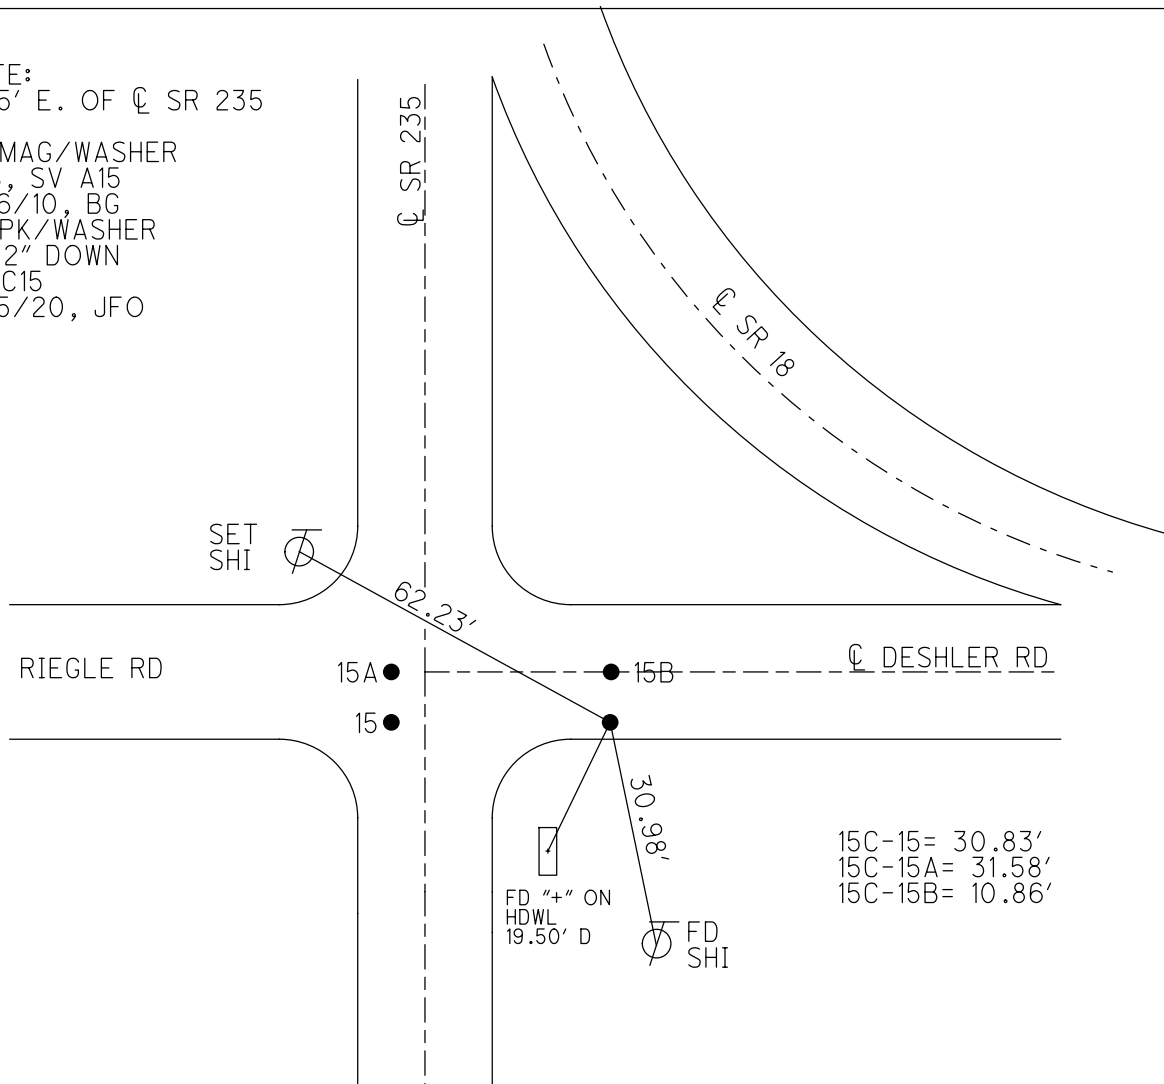


15C-15 = 30.83'
 15C-15A = 31.58'
 15C-15B = 10.86'

O.D.O.T. DISTRICT 2 SURVEY OFFICE (USE ONLY)

PERSONNEL _____ REFERENCE NO. 3 B SHEET 7 OF 8

NOTES NUHFER DATE 5-06-04 ROUTE SR 235
 H.C. CANERBURY WEATHER SUNNY COUNTY WOOD
 R.C. ARMS TEMP. 65°F TOWNSHIP JACKSON
 _____ SECTION 25
 _____ T 3 N R 9 E

TYPE MONUMENT MAG/WASHER
 ON SURFACE - ~~BELOW~~ ON _____
~~LEFT~~ - ℄ PAV'T - RIGHT 27.5'
 - TO - EDGE PAVEMENT
 S.L.M. 53+77

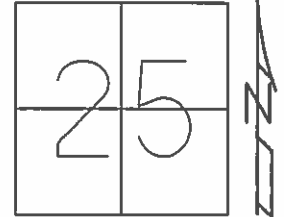


Grid: Northing: 554935.000 Easting: 1615008.353

RECORD:
OVER STONE

PK SHINER@SURFACE
11.0 S. OF ℄ EAST
27.5 E. OF ℄ S.R. 235

SET MAG/WASHER
ALL FOUR POINTS
08-03-04, MC

REF 3B TO REF 3C = 10.99'
 REF 3B TO REF 3A = 31.68'
 REF 3B TO REF 3 = 30.84'
 REF 3C TO REF 3A = 29.60'
 REF 3C TO REF 3 = 32.65'
 REF 3A TO REF 3 = 11.05'

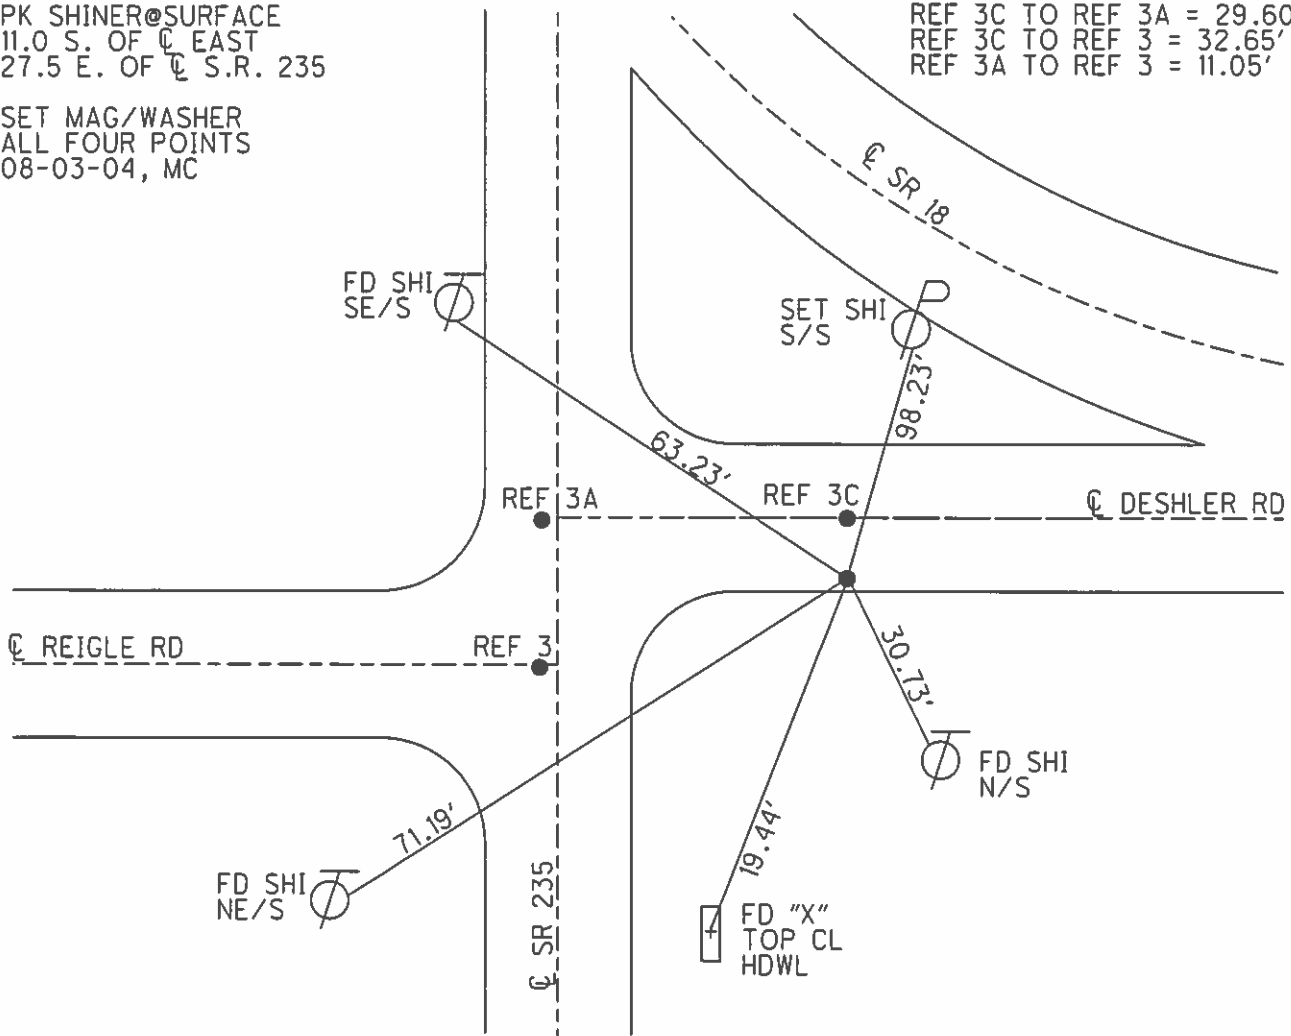

O.D.O.T. DISTRICT 2 SURVEY OFFICE

PERSONNEL _____

REFERENCE NO. 15

SHEET _____ OF _____

NOTES BARNHISEL

H.C. Loehake

DATE 3-19-91

ROUTE 18 & 235

R.C. HOFFMAN

WEATHER cloudy - Windy

COUNTY Wood

TEMP. +45°

TOWNSHIP JACKSON

SECTION 26

T 3 N R 9 E

TYPE MONUMENT P.K.'s & Washers


ON SURFACE - BELOW YES (ALL)

LEFT- & PAV'T. - RIGHT INFORMATION Below

- TO - EDGE PAVEMENT

S.L.M. NOT COVERED IN 1991 RESURFACING OF S.R. 18

PT. "D"
1/2" IRON PIN
1 1/2" DOWN

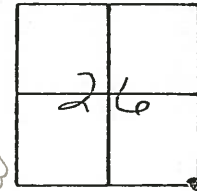


PT. "A"
11.0 S. OF & EAST,
27.5 E. OF & S.R. 235

PT. "B"
ON & PAVT E.
27.5 E. OF & S.R. 235

PT. "C"
ON & PAVT E.
2.2 W. OF & S.R. 235

PT. "D"
11.0 S. OF & E.
2.5 W. OF & S.R. 235
2" DOWN

A TO B	=	10.86
B TO C	=	29.58
A TO C	=	31.63
C TO D	=	11.03
D TO A	=	30.83
D TO B	=	32.60

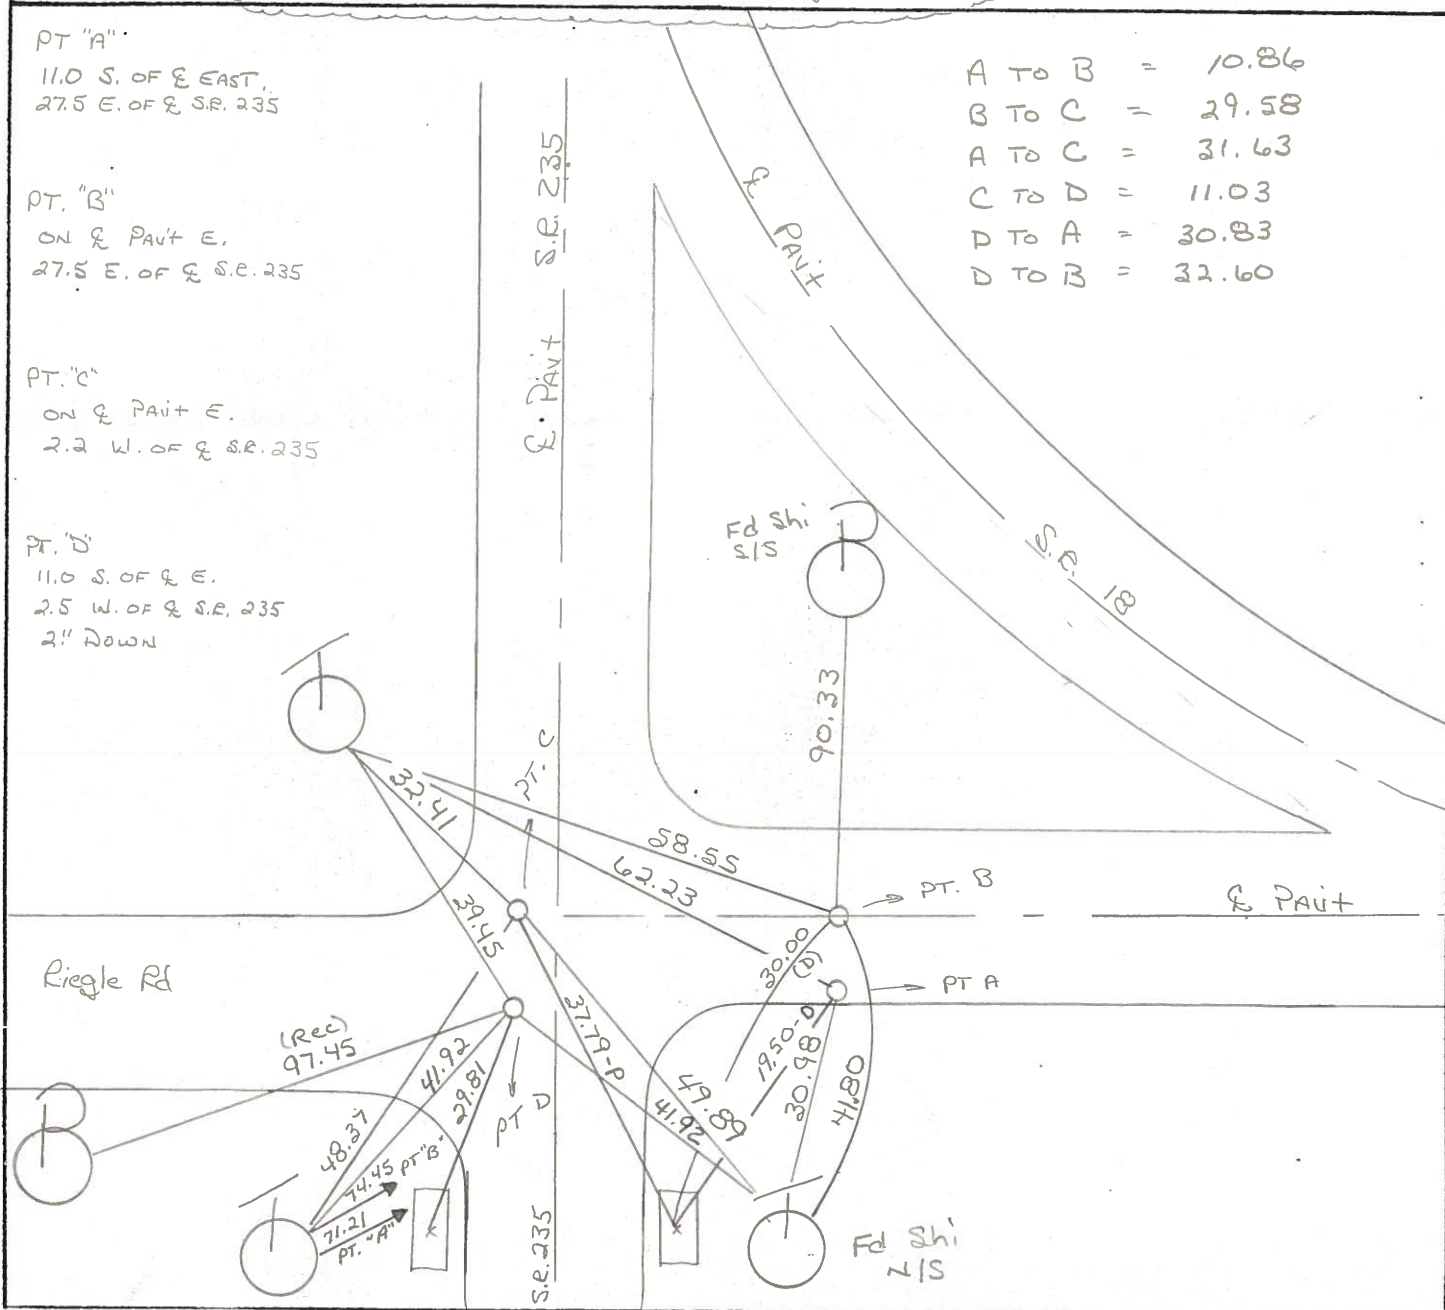

Ed "x" ON BOTH HDWS

County WOOD S.R. 18

Date 11-28-83

Township JACKSON


Weather RAIN, CLOUDY

Section 26

Temp. +40°

T N, R E

Personnel BARNHISEL H.C
HOUSEHOLDER R.C
LOEHRKE

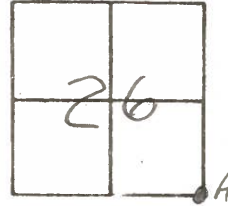


"A" RR SPIKE @ SURFACE OVER STONE
 SLM 53+75 (SR 235)
 10.9 S of & PAVT 18
 27.1 E of & PAVT 235

"C" RR SPIKE @ SURFACE
 SLM 53+86 (SR 235)
 ON & PAVT SR 18 E
 2.5' W of & PAVT 235

#15

"B" BOAT SPIKE @ SURFACE
 SLM 53+86 (SR 235)
 ON CL PAVT 18
 27.1 E of & PAVT 235

SET PK+WASHEN
 @ ALL PTS
 7-25-85
 C.L.

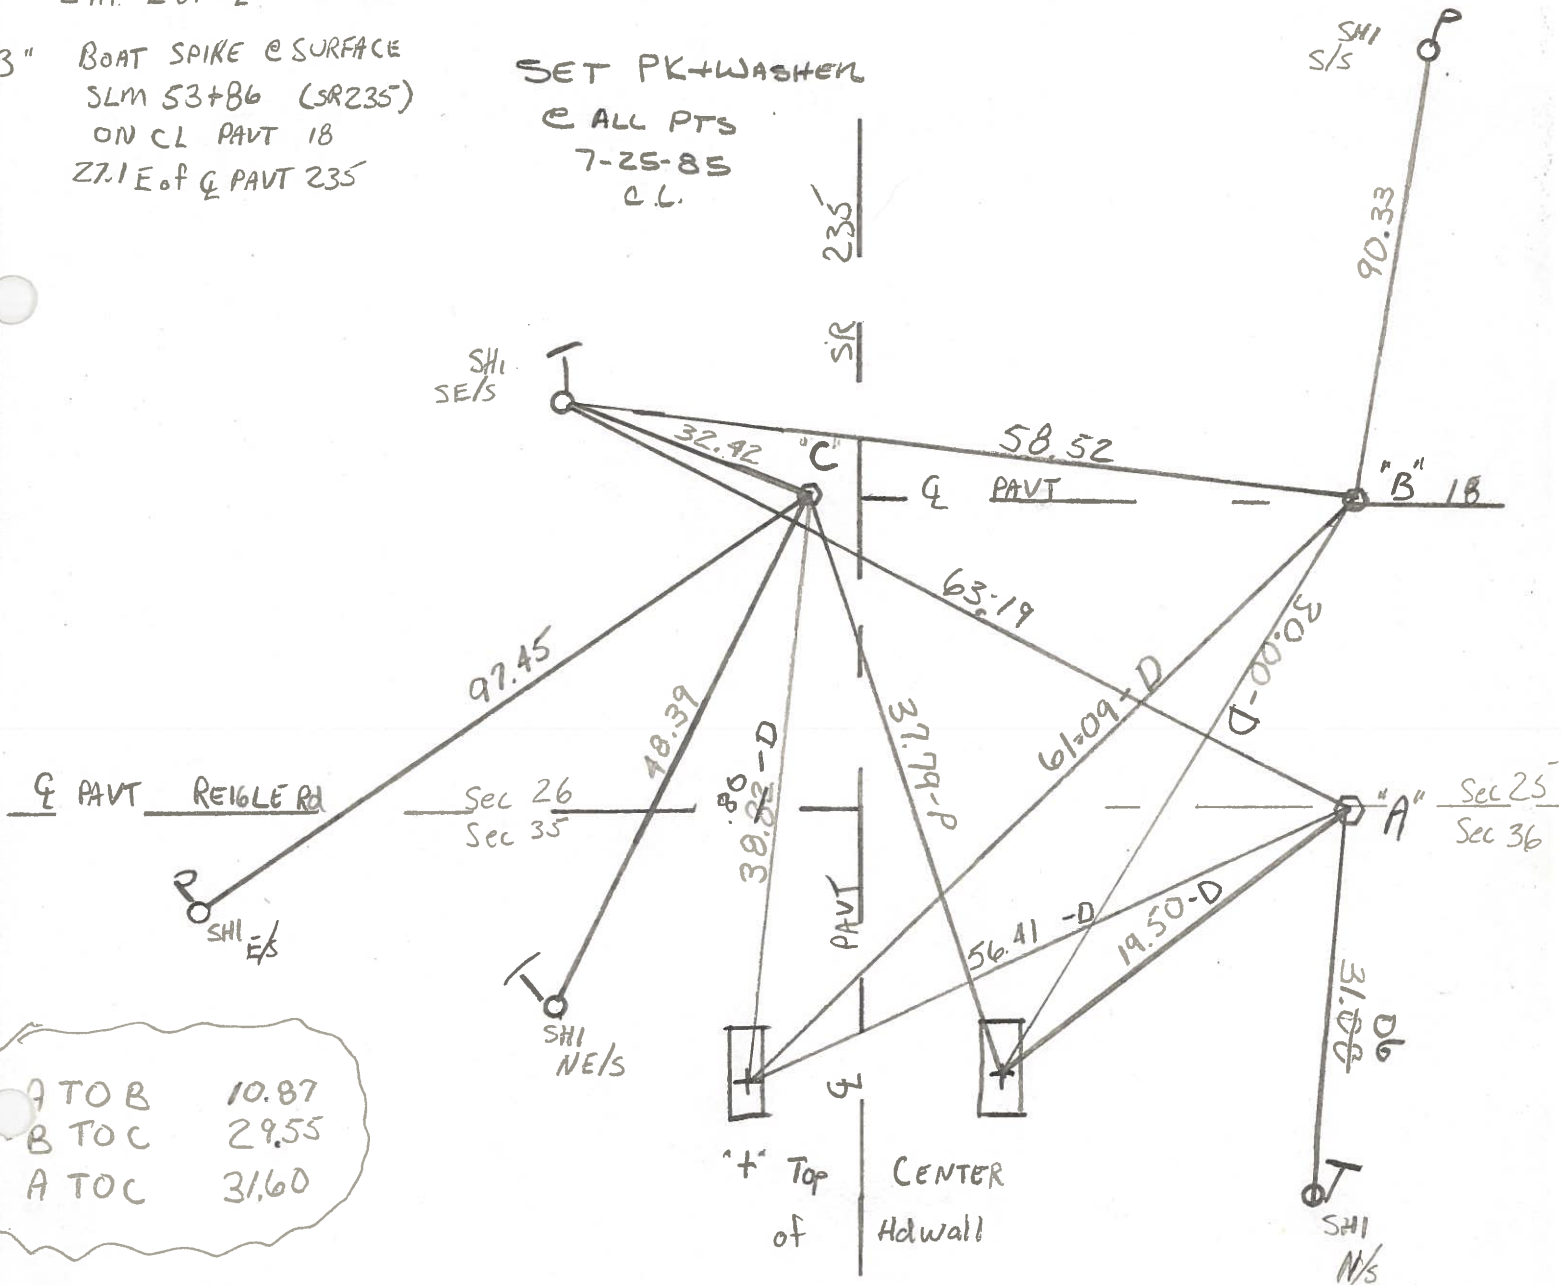

A TO B 10.87
 B TO C 29.55
 A TO C 31.60