

O.D.O.T. DISTRICT 2 SURVEY OFFICE (USE ONLY)

PERSONNEL

REFERENCE NO. 24 A

SHEET 5 OF 52

NOTES ASTON DATE 5/22/24
 H.C. NIESE WEATHER SUNNY
 R.C. PRESTON-COLVIN TEMP. 80°F

ROUTE SR 18
 COUNTY WOOD
 TOWNSHIP HENRY
 SECTION 33
 T 3 N R 10 E

DWG BY BARRIERE PID 101290

TYPE MONUMENT MONBOX W/ 1" IPIN

ON SURFACE - BELOW ON

OFFSET \varnothing PAVEMENT _____ LT : RT

_____ TO _____ EDGE PAVEMENT

STATION: 543+69.18

HORIZ.DATUM: WOOD LDP


GEOID: 18

GRID: NORTHING: 554700.829

EASTING: 1634925.999

LDP: NORTHING: 376312.942

EASTING: 146996.510

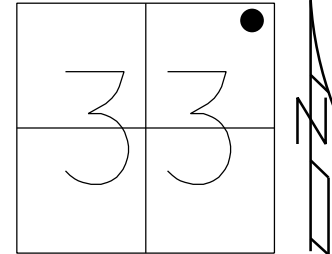

RECORD: CS
 STA. 543+69.18
 FD MONBOX
 W/1" IPIN
 REFA24
 6-15-20, JFO
 FD MONBOX, NO LID
 W/1" IPIN
 REF 42A
 5/22/24, TDN

