

O.D.O.T. DISTRICT 2 SURVEY OFFICE (USE ONLY)

PERSONNEL

REFERENCE NO. 27 A

SHEET 1 OF 19

NOTES HOMAN

DATE 8/4/14

ROUTE SR 18

H.C. LEU

WEATHER SUNNY

COUNTY WOOD

R.C. THOMAS

TEMP. 75°

TOWNSHIP HENRY

DWG BY MILLER

PID 93417

SECTION 35

T 3 N R 10 E

TYPE MONUMENT MAG/WASHER

ON SURFACE - ~~BELOW~~ ON

OFFSET Q PAVEMENT ON LT : RT

- TO - EDGE PAVEMENT


STATION: 645+00.42

HORZ.DATUM: NAD83 (2011)

GEOID: 2012A


GRID: NORTHING: 553260.497

EASTING: 1644153.153

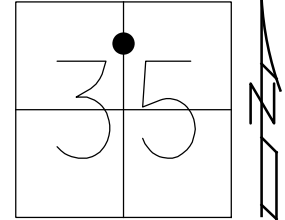

RECORD:


STA 645+00.25  
 Q SURVEY WATER ST  
 Q SURVEY SR 18  
 SET MAG/WASHER  
 2/13/03, DCH  
 FD MAG/WASHER  
 REFA27  
 8-4-14, DCH  
 SET MAG/WASHER  
 COREFA27  
 9-2-16, DCH

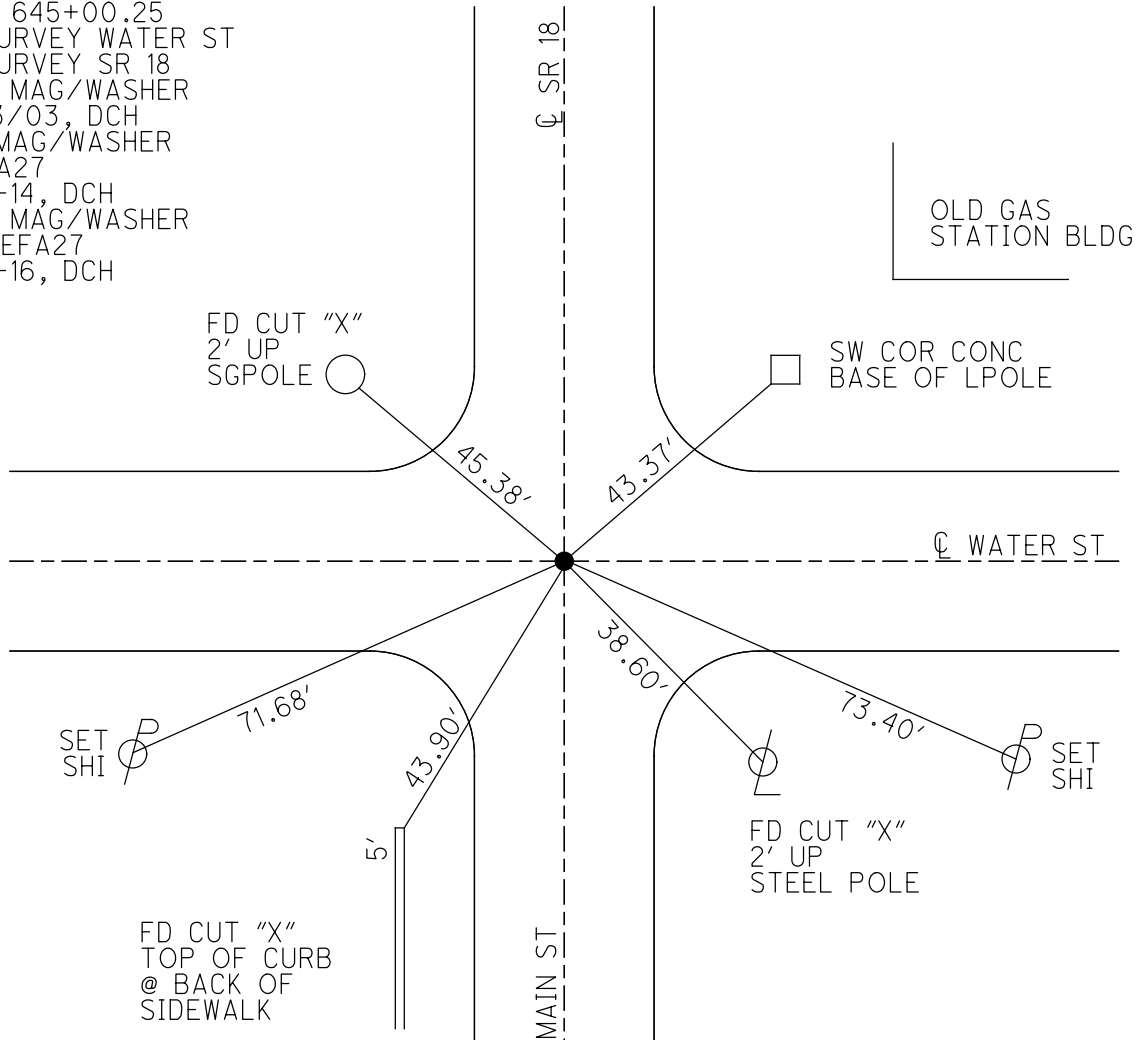

**O.D.O.T. DISTRICT 2 SURVEY OFFICE (USE ONLY)**


PERSONNEL	REFERENCE NO.	27 A	SHEET	1	OF	18
NOTES	HOMAN	DATE	7/8/02	ROUTE	SR 18	
H.C.	ZEBROWSKI	WEATHER	SUNNY	COUNTY	WOOD	
R.C.	MICHALAK	TEMP.	75°	TOWNSHIP	HENRY	
	BEAUMONT			SECTION	35	
				T	3	N
				R	10	E

TYPE MONUMENT P.K./WASHER  
 ON SURFACE - ~~BELOW~~ ON  
 LEFT - ☉ PAV'T - RIGHT ON  
     -      TO      EDGE PAVEMENT  
 S.L.M. 644+45

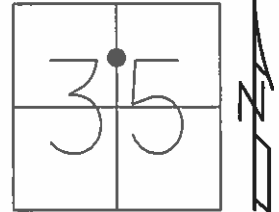

Grid: Northing: \_\_\_\_\_ Easting: \_\_\_\_\_

RECORD:  
 STA 645+00.25  
 ☉ SURVEY WATER ST  
 ☉ SURVEY SR 18  
 SET MAG/WASHER  
 2/13/03, DCH

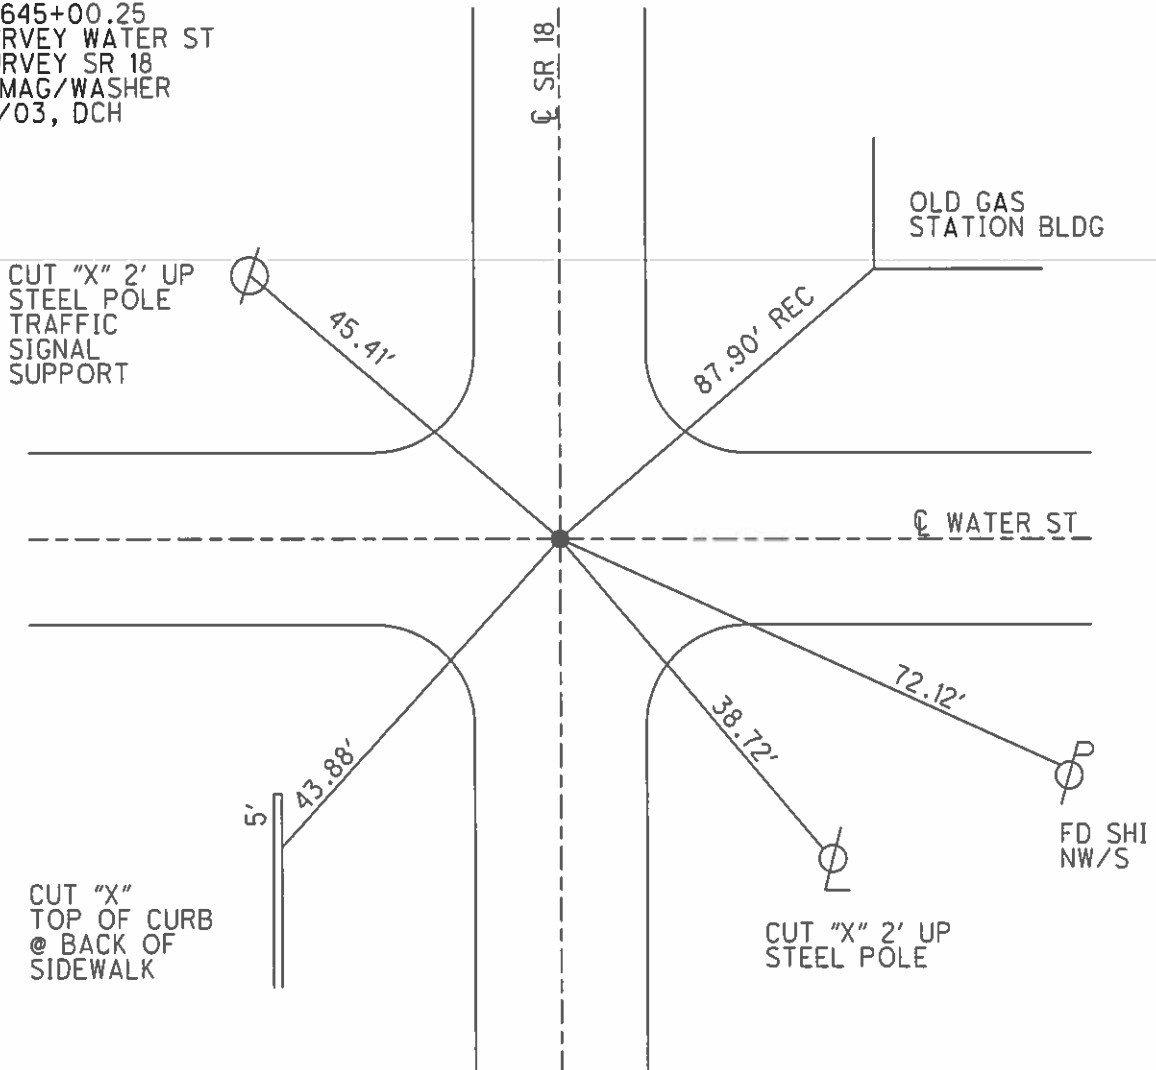

# O.D.O.T. DISTRICT 2 SURVEY OFFICE

PERSONNEL

REFERENCE NO. 27-A

SHEET 15 OF     

NOTES HOFFMAN

H.C. LOEHRKE

R.C. BARNHISEL

Sockmaal

DATE 6-17-87

WEATHER CLEAR

TEMP. 85°

ROUTE SR 18

COUNTY WOOD

TOWNSHIP HENRY

SECTION 35

T.3 N. R.10 E

TYPE MONUMENT SMALL RR SPIKE


ON SURFACE - BELOW YES

LEFT - & PAV'T. - RIGHT BOTH Pavts

TO EDGE PAVEMENT


S.L.M. 644+45

set P.K. / WASHER  
7-27-87  
SWH

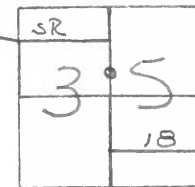

RECORD:

Sta. 645+00.25  
& survey water st  
& SR 18 & survey

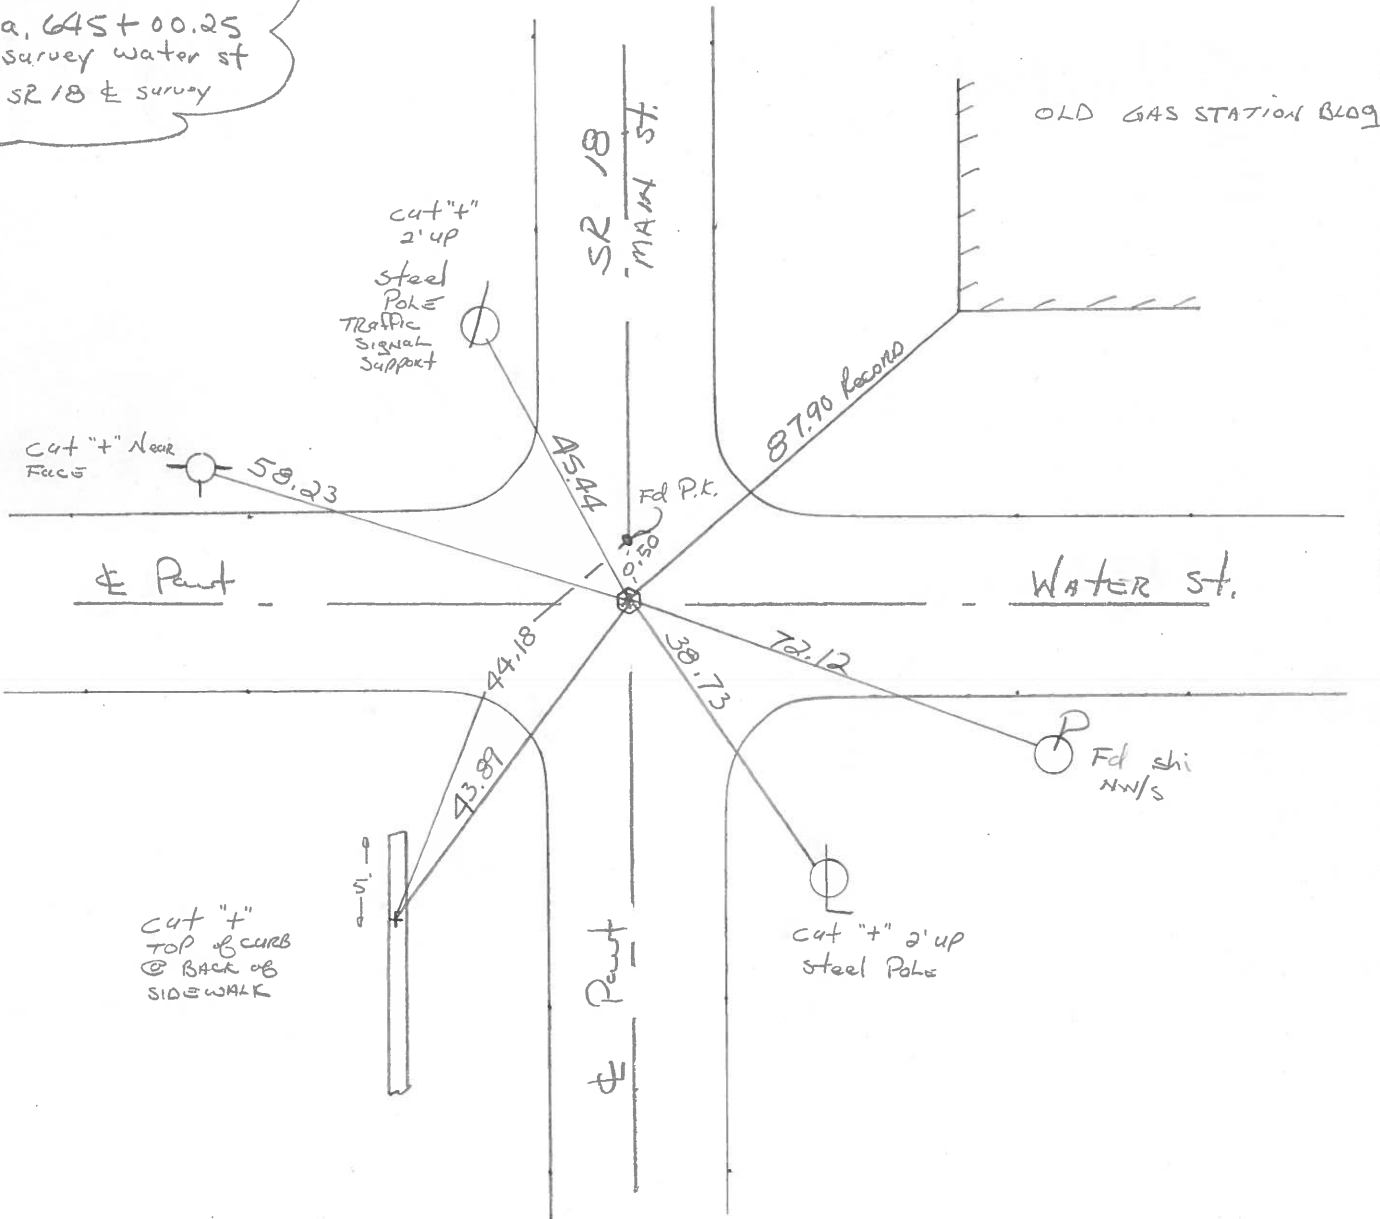

O.D.O.T. DISTRICT 2 SURVEY OFFICE

Sht. 9 of 22  
S.R. 18

County WOOD

Date 6-15-78

Township HENRY


Weather CLEAR

Section N. BALTIMORE

Temp. +70°

T N, R E

Personnel BURNSIDE

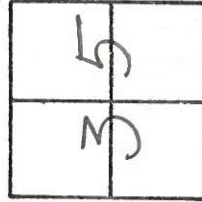

SMITH




BOWERS

KNAPE

MEAD

#27A

STA. 645+00.25  
R.R. SPK @ SURFACE  
& SURVEY WATER ST. &  
S.R. 18

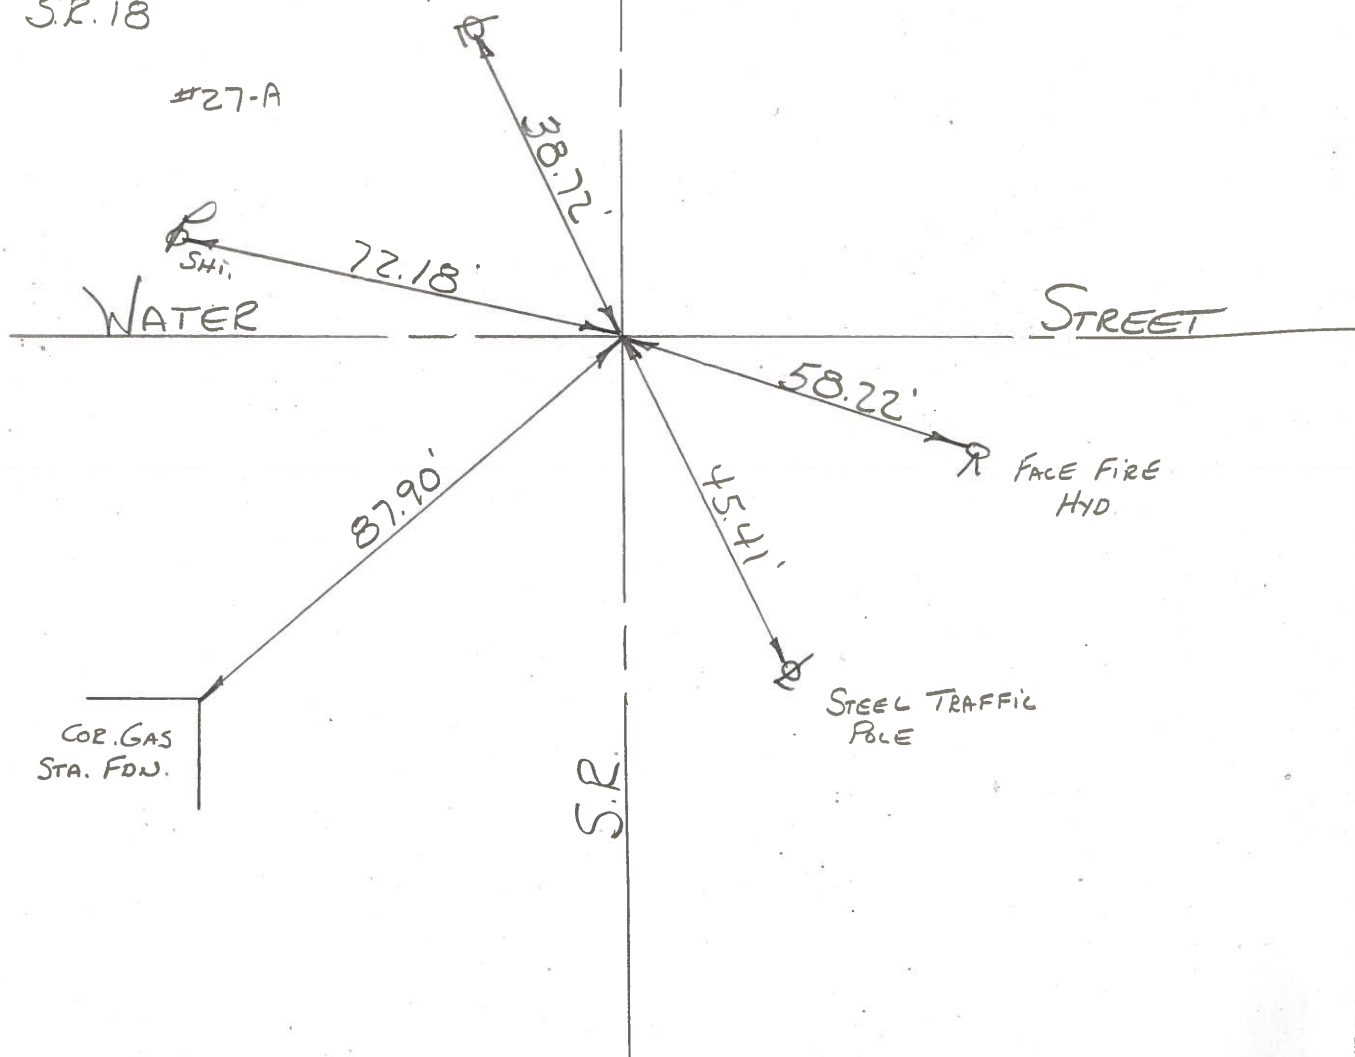

PERSONNEL	TITLE	PERSONNEL	TITLE	COUNTY	DATE	WEATHER	TEMP.
<u>PURNSIDE</u>				<u>WOOD</u>	<u>1-4-71</u>	<u>CLOUDY</u>	<u>+20°</u>
<u>SMITH</u>				<u>S. R. #18</u>			
<u>BOWERS</u>				<u>SEC. 11.58-12.63</u>			
<u>HOLCOMBE</u>							

DESCRIPTION NORTH BALTIMORE CORP. JOB NO. \_\_\_\_\_

