
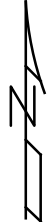


O.D.O.T. DISTRICT 2 SURVEY OFFICE (USE ONLY)


PERSONNEL _____ REFERENCE NO. 27 E SHEET 5 OF 19
 NOTES HOFFMAN DATE 6/17/87 ROUTE SR 18
 H.C. LOEHREKE WEATHER CLEAR COUNTY WOOD
 R.C. BARNHISEL TEMP. 85° TOWNSHIP HENRY
SOCKMAN SECTION 35
T 3 N R 10 E

TYPE MONUMENT SM.R.R.SPIKE
 ON SURFACE - ~~BELOW~~ ON _____
~~LEFT~~ - CL PAV'T - RIGHT 93'
 - TO - EDGE PAVEMENT
 S.L.M. 666+23

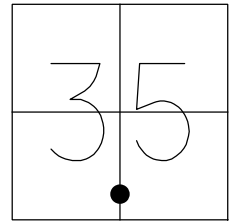

Grid: Northing: _____ Easting: _____

RECORD: P.I.
 STA 667+20.88
 $\Delta = 84^\circ 46' \text{ LT}$

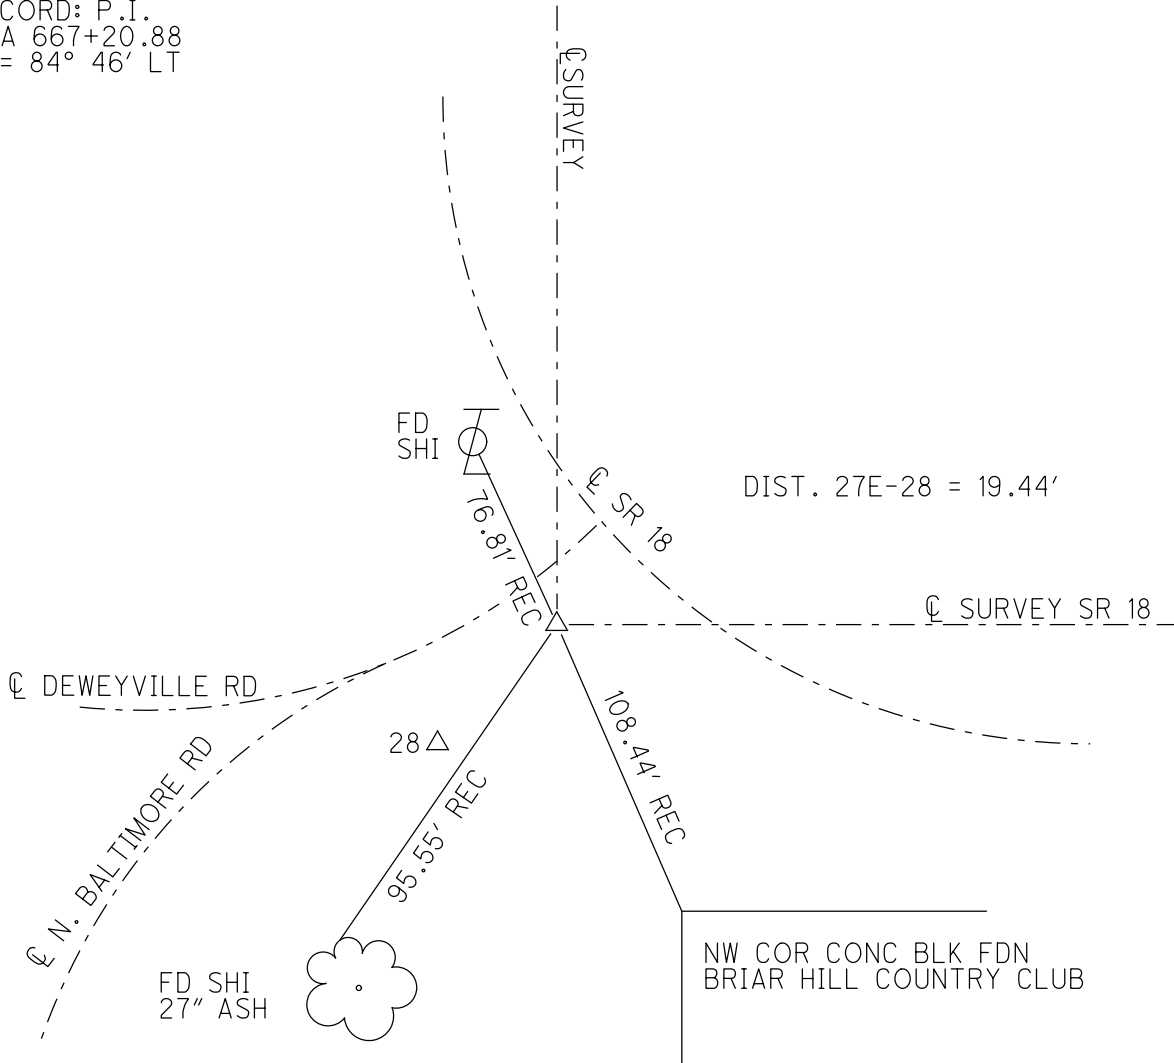

O.D.O.T. DISTRICT 2 SURVEY OFFICE

PERSONNEL

REFERENCE NO. 28

SHEET 18 OF

NOTES HOFFMAN

H.C. LOEHRKE

R.C. BARNHISEL

Soc/CMAN

DATE 6-17-87

WEATHER CLEAR

TEMP. 85°

ROUTE SR 18

COUNTY WOOD

TOWNSHIP HENRY

SECTION 35

T 3 N R 10 E



TYPE MONUMENT SMALL RR SPIKE

ON SURFACE -BELOW YES

~~LEFT~~ - PAV'T. - RIGHT 93' of Part SR 18

TO EDGE PAVEMENT

S.L.M. 666 + 23

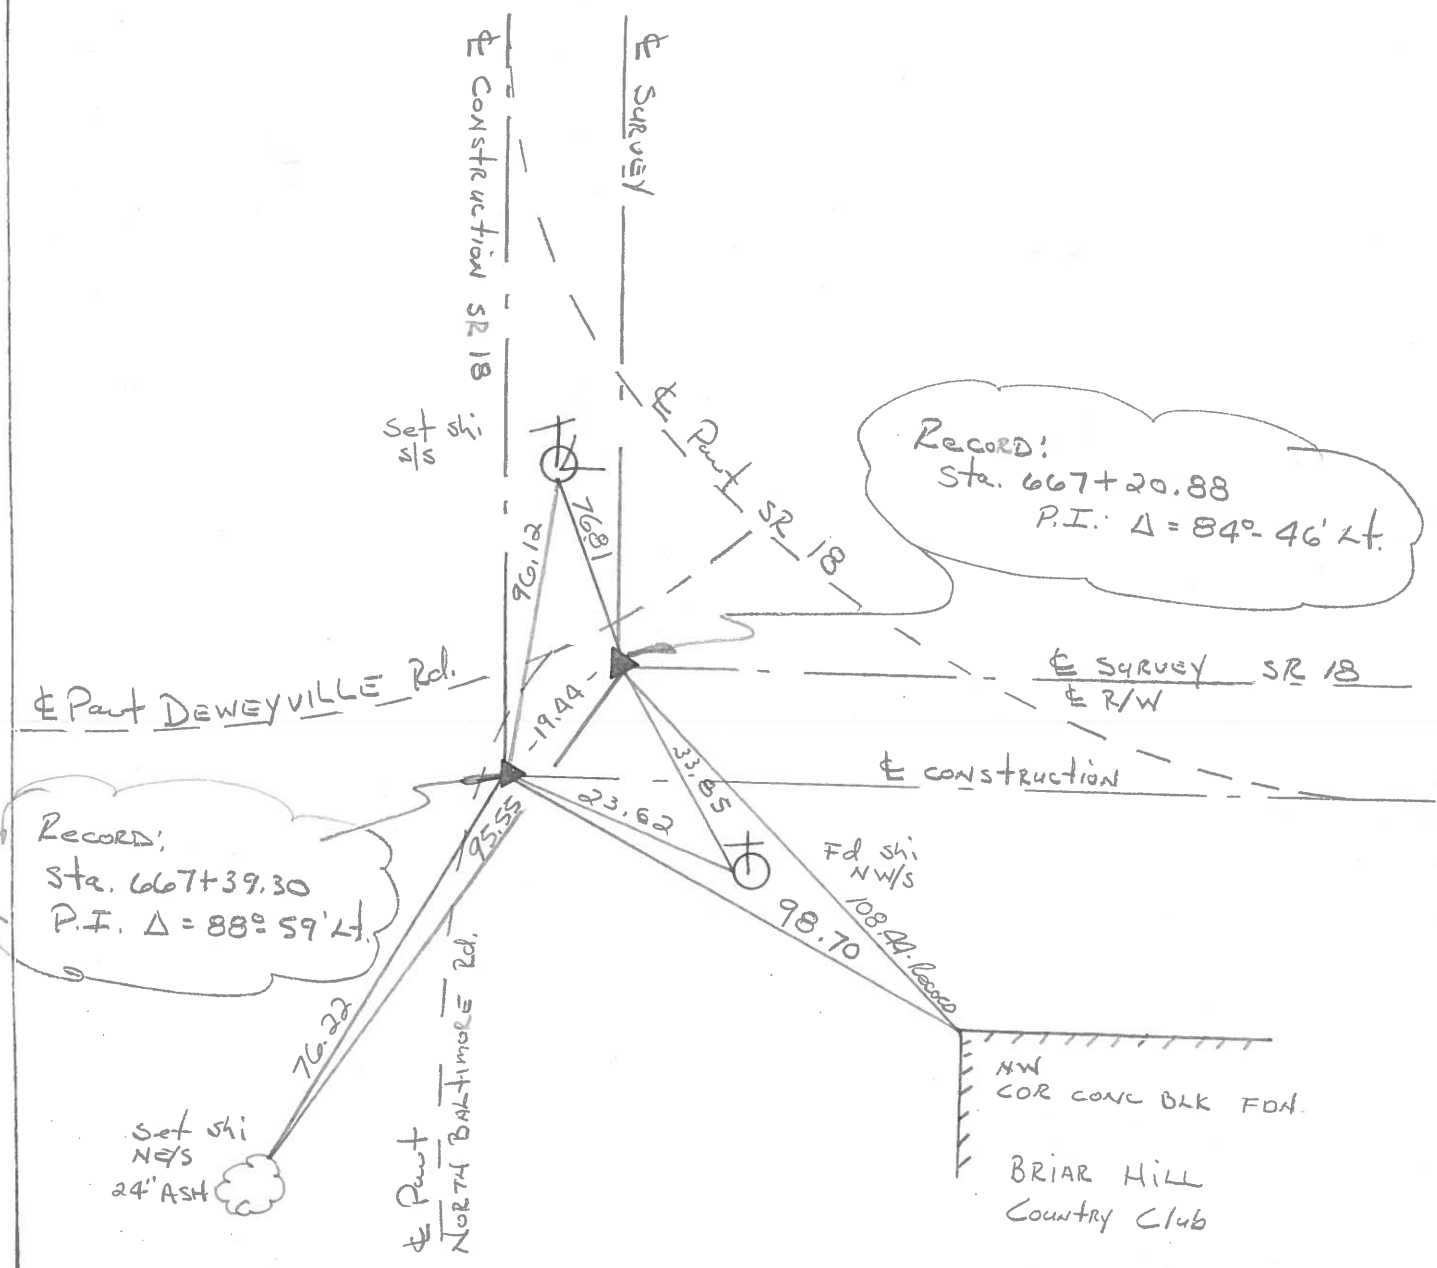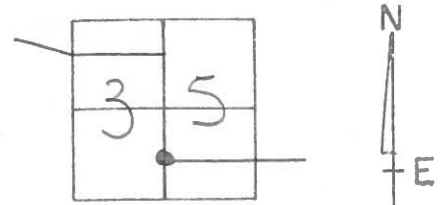

OD.O.T. DISTRICT 2 SURVEY OFFICE

Sht. 12 of 22
S.R. 18

County WOOD

Date 6-15-78

Township HENRY

Weather CLEAR

Section 35

Temp. +72°

T N, R E



Personnel BURNSIDE

SMITH


BOWERS

KUAPE

MEAD

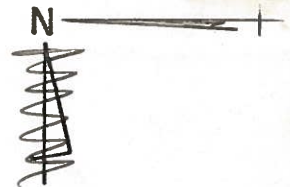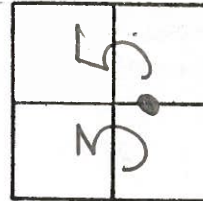

28

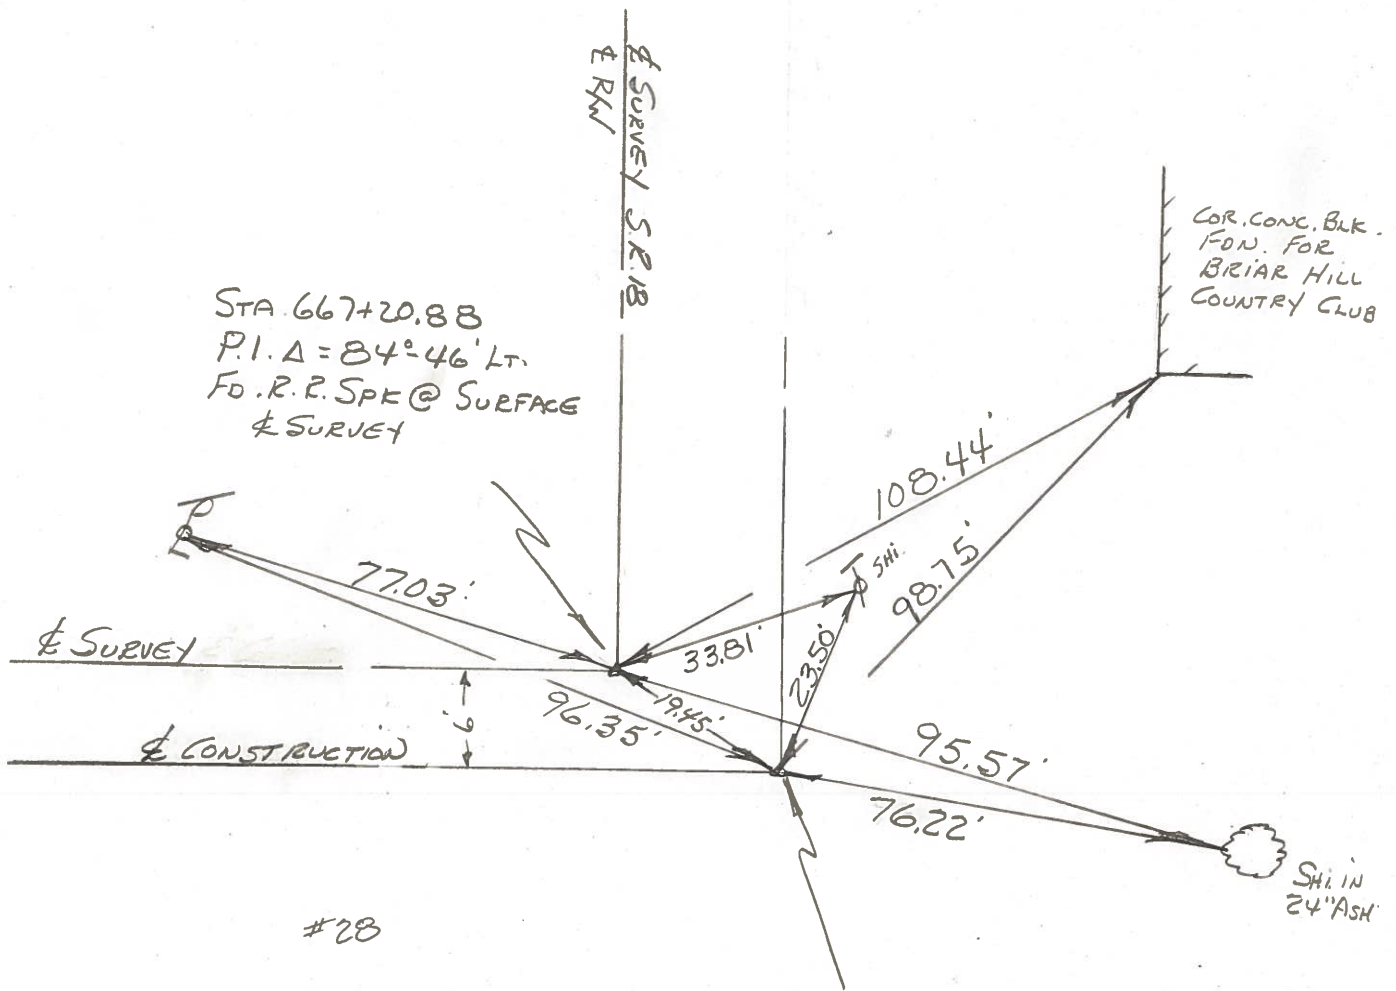

#28

STA. 667+39.30
P.I. Δ = 88°-59' LT.
FO. R.R. SPK. @ SURFACE

PERSONNEL TITLE PERSONNEL TITLE
BURNSIDE _____
SMITH _____
BOWERS _____
HOLCOMBE _____

COUNTY WOOD DATE 1-5-71
 S. R. #18 WEATHER CLEAR
 SEC. 11.58-12.63 TEMP. +14°

DESCRIPTION NORTH BALTIMORE JOB NO. _____

