

O.D.O.T. DISTRICT 2 SURVEY OFFICE (USE ONLY)

PERSONNEL

REFERENCE NO. 28 A

SHEET 7 OF 19

NOTES LEU

DATE 9/7/16

ROUTE SR 18

H.C. HOMAN

WEATHER SUNNY

COUNTY WOOD

R.C. LEU

TEMP. 87°

TOWNSHIP HENRY

SECTION 35

DWG BY MILLER PID 93417

T 3 N R 10 E

TYPE MONUMENT MAG/WASHER

ON SURFACE - ~~BELOW~~ ON

OFFSET Q PAVEMENT 0.9' ~~LT~~ : RT

11.2' TO RT EDGE PAVEMENT


STATION: 669+73.77

HORZ. DATUM: NAD83 (2011)


GEOID: 2012A

GRID: NORTHING: 551014.381

EASTING: 1644380.291

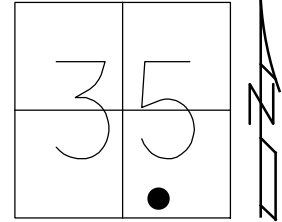


RECORD: P.I.
 STA 668+30
 $\Delta=4^{\circ}12'$ LT
 FD P.K./WASHER
 7-8-02, DCH
 SET MAG/WASHER
 2-20-03, DCH
 FD MAG/WASHER
 NEWREFA28
 9-7-16, DCH

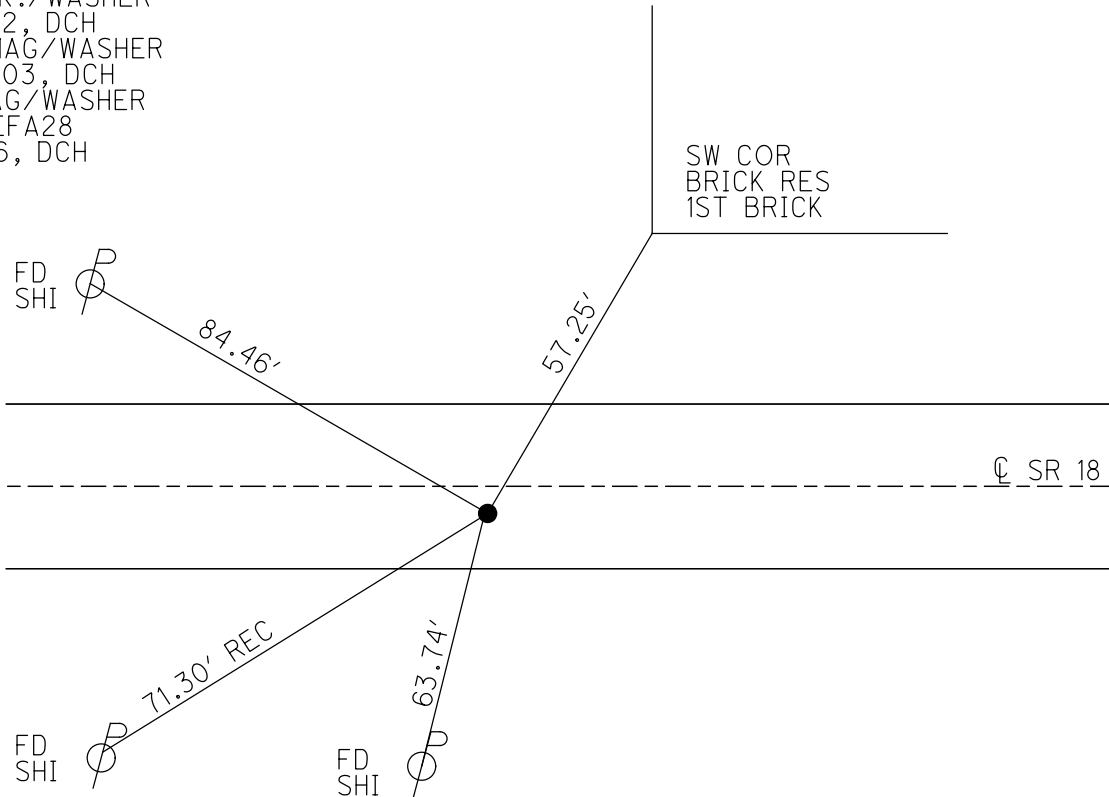

O.D.O.T. DISTRICT 2 SURVEY OFFICE (USE ONLY)


PERSONNEL _____ REFERENCE NO. 28 A SHEET 7 OF 18
 NOTES HOMAN DATE 7/8/02 ROUTE SR 18
 H.C. ZEBROWSKI WEATHER SUNNY COUNTY WOOD
 R.C. MICHALAK TEMP. 80° TOWNSHIP HENRY
BEAUMONT SECTION 35
 T 3 N R 10 E

TYPE MONUMENT P.K./WASHER
 ON SURFACE - ~~BELOW~~ ON _____
~~LEFT~~ - \odot PAV'T - RIGHT 0.9'
11.2' TO RT EDGE PAVEMENT
 S.L.M. 668+30
 Grid: Northing: _____ Easting: _____

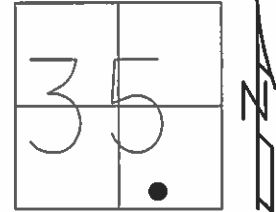

RECORD:
 STA 669+73.49
 P.I. DELTA=4°12' LT
 \odot SURVEY

SET MAG NAIL
 & WASHER
 02-20-03 DCH

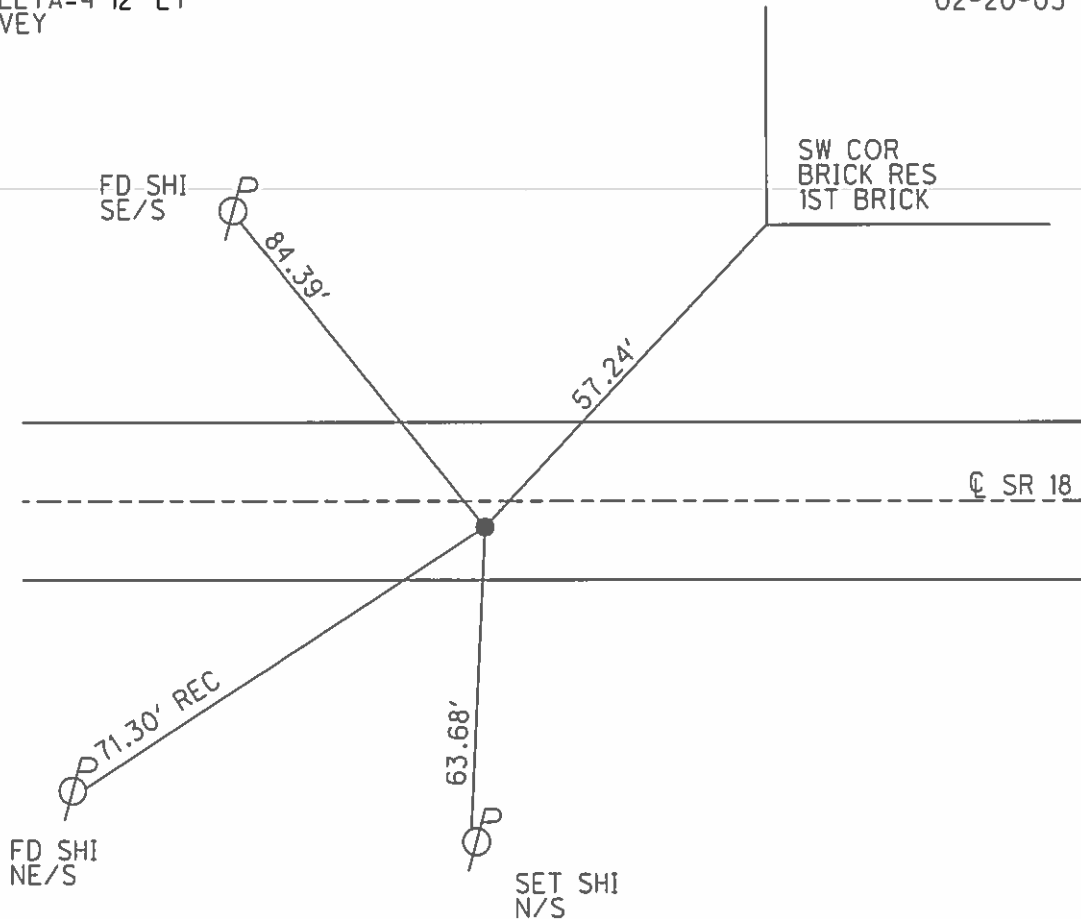

O.D.O.T. DISTRICT 2 SURVEY OFFICE

PERSONNEL

REFERENCE NO. 28-A

SHEET 19 OF

NOTES Hoffman

H.C. Loehrke

R.C. Barthel

Sackman

DATE 6-17-87

WEATHER Clear

TEMP. 85°

ROUTE SR 18

COUNTY Wood

TOWNSHIP Henry

SECTION 35

T3 N R 10 E

TYPE MONUMENT SMALL RR SPIKE


ON SURFACE - ~~BELOW~~ YES

~~LEFT~~ - PAV'T. - RIGHT 0.9


11.2 TO RT EDGE PAVEMENT

S.L.M. 668+30

Set PK/WASHER
7-27-87
SWH

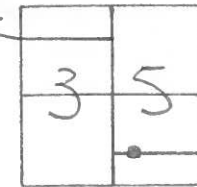

RECORD:
Sta. 669+73.49
P.I. Δ = 4°-12' Lt.
& survey

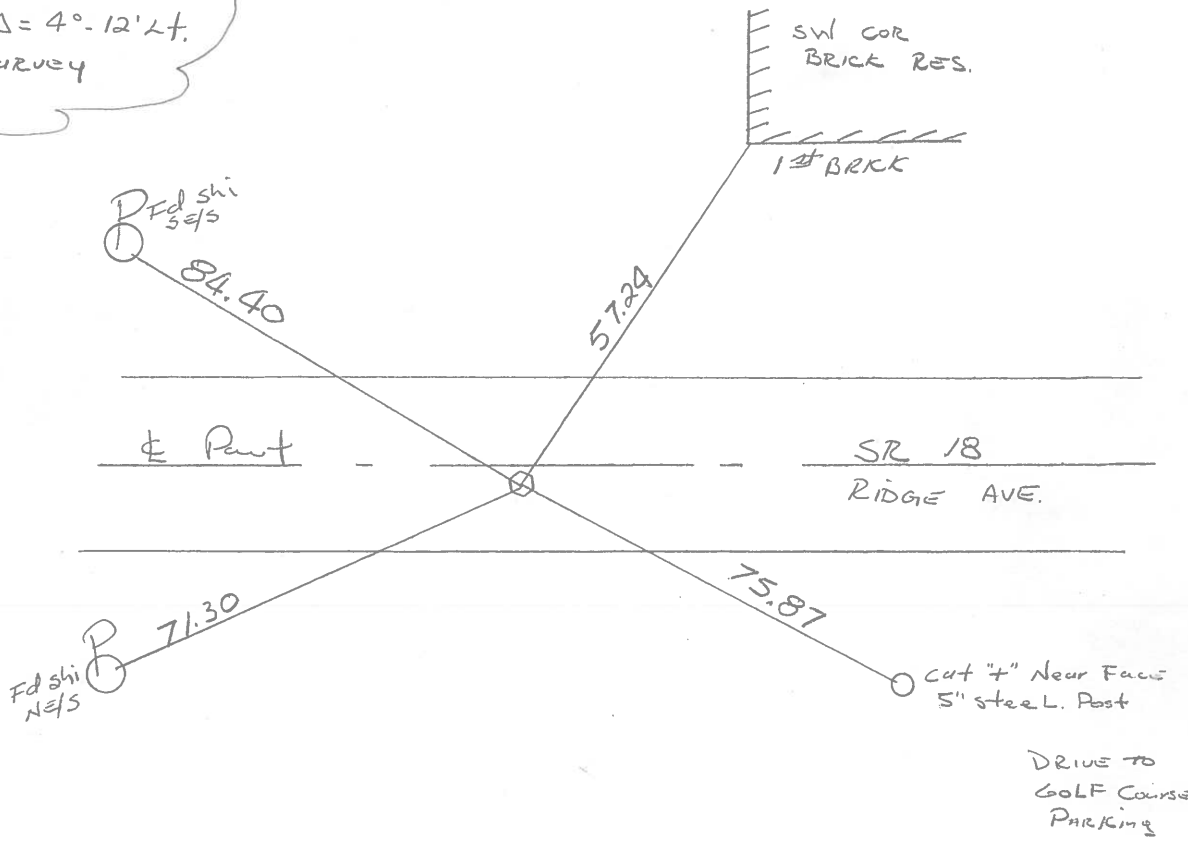

O.D.O.T. DISTRICT 2 SURVEY OFFICE

Sht. 13 of 22
S.R. 18

County WOOD

Date 6-15-78

Township HENRY

Weather P. CLOUDY

Section 35

Temp. +74°

T_N, R_E



Personnel BURNSIDE

SMITH

BOWERS

KNAPE

MEAD

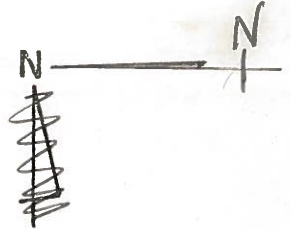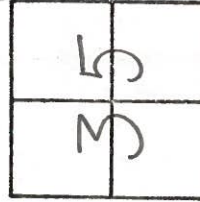

#28-A

COR. BRICK
RES.
(HILLARD)

NEAR EDGE
5" PIPE POST @
DRIVE TO
GOLF COURSE


STA. 669+73.49

P.I. Δ = 4° 12' LT.

⊥ SURVEY

FD. R.R. SPK. @ SURFACE

#28-A

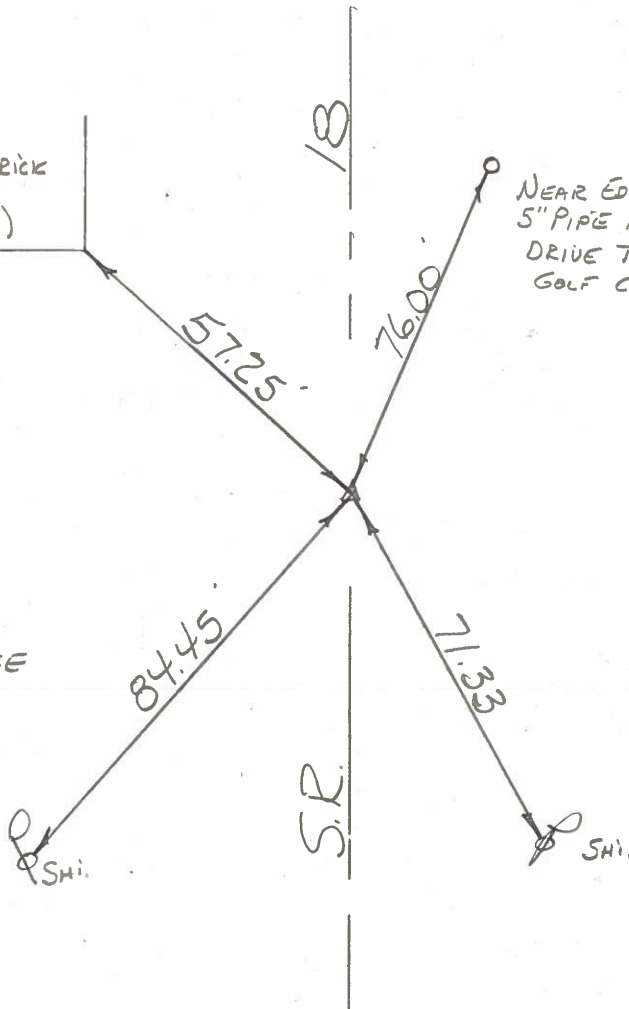

PERSONNEL	TITLE	PERSONNEL	TITLE	COUNTY	<u>Wood</u>	DATE	<u>1-5-71</u>
<u>BURNSIDE</u>				S. R.	<u>#18</u>	WEATHER	<u>CLEAR</u>
<u>SMITH</u>				SEC.	<u>11.58-12.63</u>	TEMP.	<u>+14°</u>
<u>BOWERS</u>							
<u>HOLCOMBE</u>							

DESCRIPTION NORTH BALTIMORE JOB NO. _____

