

O.D.O.T. DISTRICT 2 SURVEY OFFICE (USE ONLY)

PERSONNEL

REFERENCE NO. 28 B

SHEET 8 OF 19

NOTES LEU

DATE 9/7/16

ROUTE SR 18

H.C. HOMAN

WEATHER SUNNY

COUNTY WOOD

R.C. LEU

TEMP. 87°

TOWNSHIP HENRY

SECTION 35

DWG BY MILLER PID 93417

T 3 N R 10 E

TYPE MONUMENT P.K./WASHER

~~ON SURFACE~~ - BELOW 2"

OFFSET 1.2' ~~±~~ : RT

9.6' TO RT EDGE PAVEMENT 55' E CL TARR ST


STATION: 671+73.67

HORZ. DATUM: NAD83 (2011)


GEOID: 2012A

GRID: NORTHING: 551008.442

EASTING: 1644580.090

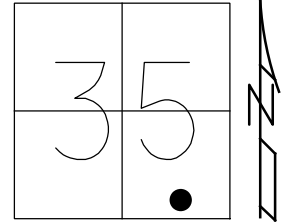


RECORD: P.I.
 STA 671+73.46
 $\Delta = 3^{\circ}19'$ LT
 FD R.R.SPIKE
 2" DOWN
 7/8/02, DCH
 SET MAG/WASHER
 2/10/03, DCH
 FD P.K./WASHER
 NEWREFB28
 9-7-16, DCH

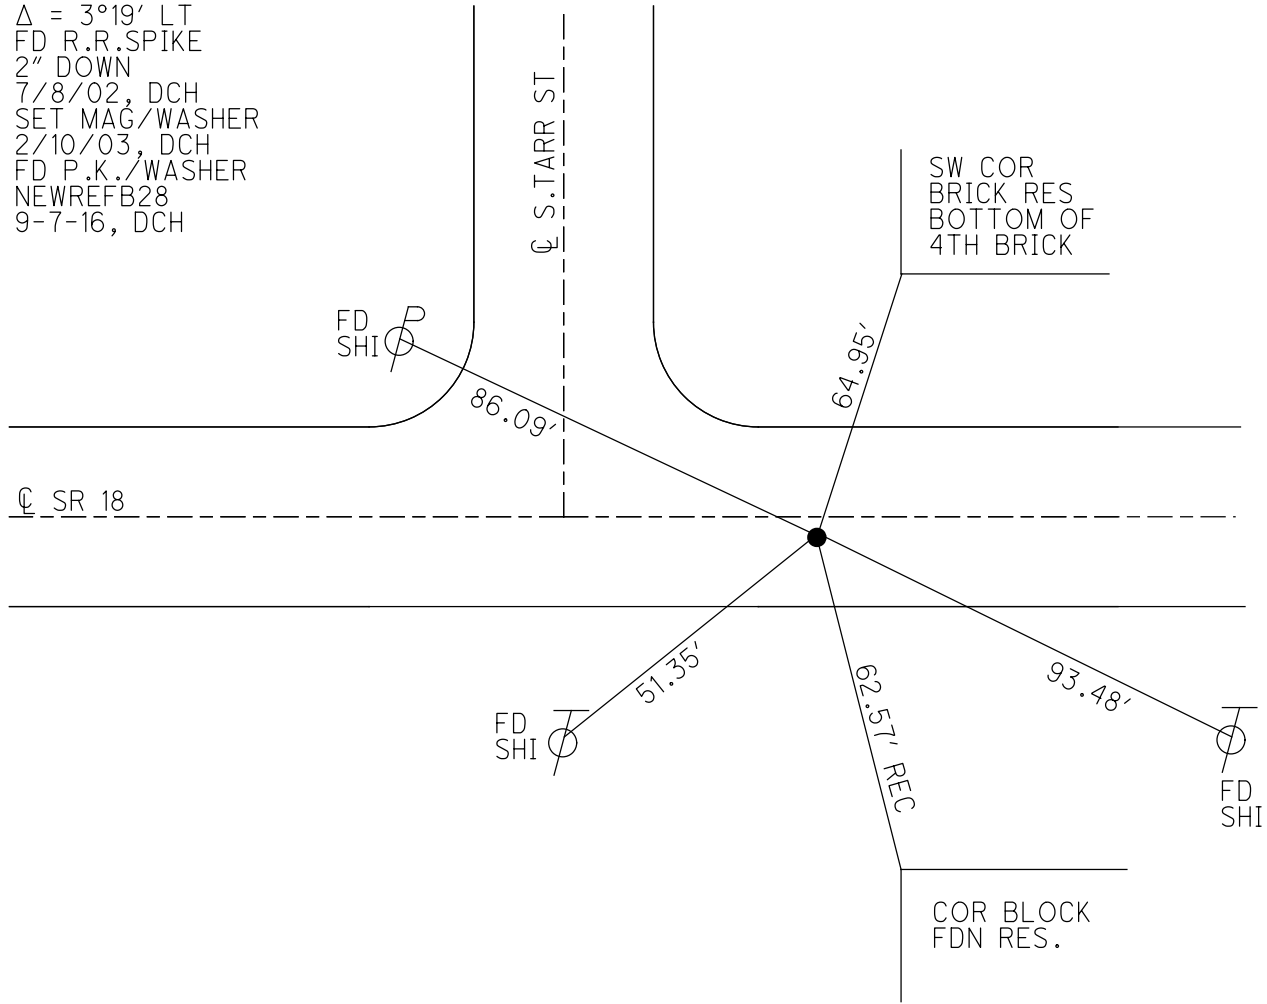


O.D.O.T. DISTRICT 2 SURVEY OFFICE (USE ONLY)

PERSONNEL _____ REFERENCE NO. 28 B SHEET 8 OF 18
 NOTES HOMAN DATE 7/8/02 ROUTE SR 18
 H.C. ZEBROWSKI WEATHER SUNNY COUNTY WOOD
 R.C. MICHALAK TEMP. 70° TOWNSHIP HENRY
BEAUMONT SECTION 35
 T 3 N R 10 E

TYPE MONUMENT R.R. SPIKE
~~ON SURFACE~~ - BELOW 2"
~~LEFT~~ - CL PAV'T - RIGHT 3.5'
9.6' TO RT EDGE PAVEMENT
 S.L.M. 670+23
 Grid: Northing: _____ Easting: _____

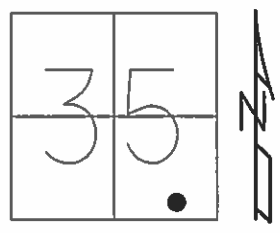

RECORD: P.I.
 STA 671+73.46
 Δ = 3°19' LT
 CL SURVEY
 SET MAG/WASHER
 2/10/03, DCH

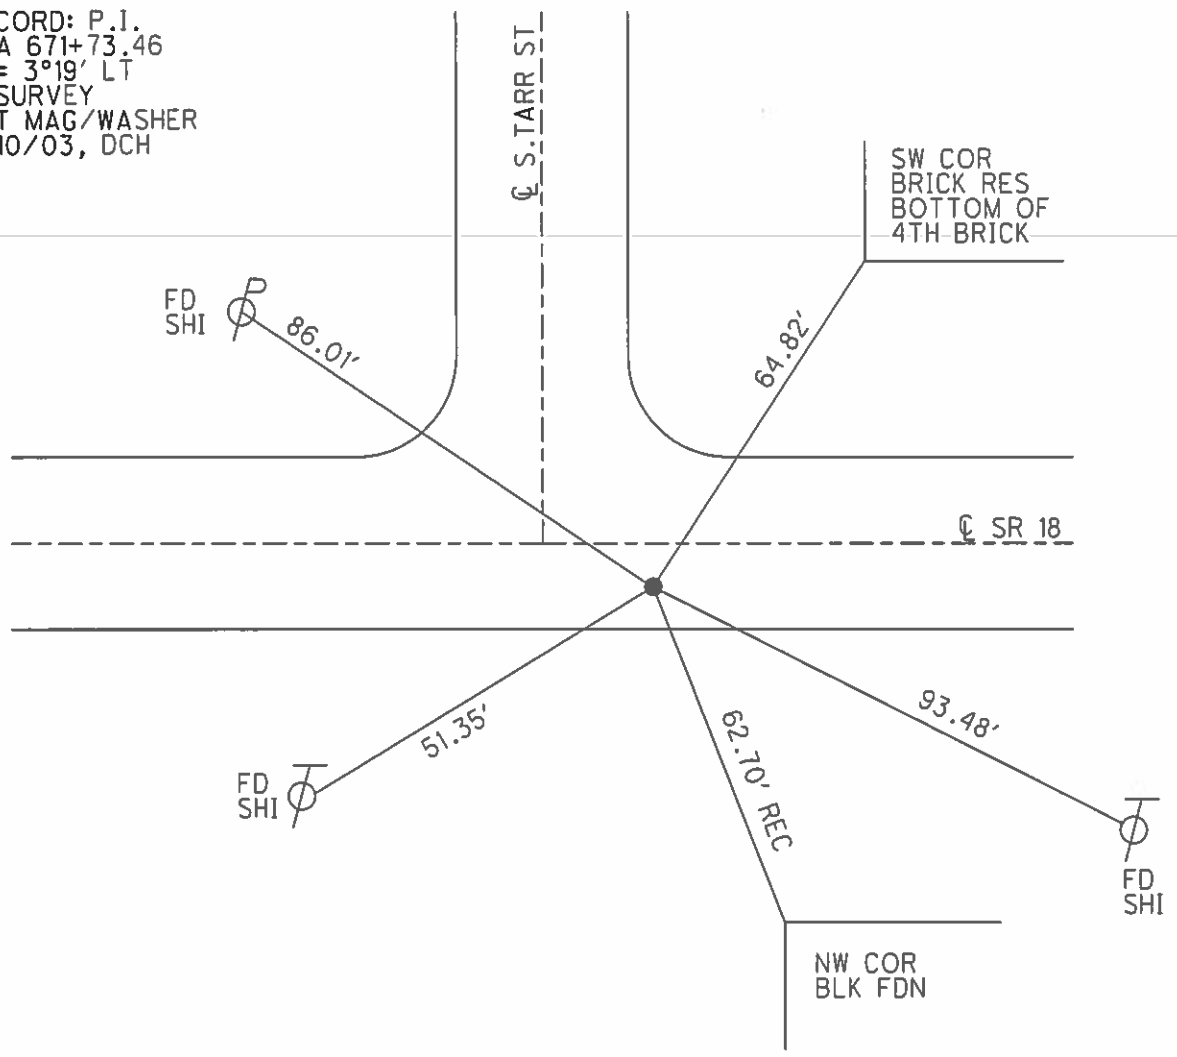

O.D.O.T. DISTRICT 2 SURVEY OFFICE

PERSONNEL

REFERENCE NO. 28-B

SHEET 20 OF

NOTES HOFFMAN

H.C. SOCKMAN

R.C. LOSHAKES

BARNHISEL

DATE 6-15-87

WEATHER CLEAR

TEMP. 85°

ROUTE SR 18

COUNTY WOOD


TOWNSHIP HENRY

SECTION 35


T.3 N. R. 10 E

TYPE MONUMENT SMALL RR SPIKE
 ON SURFACE - BELOW YES
~~LEFT~~ - PAV'T. - RIGHT 3.5
9.6 TO RT EDGE PAVEMENT
 S.L.M. 670 + 23

Set P.K. / WASTEL
 2-17-88
 SJA

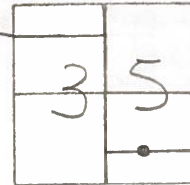

RECORD:
 Sta. 671 + 73.46
 P.I. Δ = 3°-19' LT
 & SURVEY

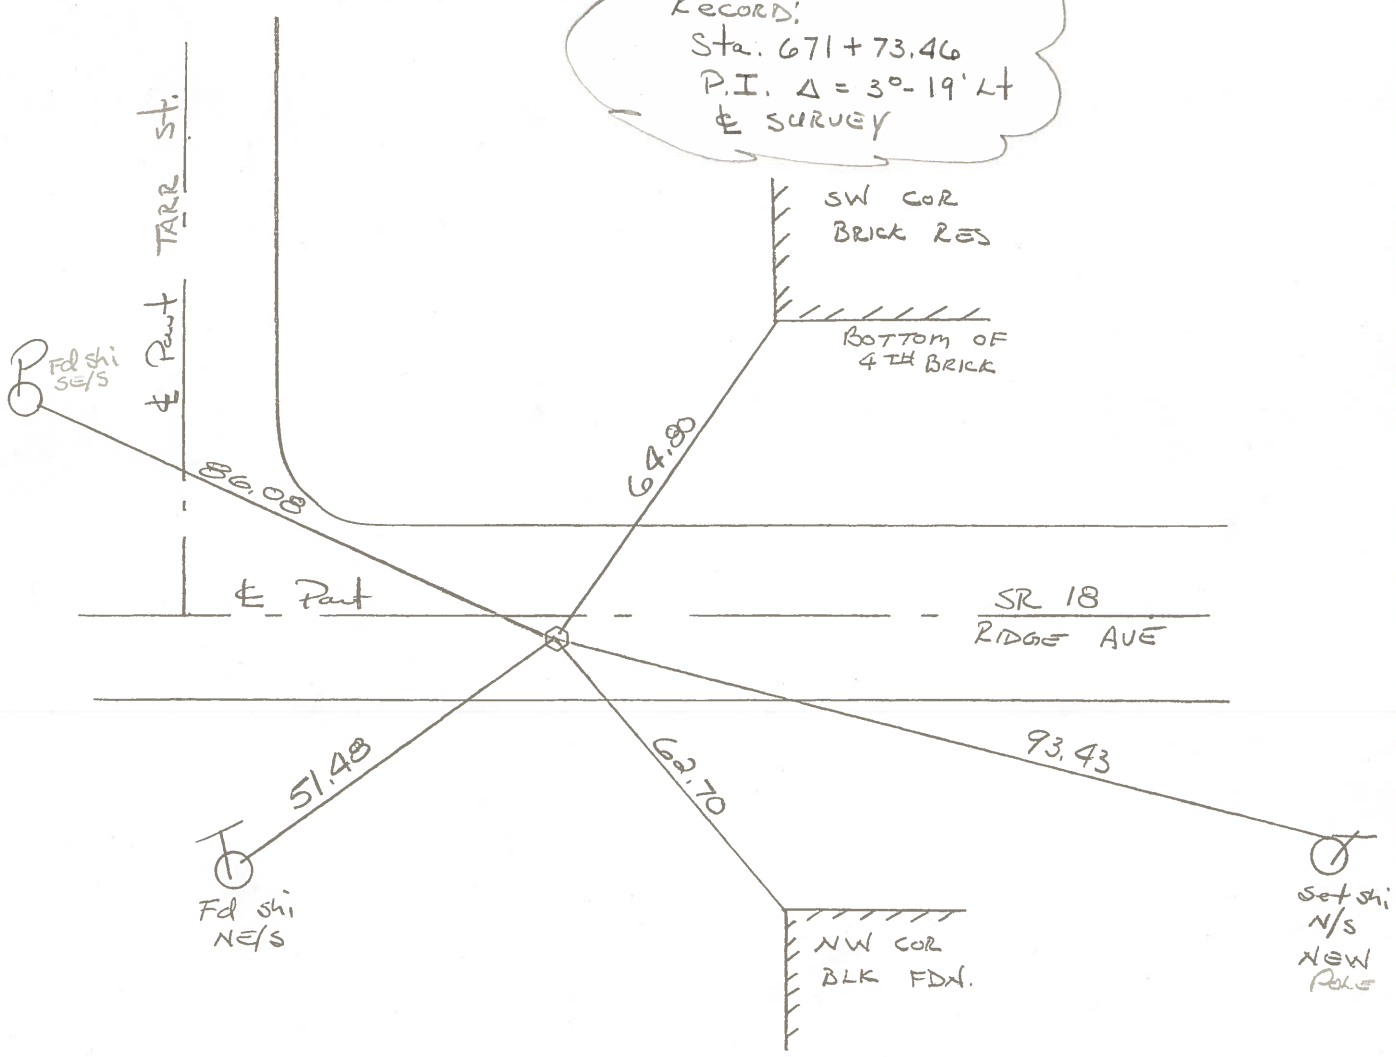

O.D.O.T. DISTRICT 2 SURVEY OFFICE

Sht. 14 of 22
S.R. 18

County WOOD

Date 6-15-78

Township HENRY



Weather PT. CLOUDY

Section N. BALTIMORE


Temp. + 74°

T N, R E

Personnel BURNSIDE
SMITH
BOWERS
KNARE
MEAD

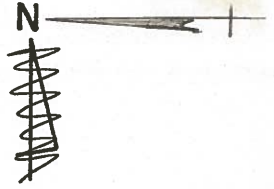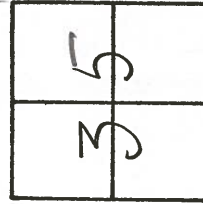

28-B

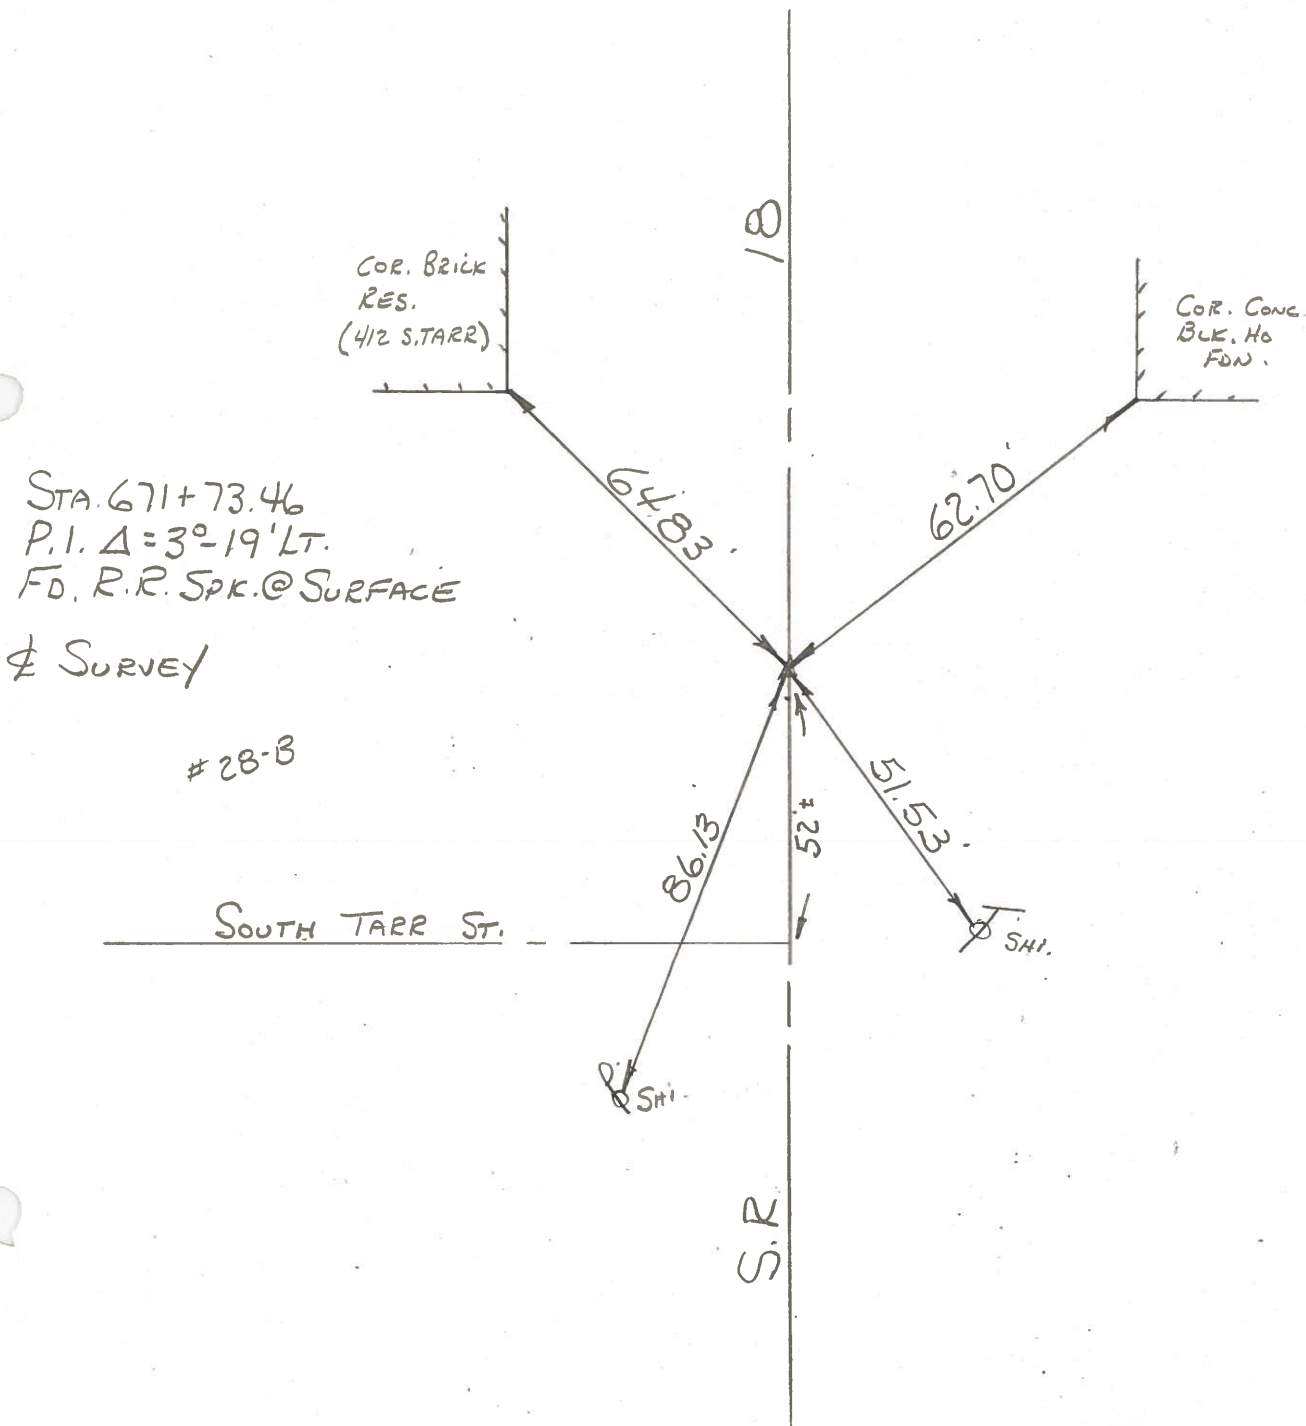

STA. 671+73.46
P.I. Δ = 3°-19' LT.
FD. R.R. SPK. @ SURFACE

± SURVEY

28-B

SOUTH TARR ST.

S.R.

| PERSONNEL | TITLE | PERSONNEL | TITLE |
|-----------|-------|-----------|-------|
| BURNSIDE | | | |
| SMITH | | | |
| BOWERS | | | |
| HOLCOMBE | | | |

COUNTY WOOD DATE 1-5-71
 S. R. #18 WEATHER CLEAR
 SEC. _____ TEMP. +14°

DESCRIPTION _____ LEFT _____ CENTER LINE _____ RIGHT _____ JOB NO. _____

