


O.D.O.T. DISTRICT 2 SURVEY OFFICE (USE ONLY)


PERSONNEL _____ REFERENCE NO. 28 C SHEET 9 OF 19
 NOTES HOMAN DATE 7/8/02 ROUTE SR 18
 H.C. ZEBROWSKI WEATHER SUNNY COUNTY WOOD
 R.C. MICHALAK TEMP. 85° TOWNSHIP HENRY
BEAUMONT SECTION 35
 DWG BY MILLER PID 93417 T 3 N R 10 E

TYPE MONUMENT DRILLH
 ON SURFACE - ~~BELOW~~ ON _____
 OFFSET \varnothing PAVEMENT - ~~LT~~ : RT
1.5' LT TO RT EDGE PAVEMENT
 STATION: 673+59.32

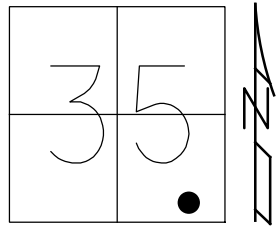

HORZ.DATUM: NAD83 (2011) GEOID: 2012A
 GRID: NORTHING: 551003.747 EASTING: 1644751.757


RECORD: P.I.
 STA 673+45.36
 $\Delta = 7^{\circ}06'$ LT
 \varnothing CONST.
 FD DRILLH
 REFD28
 9/7/16, DCH

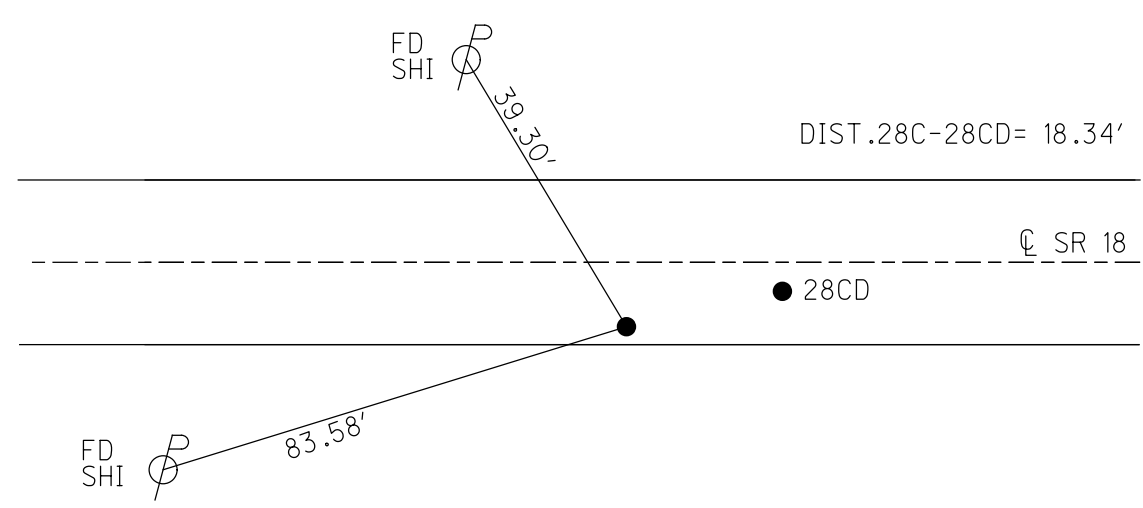

O.D.O.T. DISTRICT 2 SURVEY OFFICE (USE ONLY)


PERSONNEL _____ REFERENCE NO. 28 C SHEET 9 OF 18
 NOTES HOMAN DATE 7/8/02 ROUTE SR 18
 H.C. ZEBROWSKI WEATHER SUNNY COUNTY WOOD
 R.C. MICHALAK TEMP. 85° TOWNSHIP HENRY
BEAUMONT SECTION 35
T 3 N R 10 E

TYPE MONUMENT DRILL HOLE
 ON SURFACE - ~~BELOW~~ ON
~~LEFT~~ - ☉ PAV'T - RIGHT 1.4'
9.8' TO RT EDGE PAVEMENT
 S.L.M. 672+15

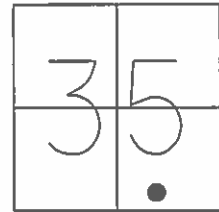

Grid: Northing: _____ Easting: _____

RECORD: P.I.
 STA 673+45.36
 $\Delta = 7^{\circ}06' \text{ LT}$
 ☉ CONST.

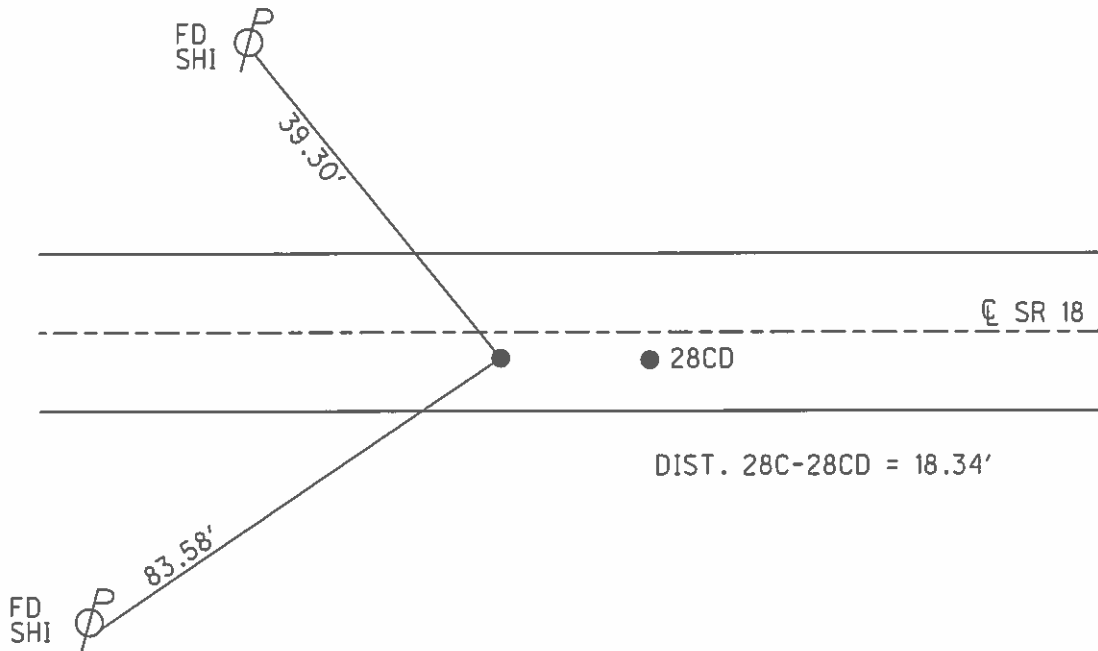

O.D.O.T. DISTRICT 2 SURVEY OFFICE

PERSONNEL

REFERENCE NO. 28-C

SHEET 21 OF

NOTES HOFFMAN

H.C. SOCKMAN

R.C. LOEHKE

BARNHISEL

DATE 6-15-87

WEATHER CLEAR

TEMP. 85°

ROUTE SR 18

COUNTY WOOD

TOWNSHIP HENRY

SECTION 35

T. 3 N. R. 10 E


TYPE MONUMENT SMALL RR SPIKE

ON SURFACE - BELOW YES

LEFT- & PAV'T. - RIGHT 1.4


9.8 TO RT EDGE PAVEMENT

S.L.M. 672+15 & SURVEY

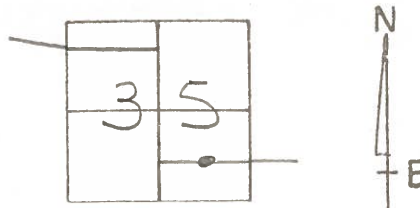

Set DRILL HOLE, 1/2" x 1/8", IN CONC. FOR BOTH POINTS
2-17-88, SURV

By Plans - 1987
673+59.30
BARBER & ASSOC.

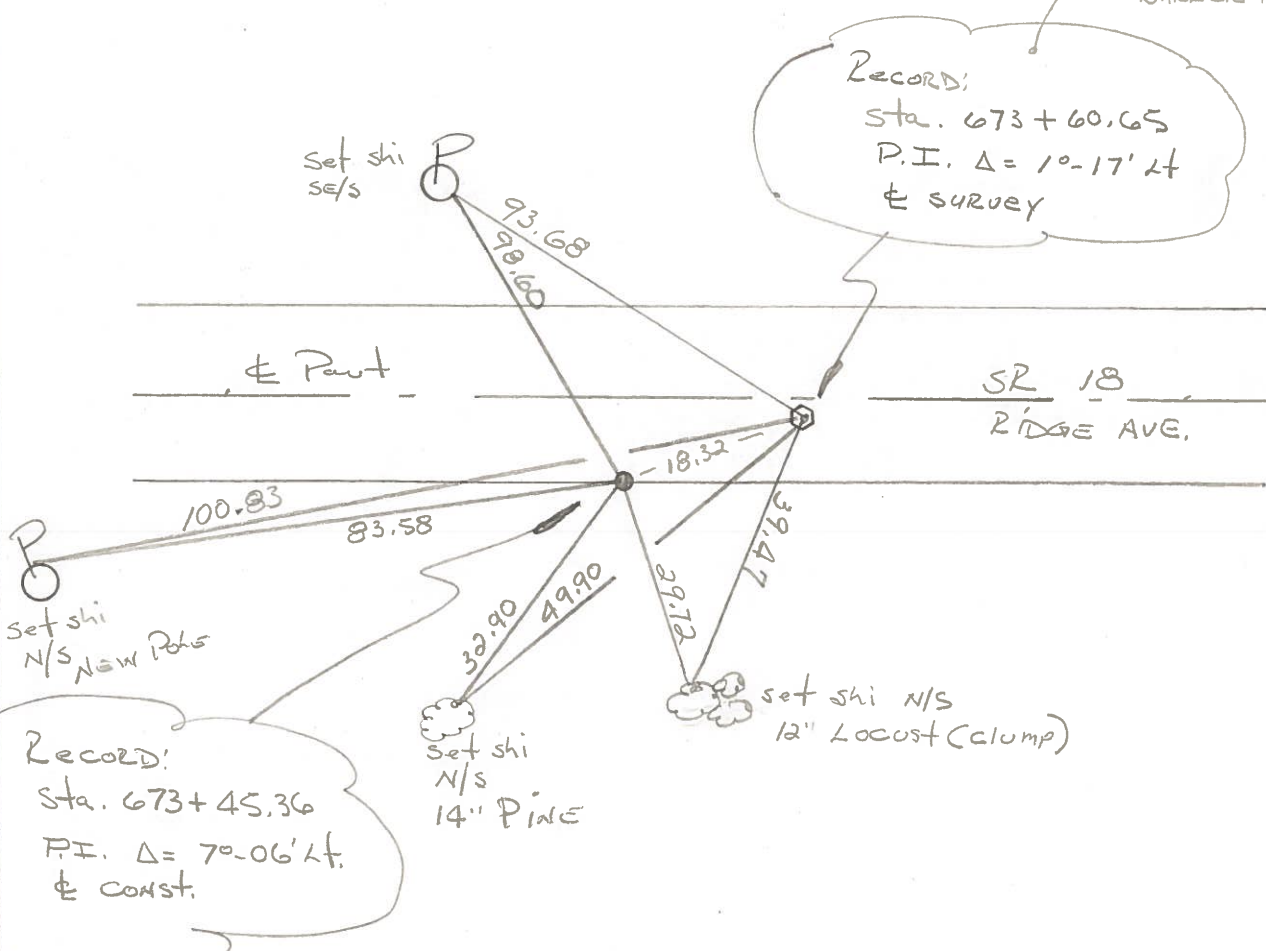

OD.O.T. DISTRICT 2 SURVEY OFFICE

Sht. 15 of 22
S.R. 18

County WOOD

Date 6-16-78

Township HENRY

Weather CLEAR

Section 35

Temp. +67°

T N, R E


Personnel BURNSIDE

SMITH

BOWERS

ICNAPE


MEAD

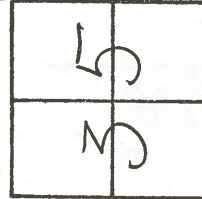

28-C

STA. 673+60.65
 Fd. P.R. SPK @ SURFACE
 & SURVEY
 P.I. Δ = 1°-17' LT.

28-C

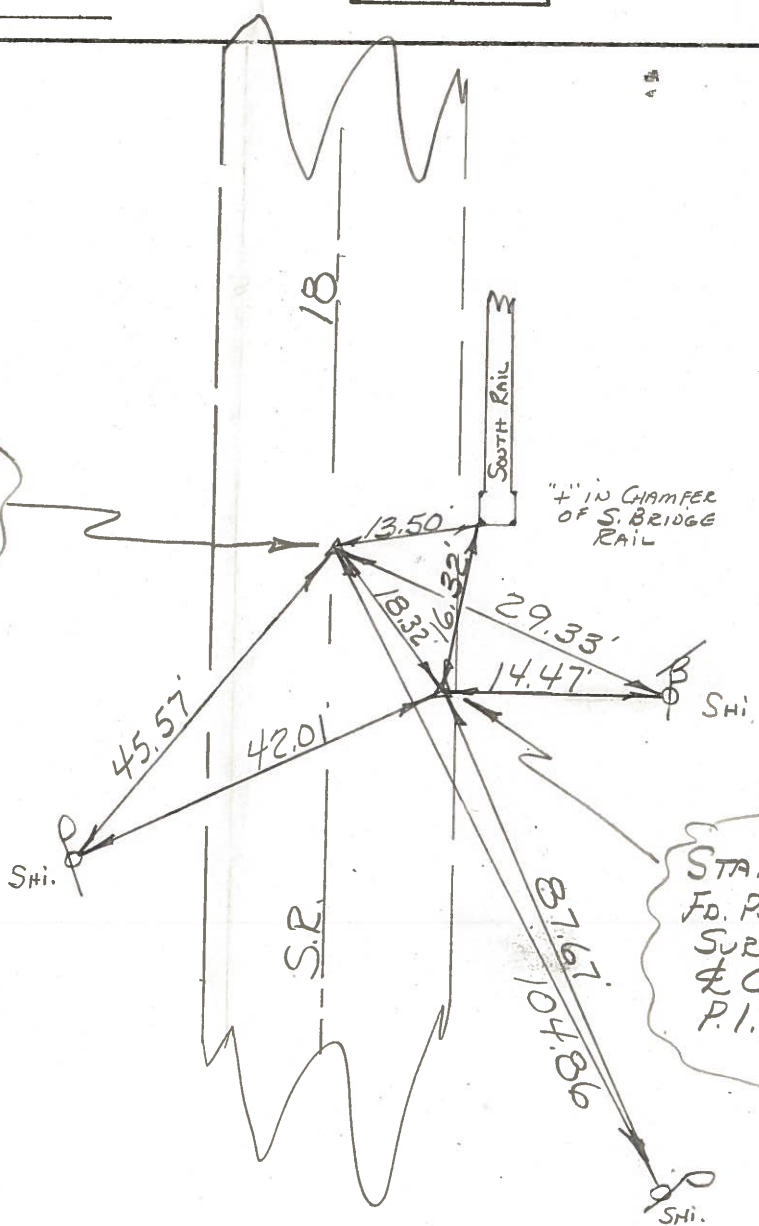

STA. 673+45.36
 Fd. P.K. NAIL @
 SURFACE
 & CONST.
 P.I. Δ = 7°-06' LT.

PERSONNEL	TITLE	PERSONNEL	TITLE	COUNTY	DATE
<u>BURNSIDE</u>				<u>WOOD</u>	<u>1-5-71</u>
<u>SMITH</u>				S. R. <u>#18</u>	WEATHER <u>CLEAR</u>
<u>BOWERS</u>				SEC.	TEMP. <u>+14°</u>
<u>HOLCOMBE</u>					

DESCRIPTION _____ LEFT _____ CENTER LINE _____ RIGHT _____ JOB NO. _____

