

O.D.O.T. DISTRICT 2 SURVEY OFFICE (USE ONLY)

PERSONNEL

REFERENCE NO. 29

SHEET 14 OF 19

NOTES HOMAN
 H.C. LUE
 R.C. THOMAS

DATE 8/4/14
 WEATHER SUNNY
 TEMP. 80°

ROUTE SR 18
 COUNTY WOOD
 TOWNSHIP HENRY
 SECTION 36
 T 3 N R 10 E

DWG BY MILLER PID 93417

TYPE MONUMENT MAG/WASHER

ON SURFACE - ~~BELOW~~ ON

OFFSET ☉ PAVEMENT 1.0 LT : ~~RT~~
12.5' TO rt EDGE PAVEMENT


STATION: 707+38.68

HORIZ.DATUM: NAD83 (2011)


GEOID: 2012A

GRID: NORTHING: 551004.173

EASTING: 1648133.909

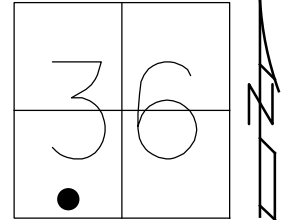


RECORD: P.I.
 STA 707+39.12
 $\Delta = 1^\circ 28' RT$
 FDS P.K./WASHER
 7/8/02, DCH
 SET P.K./WASHER
 2/20/03, DCH
 FD MAG/WASHER
 REF29
 8/4/14, DCH
 SET MAG/WASHER
 NEWREF29
 9/7/16, DCH

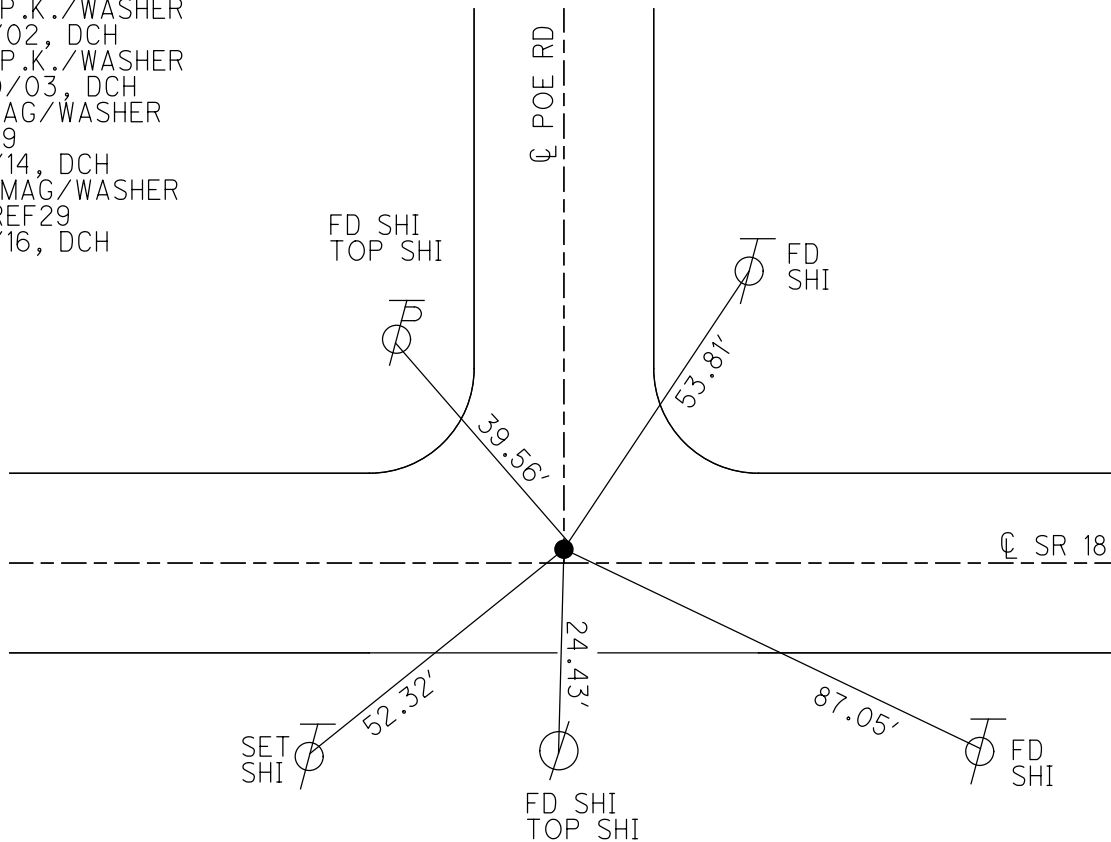

O.D.O.T. DISTRICT 2 SURVEY OFFICE (USE ONLY)


PERSONNEL _____ REFERENCE NO. 29 SHEET 14 OF 18
 NOTES HOMAN DATE 7/8/02 ROUTE SR 18
 H.C. ZEBROWSKI WEATHER SUNNY COUNTY WOOD
 R.C. MICHALAK TEMP. 90° TOWNSHIP HENRY
BEAUMONT SECTION 36
 T 3 N R 10 E

TYPE MONUMENT P.K./WASHER
 ON SURFACE - ~~BELOW~~ ON _____
 LEFT - ☉ PAV'T - ~~RIGHT~~ 1.0'
12.5' TO RT EDGE PAVEMENT
 S.L.M. 705+92

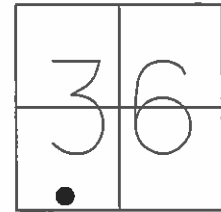

Grid: Northing: _____ Easting: _____

RECORD: P.I.
 STA 707+39.12
 $\Delta = 1^{\circ}28'RT$
 ☉ SURVEY & ☉ CONST
 SET P.K./WASHER
 2/20/03, DCH

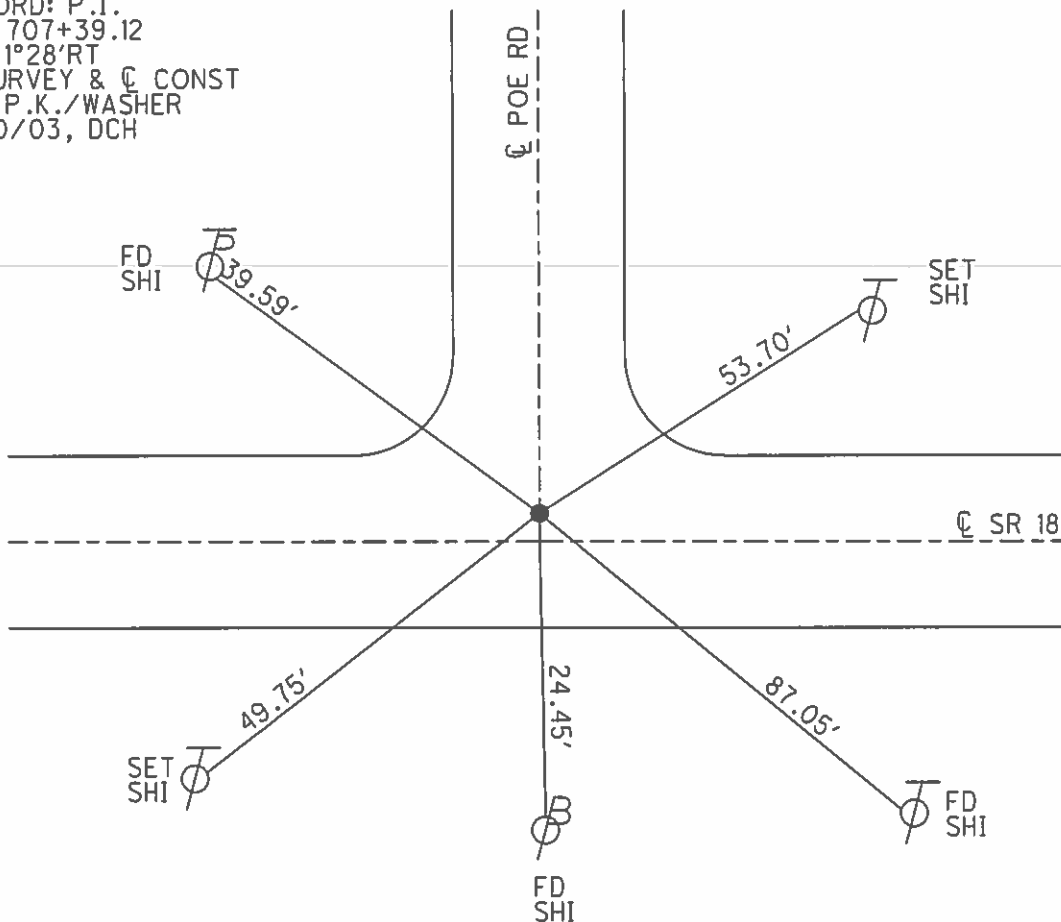

O.D.O.T. DISTRICT 2 SURVEY OFFICE

PERSONNEL

REFERENCE NO. 29

SHEET 25 OF

NOTES HOFFMAN

H.C. LOGHRICE

R.C. BARNTISCH

Sockman

DATE 6-17-87

WEATHER CLEAR

TEMP. 85°

ROUTE SR 18

COUNTY WOOD

TOWNSHIP HENRY

SECTION 36

T. 3 N. R. 10 E

TYPE MONUMENT SMALL RR SPIKE


ON SURFACE - ~~BELOW~~ YES

LEFT- $\&$ PAV'T. - ~~RIGHT~~ 1.0

12.5 TO RT EDGE PAVEMENT

S.L.M. 705+92

Set P.K./washer
7-24-87
SWL

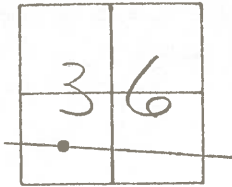


RECORD:

Sta 707+39.12

$\Delta = 1^{\circ} 28' R$

$\&$ SURVEY $\&$ $\&$ CONST

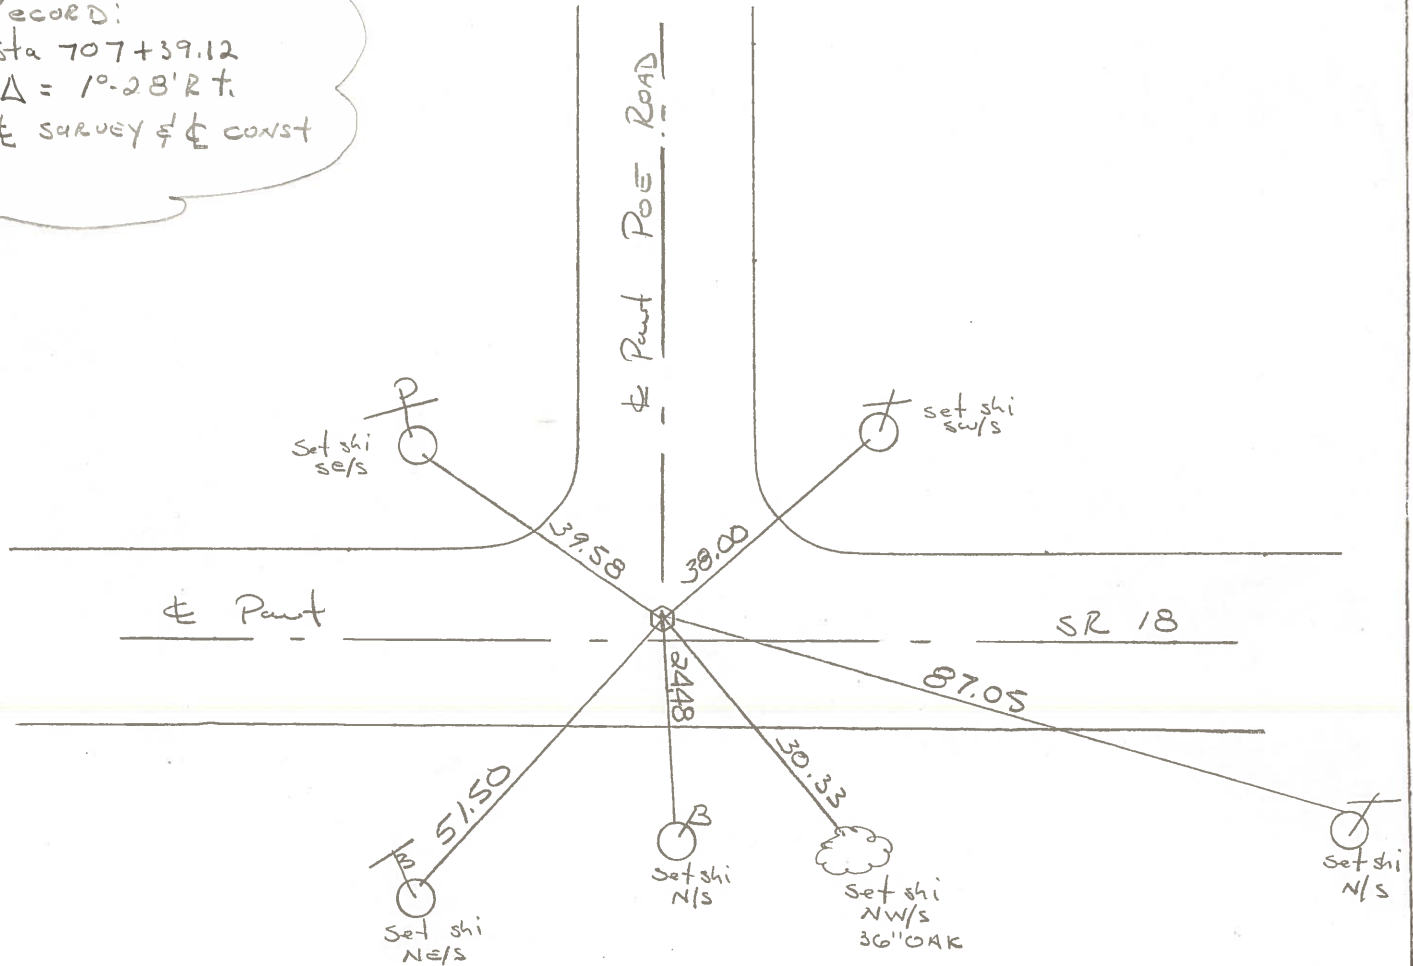

O.D.O.T. DISTRICT 2 SURVEY OFFICE

Sht. 19 of 22
S.R. 18

County WOOD

Date 6-16-78

Township HENRY



Weather CLEARING

Section 36

Temp. +74°

T N, R E

Personnel BURNSIDE
SMITH
BOWERS
KNAPE
MEAD

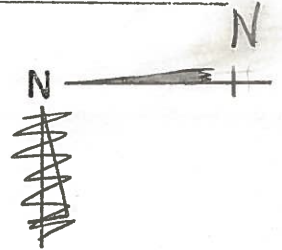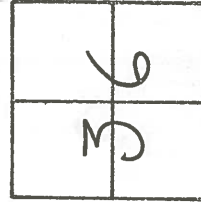


#29

STA. 707+39.12
SURVEY & CONST.
 $\Delta = 1^{\circ}28' RT.$
FD. R.R. SPK. @
SURFACE

#29

TILE YARD ROAD

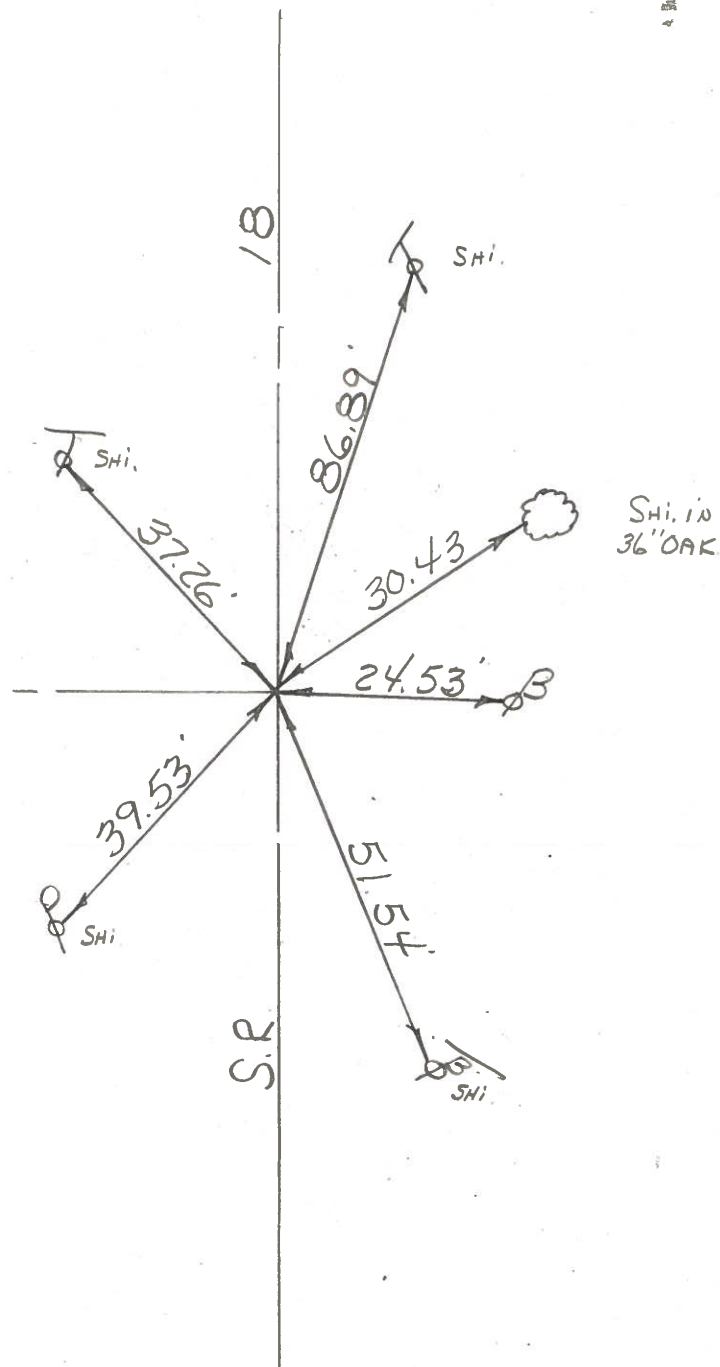

Shi. in
36" OAK

PERSONNEL	TITLE	PERSONNEL	TITLE	COUNTY	DATE
BURNSIDE		Rocchini		WOOD	6-21-71
SMITH				S. R. 18	WEATHER CLEAR
BOWERS				SEC. TILE YARD ROAD	TEMP. +72°
HOLCOMBE					

DESCRIPTION _____ LEFT _____ CENTER LINE _____ RIGHT _____ JOB NO. _____

