


O.D.O.T. DISTRICT 2 SURVEY OFFICE (USE ONLY)


PERSONNEL _____ REFERENCE NO. 33 F SHEET 10 OF 35
 NOTES BARNHISEL DATE 6/16/99 ROUTE SR 18
 H.C. CANTERBURY WEATHER CLOUDY COUNTY WOOD
 R.C. ROUSOS TEMP. 65° TOWNSHIP BLOOM
 SECTION 31
 DWG BY MILLER PID 93417 T 3 N R 11 E

TYPE MONUMENT P.K./WASHER
 ON SURFACE - ~~BELOW~~ ON
 OFFSET CL PAVEMENT 6.6' ~~LT~~ : RT
3.0' TO RT EDGE PAVEMENT
 STATION: 796+23.09

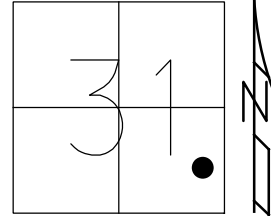

HORIZ.DATUM: NAD83 (2011) GEOID: 2012A
 GRID: NORTHING: 550356.482 EASTING: 1656955.996

RECORD: P.I.
 POINT SET
 OBSERVED
 $\Delta=10^{\circ}14'17''$
 9-26-88
 FD P.K./WASHER
 6/9/99, MB
 SET P.K./WASHER
 7/20/99, MB
 FD P.K./WASHER
 REFF33
 8/25/14, DCH

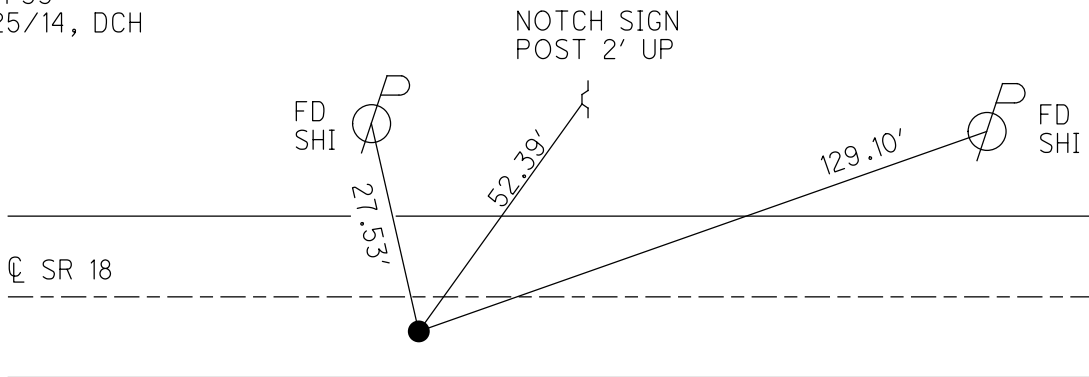

O.D.O.T. DISTRICT 2 SURVEY OFFICE

PERSONNEL _____

REFERENCE NO. _____

SHEET 5 OF 29

NOTES Baruchist

H.C. Canterbury

R.C. Rousar III

DATE 6-16-99

WEATHER Cloudy

TEMP. +65°F

ROUTE SR18

COUNTY Wear

TOWNSHIP Bloom

SECTION 31

T3 N R 11 E


TYPE MONUMENT PK/WASHER

ON SURFACE - BELOW YES

~~LEFT~~ - CL PAV'T. - RIGHT 6.6'


3.0 TO RT EDGE PAVEMENT

S.L.M. 996.164

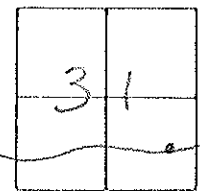

Point Set For P.I.
OBSERVED Δ: 10° 14' 19" 9-26-88

RESET PK/WASHER
7-20-99
MB

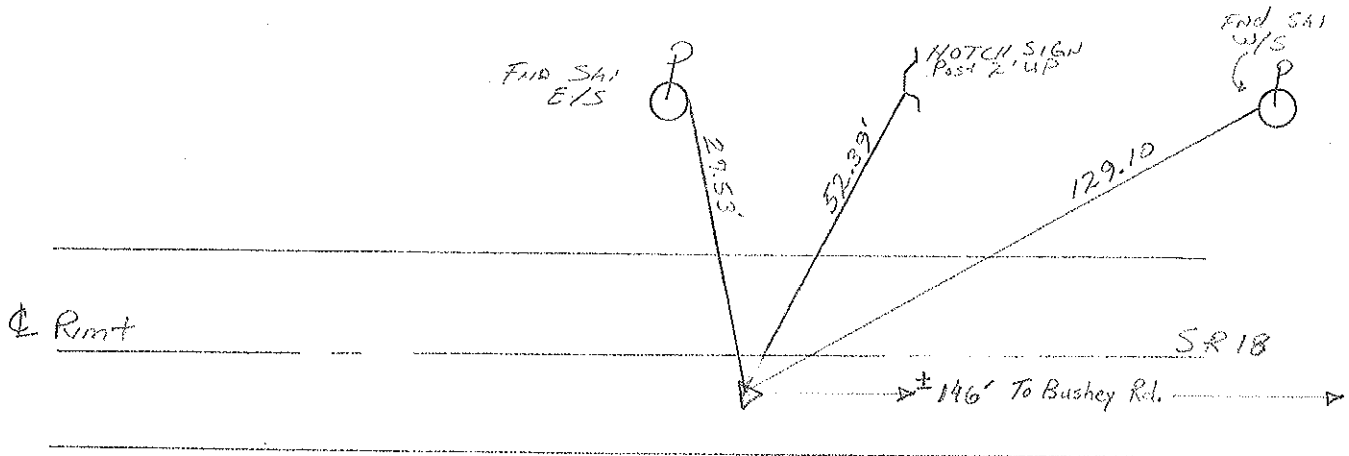

O.D.O.T. DISTRICT 2 SURVEY OFFICE

PERSONNEL _____

REFERENCE NO. 32A

SHEET _____ OF _____

NOTES HOFFMAN

H.C. LOSHRKE

R.C. BARNHISEL

DATE 9-26-88

WEATHER CLEAR

TEMP. 72°

ROUTE SR 18

COUNTY WOOD

TOWNSHIP Bloom

SECTION 31

T.3 N R 11 E


TYPE MONUMENT P.K. / WASHER

ON SURFACE - BELOW YES

LEFT- & PAV'T. - RIGHT 6.6'

3.0 TO RT EDGE PAVEMENT

S.L.M. _____

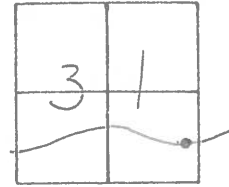

POINT SET FOR P.I.

OBSERVED $\Delta = 10^{\circ} - 14' - 17''$

